

PRIME CONSULTANT

San Luis Obispo 4119 Broad Street, Suite 210 San Luis Obispo, CA 93401 805.546.0433 fax: 805.546.0504

ARCHITECTURE PLANNING

ibigroup.com



Any reproduction or distribution for any purpose other than authorized by

COPYRIGHT 2017 IBI GROUP

REVISIONS DESCRIPTION NO. DATE APPRD.




PORTER & ASSOCIATES, INC. 1200 21st Street, Bakersfield, California 93301 661.327.0362 FAX 661.327.1065

AGENCY INFORMATION:

AGENCY TRACKING NO. 63321-241

FILE NO. 15-6 OFFICE OF REGULATION SERVICES 03-118380 DATE OCT 2 5 2017

BAKERSFIELD CITY SCHOOL

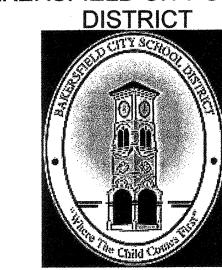

BESSIE OWENS INTERMEDIATE -815 EUREKA ST. BAKERSFIELD CA, 93305

OPSC or OSHPD PROJ. NO: PROJECT NO: 16241.000 Author DRAWN BY: Checker CHK'D BY: ISSUE DATE: 08/29/2017

> CIVIL IMPROVEMENTS **GRADING PLAN PARKING LOT WEST**

SHEET NUMBER