

SCHEDULE PANEL 'A'


CIR. NO.	DESCRIPTION	AMPS	WATTS	VA
441	3	1500	204 SP	
442	3	1500	204 SP	
443	3	1500	204 SP	
TOTAL		15000	20400 SP	

SCHEDULE PANEL 'A'

CIR. NO.	DESCRIPTION	AMPS	WATTS	VA
441	3	1500	204 SP	
442	3	1500	204 SP	
443	3	1500	204 SP	
TOTAL		15000	20400 SP	

SCHEDULE PANEL 'B'

CIR. NO.	DESCRIPTION	AMPS	WATTS	VA
441	3	1500	204 SP	
442	3	1500	204 SP	
443	3	1500	204 SP	
TOTAL		15000	20400 SP	

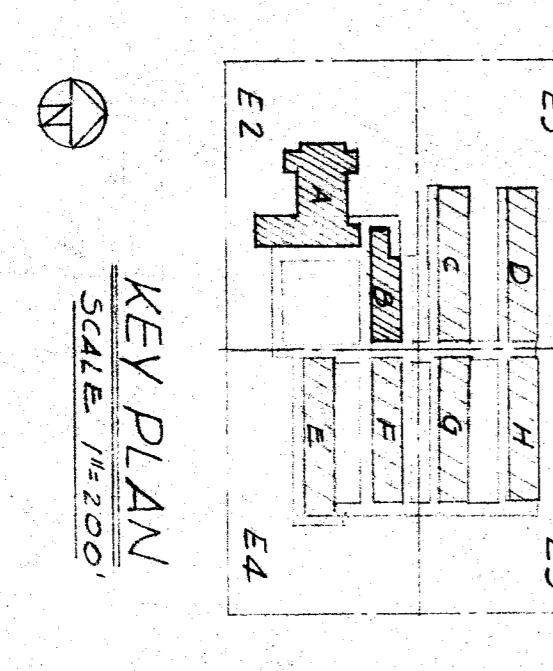

KEY PLAN
SCALE 1/8" = 1'-0"

FOSTER K. SAMPSON
REGISTERED ELECTRICAL ENGINEER
CERTIFICATE NUMBER 944
LOS ANGELES, CALIFORNIA

STATE OF CALIFORNIA
DIVISION OF ARCHITECTURE

BAKERSFIELD CITY SCHOOL DISTRICT
APPROVED: _____
DATE: 7-7-49

SECRETARY: _____

DATE: 7-7-49

WRIGHT METCALF & PARSONS
A R C H I T E C T S
111 N. GARDEN BUILDING
BAKERSFIELD, CALIFORNIA

ELECTRICAL FLOOR PLAN, UNITS 'A', 'B', 'C'
POTOMAC & 50 KING ST. SCHOOL
BAKERSFIELD CITY SCHOOL DISTRICT
KERN COUNTY, CALIFORNIA

153
E-2