

THE SEASONS  
TRACT NO. 6444 - PHASE 1  
SEWER & STORM DRAIN PLANS

RECORD DRAWING

MATTHEW K. VOVILLA  
RCE 43130 EXPIRES 3-31-08

DATE

REVIEWED BY:

JACQUES A. FALGOUT  
ASSISTANT PUBLIC WORKS DIRECTOR, CITY OF BAKERSFIELD

3/1/06  
DATE

APPROVED BY:

PUBLIC WORKS DIRECTOR, CITY OF BAKERSFIELD  
RAUL M. ROJAS R.C.E. 39880 (EXP. 12/31/05)

3/6/06  
DATE

SHEET No. INDEX

- 1 TITLE SHEET
- 2 DETAILS-GENERAL NOTES
- 3 CITY IN THE HILLS DRIVE
- 4 TOSCANA DRIVE
- 5 CITRUS HILLS DRIVE
- 6 SUMMIT PASS DRIVE
- 7 BARCELONA DRIVE
- 8 FALKIRK PLACE, COLCHESTER PLACE & PRAGUE PLACE
- 9 SAINT JOHN PLACE, PRIEST RIVER PLACE & CHARWOOD PLACE
- 10 PRETORIA PLACE & EVORA LANE
- 11 RED HILLS LANE, ROLLING HILLS LANE & SUNSET HILLS LANE
- 12 ORANGE HILLS PLACE & RICHLAND HILLS PLACE
- 13 TOSCANA DRIVE

MATERIALS LIST

ESTIMATED QUANTITIES, NOT  
TO BE USED FOR BIDDING PURPOSES

SEWER (ONSITE)	
6" SEWER MAIN	2,290 L.F.
8" SEWER MAIN	3,285 L.F.
4" SEWER LINE (LATERALS)	4,571 L.F.
SEWER MANHOLES	34 EA.
STANDARD CLEANOUTS	4 EA.

STORM-DRAIN (ONSITE)

24" R.C.P. STORM-DRAIN	550 L.F.
18" R.C.P. STORM-DRAIN	1,525 L.F.
12" P.V.C. STORM-DRAIN	60 L.F.
TYPE "A" CATCH-BASINS	10 EA.
STORM-DRAIN MANHOLES	9 EA.

SEWER (OFFSITE)


8" SEWER MAIN	1,820 L.F.
6" SEWER MAIN	100 L.F.
SEWER MANHOLES	10 EA.

STORM-DRAIN (OFFSITE)

36" R.C.P. STORM-DRAIN	465 L.F.
30" R.C.P. STORM-DRAIN	1,065 L.F.
24" R.C.P. STORM-DRAIN	260 L.F.
18" R.C.P. STORM-DRAIN	175 L.F.
STORM-DRAIN MANHOLES	10 EA.

THESE PLANS AND SPECIFICATIONS WERE PREPARED BY ME OR UNDER MY  
DIRECTION, AND TO THE BEST OF MY KNOWLEDGE AND BELIEF COMPLY WITH  
CITY OF BAKERSFIELD ORDINANCES, STANDARDS AND DESIGN CRITERIA, AND  
INCLUDE ALL IMPROVEMENT REQUIREMENTS OF THE ADVISORY AGENCY OR  
OTHER REVIEW BOARD.

ANY ERRORS, OMISSIONS OR OTHER VIOLATIONS OF THOSE ORDINANCES,  
SPECIFICATIONS, STANDARDS AND DESIGN CRITERIA, OR ANY OTHER REQUIREMENTS  
SHALL BE CORRECTED AND SUCH CORRECTIONS REFLECTED ON CORRECTED PLANS  
SUBMITTED TO THE CITY ENGINEER.

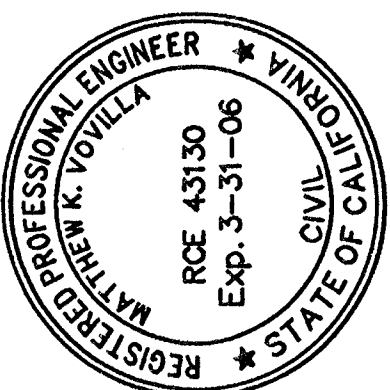

PINNACLE Civil Engineering, Inc.


1712 19th Street, Suite 101, Bakersfield, CA 93301  
Phone: (661) 869-0184 Fax: (661) 328-0607

TRACT NO. 6444 - PHASE 1  
SEWER & STORM DRAIN PLANS  
K. HOVNANIAN  
BAKERSFIELD, CALIFORNIA

JOB No.: 04-158  
DWG NO.: 04-158SWM01  
DATE: 11/21/05  
DRAWN BY: MAS/UV  
CHECKED BY: MKV  
SHEET 1

OF 13 SHEETS



12-6444-1

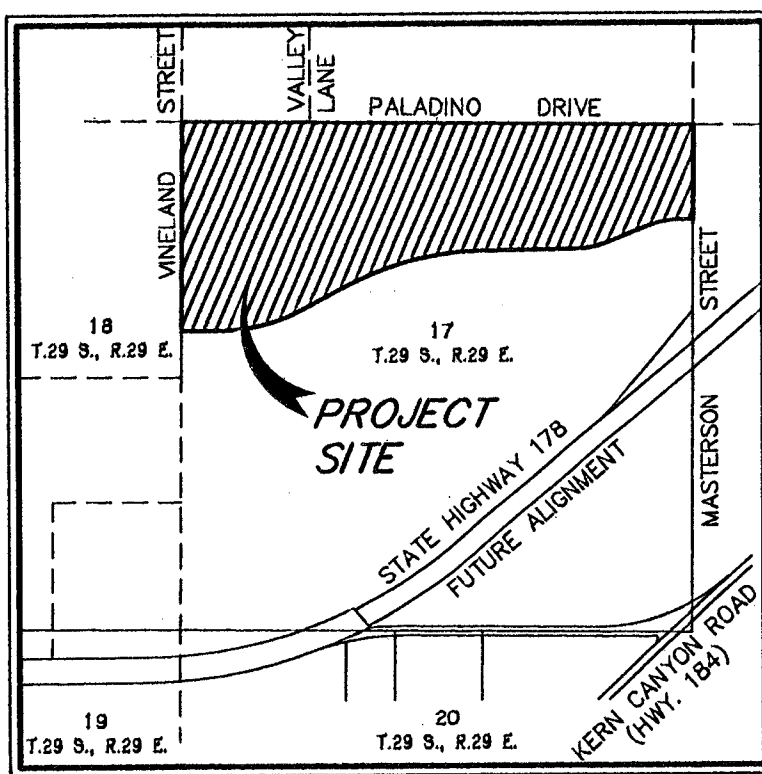

VICINITY MAP  
NO SCALE

BENCHMARK USED:

U.S.G.S. Y-292, ELEVATION=782.57 B.C. IN 9" CONC. PAD 14.5' N.W. OF STREET  
SIGN AND 51.50' FROM CENTERLINE OF HIGHWAY 178 AND LENE PLACE.

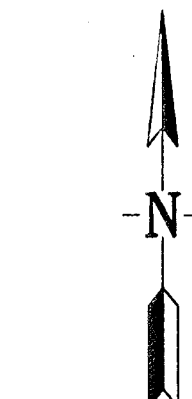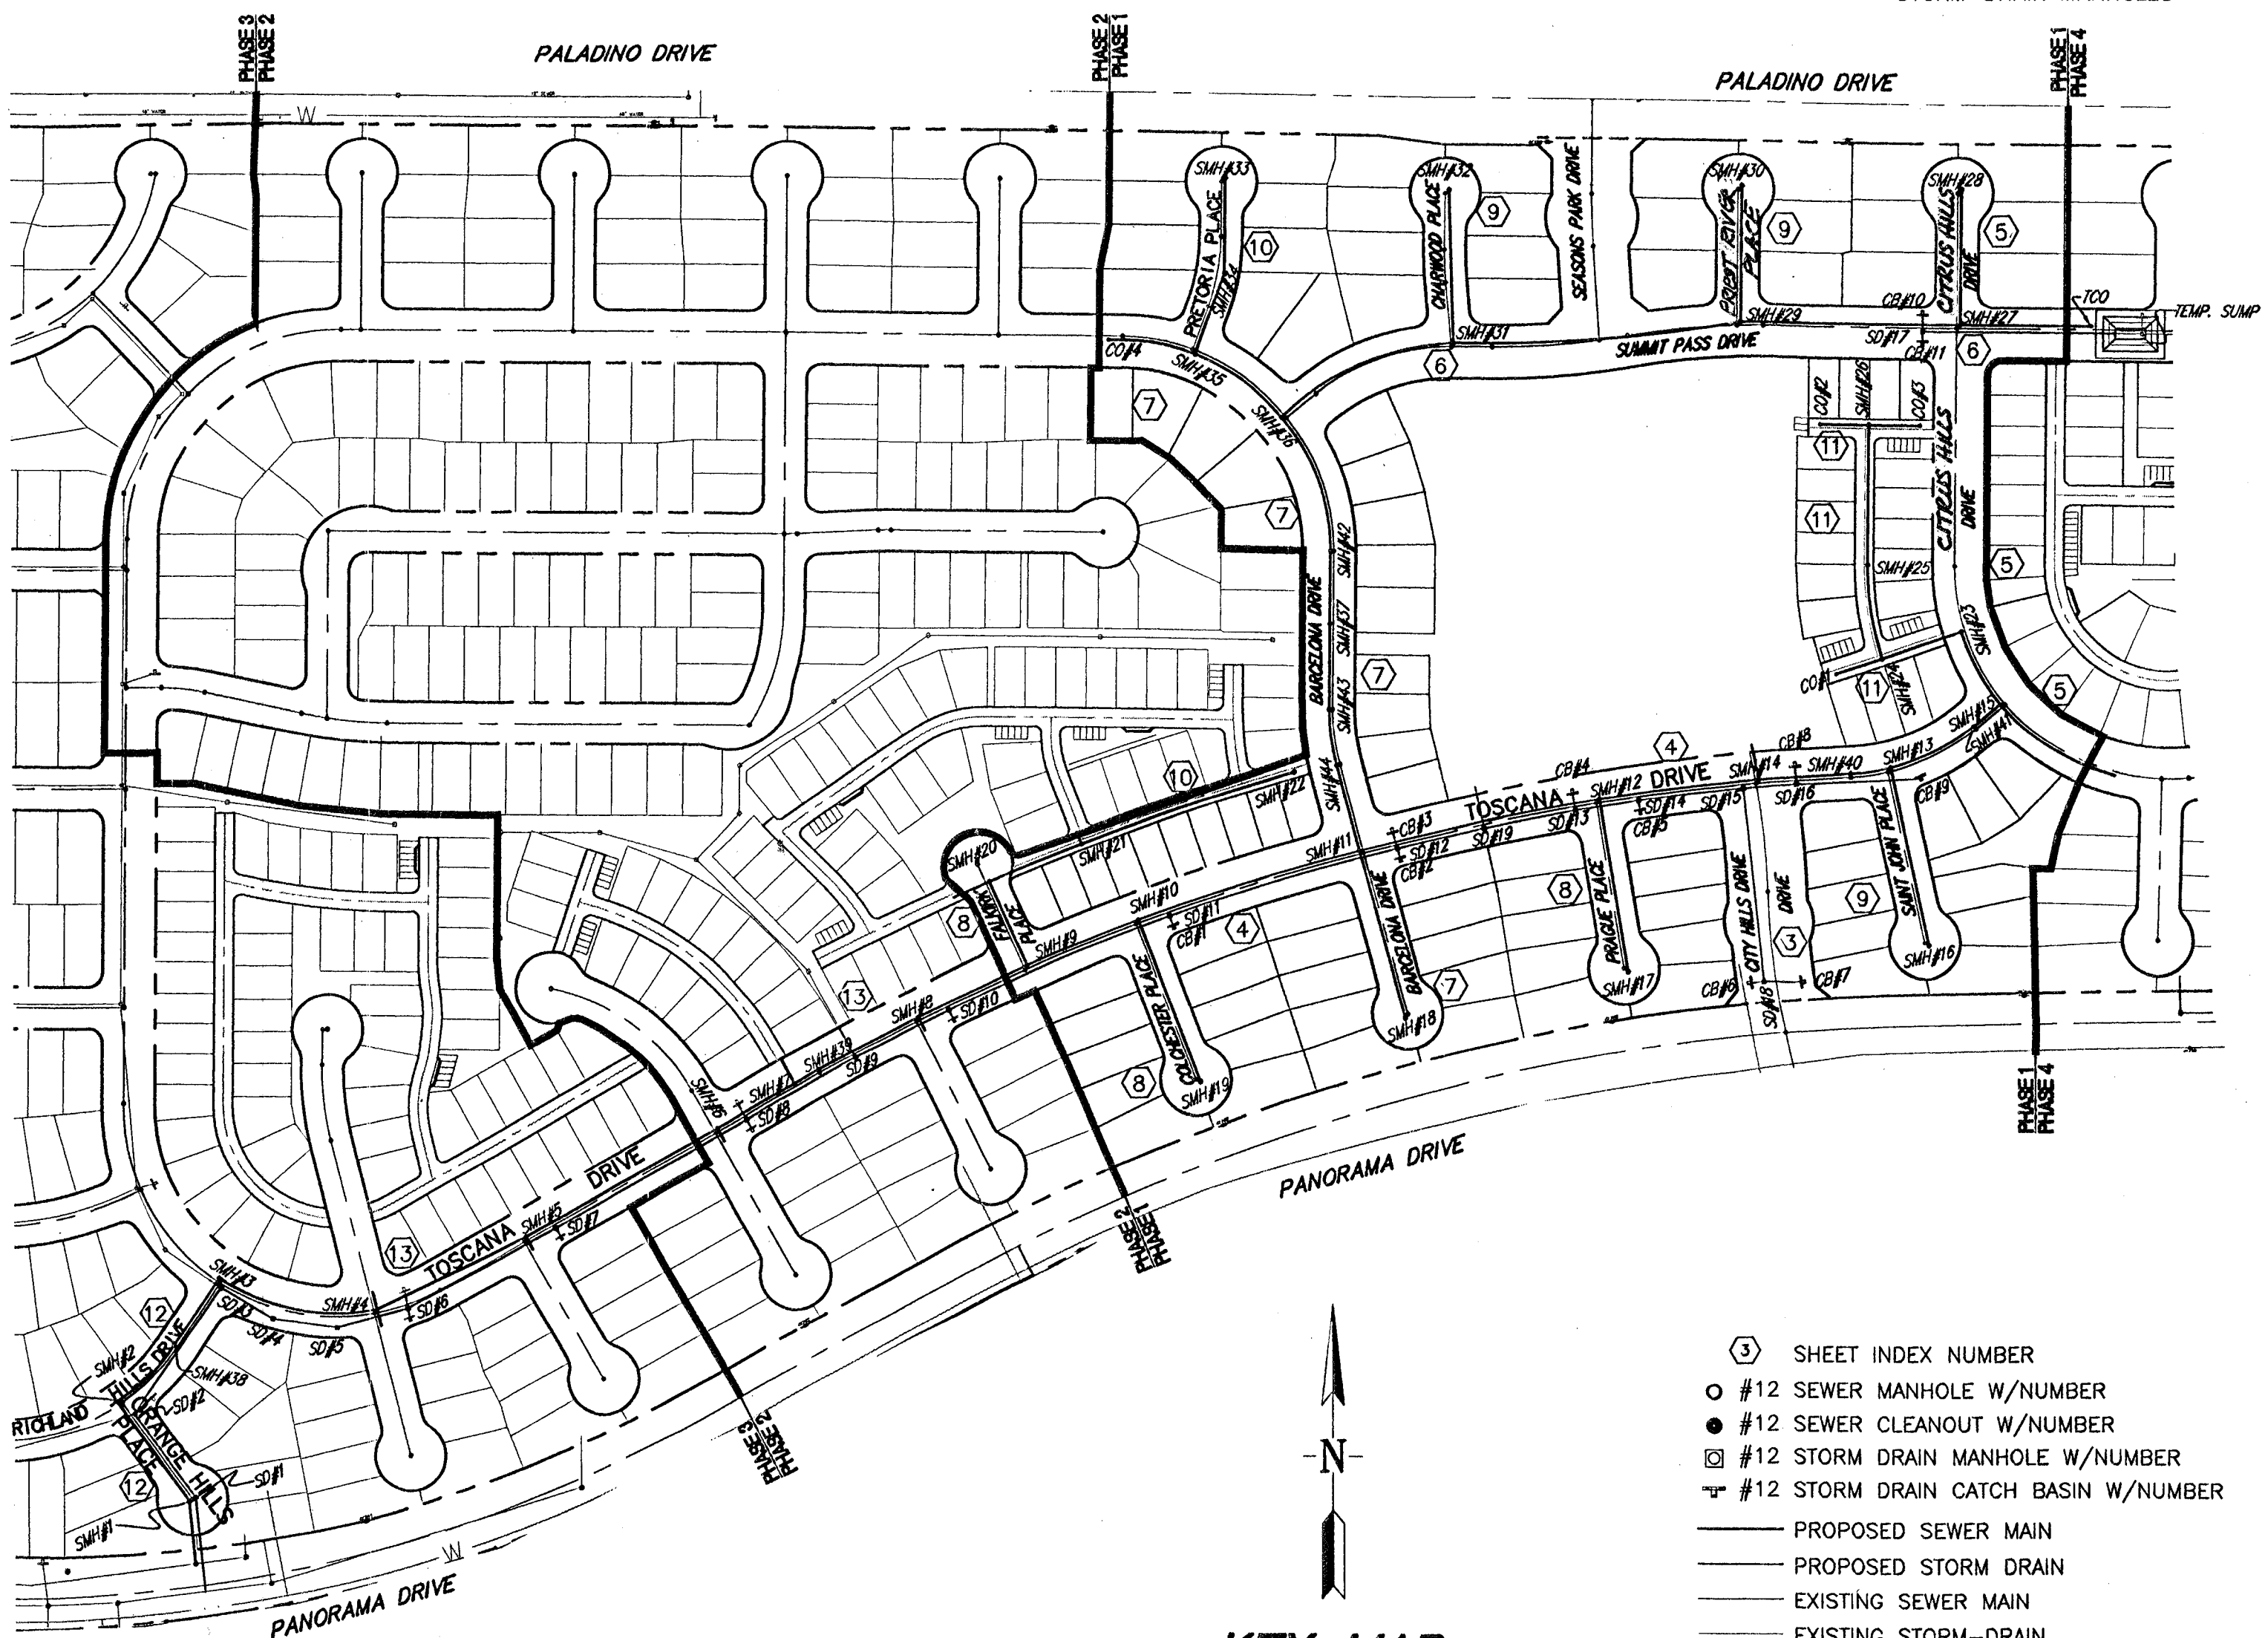

KEY MAP  
SCALE: 1"=200'

- 5 SHEET INDEX NUMBER
- #12 SEWER MANHOLE W/NUMBER
  - #12 SEWER CLEANOUT W/NUMBER
  - #12 STORM DRAIN MANHOLE W/NUMBER
  - ⊕ #12 STORM DRAIN CATCH BASIN W/NUMBER
- PROPOSED SEWER MAIN
- PROPOSED STORM DRAIN
- EXISTING SEWER MAIN
- EXISTING STORM-DRAIN

LEGEND

T.M.H.	TOP OF MANHOLE ELEVATION
T.C.O.	TOP OF CLEANOUT ELEVATION
INV.	PIPE INVERT ELEVATION
(E,S,N,W.)	(EAST, SOUTH, NORTH, WEST)
P.V.C.	POLYVINYL CHLORIDE
±	APPROXIMATE LENGTHS, CONTRACTOR SHALL VERIFY ALL LENGTHS PRIOR TO BIDDING THIS PROJECT
R.C.P.	REINFORCED CONCRETE PIPE
R.G.J.	RUBBER GASKET JOINT
EX.	EXISTING
C.B.	CATCH-BASIN
FL	FLOWLINE



CITY OF BAKERSFIELD  
SEWER SPECIFICATIONS

SEWER NOTES

- GENERAL CONTRACTOR WILL FURNISH ALL MATERIALS, TOOLS, LABOR, EQUIPMENT AND SUPERVISION NECESSARY TO COMPLETE INSTALLATION.
- VCP INSTALLATION:
  - MATERIALS: THE PIPE AND FITTINGS SHALL BE EXTRA STRENGTH VITRIFIED CLAY CONFORMING TO CURRENT ASTM DESIGNATION C-700, AND SHALL BE INSTALLED IN CONFORMANCE WITH THE PROVISIONS OF OF SECTIONS 71 OF THE STANDARD SPECIFICATIONS OF THE STATE OF CALIFORNIA, DEPARTMENT OF TRANSPORTATION, CURRENT EDITION AND THE CURRENT ASTM DESIGNATION C-12.
  - JOINTS:
    - THE PIPE AND FITTINGS SHALL HAVE A SOCKET END AND A SPIGOT END WITH COMPRESSION JOINTS CONFORMING WITH THE CURRENT ASTM DESIGNATION C-425.
    - THE PIPE FITTINGS FOR 6", 8", 10", AND 12" SANITARY SEWER MAINS MAY BE PLAIN-END WITH COMPRESSION COUPLINGS CONFORMING WITH THE CURRENT ASTM DESIGNATION C-425. EXCEPTING THAT A STAINLESS STEEL SHEAR RING AS MANUFACTURED BY MISSION CLAY PRODUCTS CORPORATION FOR THEIR "MAINLINE" BAND-SEAL COMPRESSION COUPLING, OR APPROVED EQUAL, SHALL BE REQUIRED.
    - THE PIPE AND FITTINGS FOR PRIVATE SANITARY SEWER HOUSE OR BUILDING LATERALS MAY BE PLAIN-END WITH COMPRESSION COUPLINGS CONFORMING WITH THE CURRENT ASTM DESIGNATION C-425. (STAINLESS STEEL SHEAR RINGS ARE NOT REQUIRED).
- ABS PIPE INSTALLATION:
  - MATERIALS: PIPE AND FITTINGS SHALL MEET THE REQUIREMENTS OF ASTM SPECIFICATIONS D 2680 AND D 2751. PIPE AND FITTINGS SHALL BE HOMOGENEOUS THROUGHOUT AND FREE FROM CRACKS, HOLES, FOREIGN INCLUSIONS OR OTHER INJURIOUS DEFECTS. FITTINGS SHALL BE INJECTION MOLDED AND SHALL BE INSTALLED IN LINE ON NEW PIPELINES; CUT-IN FITTINGS ARE NOT PERMITTED.
  - JOINTS: USE ONLY SOLVENT WELDED JOINTS. THE ASSEMBLY OF JOINTS SHALL BE IN ACCORDANCE WITH THE MANUFACTURER'S RECOMMENDATIONS. WHERE ABS PIPE CONNECTS TO VCP, USE COUPLINGS APPROVED BY THE CITY OF BAKERSFIELD.
  - INSTALLATION: PIPE AND FITTINGS SHOULD BE INSTALLED IN ACCORDANCE WITH ASTM D 2321. ONLY CLASS I, II OR III EMBEDMENT MATERIALS WILL BE CONSIDERED SUITABLE.
- PVC PIPE INSTALLATION:
  - MATERIALS: PIPE AND FITTINGS SHALL MEET THE REQUIREMENTS OF ASTM SPECIFICATIONS D 3034 AND SDR 35. PIPE AND FITTINGS SHALL BE HOMOGENEOUS THROUGHOUT AND FREE FROM CRACKS, HOLES, FOREIGN INCLUSIONS OR OTHER INJURIOUS DEFECTS. FITTINGS SHALL BE INJECTION MOLDED AND SHALL BE INSTALLED IN LINE ON NEW PIPELINES; CUT-IN FITTINGS ARE NOT PERMITTED.
  - JOINTS: USE ONLY ELASTOMERIC GASKET JOINTS. THE ASSEMBLY OF JOINTS SHALL BE IN ACCORDANCE WITH THE MANUFACTURER'S RECOMMENDATIONS. WHERE PVC PIPE CONNECTS TO VCP, USE COUPLINGS APPROVED BY THE CITY OF BAKERSFIELD.
  - INSTALLATION: PIPE AND FITTINGS SHOULD BE INSTALLED IN ACCORDANCE WITH ASTM D 2321. ONLY CLASS I OR II EMBEDMENT MATERIALS WILL BE CONSIDERED SUITABLE.
- SYSTEM TESTING:

INSTALLED PIPE SHALL BE TESTED IN ACCORDANCE WITH CHAPTER 1.3 OF THE SUBDIVISION DESIGN MANUAL AND WITH THE RECOMMENDATIONS OF THE MANUFACTURER AND ACCEPTABLE TO THE CITY OF BAKERSFIELD. 24 HOURS NOTICE WILL BE REQUIRED FOR TEST AND INSPECTION.
- WYE-FITTINGS SHALL BE INJECTION MOLDED IN-LINE AND SHALL BE USED FOR ALL LATERAL CONNECTIONS AND SHALL BE ROTATED A MINIMUM OF 23° AND A MAXIMUM OF 45° ABOVE THE HORIZONTAL PLANE RUNNING THROUGH THE CENTERLINE OF THE MAIN. WYE FITTINGS ONLY SHALL BE USED FOR VCP. ALL SEWER STUBS SHALL BE CLOSED WITH A STANDARD PLASTIC PLUG (SOLVENT WELDED).
- THE MANHOLES SHALL BE CONSTRUCTED IN ACCORDANCE WITH THE CITY OF BAKERSFIELD DRAWING S-7 AND S-8 AND SECTION 70-1.02H AND 71-1.07 OF THE STANDARD SPECIFICATIONS OF THE STATE OF CALIFORNIA, DEPARTMENT OF TRANSPORTATION, LATEST EDITION. THE CLEANOUTS SHALL BE CONSTRUCTED IN ACCORDANCE WITH THE CITY OF BAKERSFIELD STANDARD DRAWINGS S-20.
- ALL SEWER LATERALS TO BE 4" IN DIAMETER EXCEPT AS NOTED ON PLANS AND EXTEND 4 FEET BEYOND PROPERTY LINE.
- SURFACE MARKERS FOR SEWER LATERALS SHALL BE INSTALLED PER CITY OF BAKERSFIELD DRAWING SW-1.
- 24 HOUR NOTICE IS REQUIRED FOR TESTING AND INSPECTION.
- FOR CURVED PIPE: IDENTIFICATION TAPE DESIGNED FOR USE ON SEWERS SHALL BE PLACED ON TOP OF SEWER MAIN ALONG ITS ENTIRE LENGTH. IDENTIFICATION TAPE SHALL ALSO BE PLACED ON SEWER LATERALS EXTENDING 1 FOOT ABOVE SEWER MAIN TO RIGHT-OF-WAY LINE.

NOTE TO CONTRACTOR

ALL MANHOLES AND CLEANOUTS WITHIN TRACT, INCLUDING EXISTING MANHOLES, SHALL BE ADJUSTED TO FINISH GRADE IN ACCORDANCE WITH CITY STANDARDS. EXISTING MANHOLES MAY REQUIRE REMOVAL OF EXISTING CONE, AND REMOVAL OR "CHANGE OUT" OF BARREL RINGS.

GENERAL NOTES:

- CONTRACTOR SHALL OBTAIN ALL NECESSARY PERMITS BEFORE START OF CONSTRUCTION. A PERMIT SHALL BE OBTAINED FROM CITY PUBLIC WORKS DEPARTMENT FOR WORK TO BE DONE IN THE CITY STREET RIGHT-OF-WAY.
- ANY TRENCHING TO BE CONDUCTED WITHIN THIS PROJECT SHALL BE BACKFILLED AND COMPACTED PER CITY STANDARD DETAIL ST-22.
- THE CONTRACTOR SHALL REMOVE OR RELOCATE ALL OBSTRUCTIONS AS DIRECTED BY THE CITY ENGINEER.
- CONTRACTOR AGREES THAT HE SHALL ASSUME SOLE AND COMPLETE RESPONSIBILITY FOR JOB SITE CONDITIONS DURING THE COURSE OF CONSTRUCTION OF THE PROJECT, INCLUDING SAFETY OF ALL PERSONS AND PROPERTY; THAT THIS REQUIREMENT SHALL APPLY CONTINUOUSLY AND NOT BE LIMITED TO NORMAL WORKING HOURS; THAT THE CONTRACTOR SHALL DEFEND, INDEMNIFY AND HOLD THE OWNER AND THE ENGINEER HARMLESS FROM ANY AND ALL LIABILITY, REAL OR ALLEGED, IN CONNECTION WITH THE PERFORMANCE OF WORK ON THIS PROJECT, EXCEPTING FOR LIABILITY ARISING FROM THE SOLE NEGLIGENCE OF THE OWNER OR THE ENGINEER.
- IF A PROBLEM SHOULD ARISE DURING THE COURSE OF CONSTRUCTION, IT IS THE RESPONSIBILITY OF THE CONTRACTOR TO NOTIFY THE ENGINEER IMMEDIATELY PRIOR TO ANY FURTHER WORK.
- ALL CONSTRUCTION SHALL BE IN ACCORDANCE WITH CITY OF BAKERSFIELD STANDARDS AND STATE OF CALIFORNIA, DEPARTMENT OF TRANSPORTATION STANDARD SPECIFICATIONS, LATEST ADDITION.
- PRIOR TO THE START OF ANY PHASE OF CONSTRUCTION, THE CITY CONSTRUCTION INSPECTION DEPARTMENT SHALL BE GIVEN 24 HOURS NOTICE (661) 326-3049.
- ALL EXISTING IMPROVEMENTS (CURB, CUTTER, SIDEWALK, CROSS-GUTTER, FENCING, ETC.) THAT ARE REMOVED, DAMAGED, OR UNDERCUT SHALL BE REPAIRED OR REPLACED AS DIRECTED BY THE CITY ENGINEER.
- THE LOCATIONS OF EXISTING UTILITIES AND UNDERGROUND PIPELINES ARE SHOWN IN AN APPROXIMATE WAY ONLY. THE CONTRACTOR SHALL DETERMINE THE EXACT LOCATION AND DEPTH OF ALL EXISTING UTILITIES AND UNDERGROUND PIPELINES BEFORE COMMENCING WORK. HE AGREES TO BE FULLY RESPONSIBLE FOR ANY AND ALL DAMAGES WHICH MIGHT BE OCCASIONED BY HIS FAILURE TO EXACTLY LOCATE, PRESERVE AND PROTECT ANY AND ALL UNDERGROUND UTILITIES AND PIPELINES. THE CONTRACTOR SHALL CALL U.S.A. (UNDERGROUND SERVICE ALERT) 1-800-227-2600 TWO WORKING DAYS PRIOR TO ANY CONSTRUCTION OR EXCAVATION.
- IF THE CONTRACTOR IS IN DOUBT AS TO THE MEANING OF ANY PART OF THE PLAN AND SPECIFICATIONS OR FINDS DISCREPANCIES IN OR OMISSIONS FROM THE DRAWINGS, HE SHALL SUBMIT A WRITTEN REQUEST FOR AN INTERPRETATION OR A CORRECTION THEREOF, PRIOR TO FILING HIS BID PRICE FOR THE PROJECT.
- IN THE EVENT CONSTRUCTION STAKING BASED ON CONSULTANT'S PLANS, DRAWINGS OR OTHER DOCUMENTS IS ACCOMPLISHED BY OTHER THAN THE CONSULTANT, CLIENT AGREES TO HOLD CONSULTANT HARMLESS AND RELEASE CONSULTANT FROM ALL LIABILITY ARISING FROM THE USE OF SAID PLANS, DRAWINGS OR OTHER DOCUMENTS.
- ALL EXISTING PAVING AND SURFACING REMOVED, DAMAGED OR UNDERCUT SHALL BE REPLACED IN ACCORDANCE WITH CITY OF BAKERSFIELD DRAWING S-6.
- COMPACTION TESTS SHALL BE THE RESPONSIBILITY OF THE DEVELOPER. THE NUMBER AND LOCATION OF REQUIRED TESTS SHALL BE DETERMINED BY THE CITY ENGINEER. THE COST OF RETESTING DUE TO FAILED COMPACTION TESTS WILL BE BACKCHARGED TO THE CONTRACTOR.
- PINNACLE ENGINEERING SHALL NOT BE RESPONSIBLE OR LIABLE FOR UNAUTHORIZED CHANGES TO, OR USES OF, THESE PLANS. ALL CHANGES TO THESE PLANS MUST BE APPROVED IN WRITING BY PINNACLE ENGINEERING.
- SEE WATER AND STREET IMPROVEMENT PLANS FOR OTHER IMPROVEMENTS THAT ARE PART OF THIS PROJECT.
- THE CONTRACTOR SHALL BE RESPONSIBLE FOR DEWATERING ALL TRENCHES. IF TRENCHES OR PIPING BECOME DAMAGED DUE TO WATER INFILTRATION, IT SHALL BE THE CONTRACTORS RESPONSIBILITY TO REPAIR THE TRENCH AND PIPING TO THE SATISFACTION OF THE ENGINEER AT THE CONTRACTORS EXPENSE.
- FLOODING OR WATERJETTING SHALL NOT BE USED FOR BACKFILL COMPACTION.
- DRAWINGS SHOWN ON THIS SHEET ARE FOR REFERENCE ONLY. CONTRACTOR SHALL OBTAIN A COPY OF "CITY OF BAKERSFIELD SUBDIVISION STANDARDS" AND DRAWINGS FOR HIS USE. THESE STANDARD DRAWINGS SHALL BE CONSIDERED A PART OF THESE PLANS.
- NORMAL CONSTRUCTION STAKING WILL BE SUPPLIED ONE TIME BE THE DEVELOPER. ALL RESTAKING WILL BE BACKCHARGED TO THE CONTRACTOR.
- CONTRACTOR SHALL VERIFY LOCATIONS AND ELEVATIONS OF EXISTING SEWER LINES THAT THE NEW SYSTEM TIES INTO. ANY DISCREPANCIES SHALL BE REPORTED TO THE ENGINEER SO THAT ANY NECESSARY ADJUSTMENTS CAN BE MADE TO THE PLANS.
- PRIOR TO FINAL ACCEPTANCE, ALL SEWER LINES SHALL BE INSPECTED WITH VIDEO EQUIPMENT DESIGNED FOR THIS PURPOSE. THE TELEVISION CAMERA SHALL HAVE THE CAPABILITY OF ROTATING 360°, IN ORDER TO VIEW AND RECORD THE TOP AND SIDES OF THE PIPE, AS REQUIRED. THE VIDEO INSPECTION SHALL BE WITNESSED BY THE CITY'S CONSTRUCTION INSPECTOR, WHO WILL ALSO INITIAL AND DATE THE "CHAIN OF CUSTODY" FORM. THE SUBDIVIDER SHALL IMMEDIATELY NOTIFY CITY OF ANY PIPE LOCATIONS REVEALED TO BE NOT IN COMPLIANCE WITH THE SPECIFICATIONS. A RECORDED VIDEO CASSETTE, THE COMPLETED "CHAIN OF CUSTODY" FORM AND A WRITTEN LOG (WHICH INCLUDES THE STATIONING, BASED ON THE STATIONING OF THE APPROVED PLANS, OF ALL CONNECTED LATERALS) OF THE INSPECTION SHALL BE PROVIDED FOR VIEWING, AND SHALL BE APPROVED BY THE CITY ENGINEER PRIOR TO ACCEPTANCE. AFTER ACCEPTANCE, THE VIDEO CASSETTE SHALL BECOME THE PROPERTY OF THE CITY.
- AN OPEN STREET PERMIT SHALL BE OBTAINED FROM THE CITY OF BAKERSFIELD PUBLIC WORKS DEPARTMENT FOR ANY WORK PERFORMED WITHIN EXISTING ACCEPTED STREET RIGHT-OF-WAY, UNLESS REQUIRED BY A SUBDIVISION AGREEMENT, SECURITY BASED ON AN APPROVED ENGINEER'S ESTIMATE FOR THE WORK PERFORMED WITHIN THE RIGHT-OF-WAY AND INSURANCE AS REQUIRED SHALL BE PROVIDED PRIOR TO ISSUANCE OF A BUILDING PERMIT.
- CLASS I BEDDING AND EMBANKMENT IS REQUIRED FOR ALL PLASTIC SEWER PIPE WITHIN THE PIPE ZONE.
- CONTRACTOR TO VERIFY POSITIVE SLOPE FROM MANHOLE PRIOR TO CONNECTING TO EXISTING STUB. IF THE POSITIVE SLOPE DOES NOT EXIST, REPLACE STUB TO MANHOLE.

CITY OF BAKERSFIELD  
STORM DRAIN NOTES

STORM DRAIN PIPE:

UNLESS OTHERWISE SPECIFIED ON THESE PLANS, THE STORM DRAIN PIPE SHALL BE THE FOLLOWING:

REINFORCED CONCRETE PIPE (R.C.P.): REINFORCED CONCRETE PIPE SHALL BE CLASS III (ASTM C76) AND SHALL CONFORM TO THE REQUIREMENTS OF SECTION 65 OF THE STANDARD SPECIFICATIONS.


JOINTS SHALL BE RUBBER GASKETED IN CONFORMANCE WITH THE PROVISIONS OF SECTION 65.1.06 OF THE STANDARD SPECIFICATIONS.

CEMENT MORTAR JOINTS SHALL ONLY BE USED WHEN THE PIPE INVERT ELEVATION IS HIGHER THAN ONE HALF THE DRAINAGE SUMP DESIGN WATER SURFACE DEPTH ELEVATION.

CONCRETE PIPE SHALL BE LAID IN ACCORDANCE WITH THE REQUIREMENTS OF SECTION 65 OF THE STANDARD SPECIFICATIONS.

IN ADDITION TO THE ABOVE REQUIREMENTS, ALL RUBBER GASKETED JOINT RINGS SHALL BE CHECKED WITH A GAUGE ALL THE WAY AROUND THE PIPE AFTER THE JOINT HAS BEEN ASSEMBLED, TO DETERMINE THAT THE RING HAS BEEN PROPERLY LOCATED AND SEATED. IMPROPERLY MADE JOINTS SHALL BE PULLED APART AND SATISFACTORILY REMADE.

NOTE CLASS 1 BACKFILL IS NOT REQUIRED IF PIPE SLOPES EXCEEDS 1%

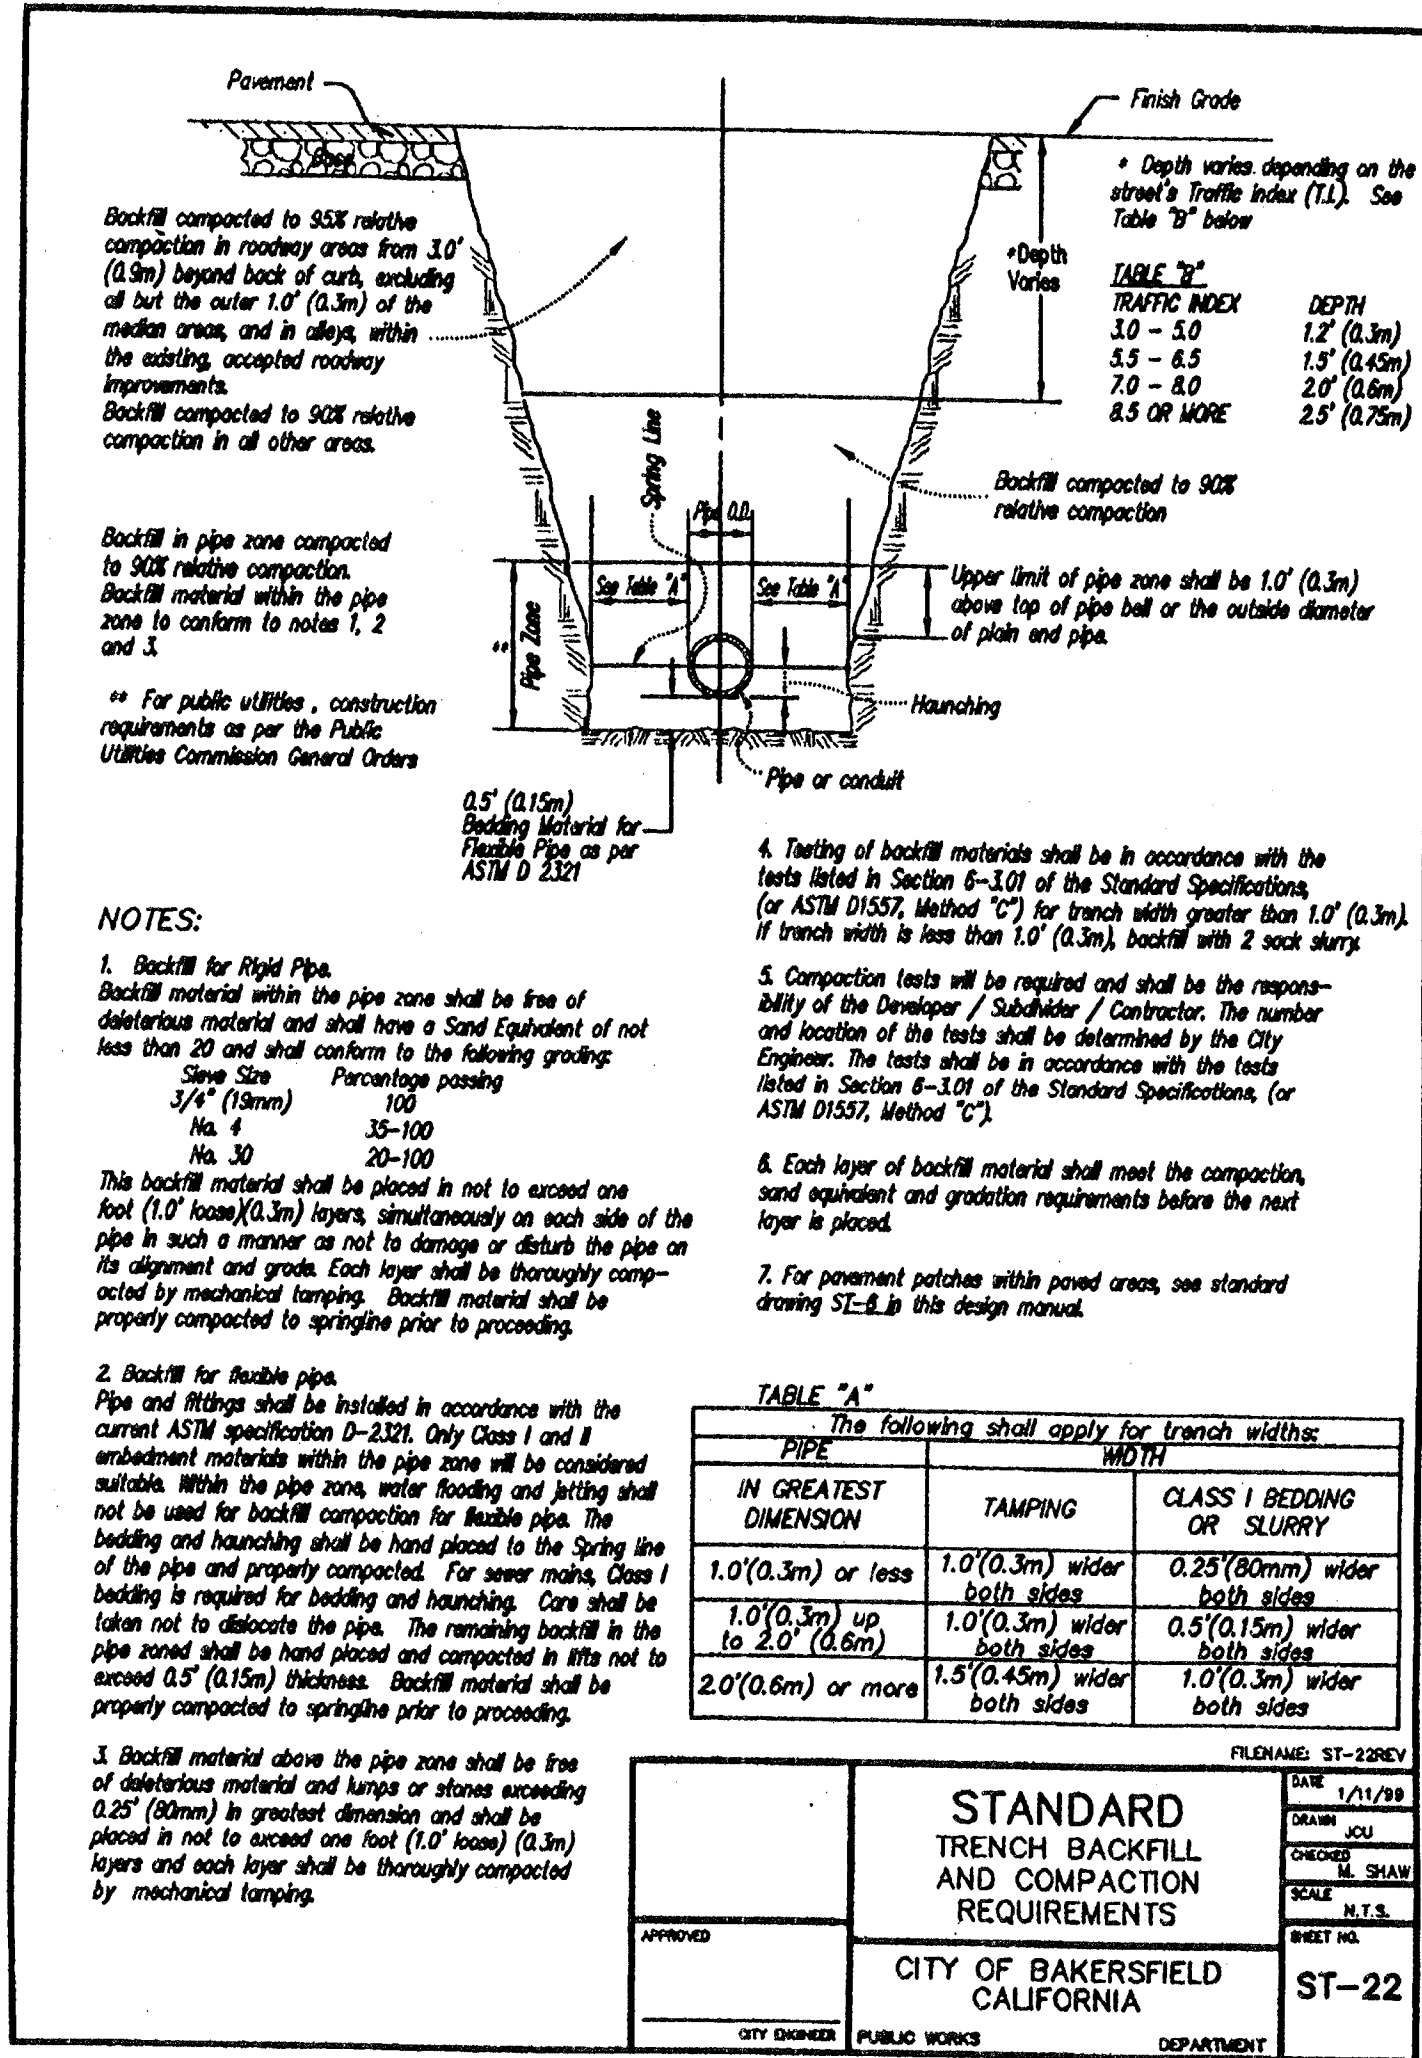


THE FOLLOWING CITY OF BAKERSFIELD STANDARD DRAWINGS SHALL BE CONSIDERED A PART OF THESE PLANS. (CONTRACTOR TO OBTAIN LATEST EDITION THEREOF)

CITY STD. NO.	DESCRIPTION	CITY STD. NO.	DESCRIPTION
<input checked="" type="checkbox"/> SW-1	SEWER LATERAL MARKER	<input type="checkbox"/> D-5	RIGHT OF WAY FOR NATURAL CHANNELS
<input type="checkbox"/> SW-2	TRENCH SECTION FOR CONCRETE ENCASED PIPE	<input type="checkbox"/> D-6	LANDSCAPED CONSTRUCTED CHANNELS
<input checked="" type="checkbox"/> SW-3	PAVEMENT PATCHES	<input type="checkbox"/> D-7	RIGHT OF WAY FOR CONSTRUCTED CHANNELS
<input checked="" type="checkbox"/> SW-4	MANHOLE, TYPE "A" WITH DROP CONNECTION	<input type="checkbox"/> D-8	RIGHT OF WAY FOR LINED CONSTRUCTED CHANNELS
<input checked="" type="checkbox"/> SW-5	FRAMES & COVER FOR MANHOLES & CLEANOUTS	<input checked="" type="checkbox"/> D-9	PIPE SADDLE DETAIL
<input checked="" type="checkbox"/> SW-6	6" CLEAN OUT	<input type="checkbox"/> D-10	SIDEWALK UNDERDRAIN
<input checked="" type="checkbox"/> SW-7	HOUSE CONNECTION WITH VCP SADDLE	<input type="checkbox"/> D-11	DRAINAGE BASIN
<input type="checkbox"/> SW-8	INDUSTRIAL SAND TRAP	<input type="checkbox"/> D-12	CHAIN LINK FENCES
<input type="checkbox"/> SW-10	SAND TRAP	<input type="checkbox"/> D-13	CHAIN LINK GATES
<input type="checkbox"/> SW-11	HOUSE CONNECTION WITH CAST IRON SADDLE	<input checked="" type="checkbox"/> D-14	CATCH BASIN, TYPE "A"
<input type="checkbox"/> SW-12	SEWER LIFT STATION VALVE BOX	<input type="checkbox"/> D-15	CATCH BASIN, TYPE "A-1"
<input type="checkbox"/> D-1	INTENSITY VS. DURATION CURVES	<input checked="" type="checkbox"/> D-16	GUTTER DEPRESSIONS
<input type="checkbox"/> D-2	RATIONAL METHOD RUNOFF COEFFICIENTS	<input type="checkbox"/> D-17	JUNCTION BOX
<input type="checkbox"/> D-3	CHANNEL PROTECTION	<input type="checkbox"/> D-18	MANHOLE, TYPE "B"
<input type="checkbox"/> D-4	CHANNEL PROTECTION	<input type="checkbox"/> D-19	DRAINAGE WELL, TYPE "B"
		<input checked="" type="checkbox"/> ST-22	TRENCH BACKFILL & COMPACTION

RECORD DRAWING

MATTHEW K. VOVILA  
RCE 43130 EXPIRES 3-31-06

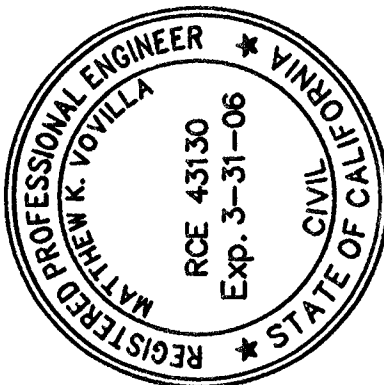

PINNACLE Civil Engineering, Inc.

1712 19th Street, Suite 101, Bakersfield, CA 93301  
Phone: (661) 869-0184 Fax: (661) 328-0607

TRACT NO. 6444 - PHASE 1  
SEWER & STORM DRAIN PLANS  
K. HOVNANIAN  
DETAILS - GENERAL NOTES

JOB No.: 04-158  
DWG NO.: 04-158SWRBM01  
DATE: 11/21/05  
DRAWN BY: MJS  
CHECKED BY: MKV  
SHEET 2  
OF 13 SHEETS

12-6444 1




# LEGEND



- PROPOSED SEWER MANHOLE w/NUMBER
- 8" S PROPOSED SEWER LINE w/SIZE
- PROPOSED RIGHT-OF-WAY
- SEWER STATION
- SD STORMDRAIN STATION

ALL SEWER LATERALS ARE 4" UNLESS OTHERWISE NOTED  
ALL SEWER LATERALS ARE TO HAVE A 4.5' MIN. - 7' MAX. OF COVER AT THE PROPERTY LINE AND A MINIMUM OF 2.5' OF COVER AT GUTTER FLOWLINE.

- PROPOSED STORM-DRAIN MANHOLE
- 18" SD PROPOSED STORM-DRAIN LINE w/SIZE
- CONSTRUCT TYPE "A" CATCH BASIN PER C.O.B. STD. DWG. D-14

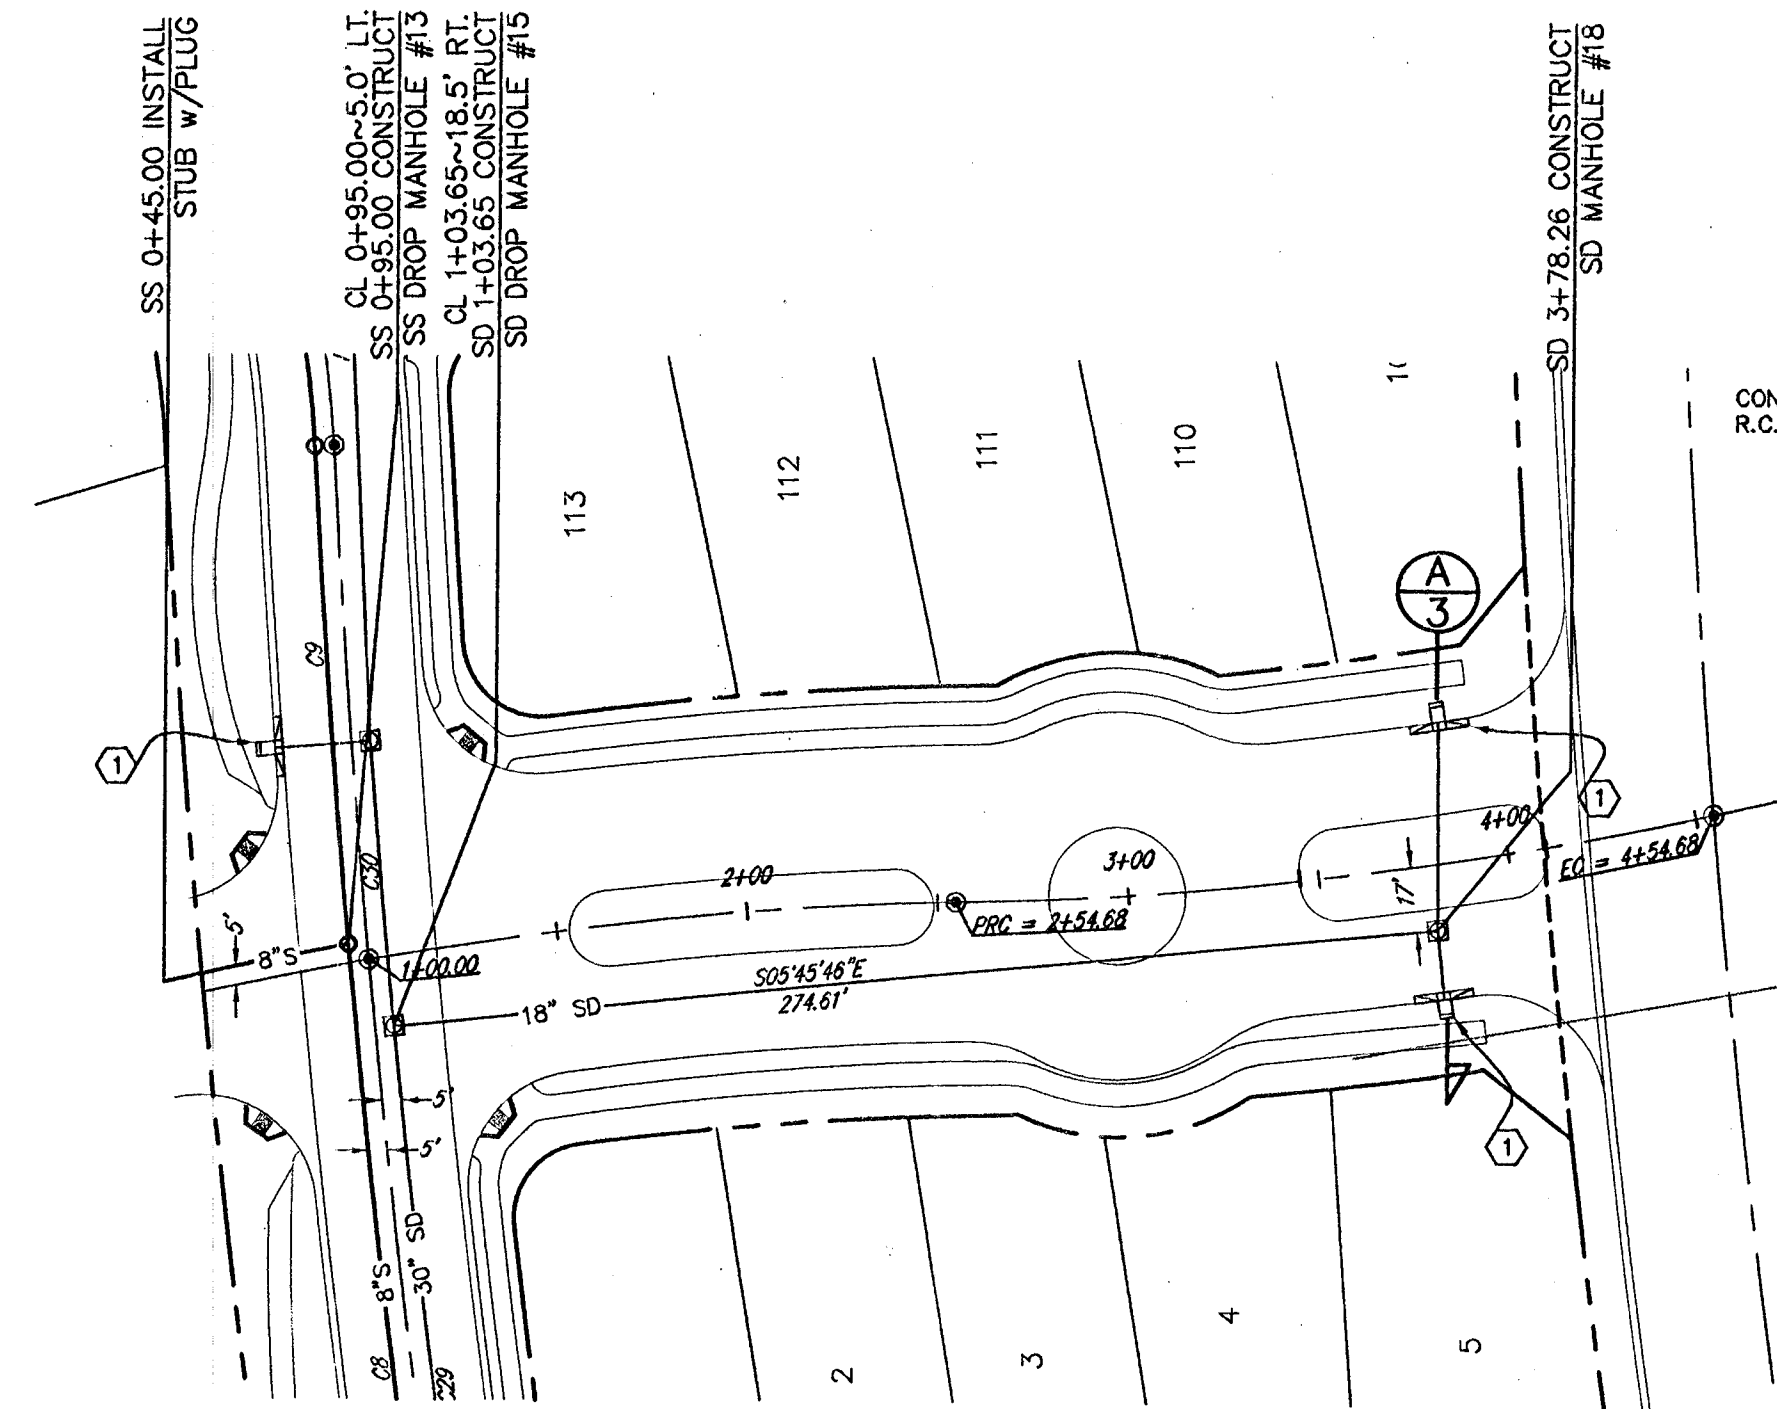

## CITY HILLS DRIVE (PRIVATE)

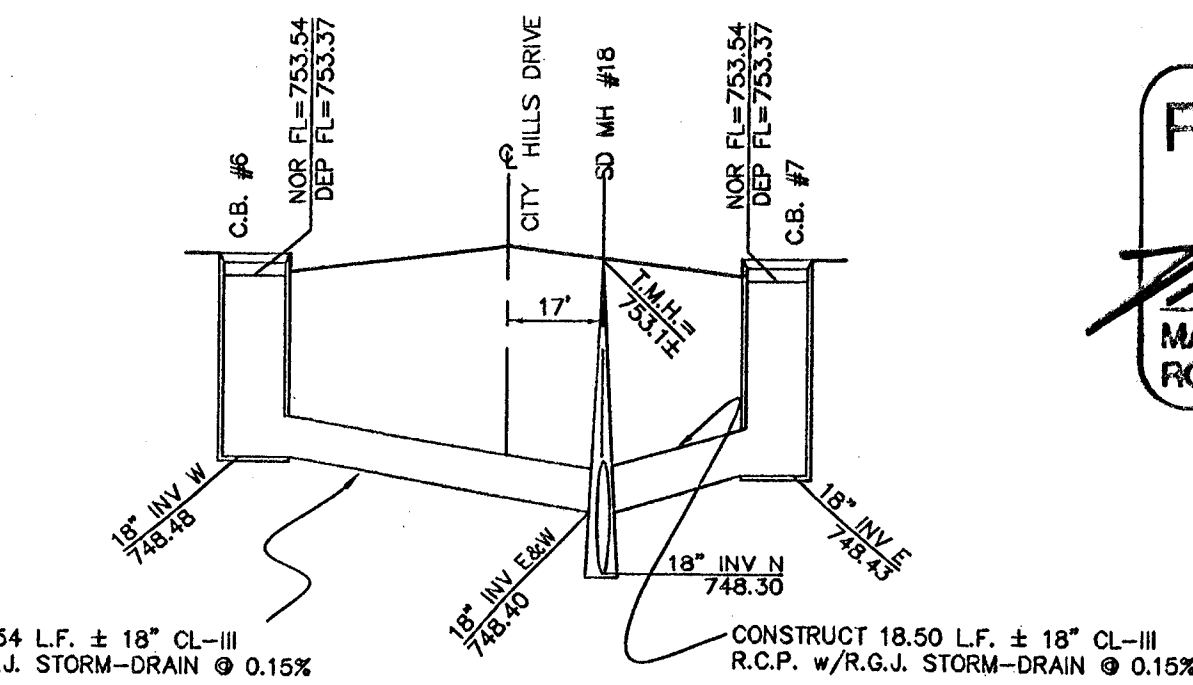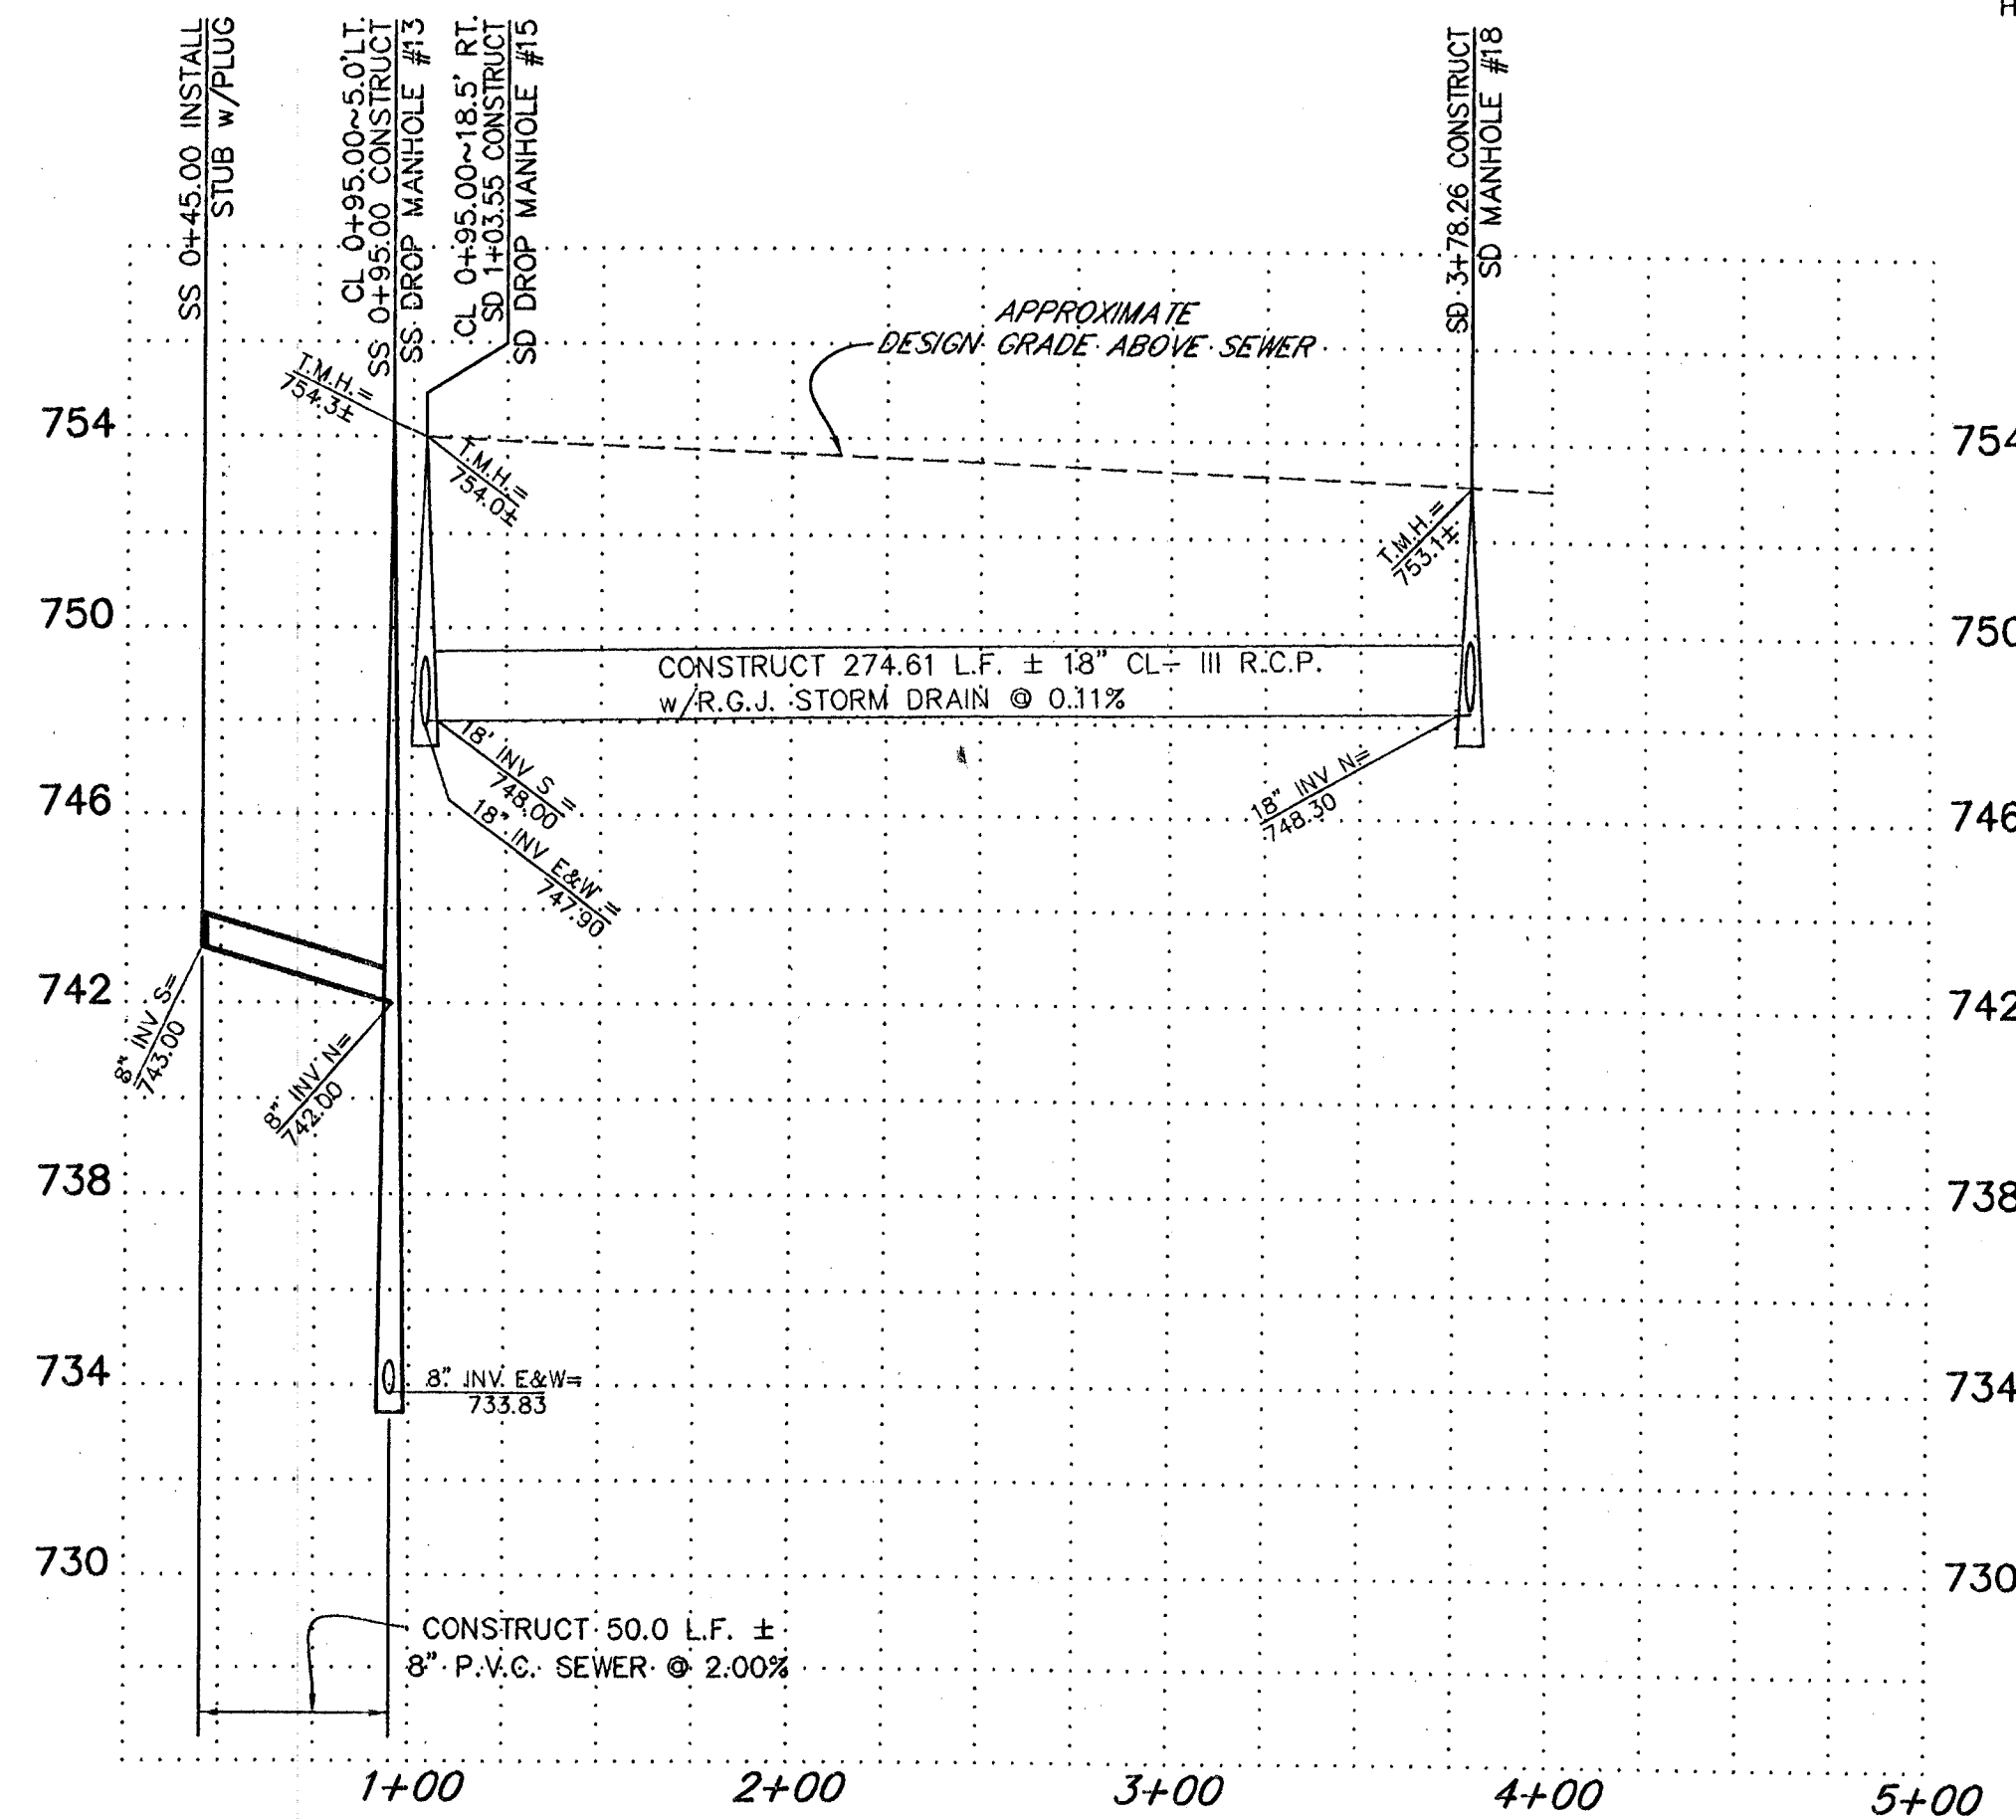


STORM-DRAIN SECTION  
NO SCALE

## RECORD DRAWING

MATTHEW K. VOVILLA  
RCE 43130 EXPIRES 3-31-06

DATE

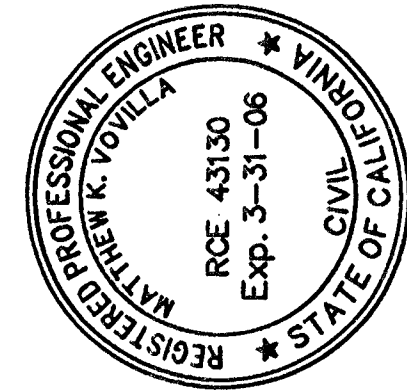

**PINNACLE Civil Engineering, Inc.**


1712 19th Street, Suite 101, Bakersfield, CA 93301  
Phone: (661) 869-0184 Fax: (661) 328-0607

TRACT NO. 6444 - PHASE 1  
SEWER & STORM DRAIN PLANS  
K. HOVNANIAN  
BAKERSFIELD, CALIFORNIA

TRACT NO. 6444 - PHASE 1  
SEWER & STORM DRAIN PLANS  
K. HOVNANIAN  
BAKERSFIELD, CALIFORNIA

JOB NO.	04-158
DWG NO.	04-158SVRBM01
DATE	11/21/05
DRAWN BY	MJS
CHECKED BY	MKV
SHEET	3
OF 13 SHEETS	

1.2-6444 1

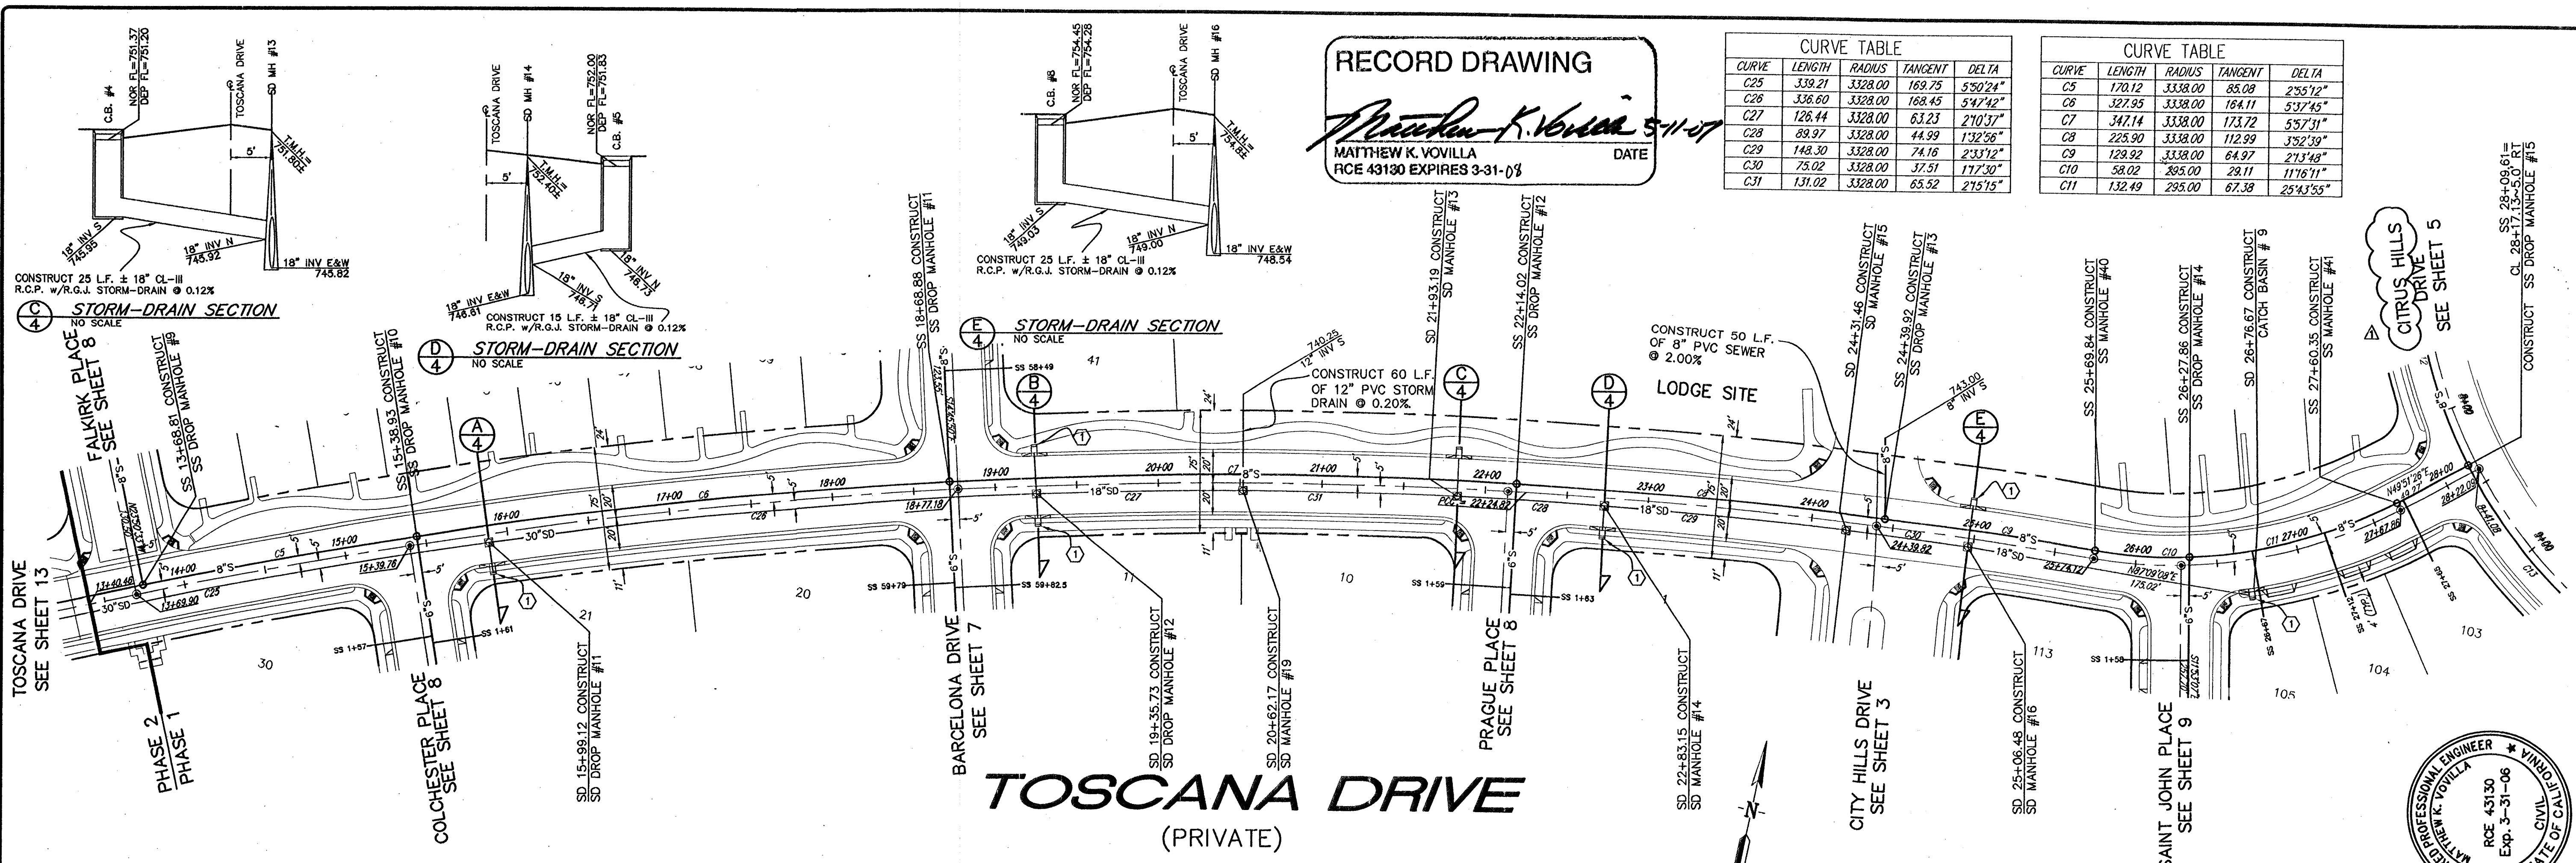

CURVE TABLE				
CURVE	LENGTH	RADIUS	TANGENT	DELTA
C25	339.21	3328.00	169.75	55°24'
C26	336.60	3328.00	168.45	54°42'
C27	126.44	3328.00	63.23	21°37'
C28	89.97	3328.00	44.99	13°56'
C29	148.30	3328.00	74.16	23°32'
C30	73.02	3328.00	37.51	11°30'
C31	131.02	3328.00	65.52	21°15'

CURVE TABLE				
CURVE	LENGTH	RADIUS	TANGENT	DELTA
C5	170.12	3338.00	85.08	2°55'12"
C6	327.95	3338.00	164.11	5°37'45"
C7	347.74	3338.00	173.72	5°57'31"
C8	225.90	3338.00	112.99	3°52'39"
C9	129.92	3338.00	64.97	2°13'48"
C10	58.02	295.00	29.11	1°16'11"
C11	132.40	295.00	67.18	2°54'15"

RECORD DRAWING

*Matthew K. Vovilla*

MATTHEW K. VOVILLA DATE  
RCE 43130 EXPIRES 3-31-08

**PINNACLE** Civil Engineering, Inc.  
1712 19th Street, Suite 101, Bakersfield, CA 93301  
Phone: (661) 869-0184 Fax: (661) 328-0607


<i>Matthew K Vovilla</i>	DATE
MATTHEW K VOVILLA	5/16/06
REVISIONS	
UPDATED STREET NAMES	

**TRACT NO. 6444 - PHASE 1  
SEWER & STORM DRAIN PLANS  
K. HOVNANIAN  
BAKERSFIELD, CALIFORNIA**

JOB NO.:	04-158
DWG NO.:	04-158SWRBM01
DATE:	11/21/05
DRAWN BY:	MJS
CHECKED BY:	MKV
SHEET 4	
OF 13	SHEETS




- LEGEND**
- PROPOSED SEWER MANHOLE w/NUMBER
  - 8" S PROPOSED SEWER LINE w/SIZE
  - PROPOSED RIGHT-OF-WAY
  - SS SEWER STATION
  - SD STORMDRAIN STATION
- ALL SEWER LATERALS ARE 4" UNLESS OTHERWISE NOTED
- ALL SEWER LATERALS ARE TO HAVE A 4.5' MIN. - 7' MAX. OF COVER AT THE PROPERTY LINE AND A MINIMUM OF 2.5' OF COVER AT GUTTER FLOWLINE.
- PROPOSED STORM-DRAIN MANHOLE
  - 18" SD PROPOSED STORM-DRAIN LINE w/SIZE
  - CONSTRUCT TYPE "A" CATCH BASIN PER C.O.B. STD. DWG. D-14

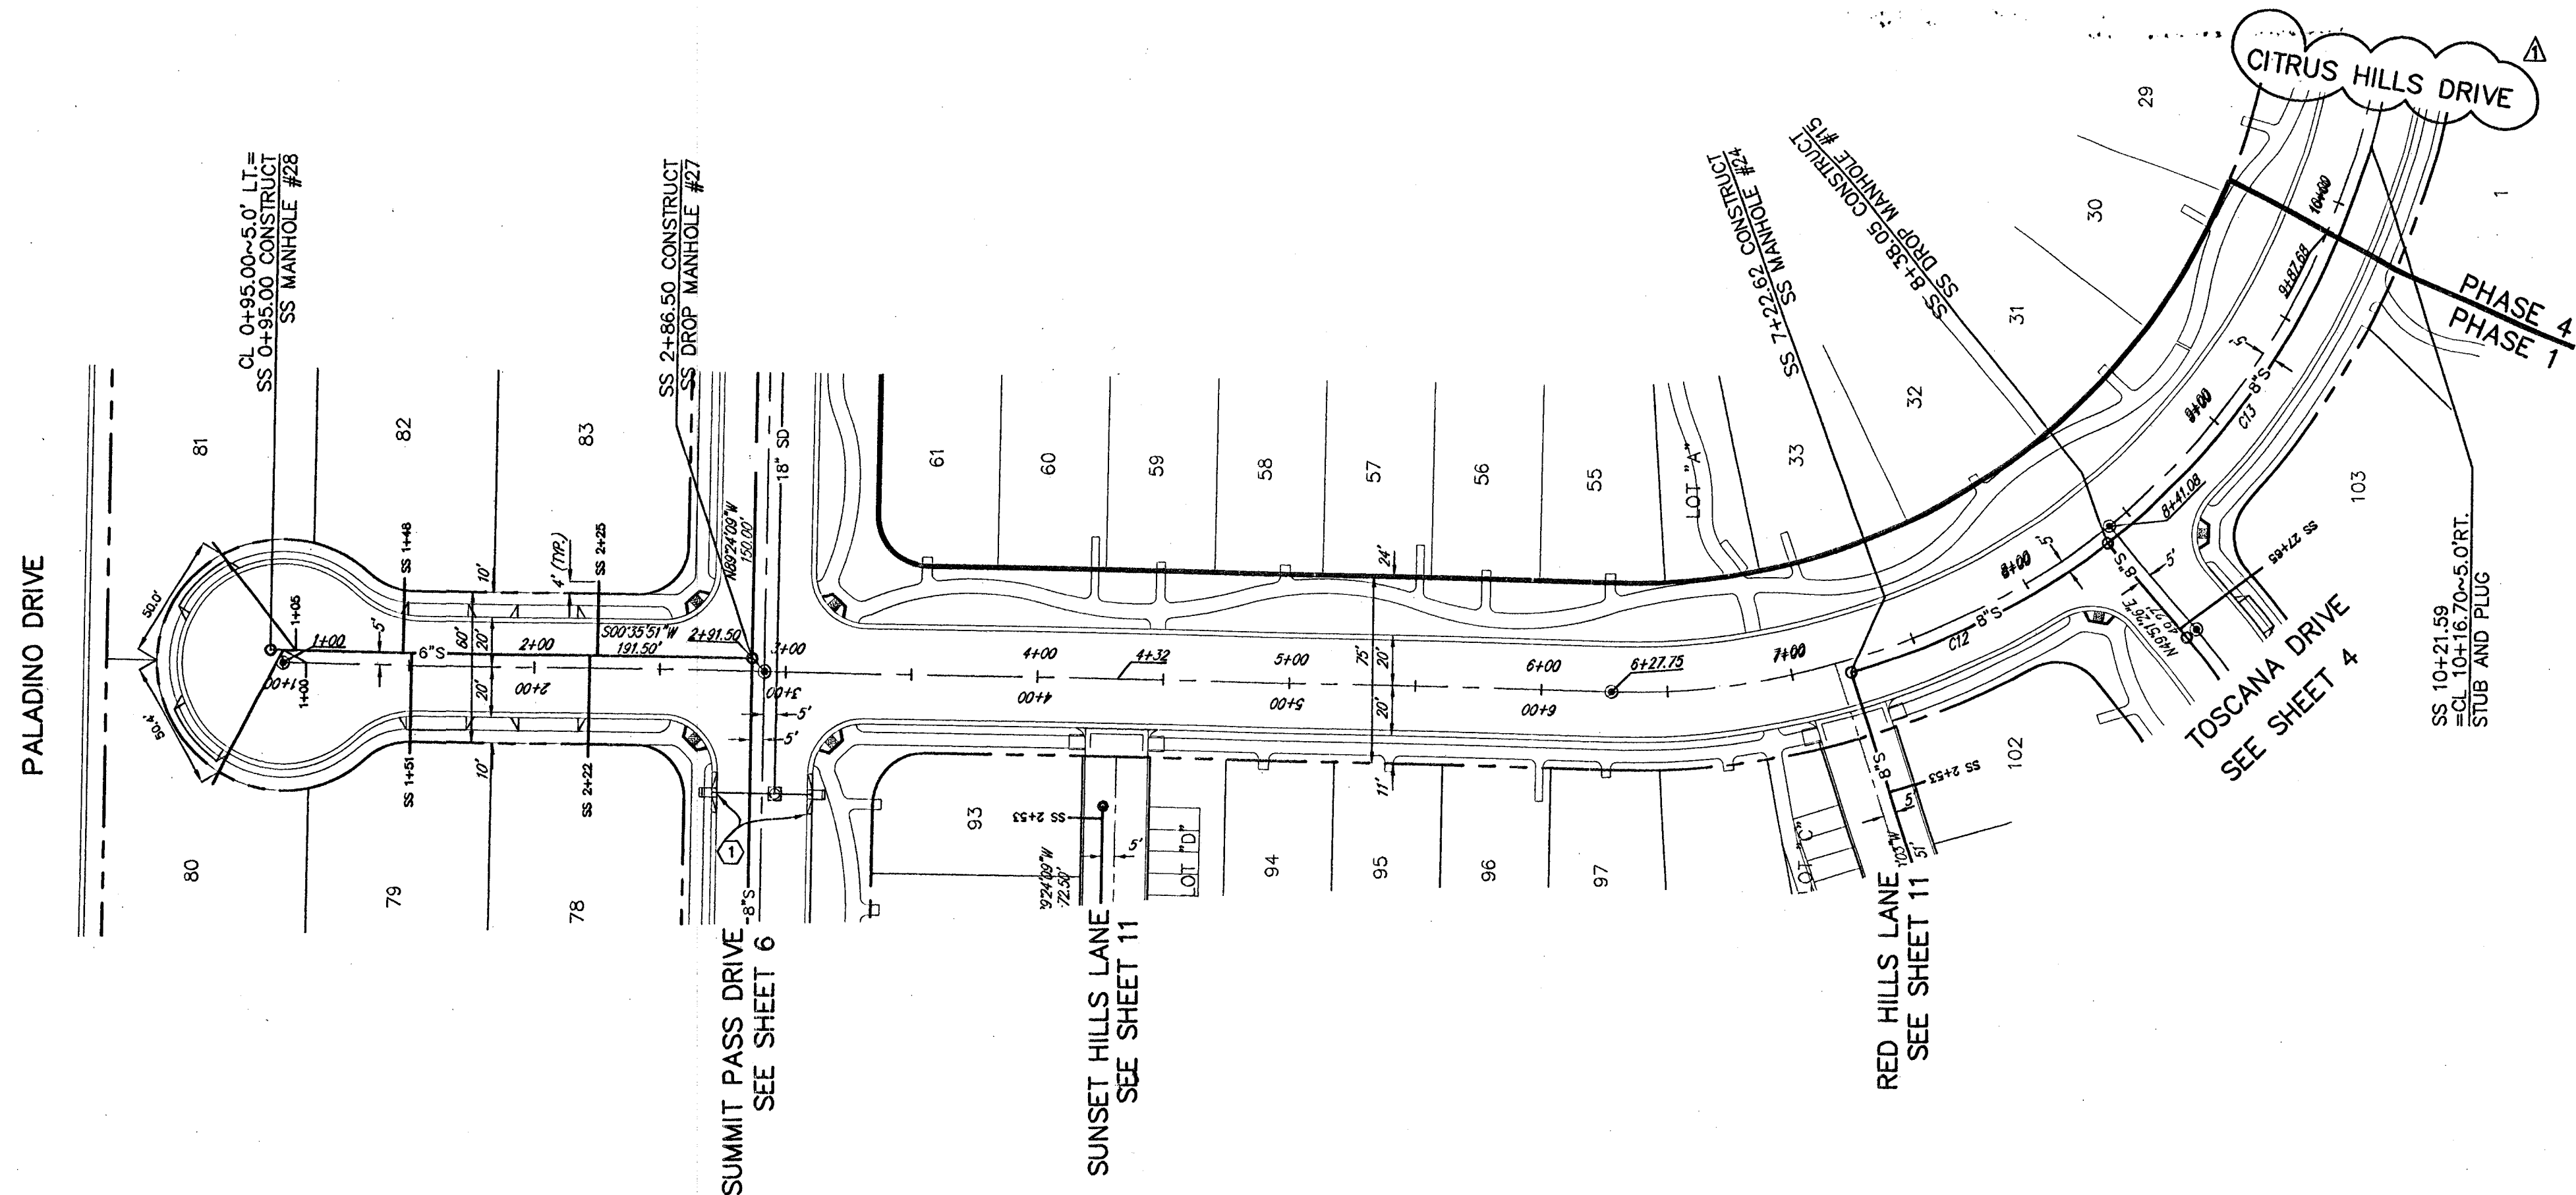


CURVE TABLE				
CURVE	LENGTH	RADIUS	TANGENT	DELTA
C12	115.43	303.03	58.41	21°40'55"
C13	183.54	305.00	94.65	34°28'53"

RECORD DRAWING

*Matthew K. Vovilla* 5-11-07  
DATE  
MATTHEW K. VOVILLA  
RCE 43130 EXPIRES 3-31-08

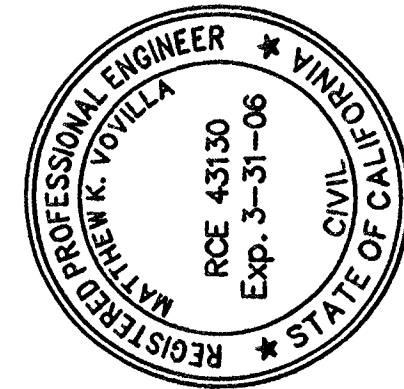

HORIZONTAL: 1" = 50'  
VERTICAL: 1" = 4'

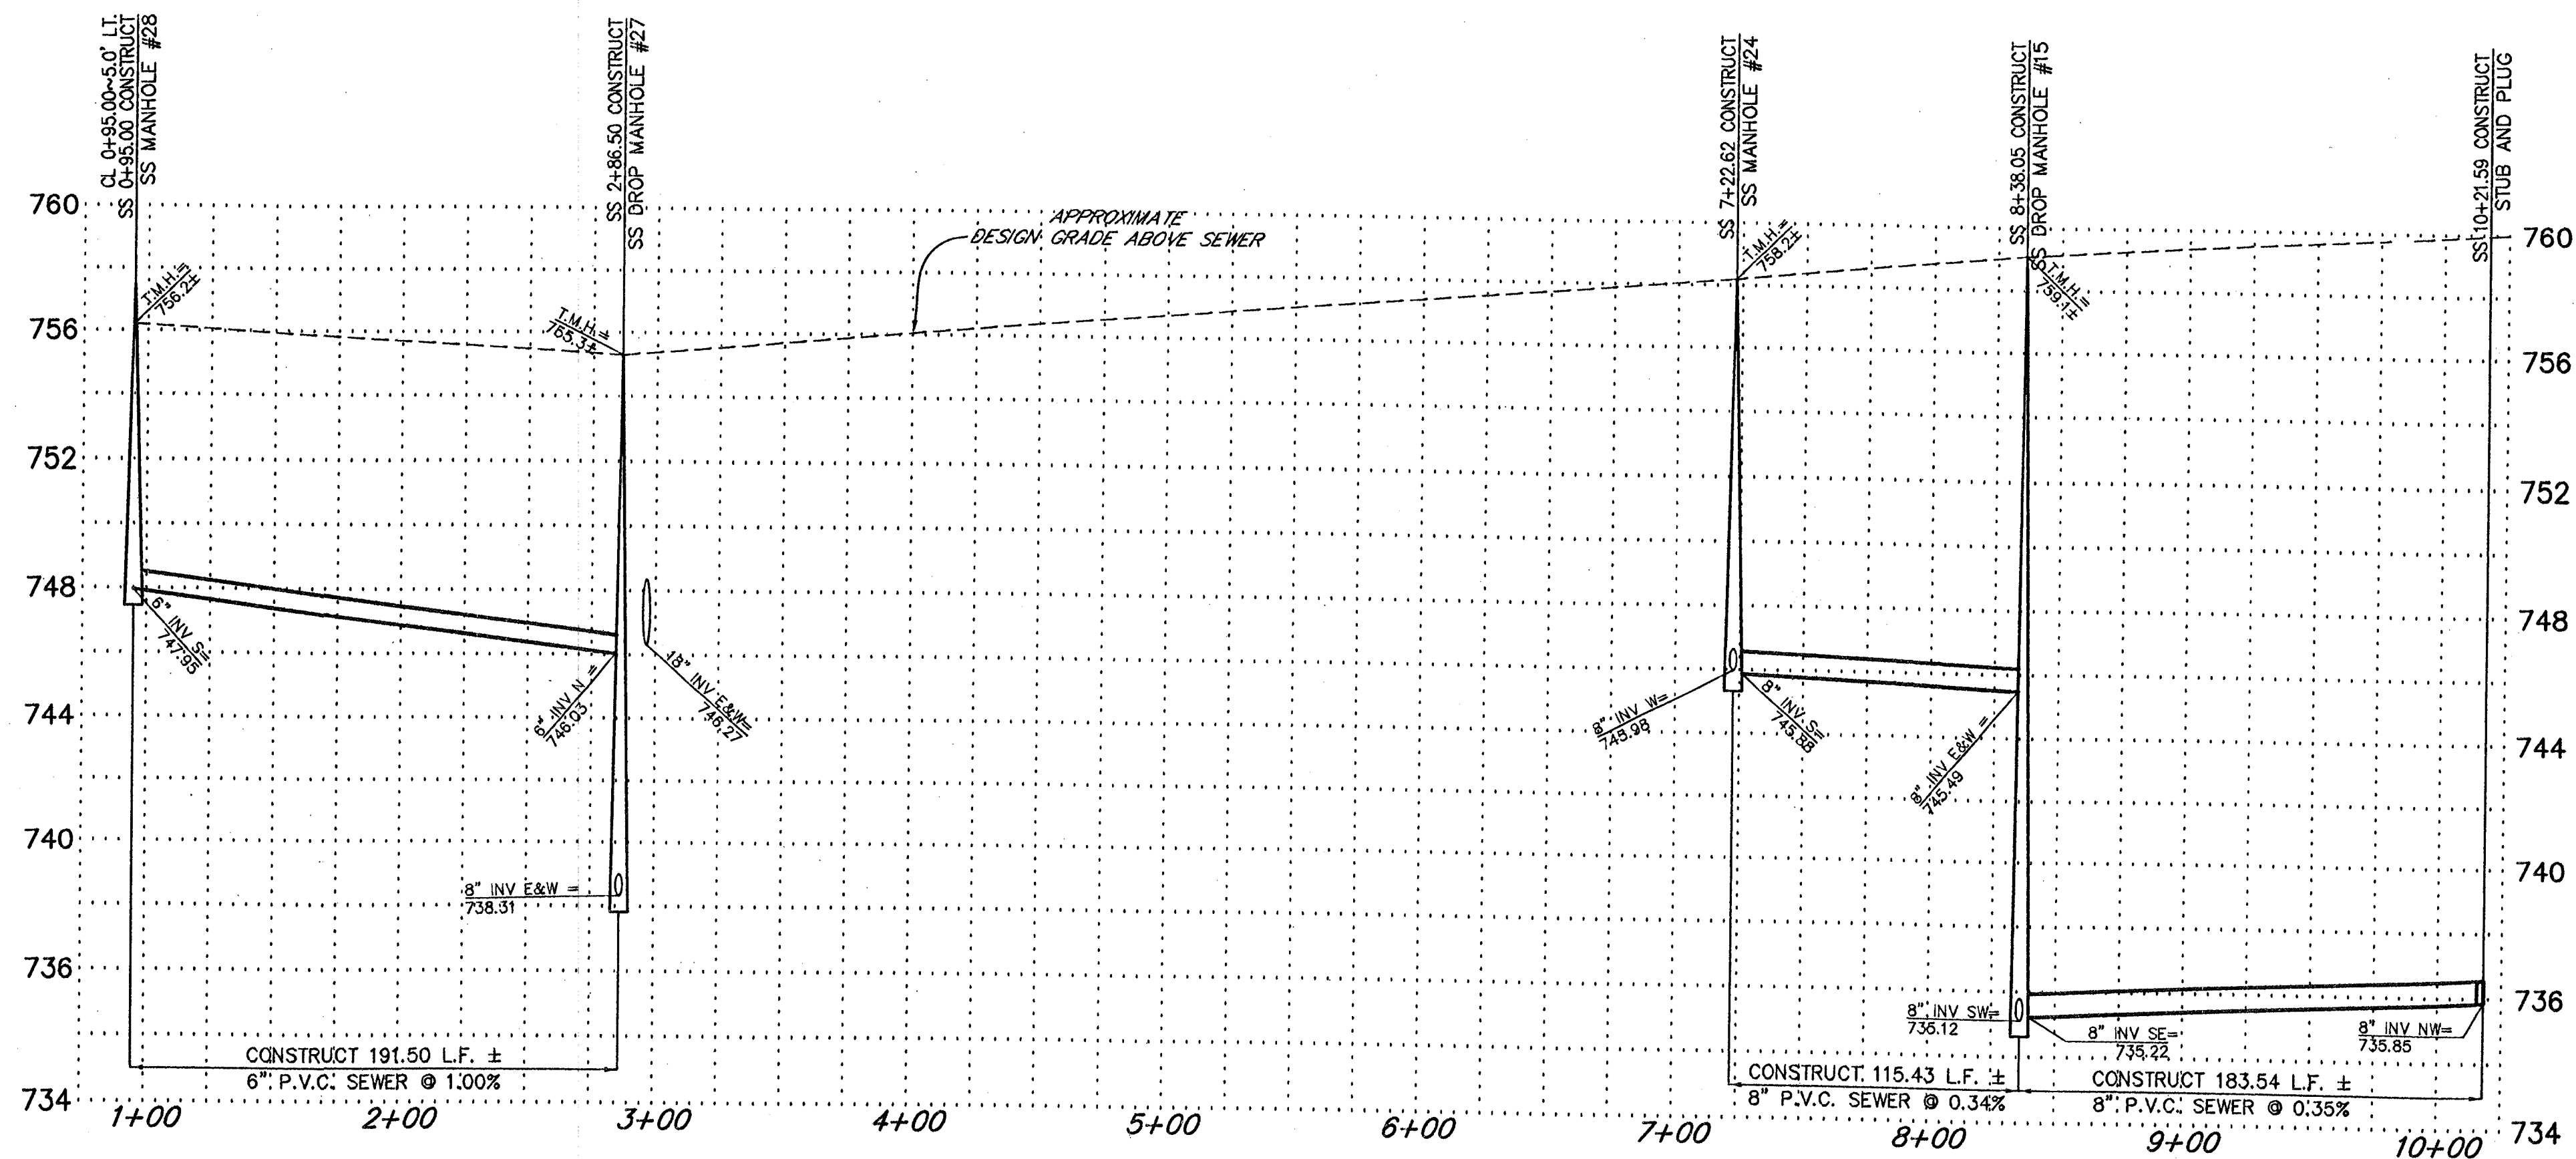

**PINNACLE Civil Engineering, Inc.**  
1712 19th Street, Suite 101, Bakersfield, CA 93301  
Phone: (661) 869-0184 Fax: (661) 328-0607



*Matthew K. Vovilla* 11-21-05  
MATTHEW K. VOVILLA RCE 43130 EXP. 3/31/08  
DATE  
A. UPDATED STREET NAMES 3/18/06  
REVISIONS

**TRACT NO. 6444 - PHASE 1  
SEWER & STORM DRAIN PLANS  
K. HOVNANIAN  
BAKERSFIELD, CALIFORNIA**  
DRAWN BY: MJS  
CHECKED BY: MKV  
SHEET 5  
OF 13 SHEETS

JOB NO.: 04-158  
DWG NO.: 04-158S\WRB\01  
DATE: 11/21/05  
DRAWN BY: MJS  
CHECKED BY: MKV  
SHEET 5  
OF 13 SHEETS

112-6444 1




	PROPOSED SEWER MANHOLE w/NUMBER
	PROPOSED SEWER LINE w/SIZE
	PROPOSED RIGHT-OF-WAY
SS	SEWER STATION
SD	STORMDRAIN STATION

☒ PROPOSED STORM-DRAIN MANHOLE  
 —18" SD— PROPOSED STORM-DRAIN LINE w/SIZE  
 (1) CONSTRUCT TYPE "A" CATCH BASIN PER C.O.B.  
 STD. DWG. D-14

MATTHEW K. VOVILLA  
DCE 45120 EXPIRES 3-31-08

CURVE TABLE				
CURVE	LENGTH	RADIUS	TANGENT	DELTA
C14	270.34	368.14	141.59	42°04'29"
C21	406.30	1963.51	203.88	11°51'21"

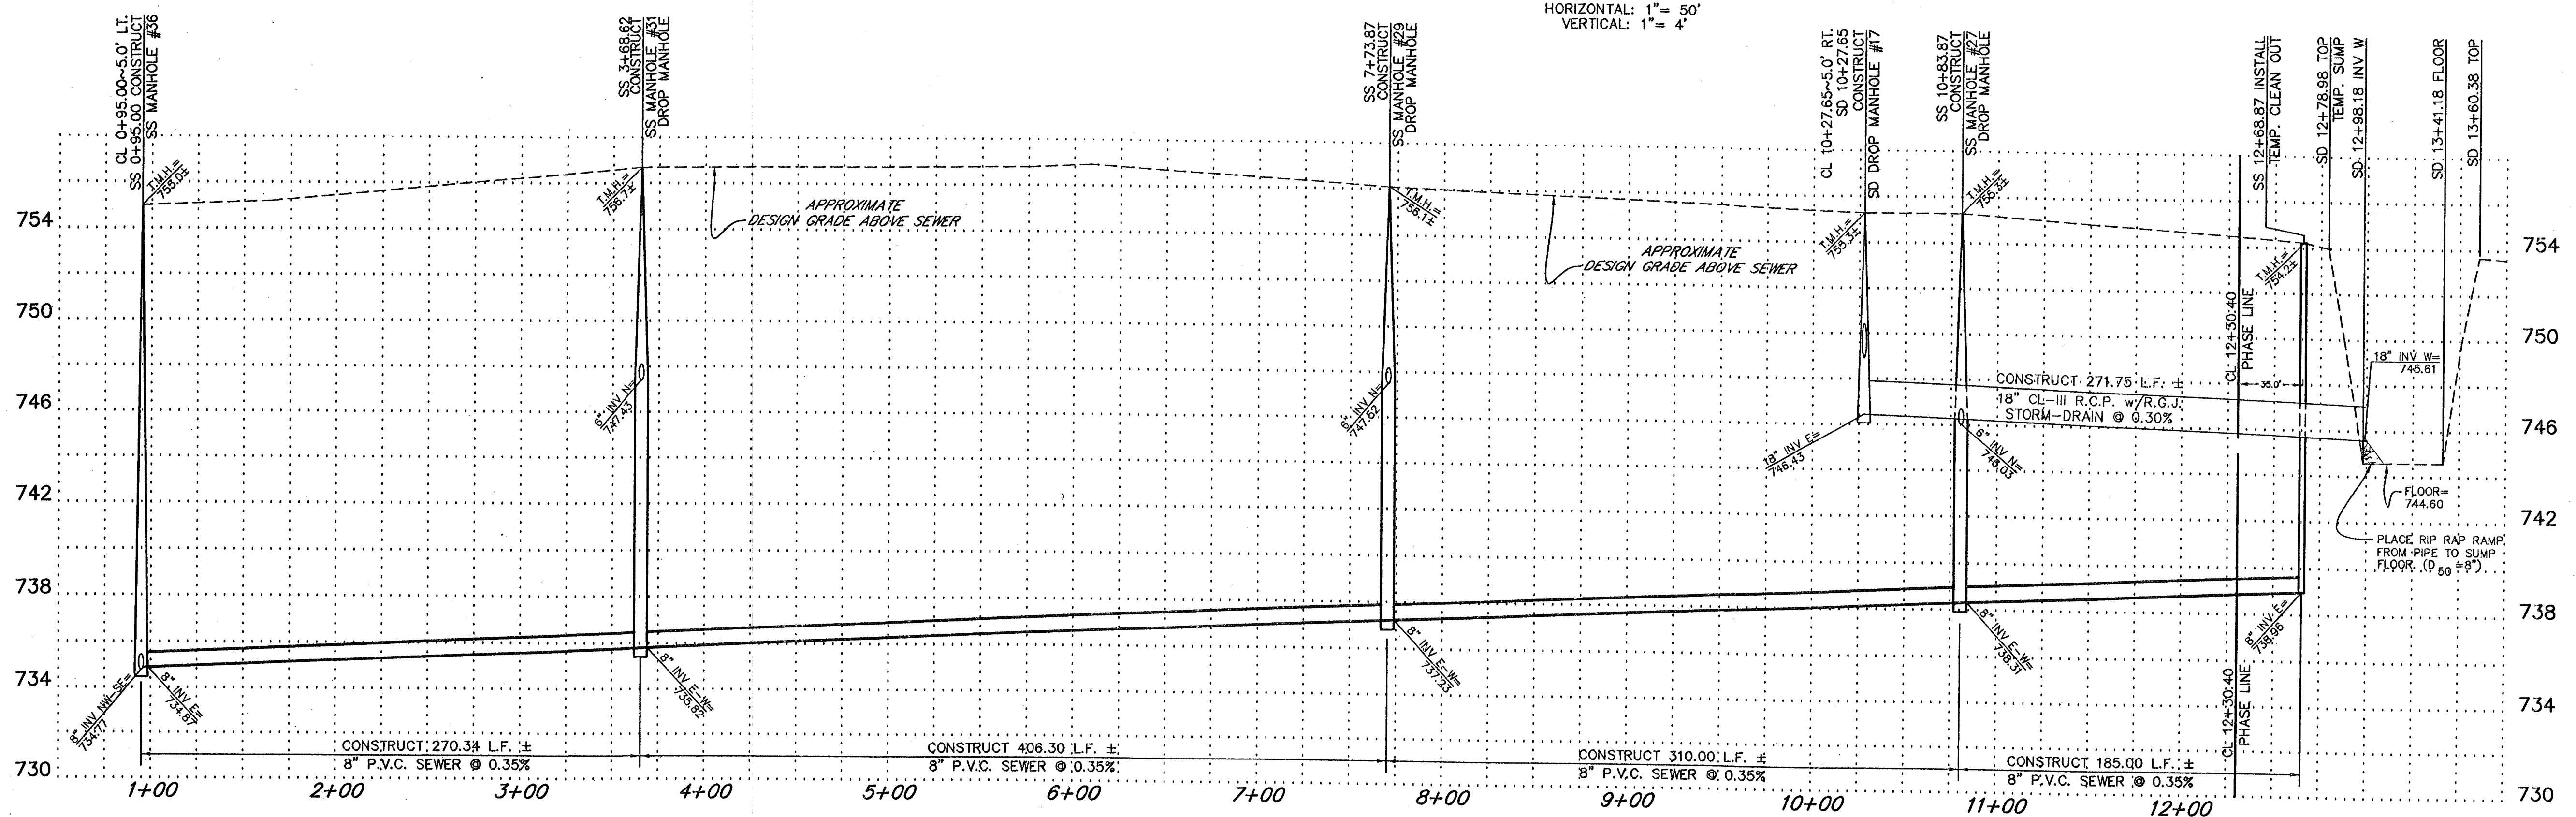

**PINNACLE** Civil Engineering, Inc.


1712 19th Street, Suite 101, Bakersfield, CA 93301  
Phone: (661) 869-0184 Fax: (661) 328-0607

**TRACT NO. 6444 - PHASE 1  
SEWER & STORM DRAIN PLANS  
K. HOVNANIAN  
BAKERSFIELD CALIFORNIA**




JOB NO.:	04-158
DWG NO.:	04-158SWRBMO1
DATE:	11/21/05
DRAWN BY:	MJS
CHECKED BY:	MKV
SHEET	6
OF 13	SHEETS



- LEGEND**
- PROPOSED SEWER MANHOLE w/NUMBER
  - 8" S — PROPOSED SEWER LINE w/SIZE
  - - - PROPOSED RIGHT-OF-WAY
  - SS SEWER STATION
  - SD STORMDRAIN STATION
- ALL SEWER LATERALS ARE 4" UNLESS OTHERWISE NOTED  
ALL SEWER LATERALS ARE TO HAVE A 4.5' MIN. —  
7' MAX. OF COVER AT THE PROPERTY LINE AND A  
MINIMUM OF 2.5' OF COVER AT GUTTER FLOWLINE.
- PROPOSED STORM-DRAIN MANHOLE
  - 18" SD — PROPOSED STORM-DRAIN LINE w/SIZE
  - ① CONSTRUCT TYPE "A" CATCH BASIN PER C.O.B.  
STD. DWG. D-14

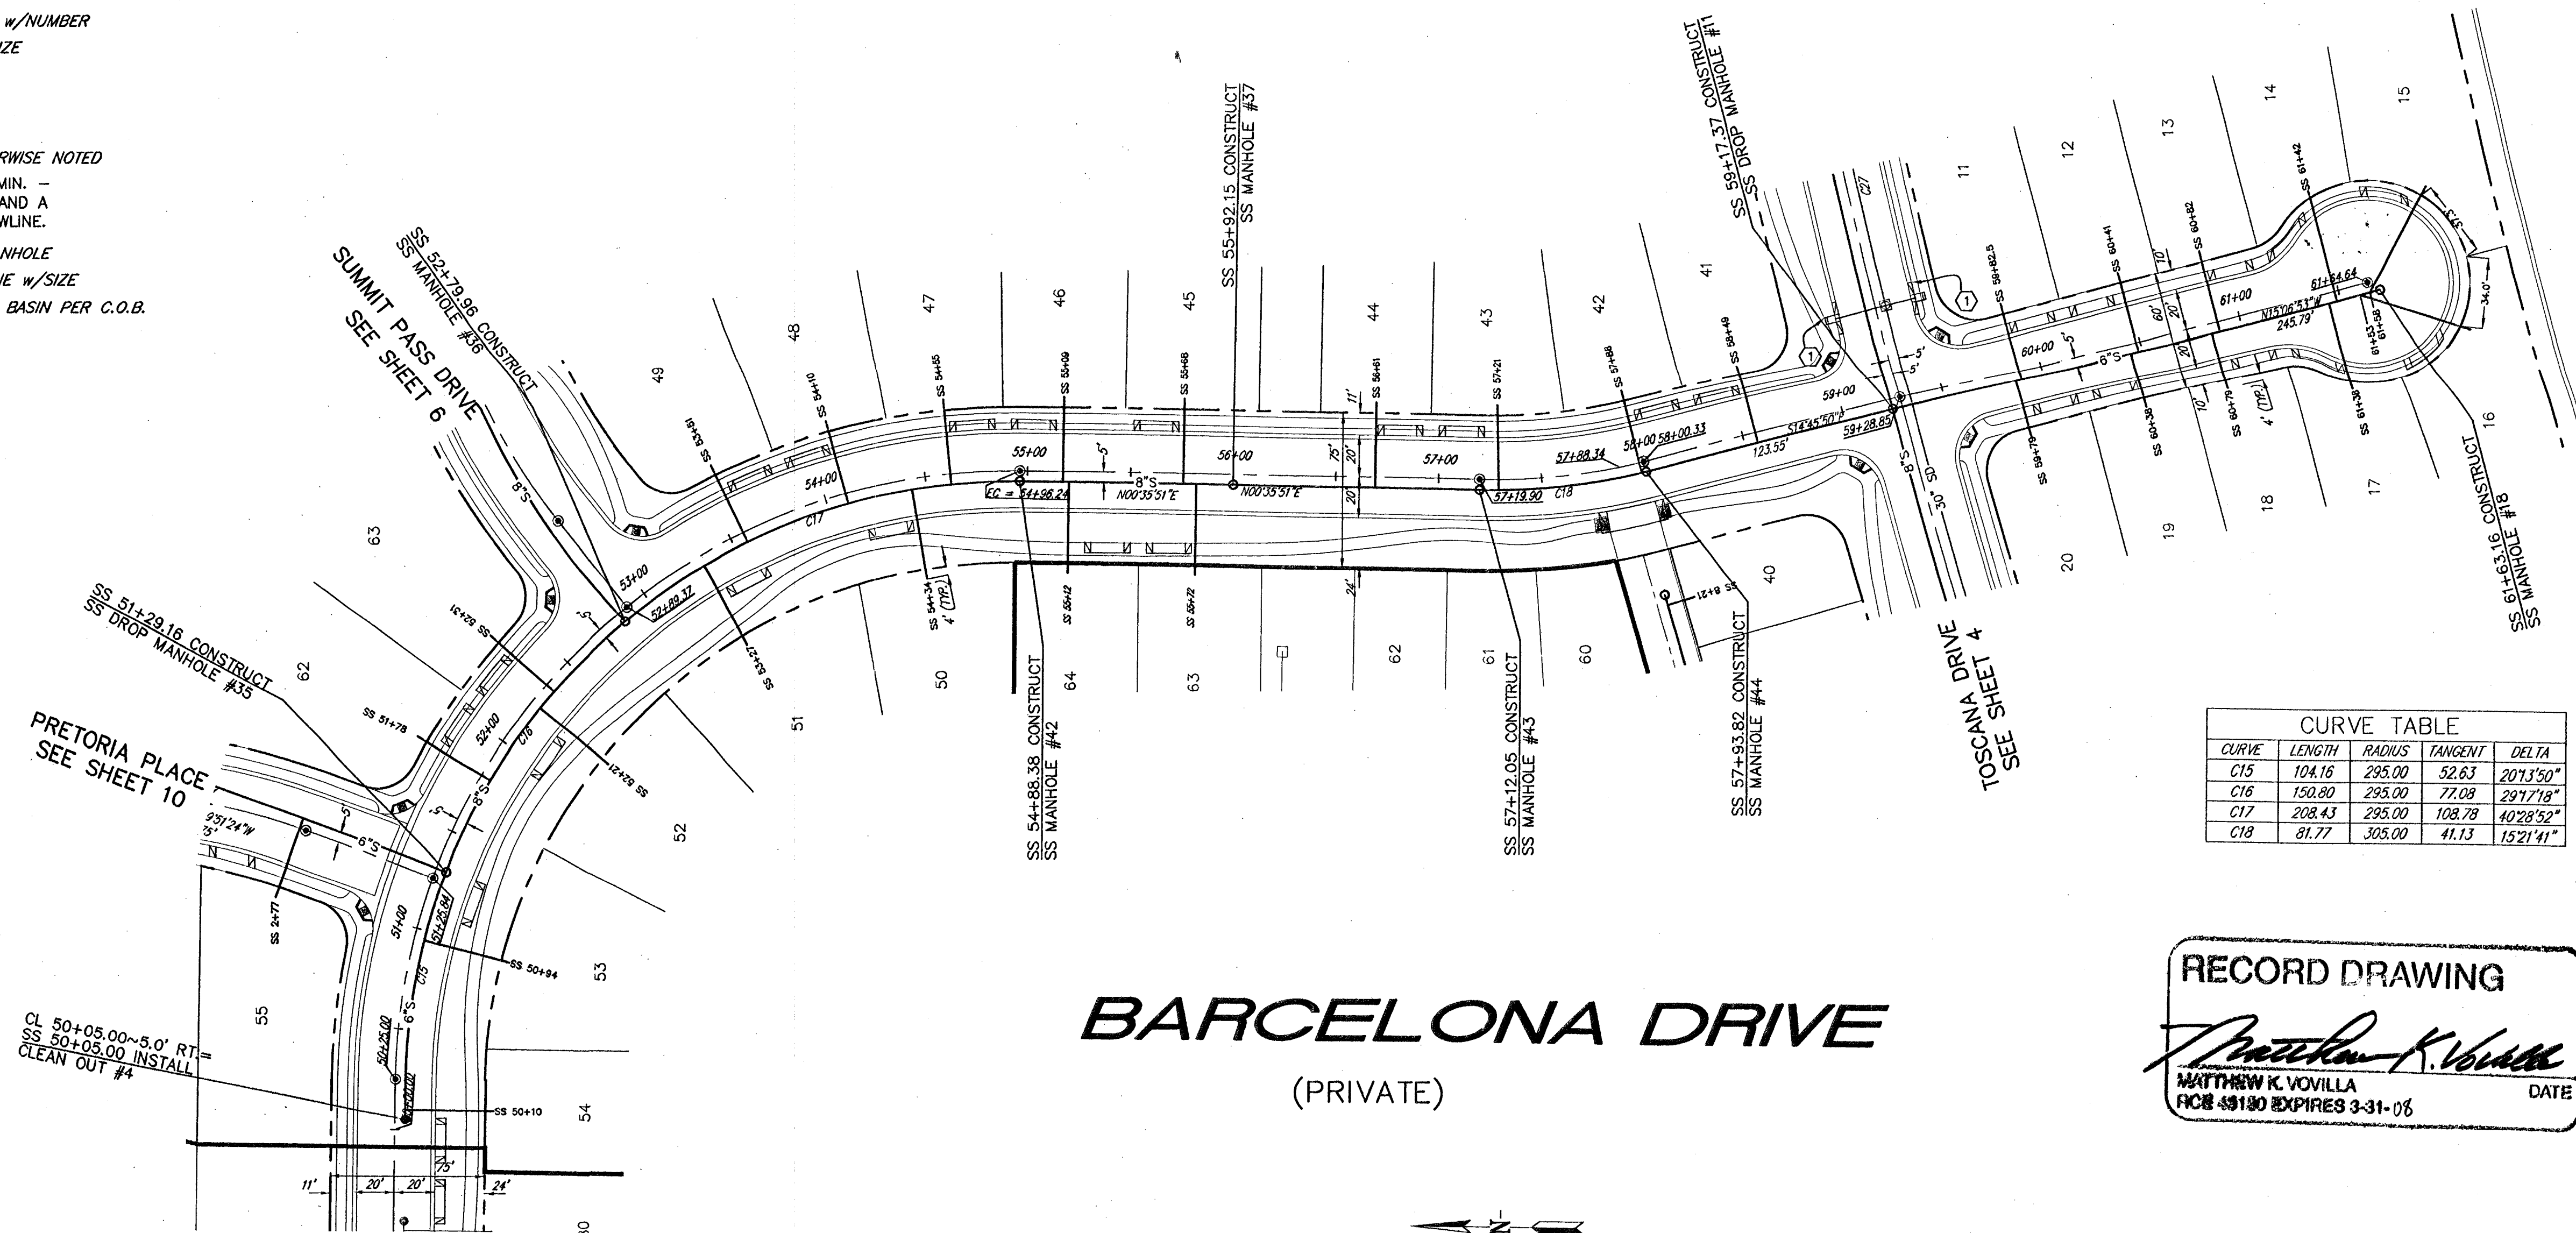

CURVE TABLE				
CURVE	LENGTH	RADIUS	TANGENT	DELTA
C15	104.16	295.00	52.63	20°13'50"
C16	150.80	295.00	77.08	29°17'18"
C17	208.43	295.00	108.78	40°28'52"
C18	81.77	305.00	41.13	15°21'41"

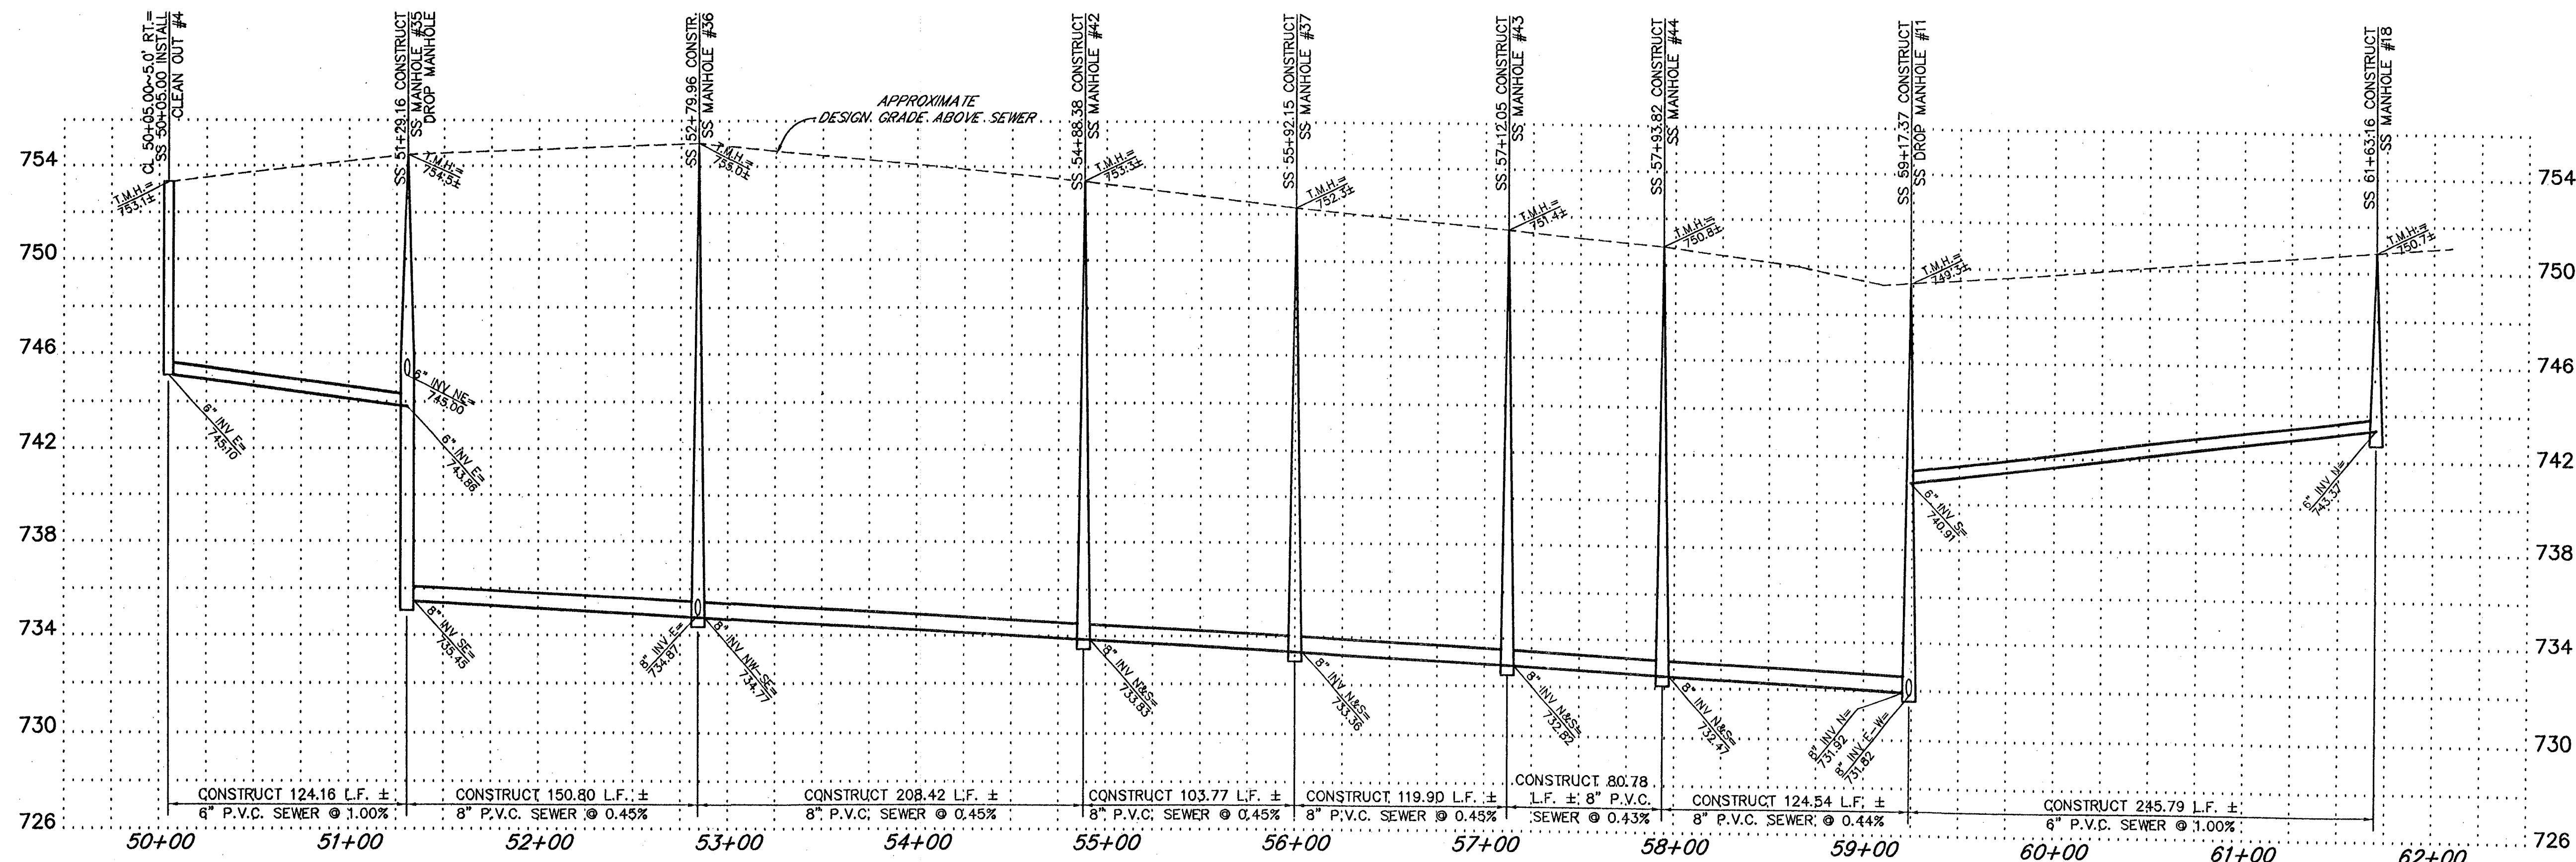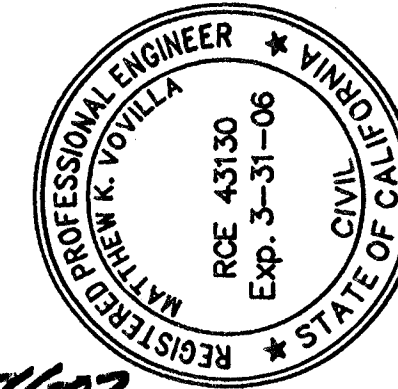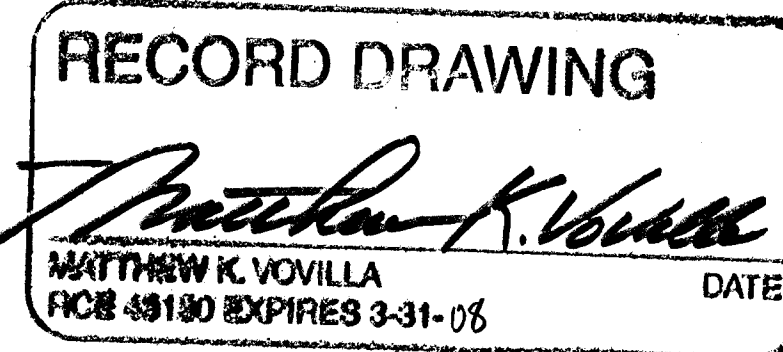

**PINNACLE Civil Engineering, Inc.**

1712 19th Street, Suite 101, Bakersfield, CA 93301  
Phone: (661) 869-0184 Fax: (661) 328-0607

*Matthew K. Vovilla*  
MATTHEW K. VOVILLA  
RCE 43130 EXP. 3/31/06

REVISIONS

**TRACT NO. 6444 - PHASE 1  
SEWER & STORM DRAIN PLANS  
K. HOVNANIAN  
BAKERSFIELD, CALIFORNIA**

JOB No: 04-158  
DWG NO: 04-158SWRB01  
DATE: 11/21/05  
DRAWN BY: MJS  
CHECKED BY: MKV  
SHEET 7  
OF 13 SHEETS

1,2-6444 1

**LEGEND**

- PROPOSED SEWER MANHOLE w/NUMBER
- 8" S PROPOSED SEWER LINE w/SIZE
- PROPOSED RIGHT-OF-WAY
- SS SEWER STATION
- SD STORMDRAIN STATION

ALL SEWER LATERALS ARE 4" UNLESS OTHERWISE NOTED


ALL SEWER LATERALS ARE TO HAVE A 4.5' MIN. - 7' MAX. OF COVER AT THE PROPERTY LINE AND A MINIMUM OF 2.5' OF COVER AT GUTTER FLOWLINE.

- PROPOSED STORM-DRAIN MANHOLE
- 18" SD PROPOSED STORM-DRAIN LINE w/SIZE
- CONSTRUCT TYPE "A" CATCH BASIN PER C.O.B. STD. DWG. D-14

RECORD DRAWING

MATTHEW K. VOVILLA  
RCE 43130 EXPIRES 3-31-03

DATE

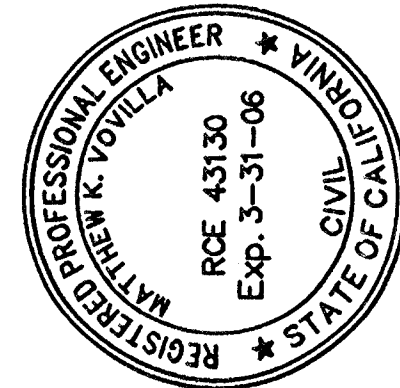


**PINNACLE Civil Engineering, Inc.**  
1712 19th Street, Suite 101, Bakersfield, CA 93301  
Phone: (661) 869-0184 Fax: (661) 328-0607

REVISIONS  
DATE  
MATTHEW K. VOVILLA RCE 43130 EXP. 3/31/06  
11-2-05

**TRACT NO. 6444 - PHASE 1  
SEWER & STORM DRAIN PLANS  
K. HOVNANIAN  
BAKERSFIELD, CALIFORNIA**


JOB NO.: 04-158  
DWG NO.: 04-158SWRBM01  
DATE: 11/21/05  
DRAWN BY: MJS  
CHECKED BY: MKY  
SHEET 8  
OF 13 SHEETS

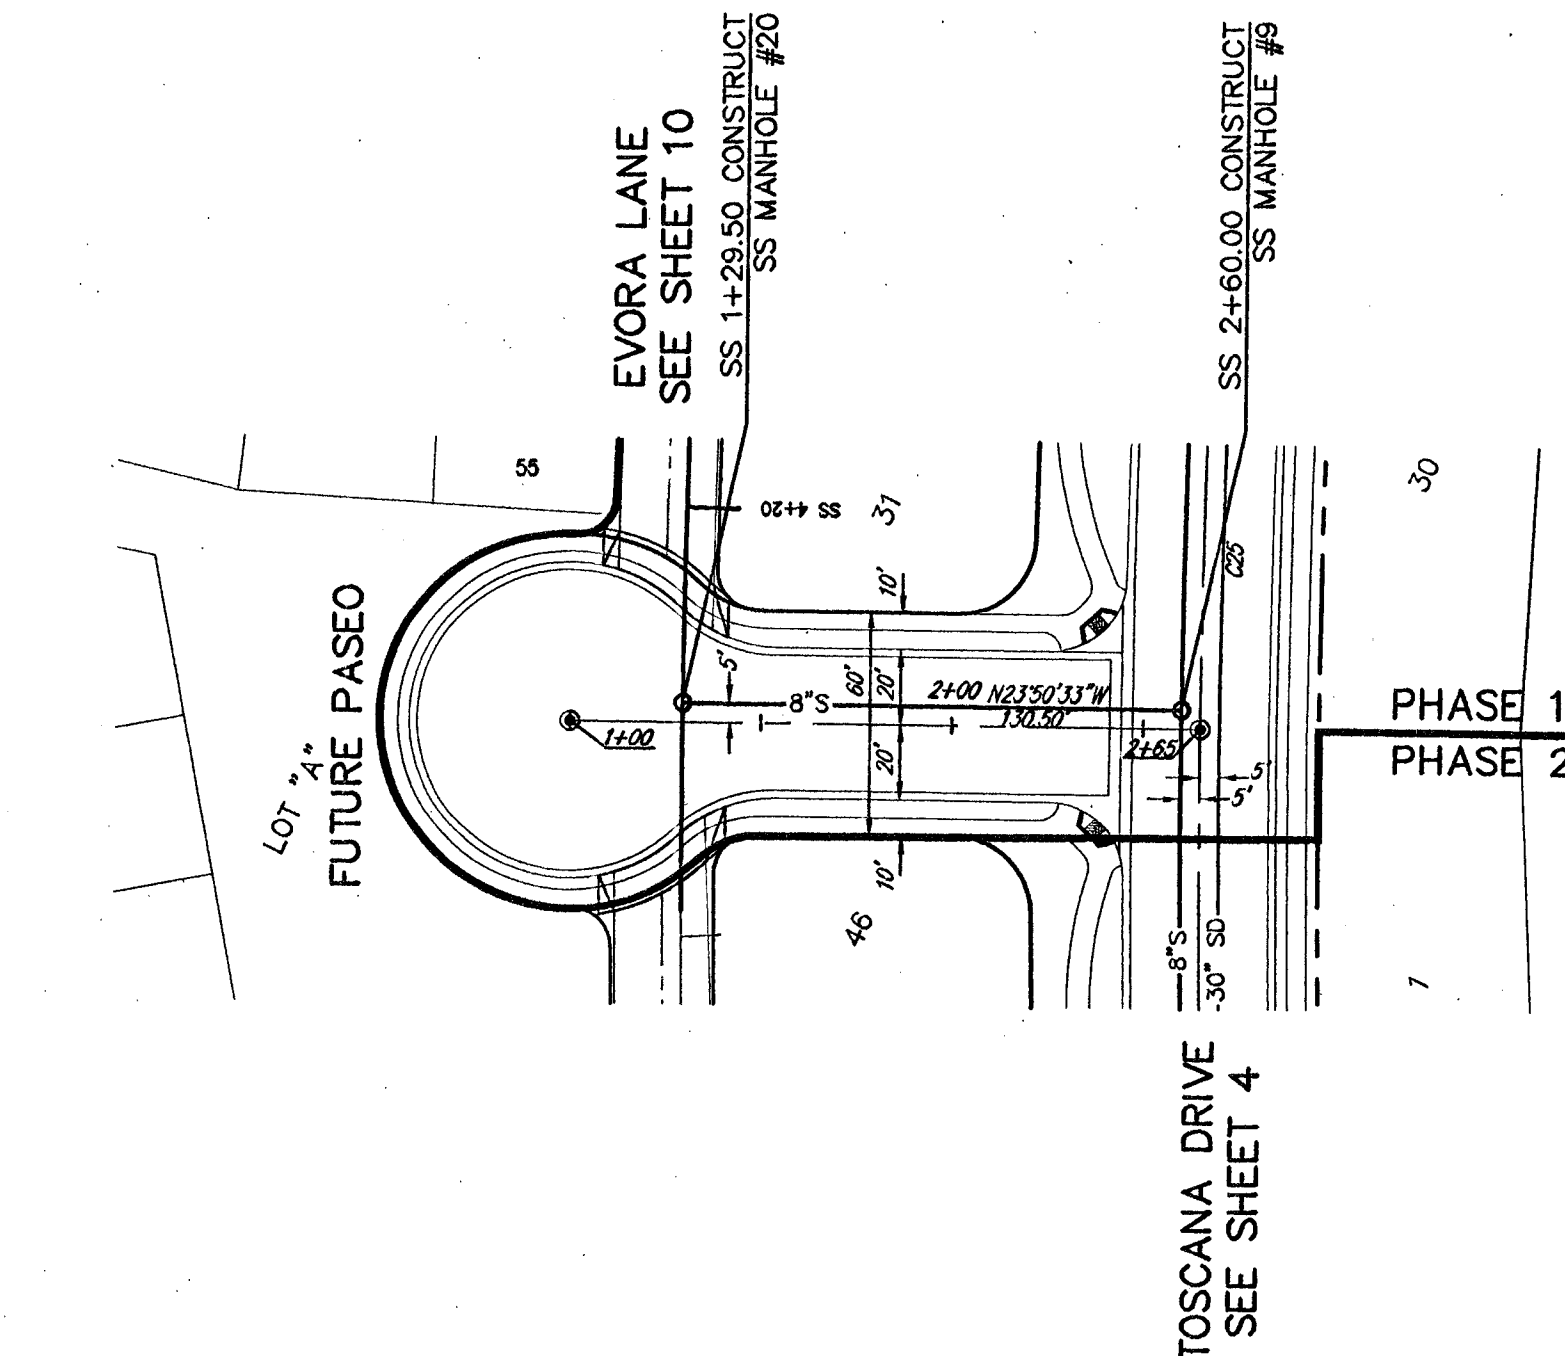


**FALKIRK PLACE**  
(PRIVATE)




HORIZONTAL: 1" = 50'  
VERTICAL: 1" = 4'

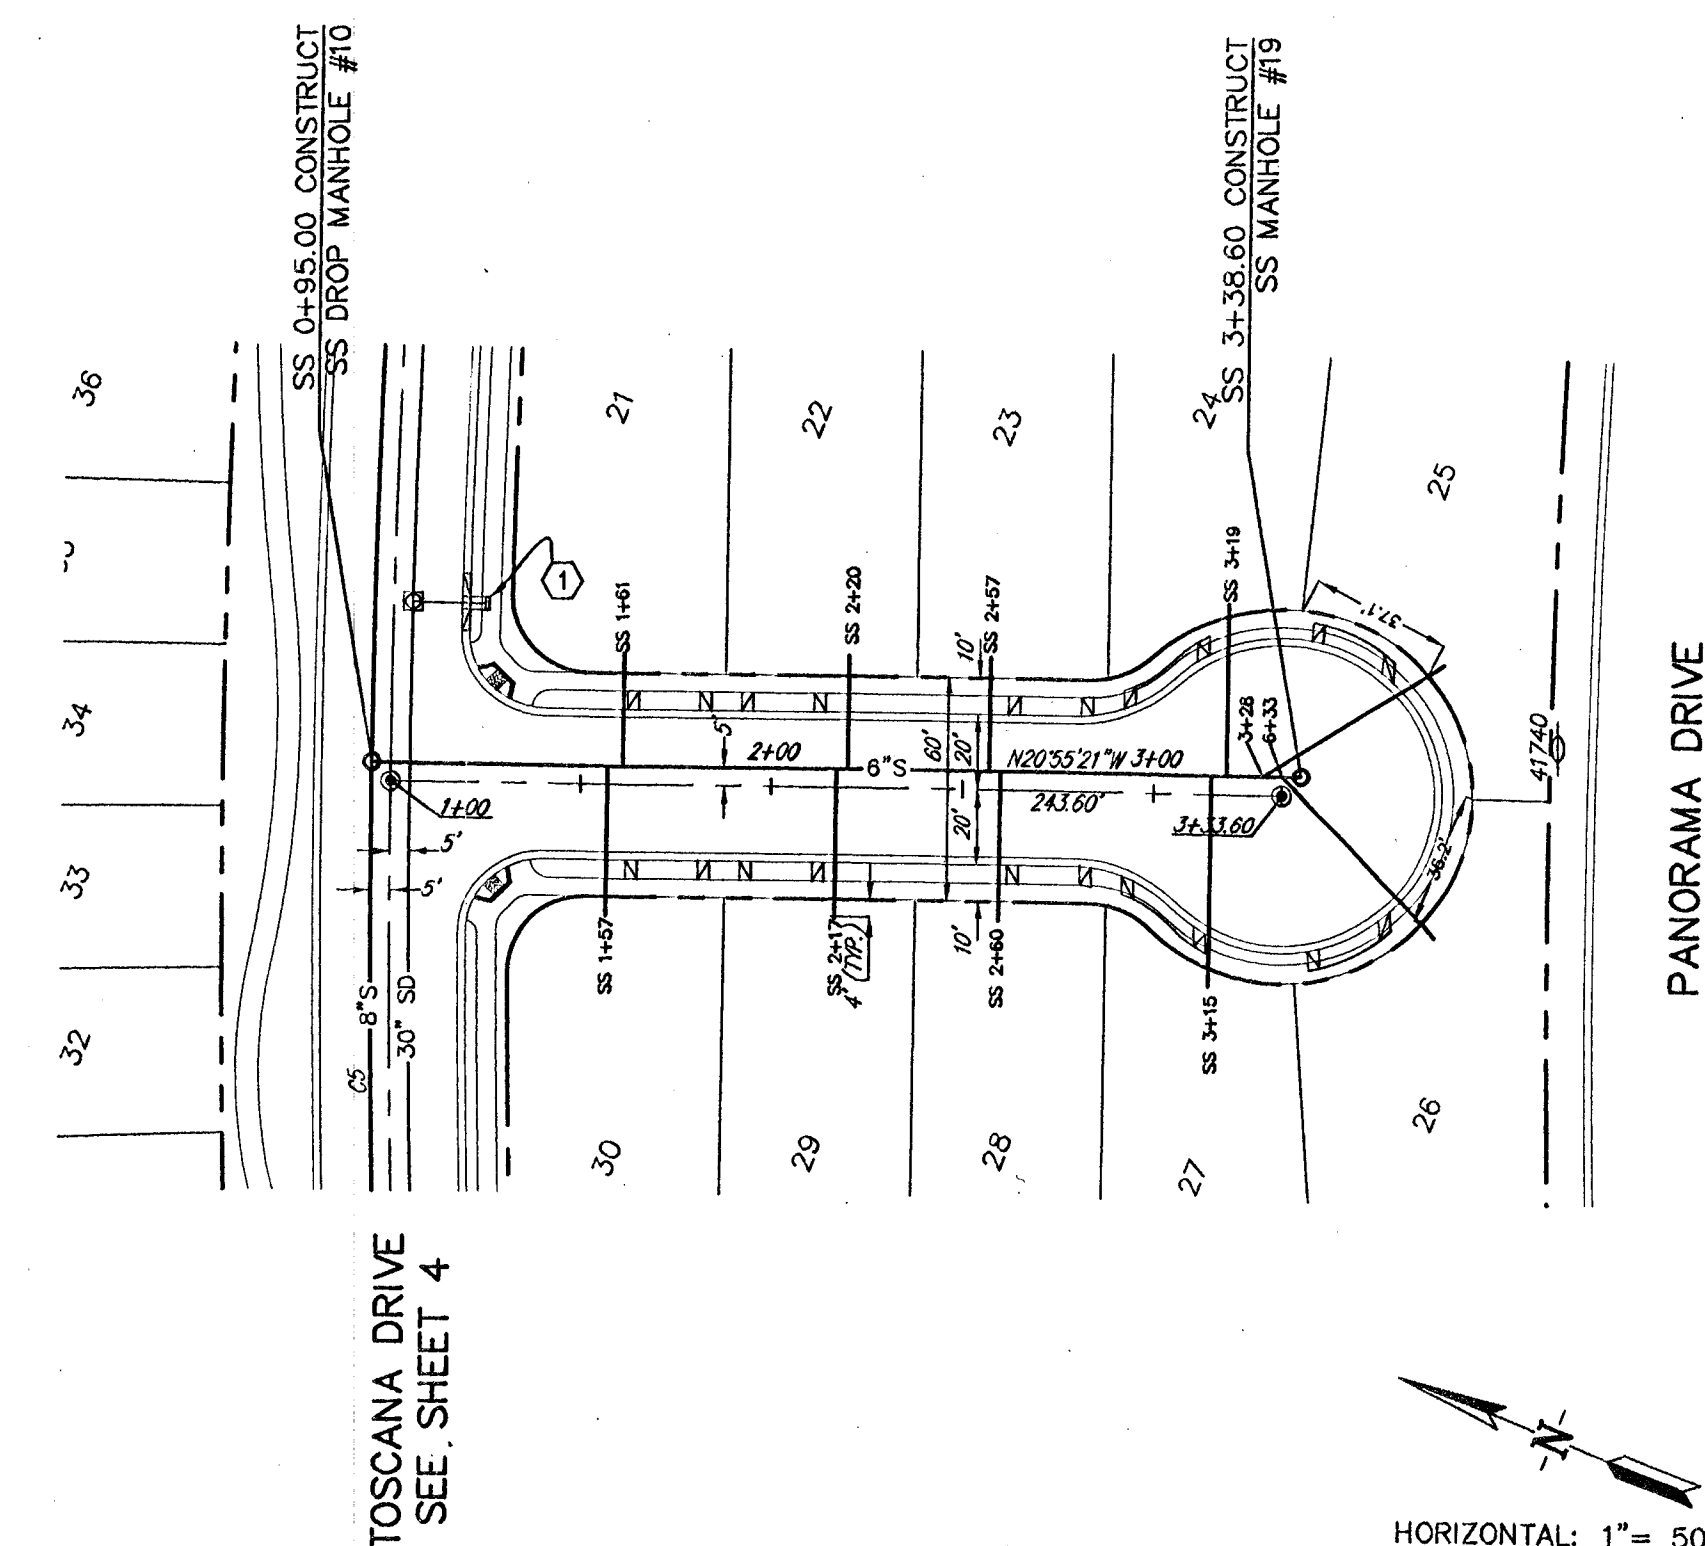


**COLCHESTER PLACE**  
(PRIVATE)

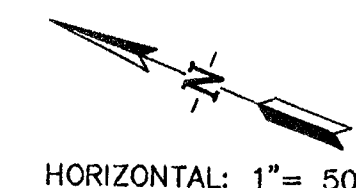




HORIZONTAL: 1" = 50'  
VERTICAL: 1" = 4'

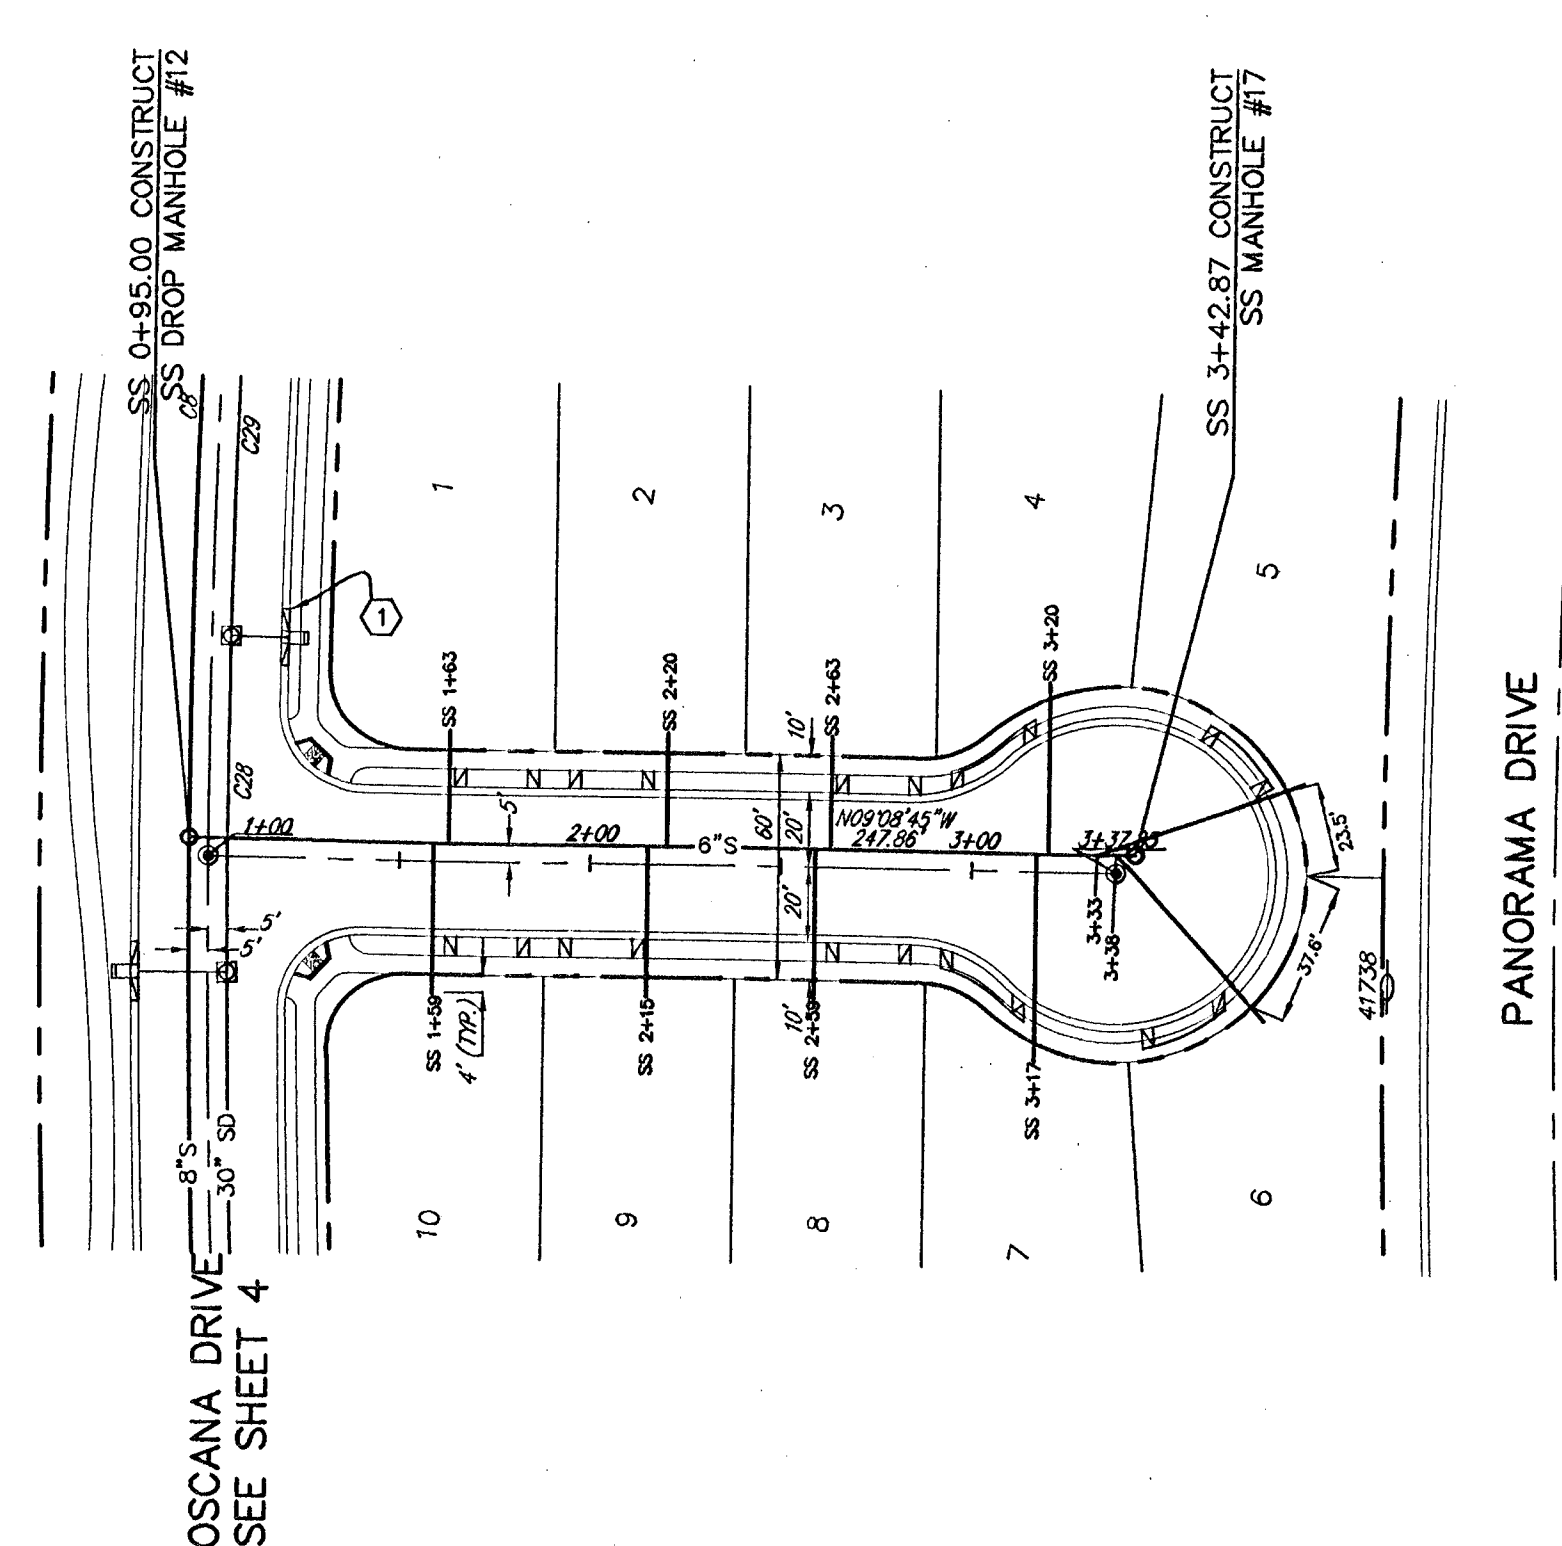

**PRAQUE PLACE**  
(PRIVATE)

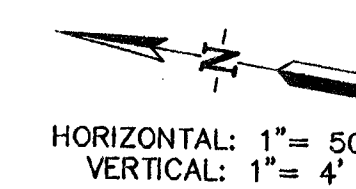


HORIZONTAL: 1" = 50'  
VERTICAL: 1" = 4'

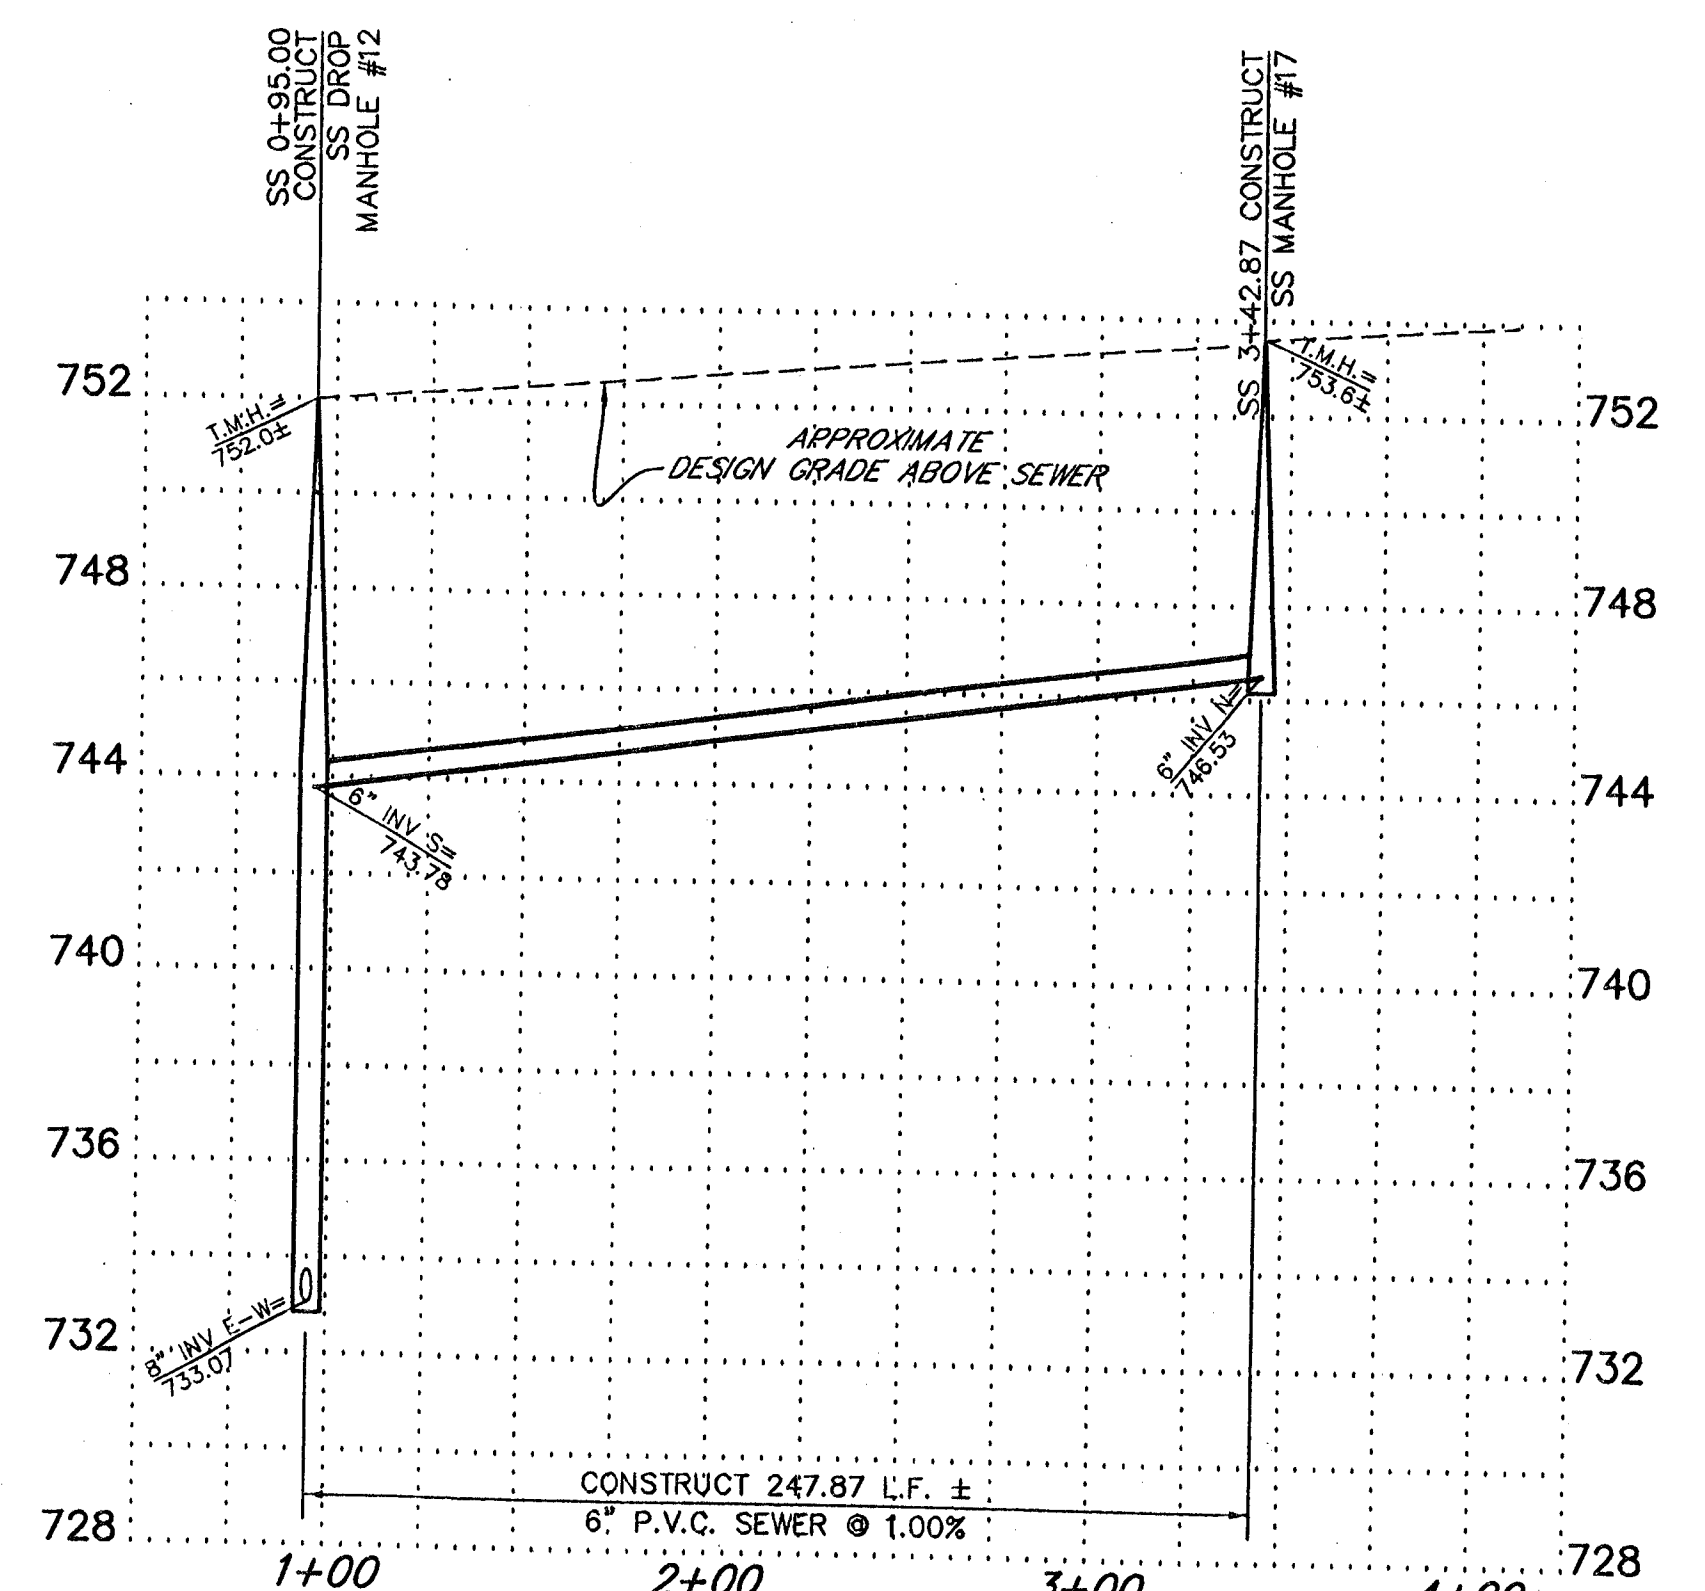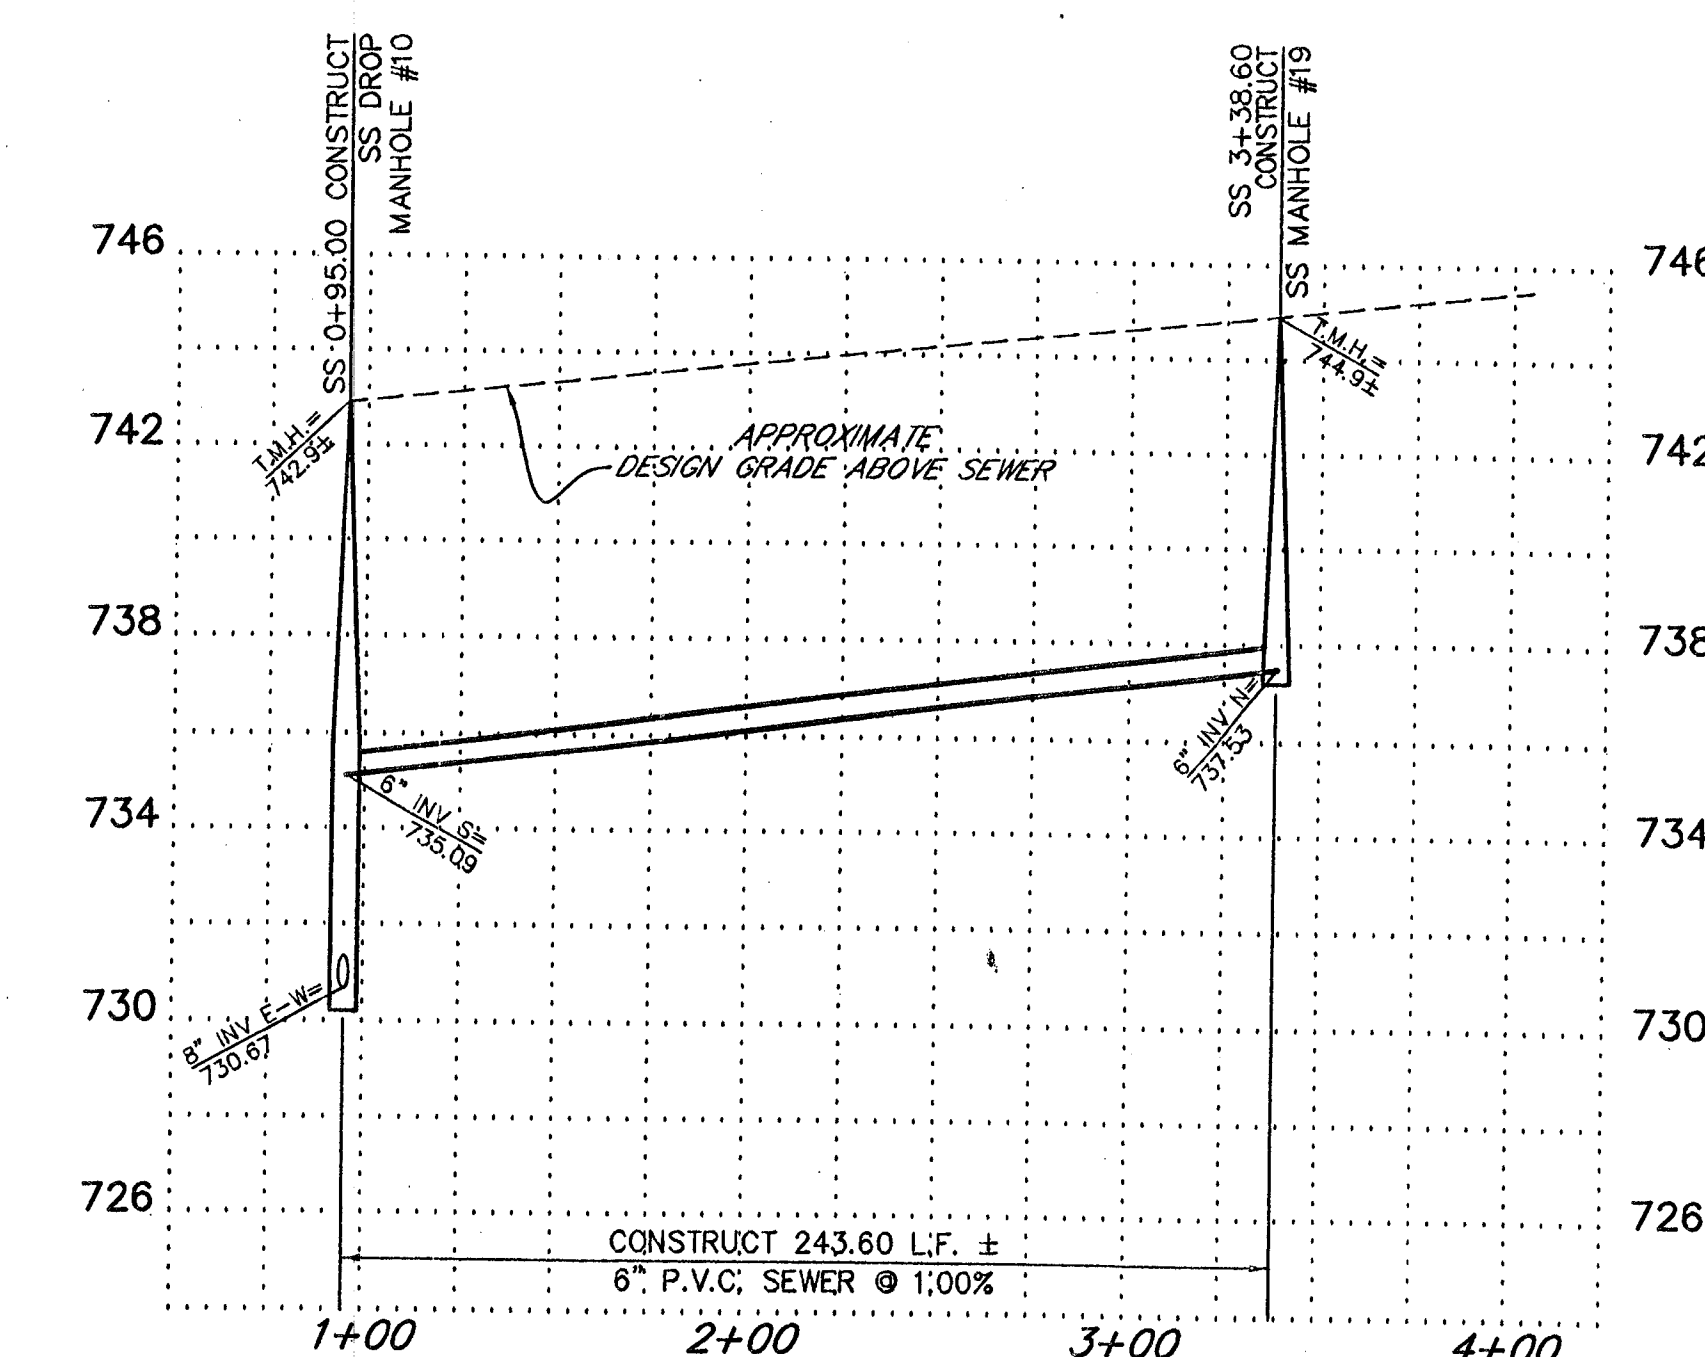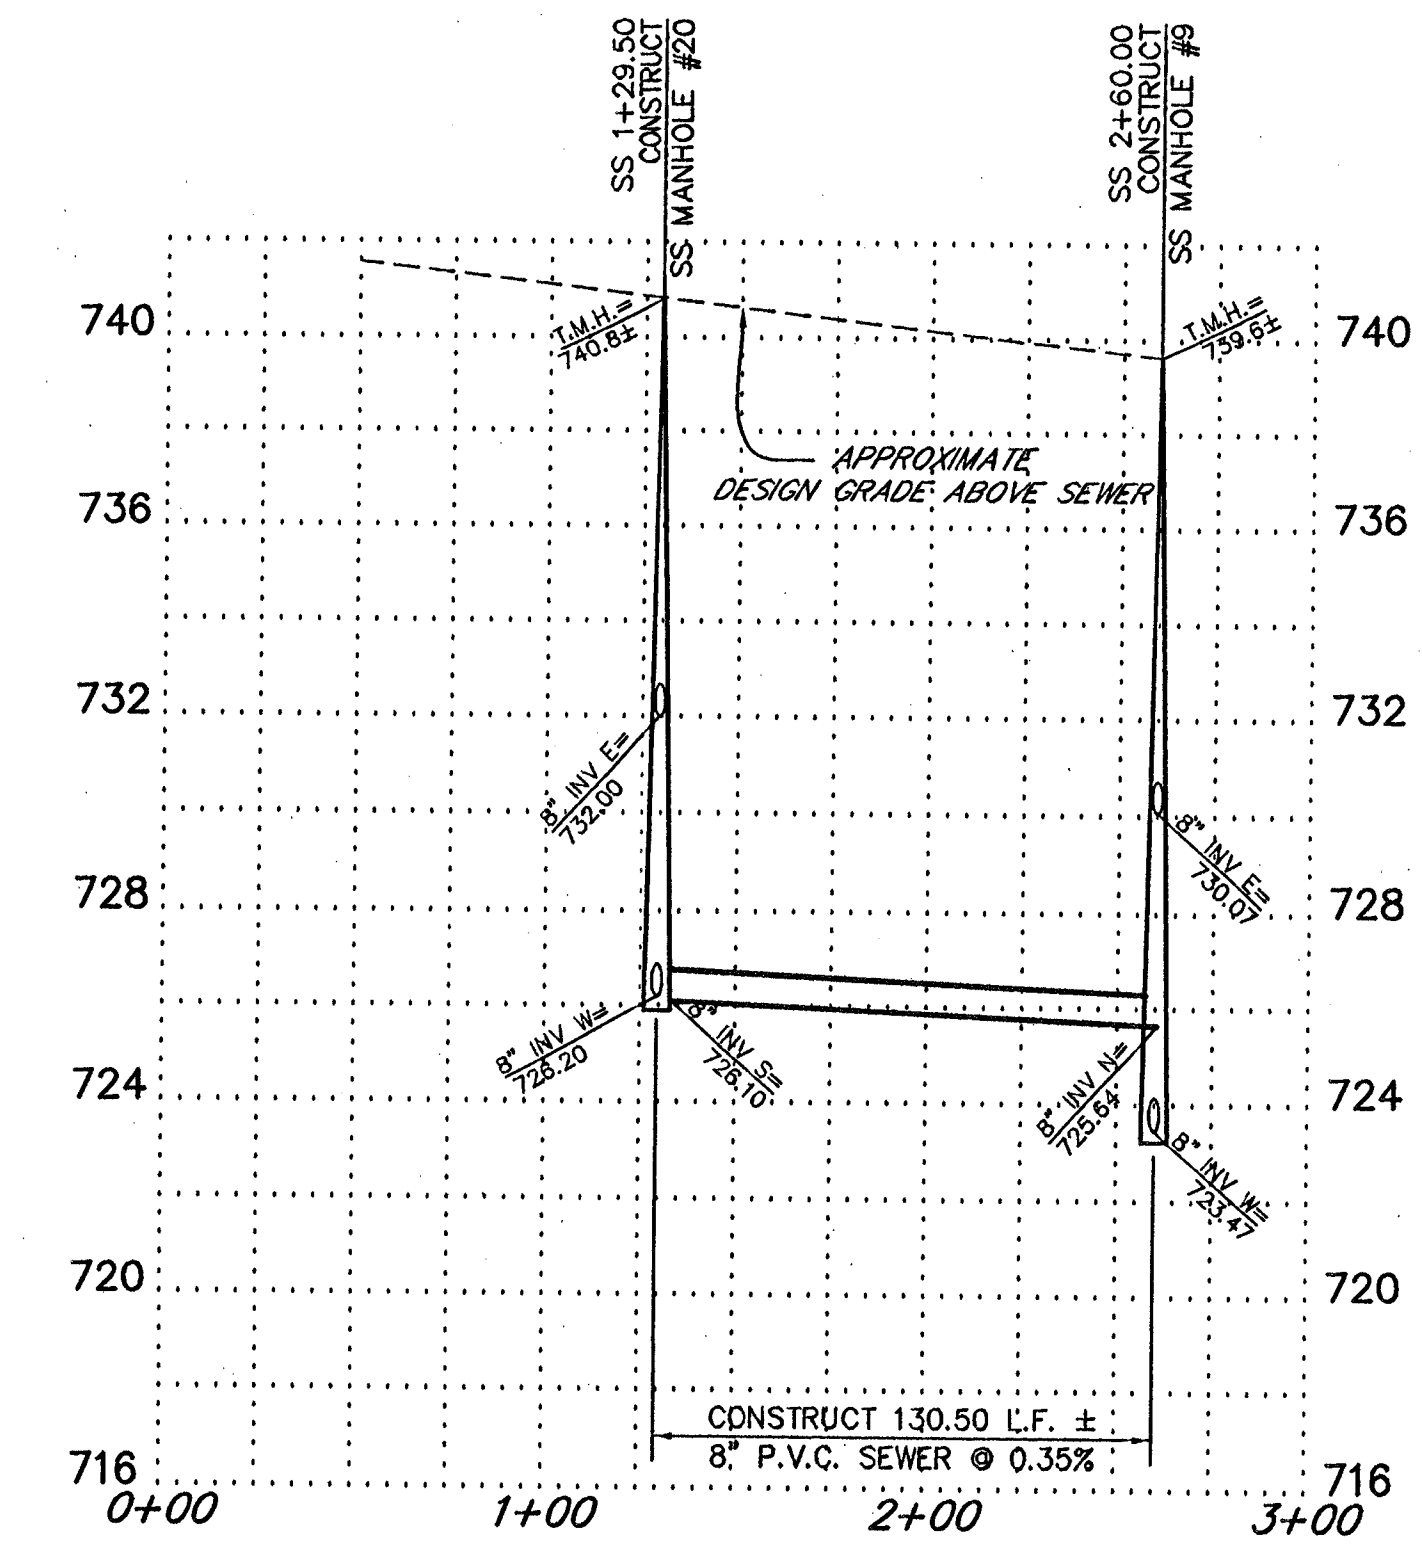





- LEGEND**
- PROPOSED SEWER MANHOLE w/NUMBER
  - 8" S PROPOSED SEWER LINE w/SIZE
  - PROPOSED RIGHT-OF-WAY
  - SS SEWER STATION
  - SD STORMDRAIN STATION
- ALL SEWER LATERALS ARE 4" UNLESS OTHERWISE NOTED  
ALL SEWER LATERALS ARE TO HAVE A 4.5' MIN. -  
7' MAX. OF COVER AT THE PROPERTY LINE AND A  
MINIMUM OF 2.5' OF COVER AT GUTTER FLOWLINE.
- PROPOSED STORM-DRAIN MANHOLE
  - 18" SD PROPOSED STORM-DRAIN LINE w/SIZE
  - CONSTRUCT TYPE "A" CATCH BASIN PER C.O.B.  
STD. DWG. D-14

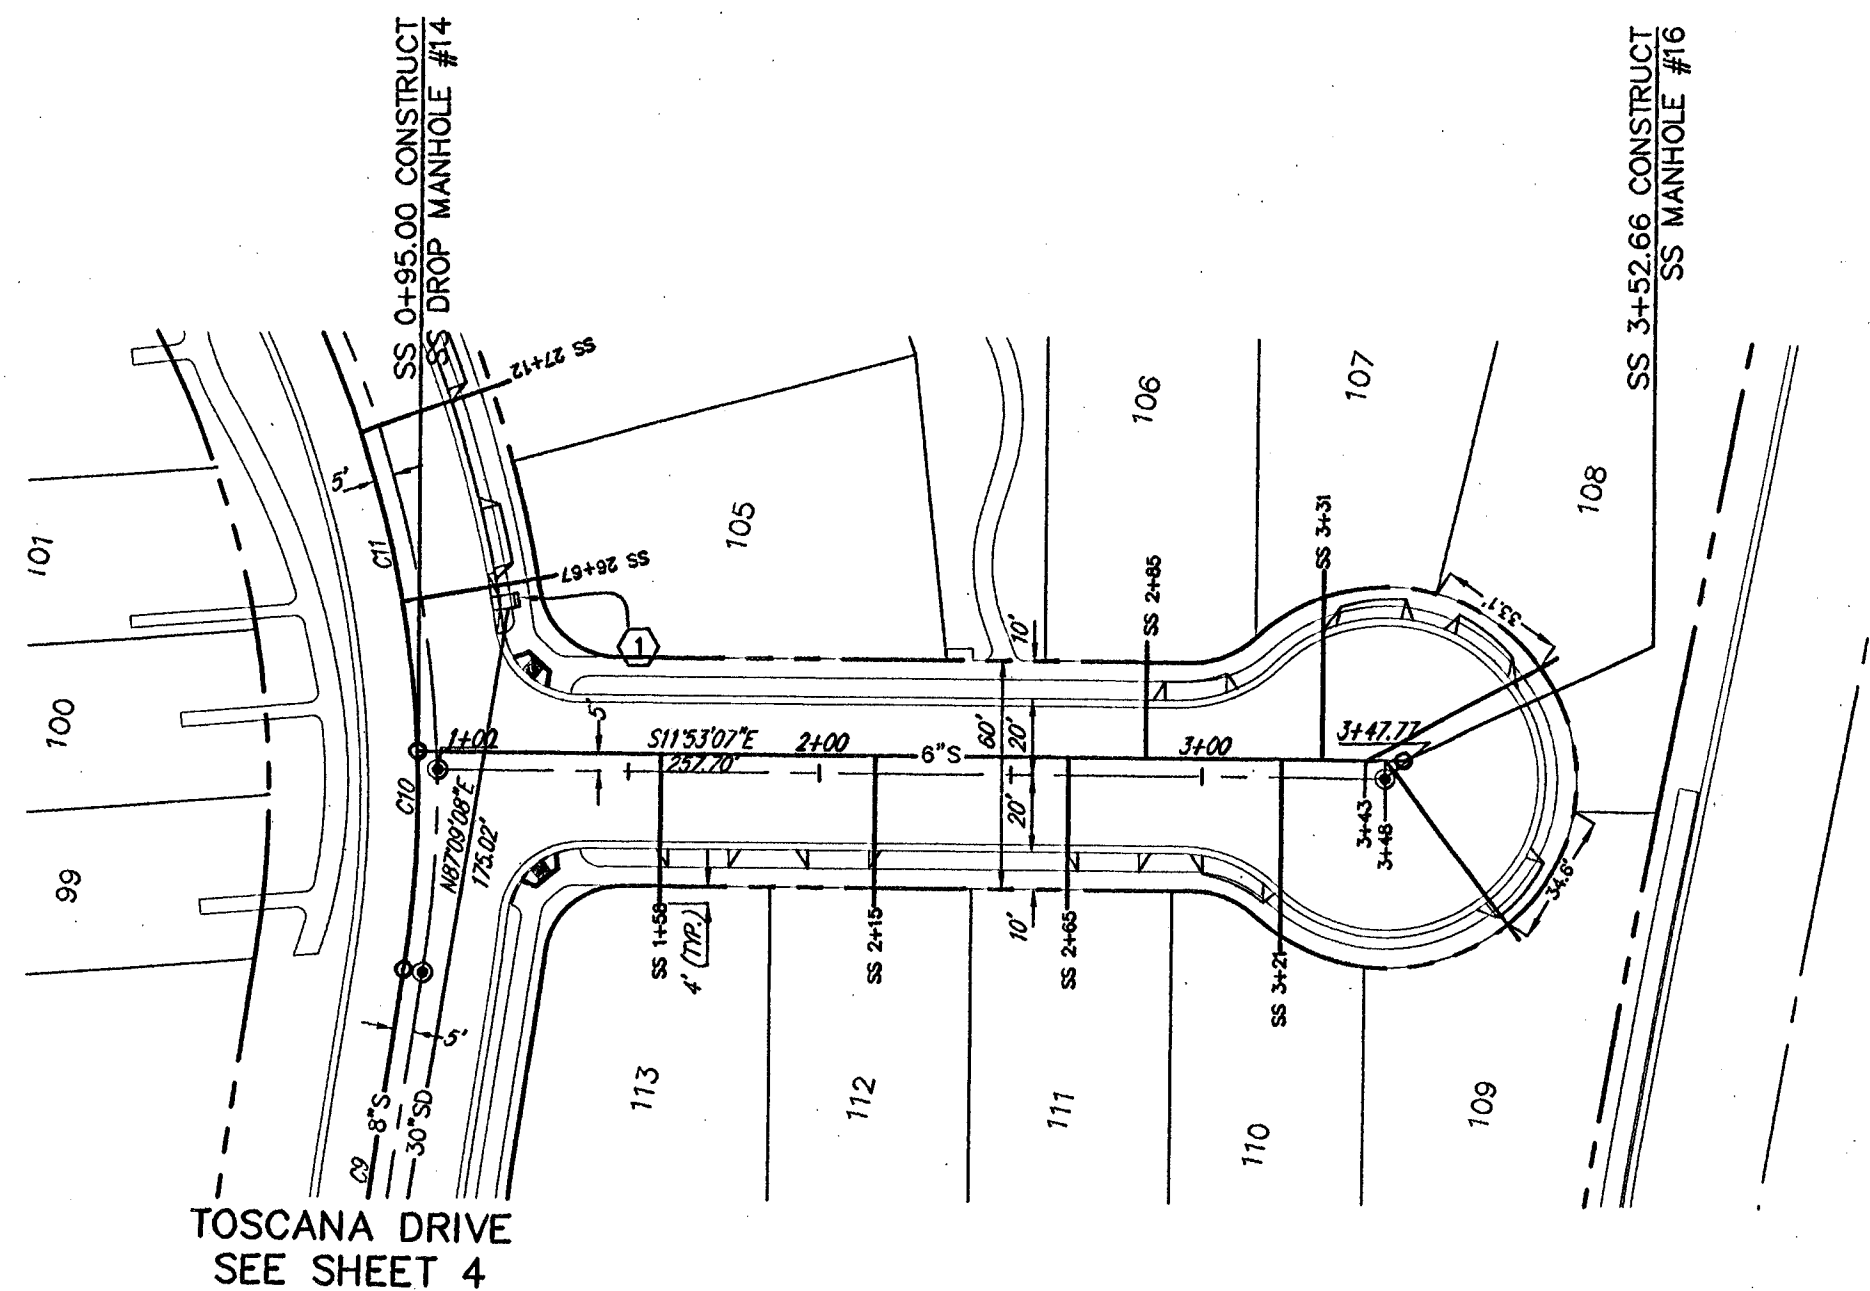

## SAINT JOHN PLACE

(PRIVATE)



HORIZONTAL: 1" = 50'  
VERTICAL: 1" = 4'

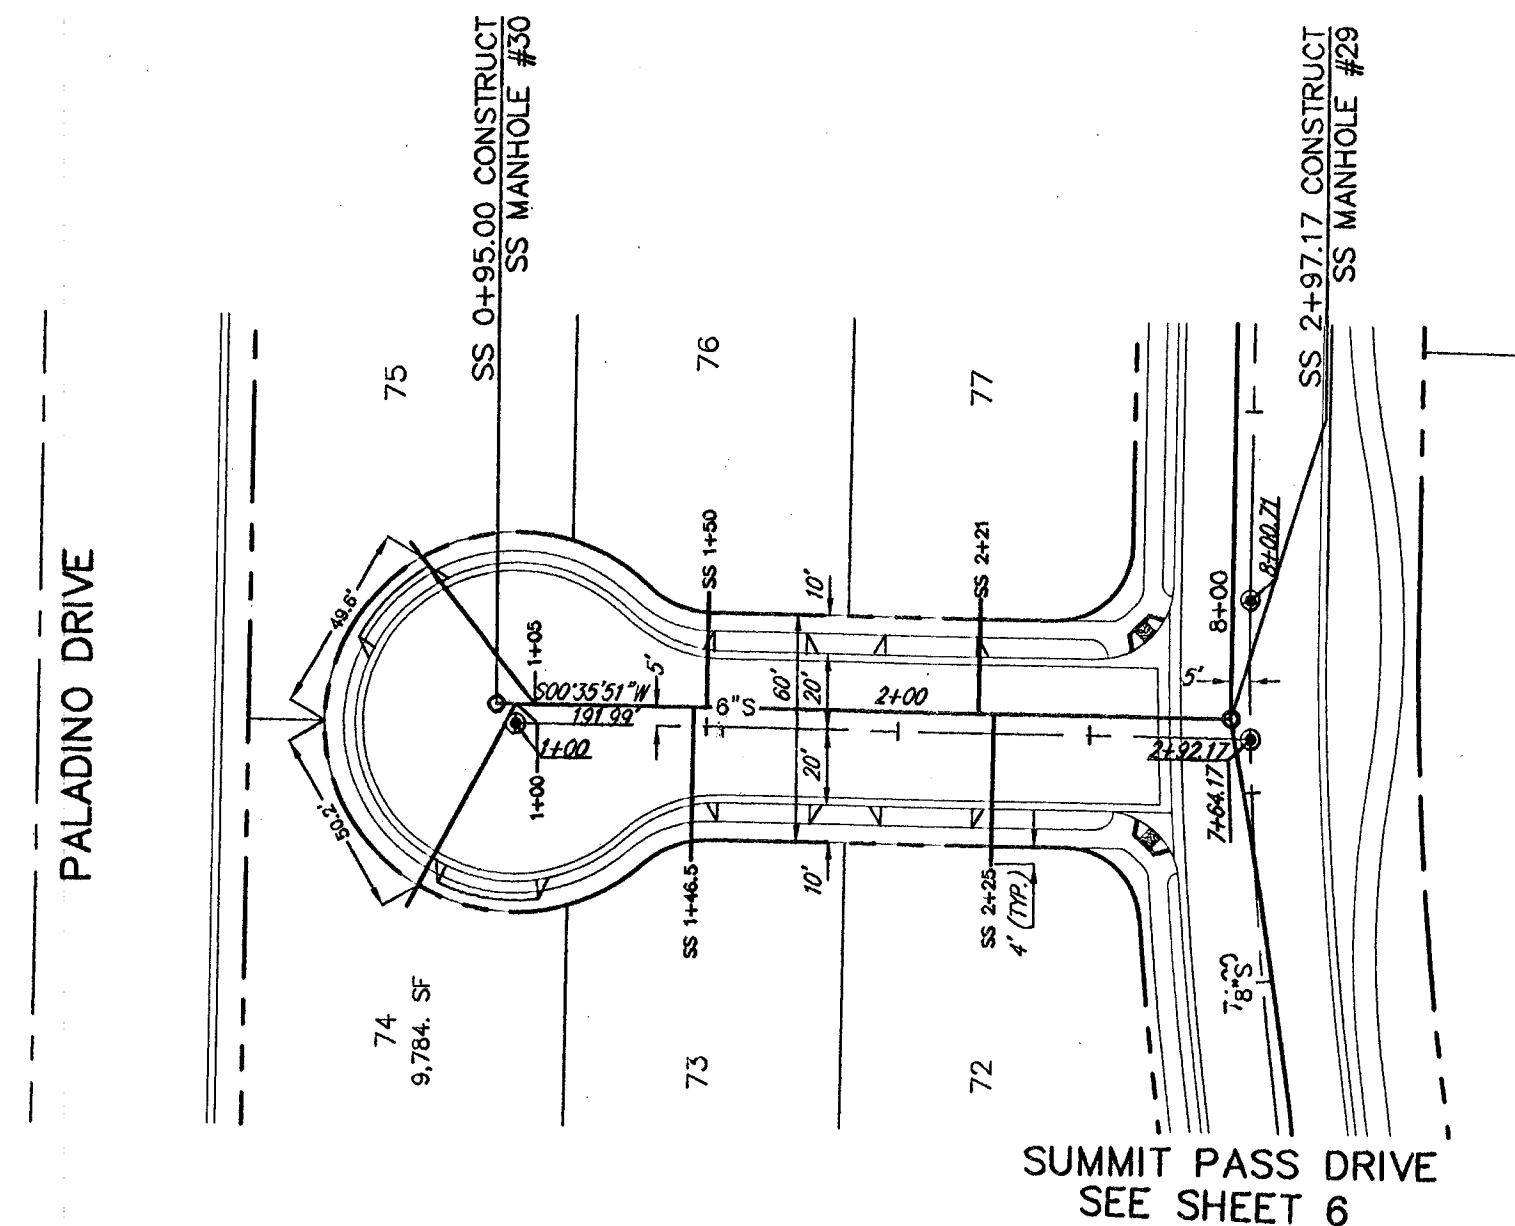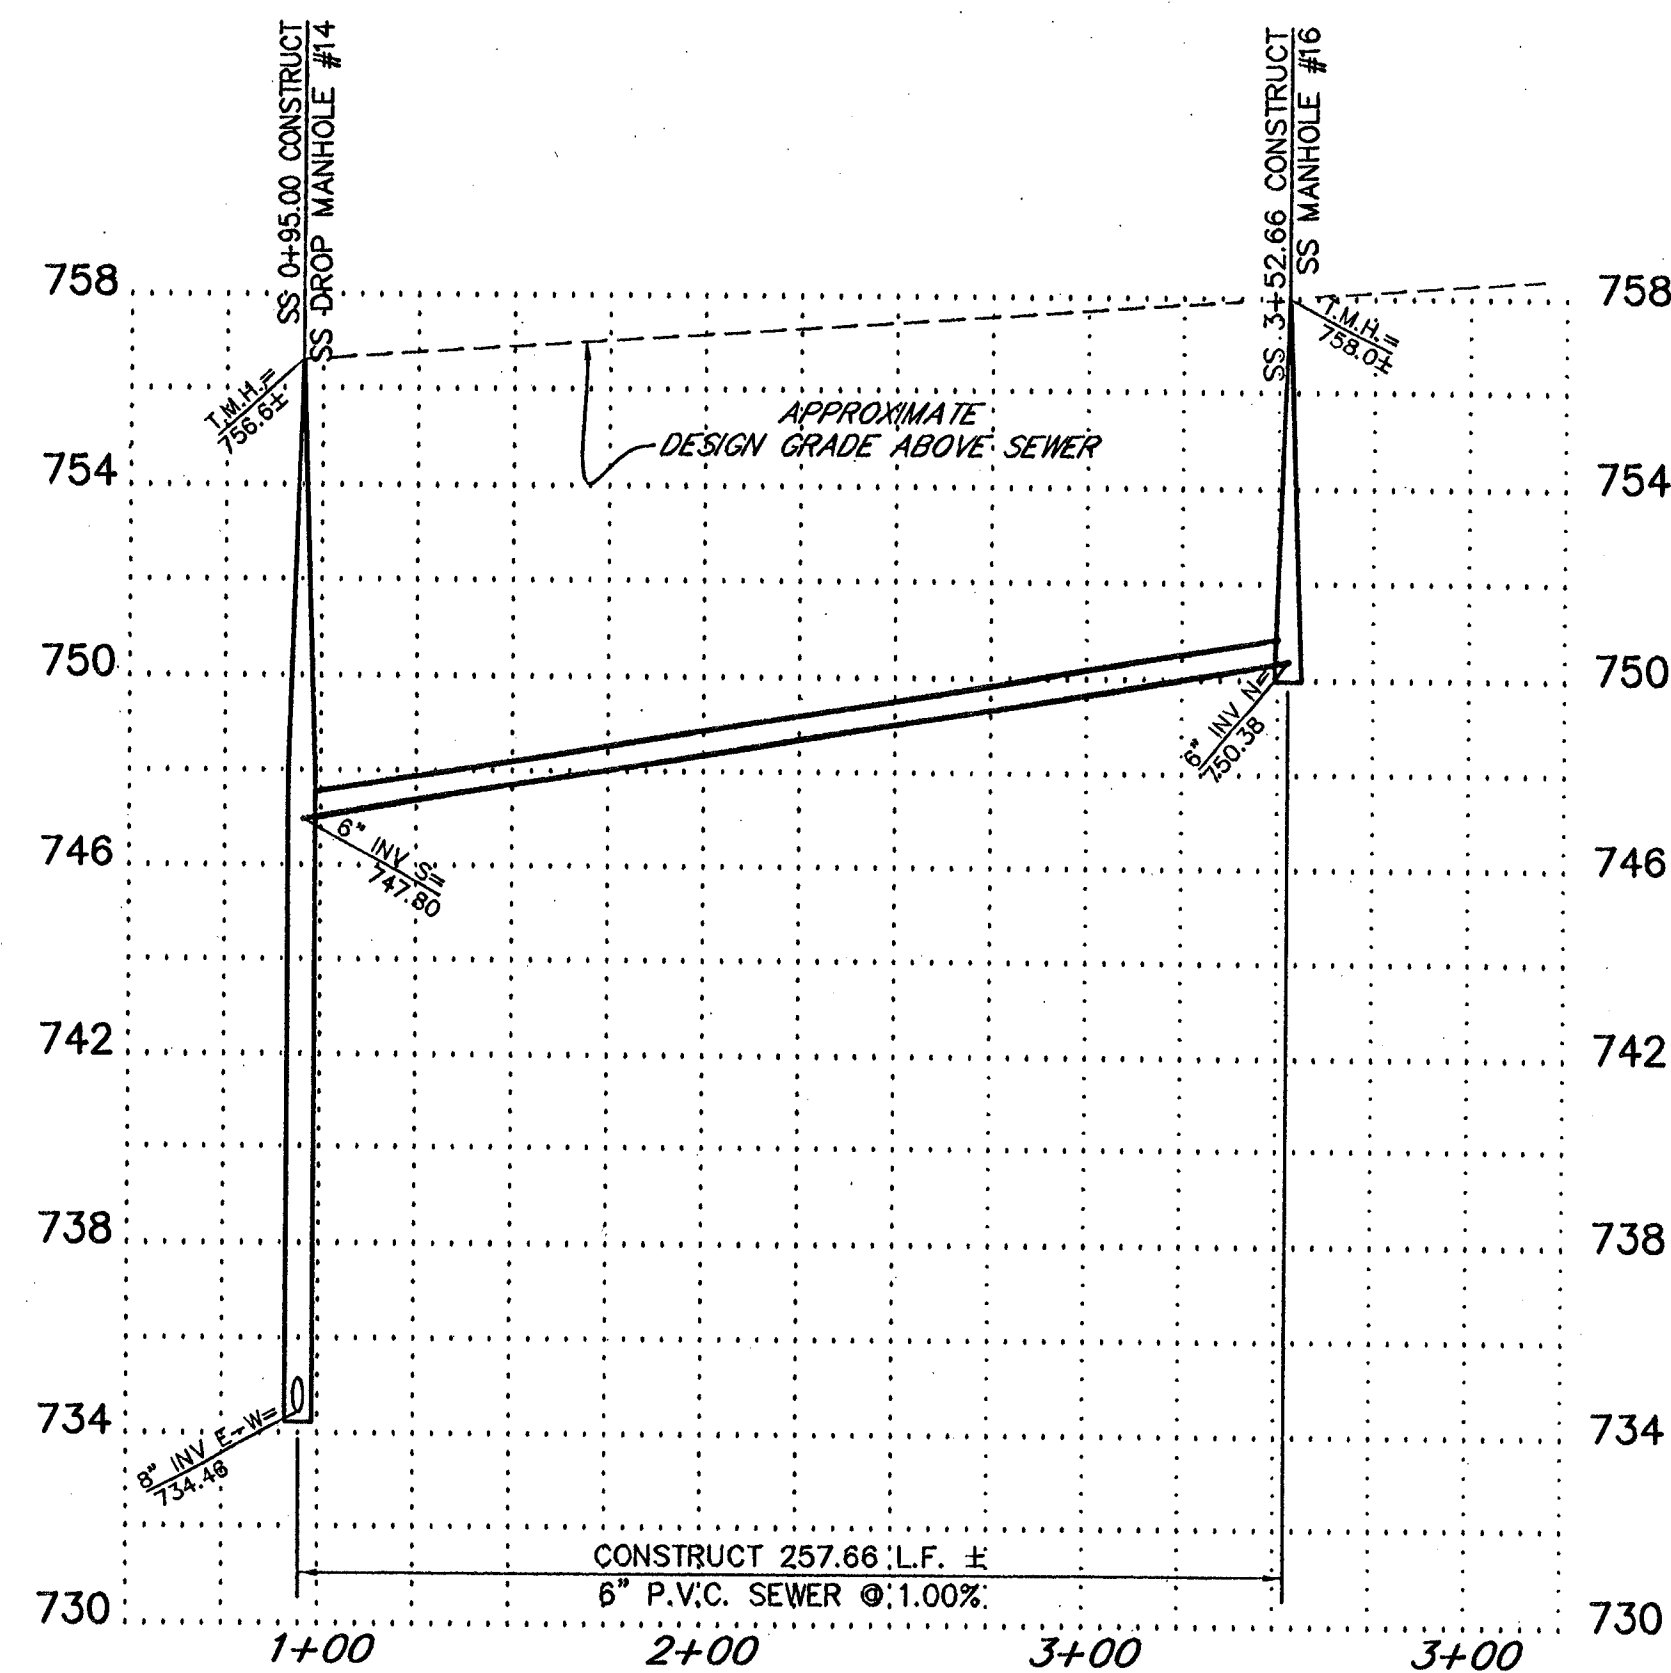

## PRIEST RIVER PLACE

(PRIVATE)


HORIZONTAL: 1" = 50'  
VERTICAL: 1" = 4'

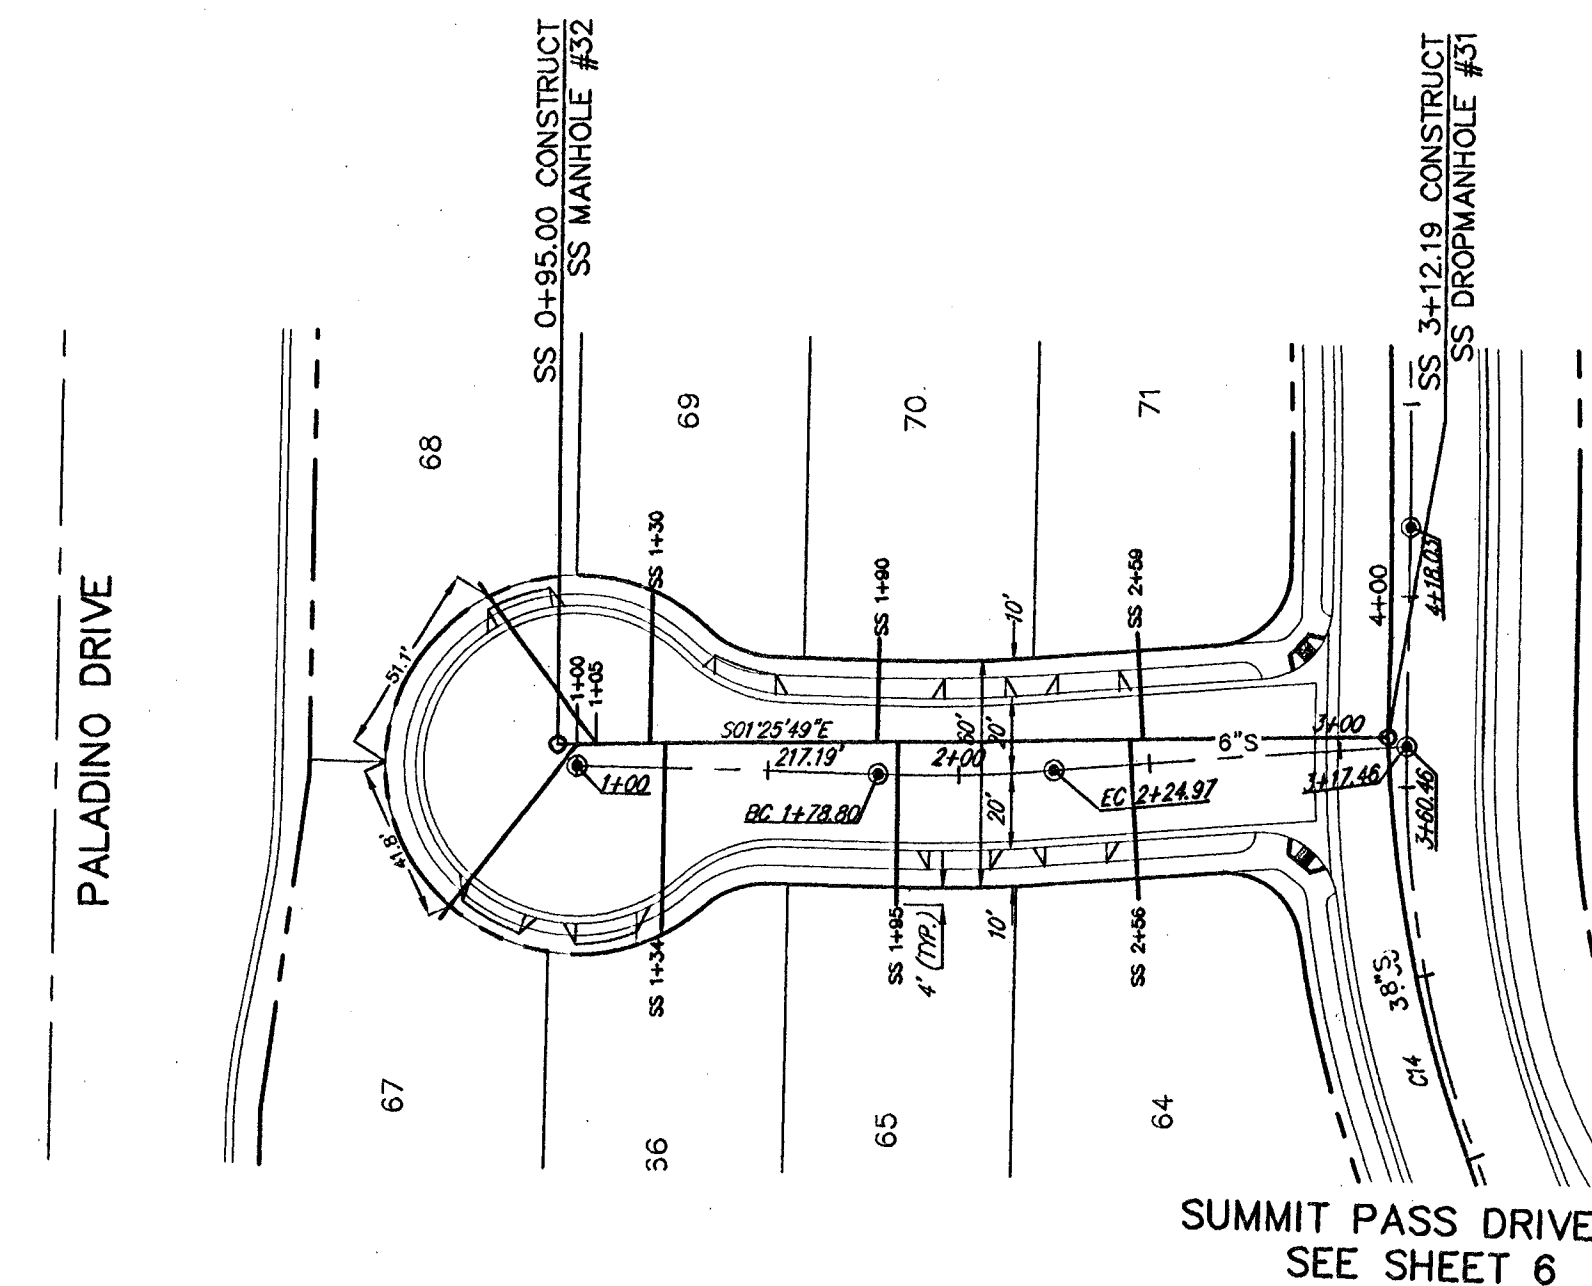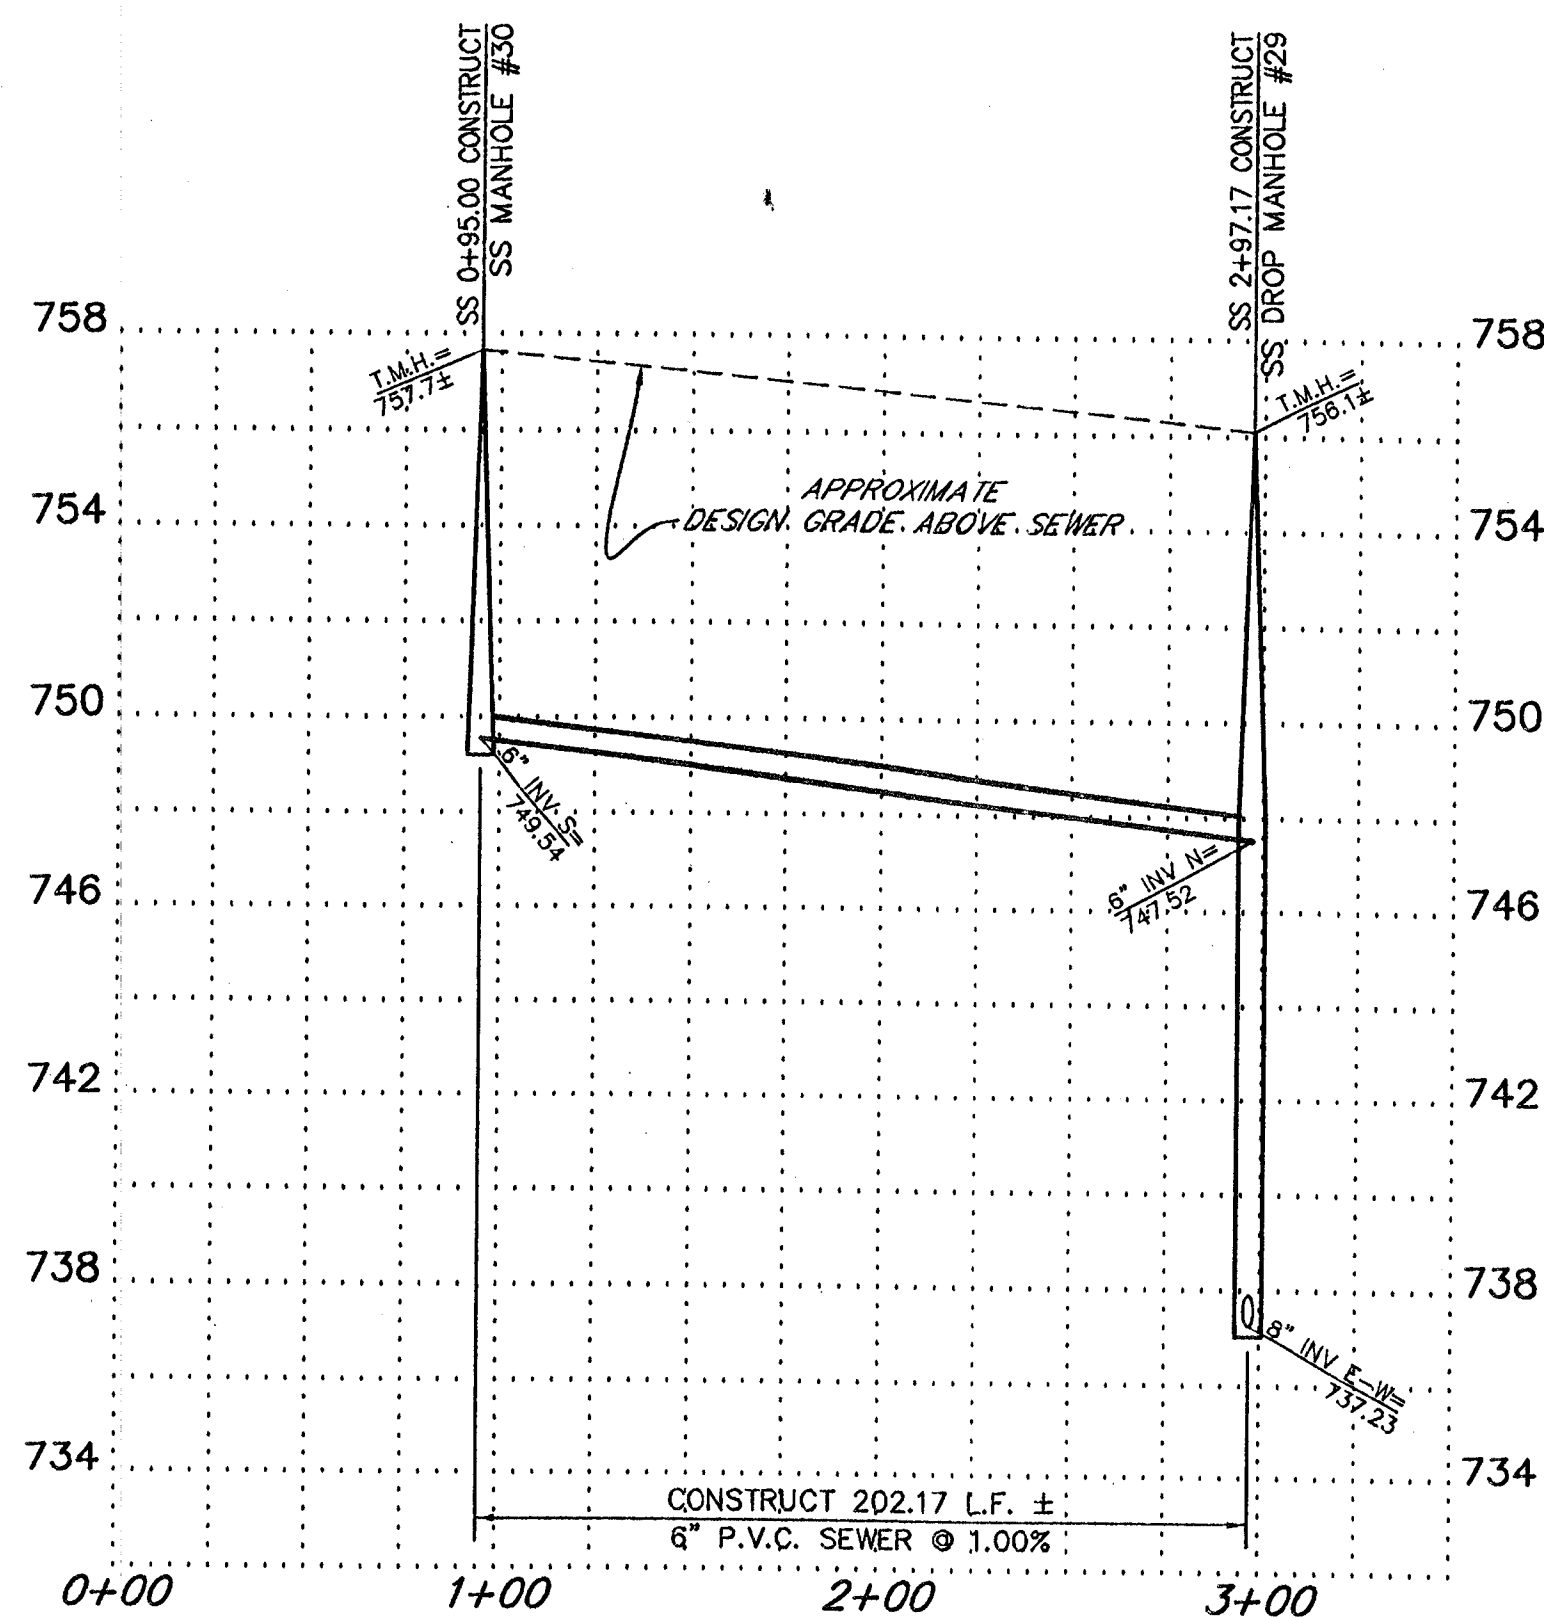

## CHARWOOD PLACE

(PRIVATE)


HORIZONTAL: 1" = 50'  
VERTICAL: 1" = 4'

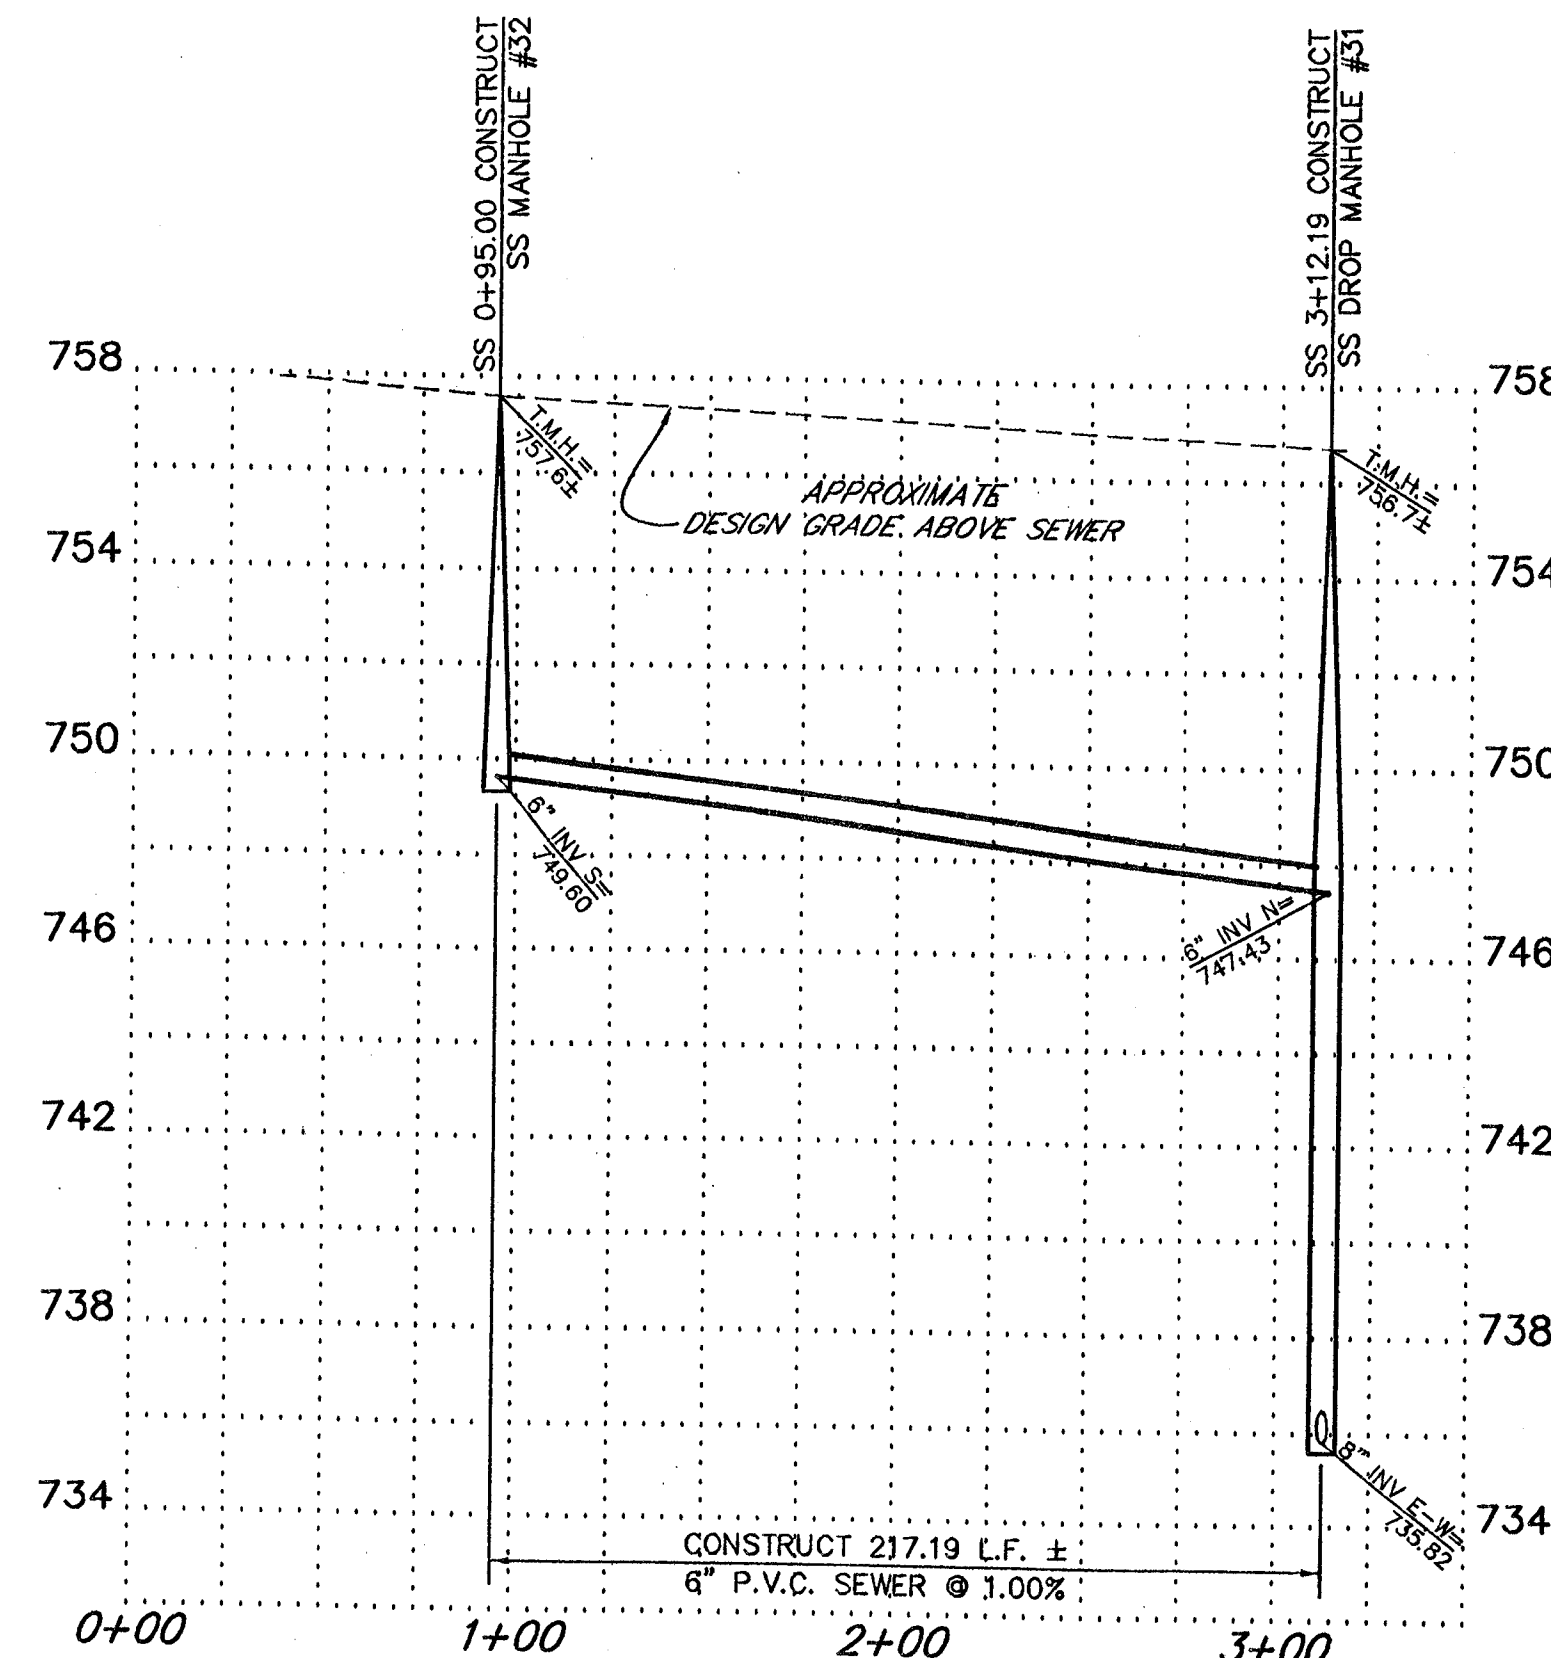

RECORD DRAWING

MATTHEW K. VOVILLA  
RCE 43130 EXPIRES 3-31-06

DATE

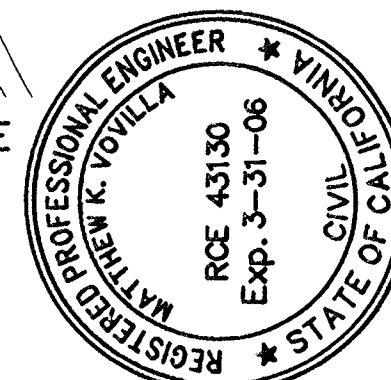

**PINNACLE Civil Engineering, Inc.**  
1712 19th Street, Suite 101, Bakersfield, CA 93301  
Phone: (661) 869-0184 Fax: (661) 328-0607




REVISIONS	DATE
1. UPDATED STREET NAMES	5/18/06

TRACT NO. 6444 - PHASE 1  
SEWER & STORM DRAIN PLANS  
K. HOVNANIAN  
BAKERSFIELD, CALIFORNIA




JOB NO.	04-158
DWG NO.	04-158SRBM01
DATE	11/21/05
DRAWN BY	MKS
CHECKED BY	MKV
SHEET	9
OF 13 SHEETS	


1.2-6444 1






 PROPOSED SEWER MANHOLE w/NUMBER  
 8" S PROPOSED SEWER LINE w/SIZE  
 PROPOSED RIGHT-OF-WAY  
 SS SEWER STATION  
 SD STORMDRAIN STATION

ALL SEWER LATERALS ARE 4" UNLESS OTHERWISE NOTED  
ALL SEWER LATERALS ARE TO HAVE A 4.5' MIN. -  
7' MAX. OF COVER AT THE PROPERTY LINE AND A  
MINIMUM OF 2.5' OF COVER AT GUTTER FLOWLINE.

 PROPOSED STORM-DRAIN MANHOLE  
 18" SD — PROPOSED STORM-DRAIN LINE w/ SIZE  
 ① CONSTRUCT TYPE "A" CATCH BASIN PER C.O.B.  
 STD. DWG. D-14

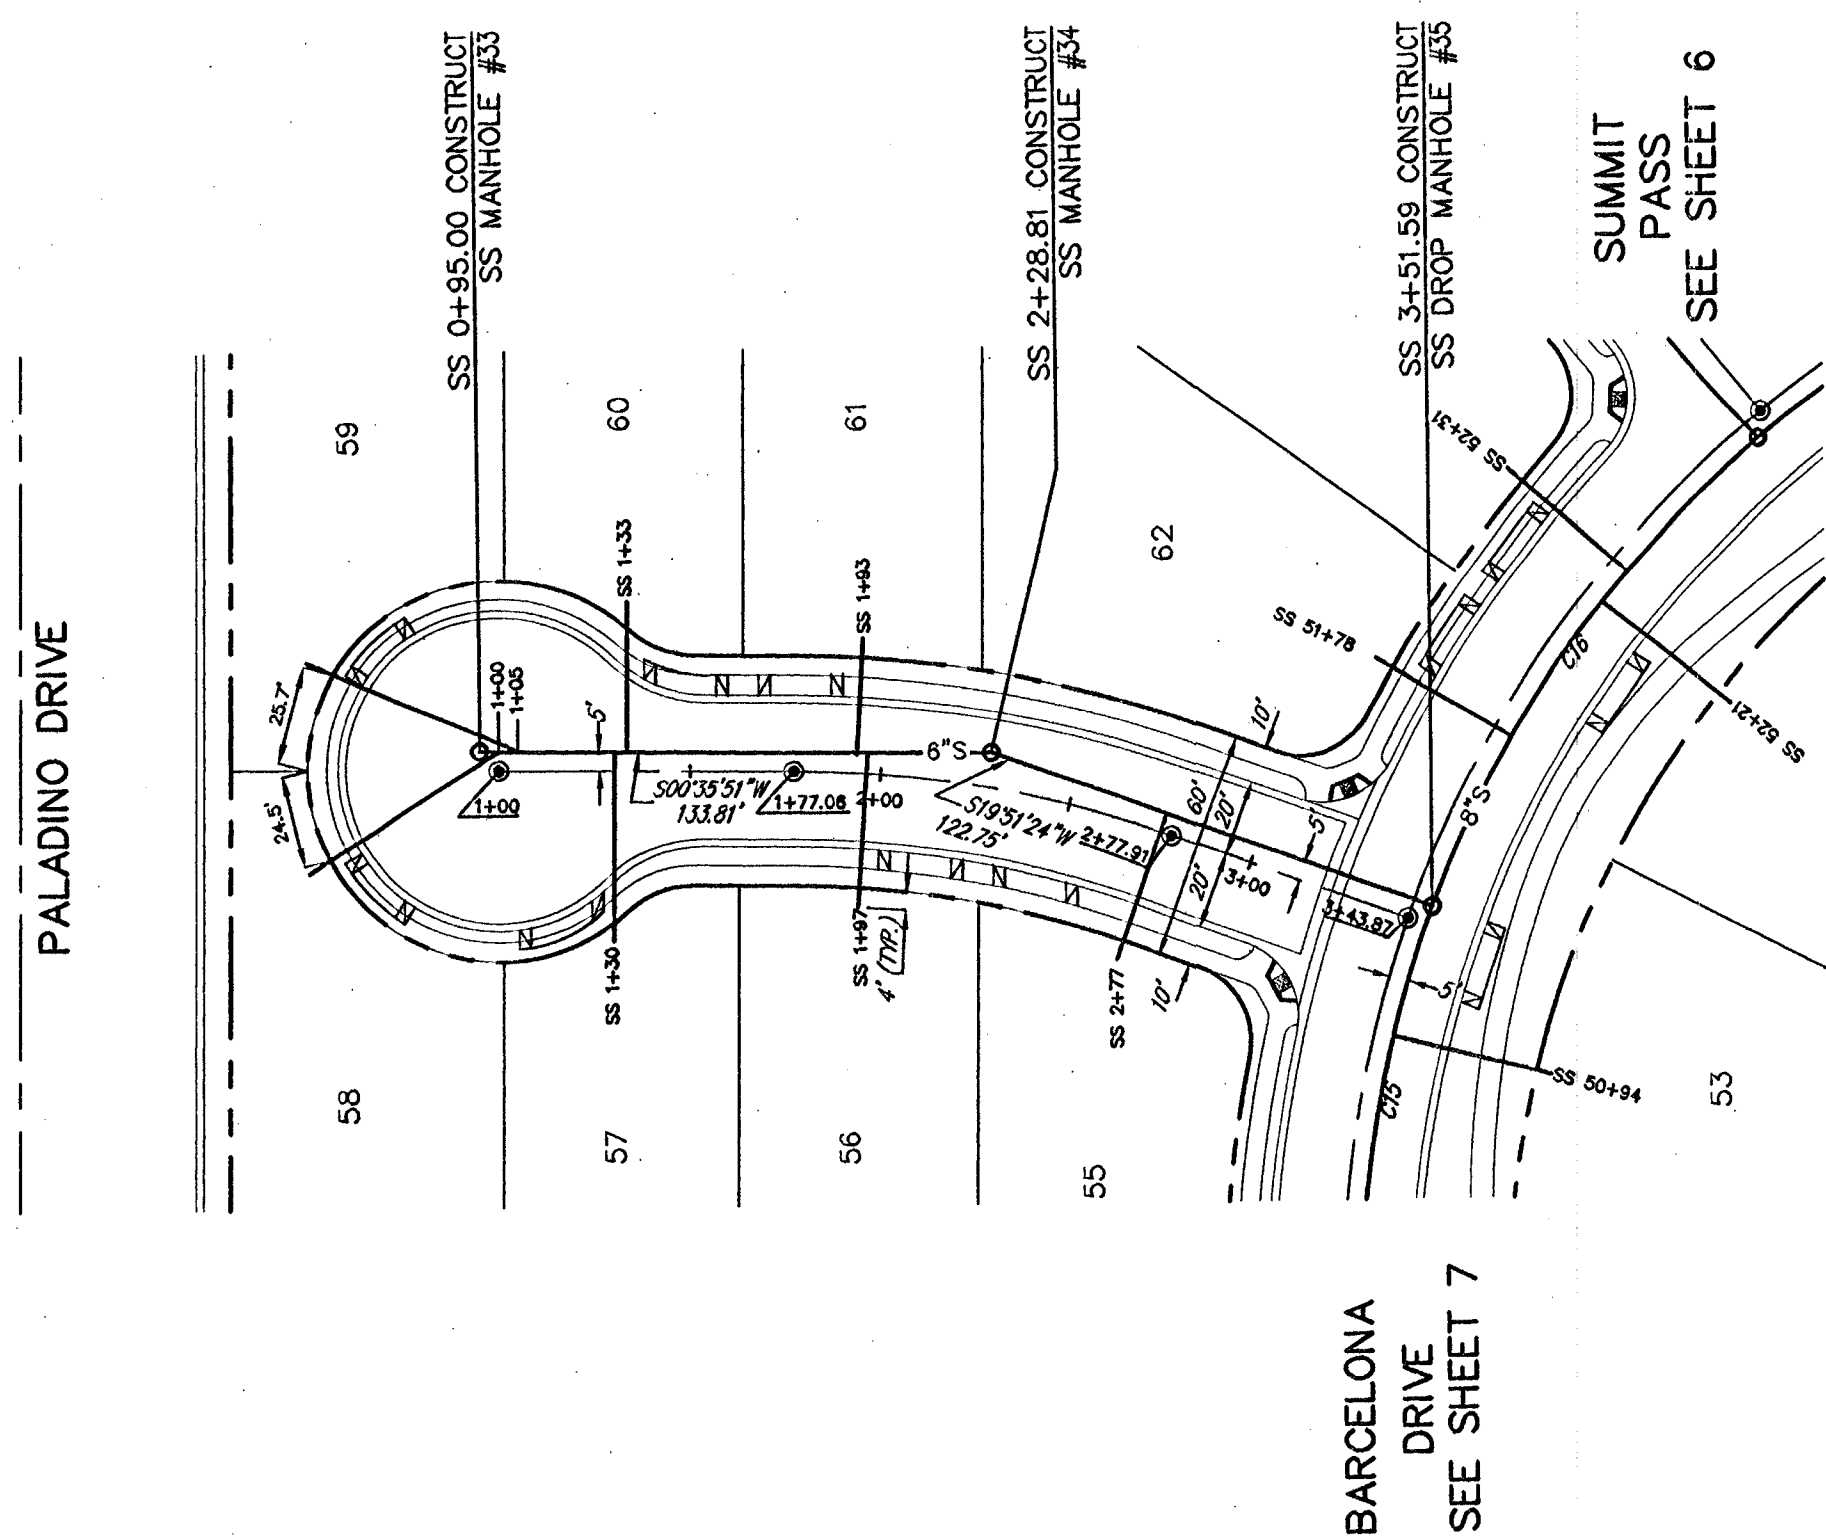


***PRETORIA PLACE***  
(PRIVATE)

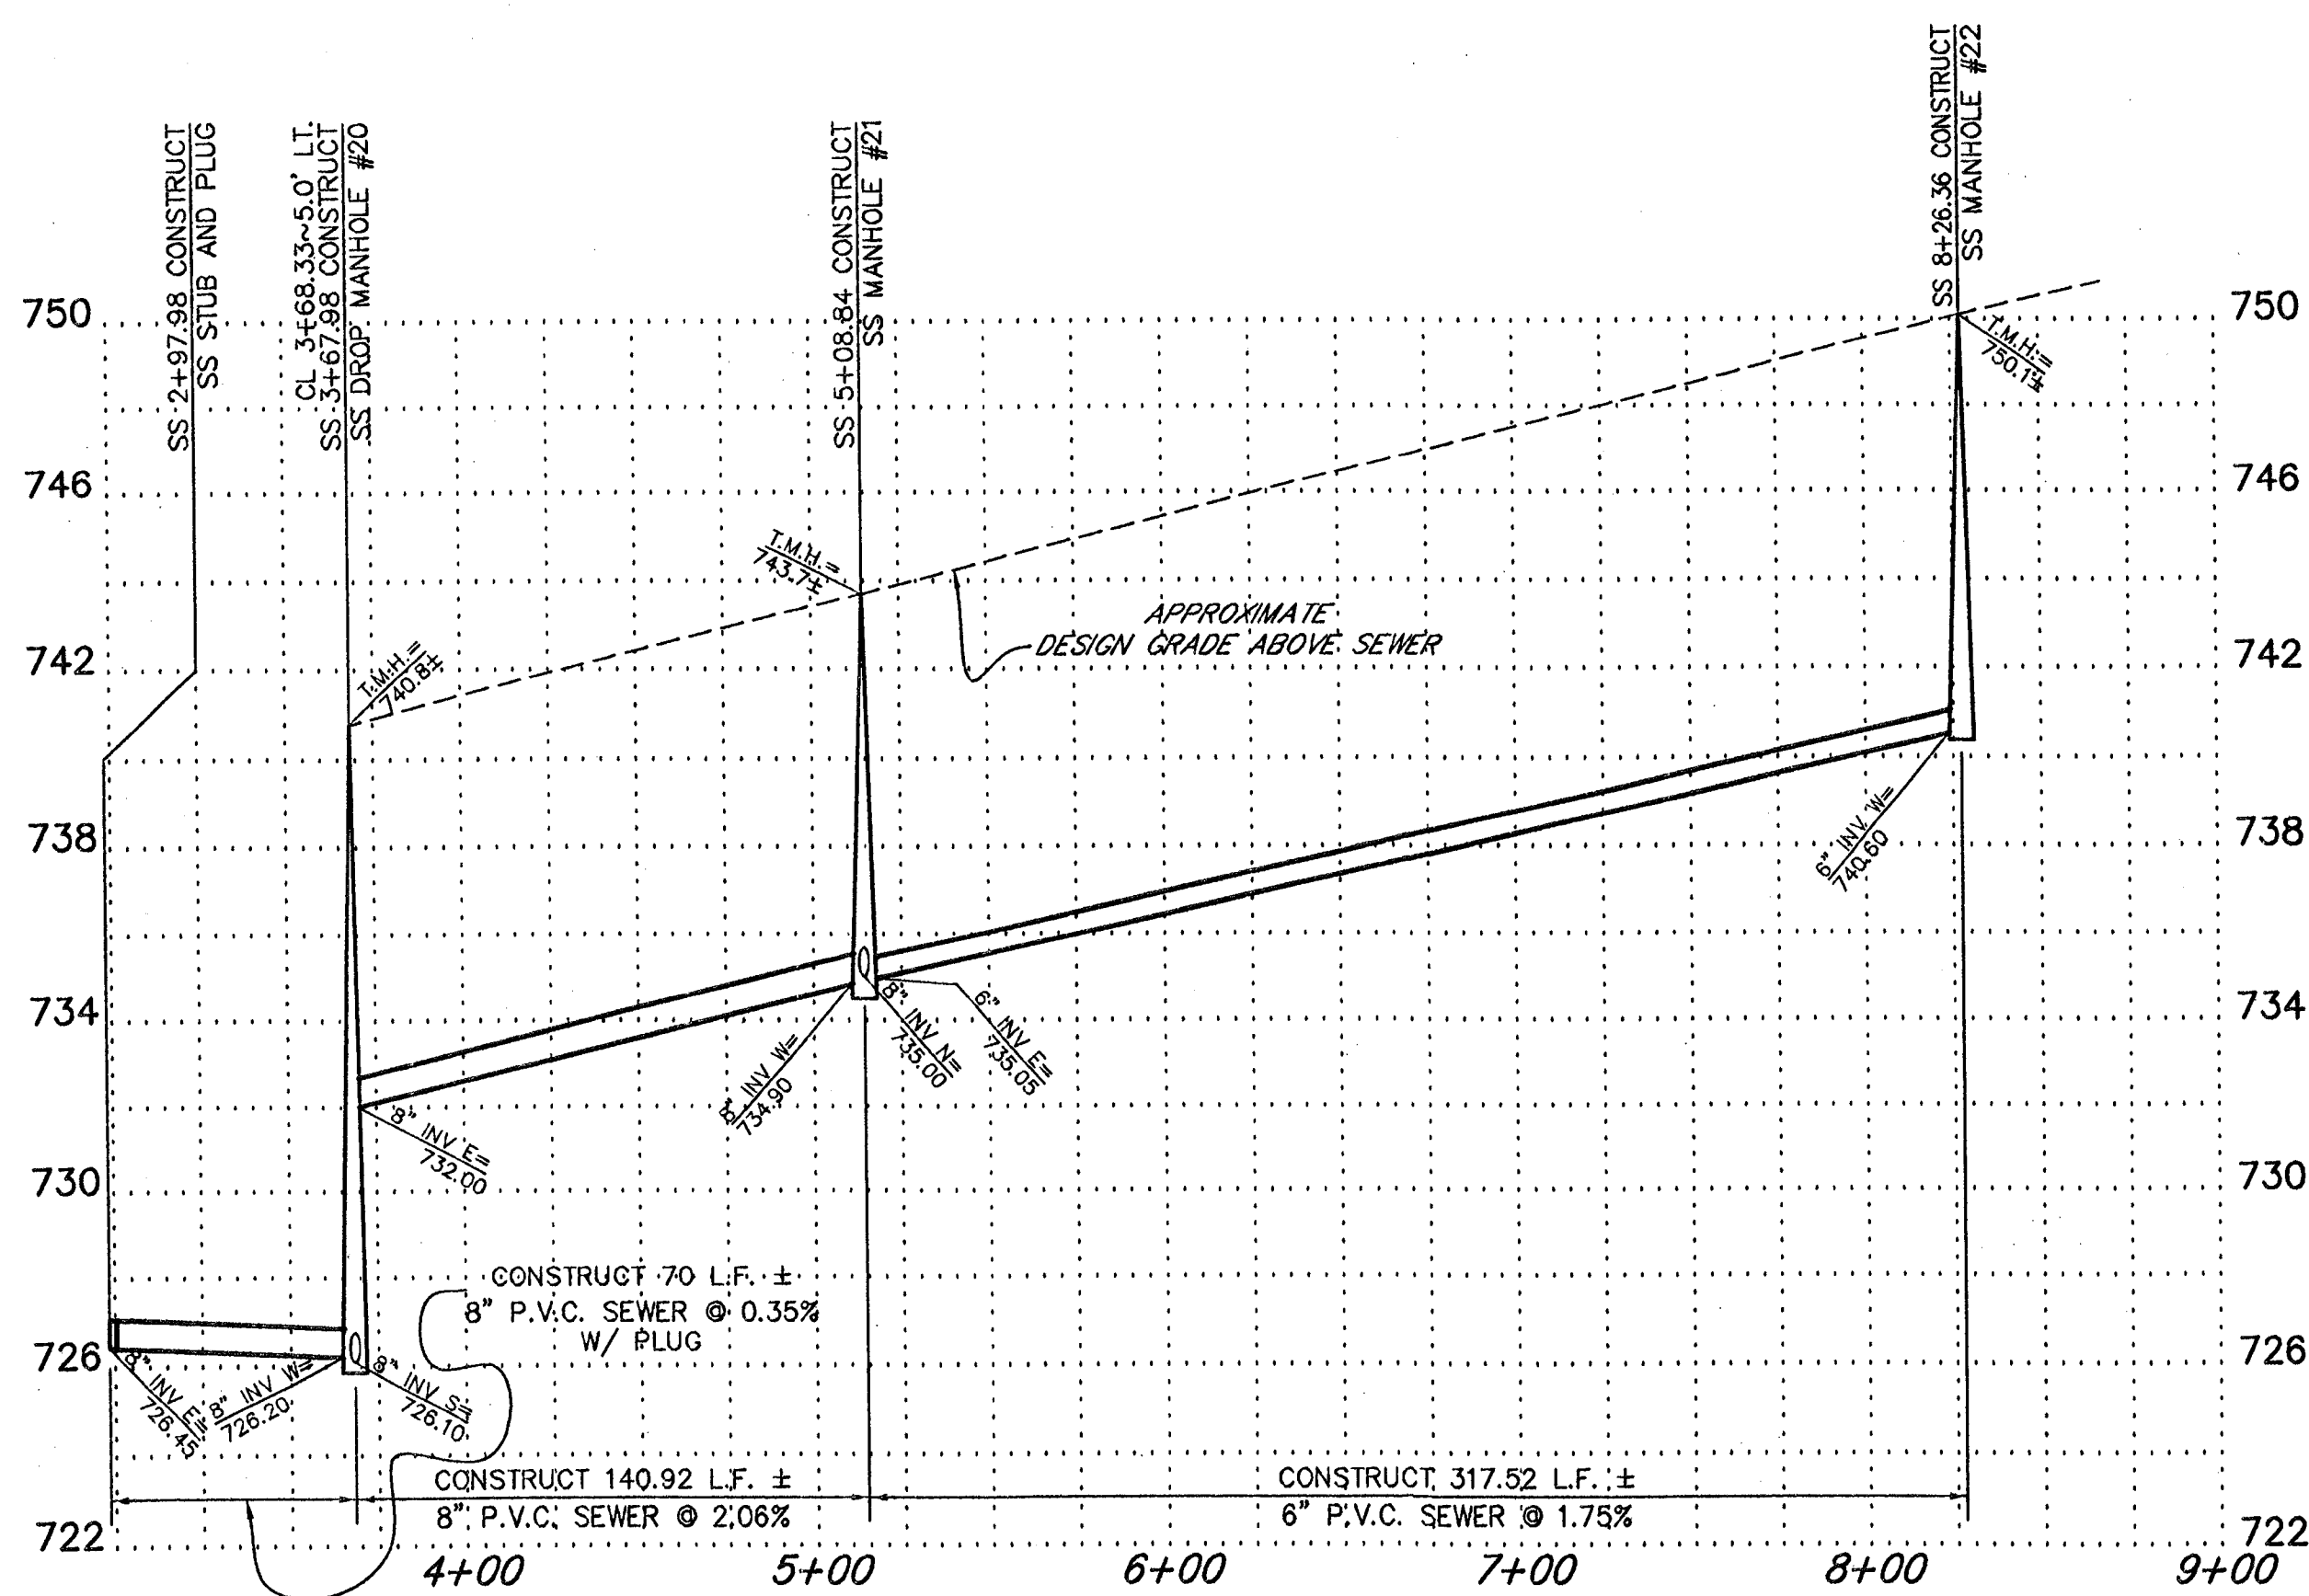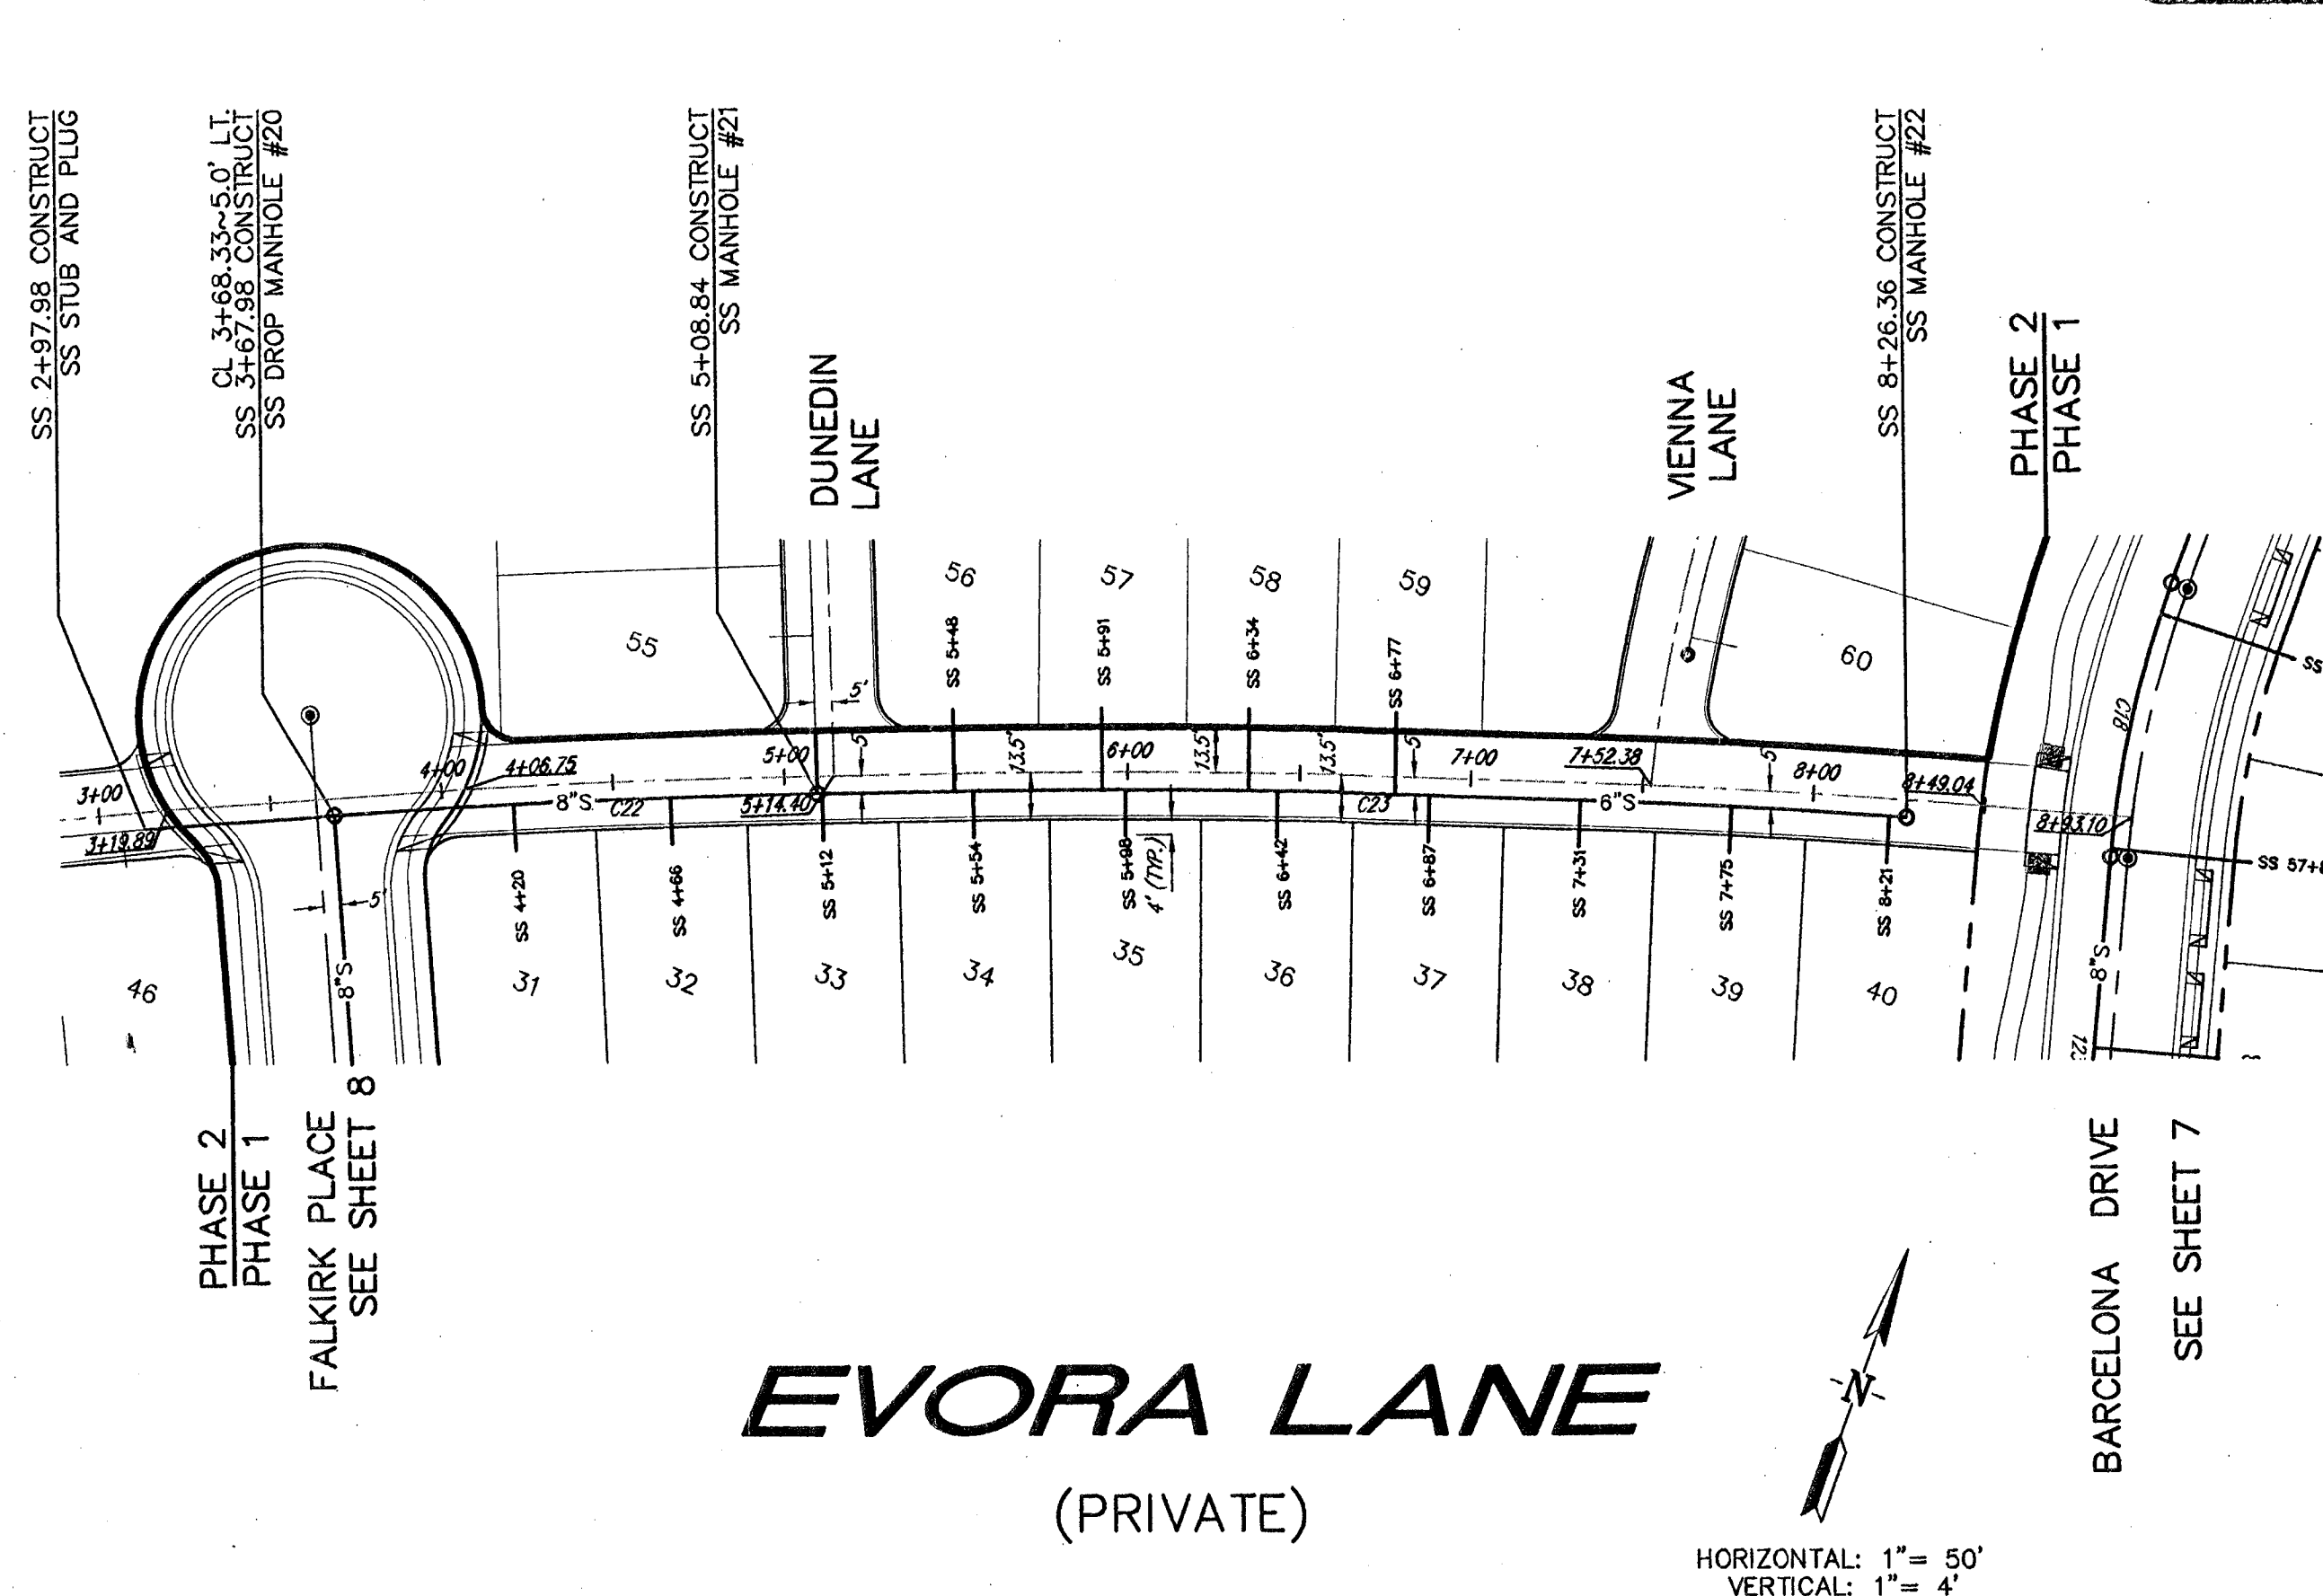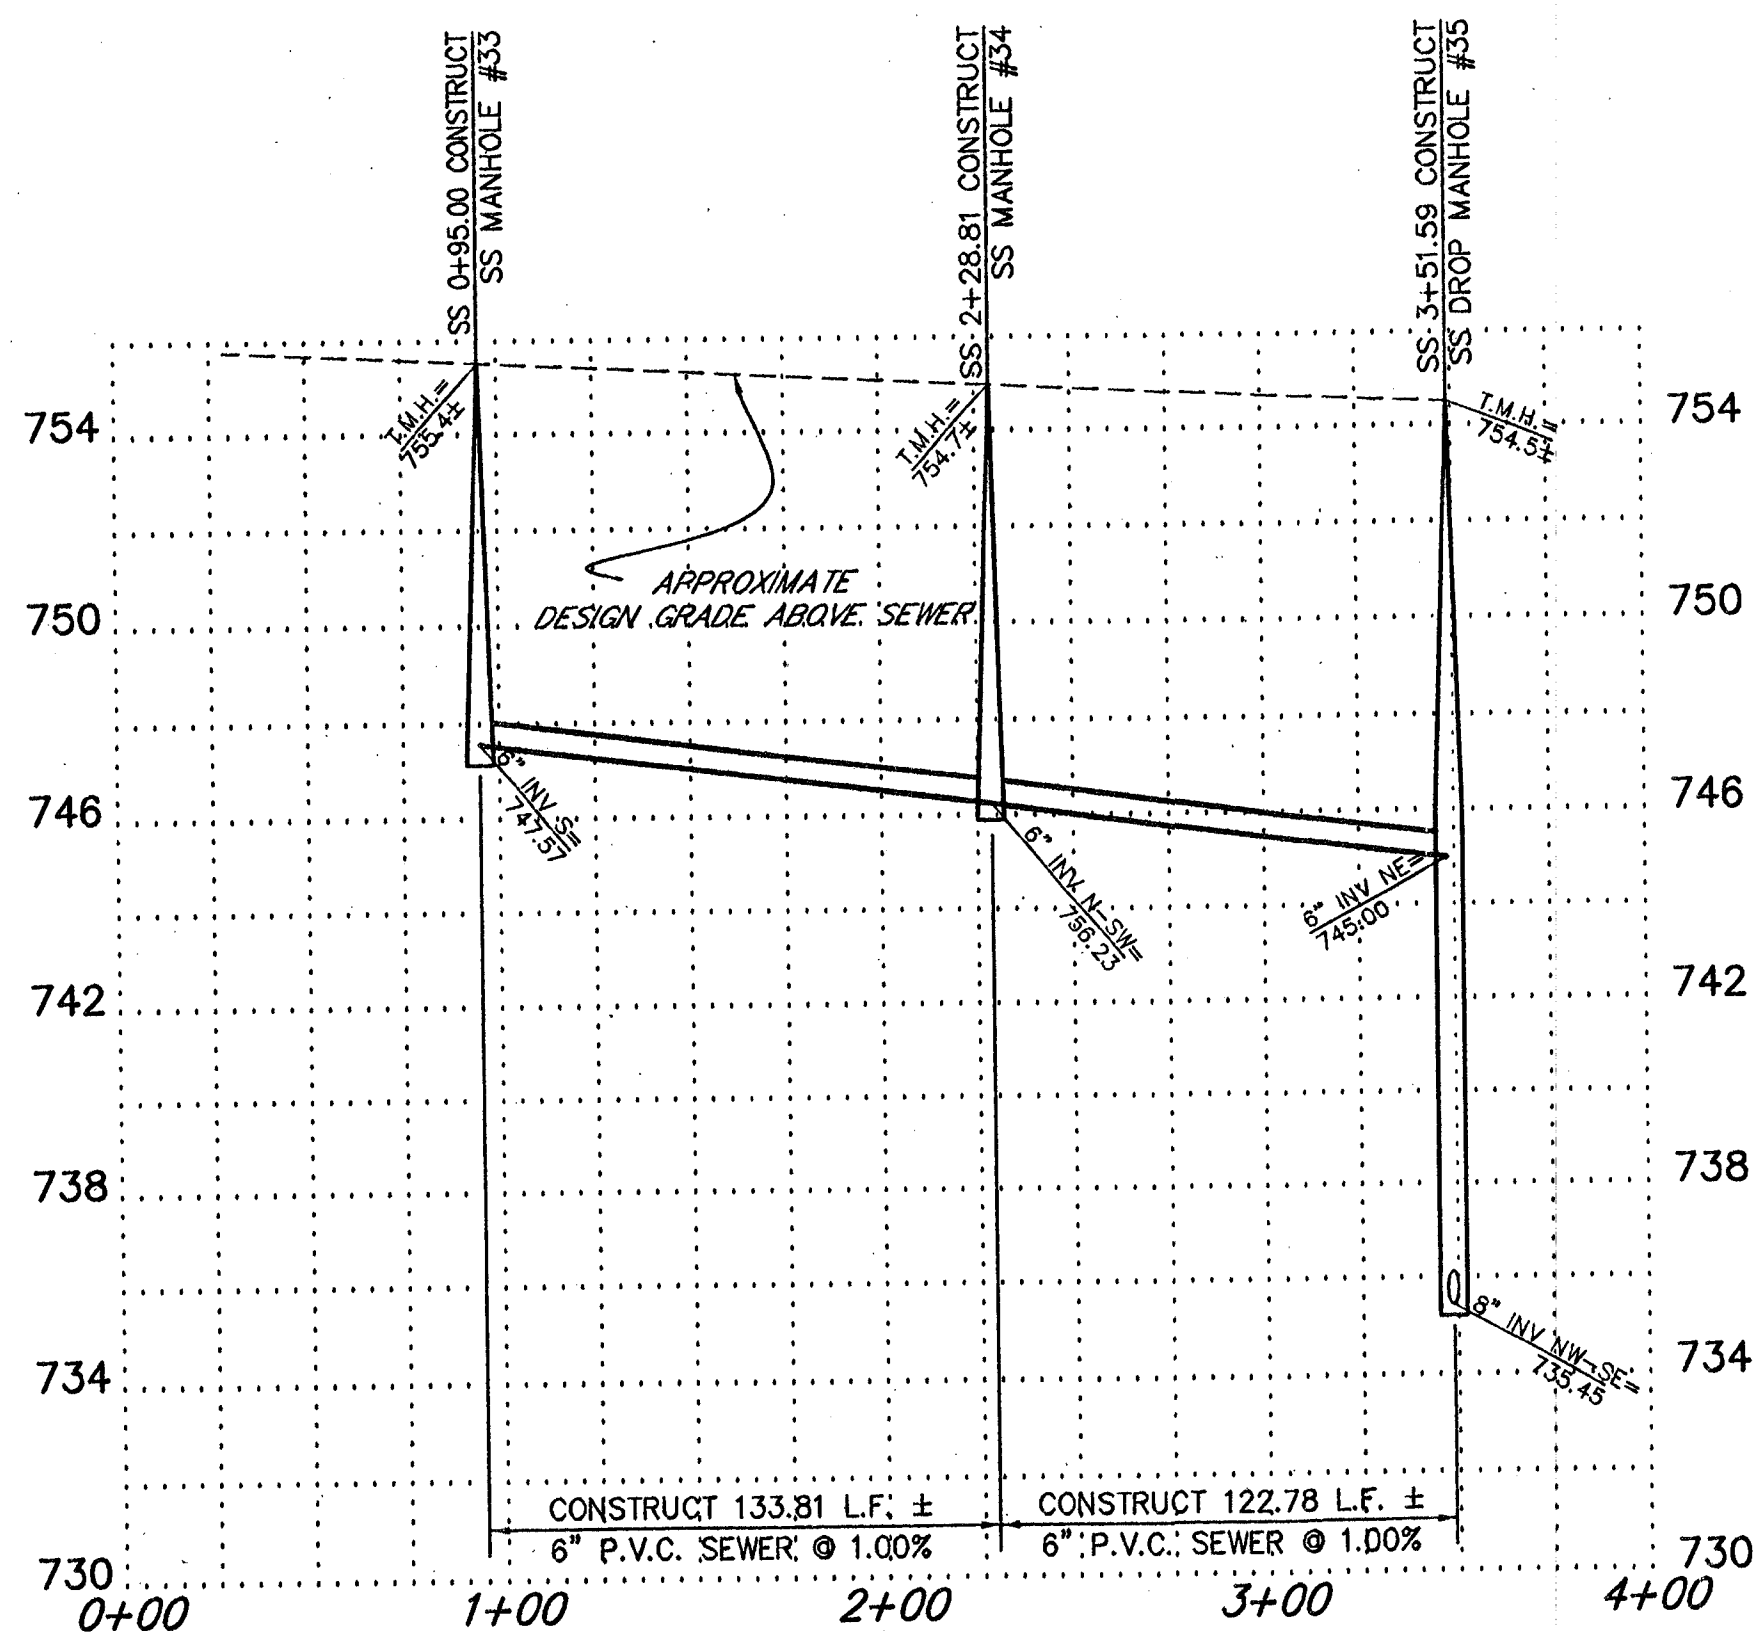

CURVE TABLE				
CURVE	LENGTH	RADIUS	TANGENT	DELTA
C22	140.86	3468.50	70.44	279°37"
C23	317.52	3468.50	158.87	574°42"

# RECORD DRAWING

Matthew K. Novilla 5-11-07  
DATE  
PC# 48190 EXPIRES 3-31-08

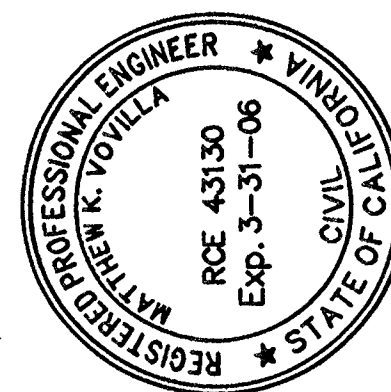

**PINNACLE** Civil Engineering, Inc.

1712 19th Street, Suite 101, Bakersfield, CA 93301  
Phone: (661) 869-0184 Fax: (661) 328-0607

Phone: (661) 869-0184 Fax: (661) 328-0607

MATTHEW K. VOVILLA RCE 43130 EXP. 3/31/06

REVISIONS	DATE
-----------	------

## REVISIONS

**TRACT NO. 6444 - PHASE 1  
SEWER & STORM DRAIN PLANS  
K. HOVNANIAN  
BAKERSFIELD, CALIFORNIA**

JOB No.:	04-158
DWG NO.:	04-158SWRBM01
DATE:	11/21/05
DRAWN BY:	MJS
CHECKED BY:	MKV
SHEET	10

OF 13 SHEETS



- LEGEND**
- PROPOSED SEWER MANHOLE w/NUMBER
  - 8" S PROPOSED SEWER LINE w/SIZE
  - PROPOSED RIGHT-OF-WAY
  - SS SEWER STATION
  - SD STORMDRAIN STATION
- ALL SEWER LATERALS ARE 4" UNLESS OTHERWISE NOTED  
ALL SEWER LATERALS ARE TO HAVE A 4.5' MIN. -  
7' MAX. OF COVER AT THE PROPERTY LINE AND A  
MINIMUM OF 2.5' OF COVER AT GUTTER FLOWLINE.
- PROPOSED STORM-DRAIN MANHOLE
  - 18" SD PROPOSED STORM-DRAIN LINE w/SIZE
  - CONSTRUCT TYPE "A" CATCH BASIN PER C.O.B.  
STD. DWG. D-14


CURVE TABLE				
CURVE	LENGTH	RADIUS	TANGENT	DELTA
C19	135.61	422.50	68.39	19°23'23"

RECORD DRAWING

MATTHEW K. VOVILLA  
RCE 43130 EXPIRES 3-31-08

DATE


LODGE SITE

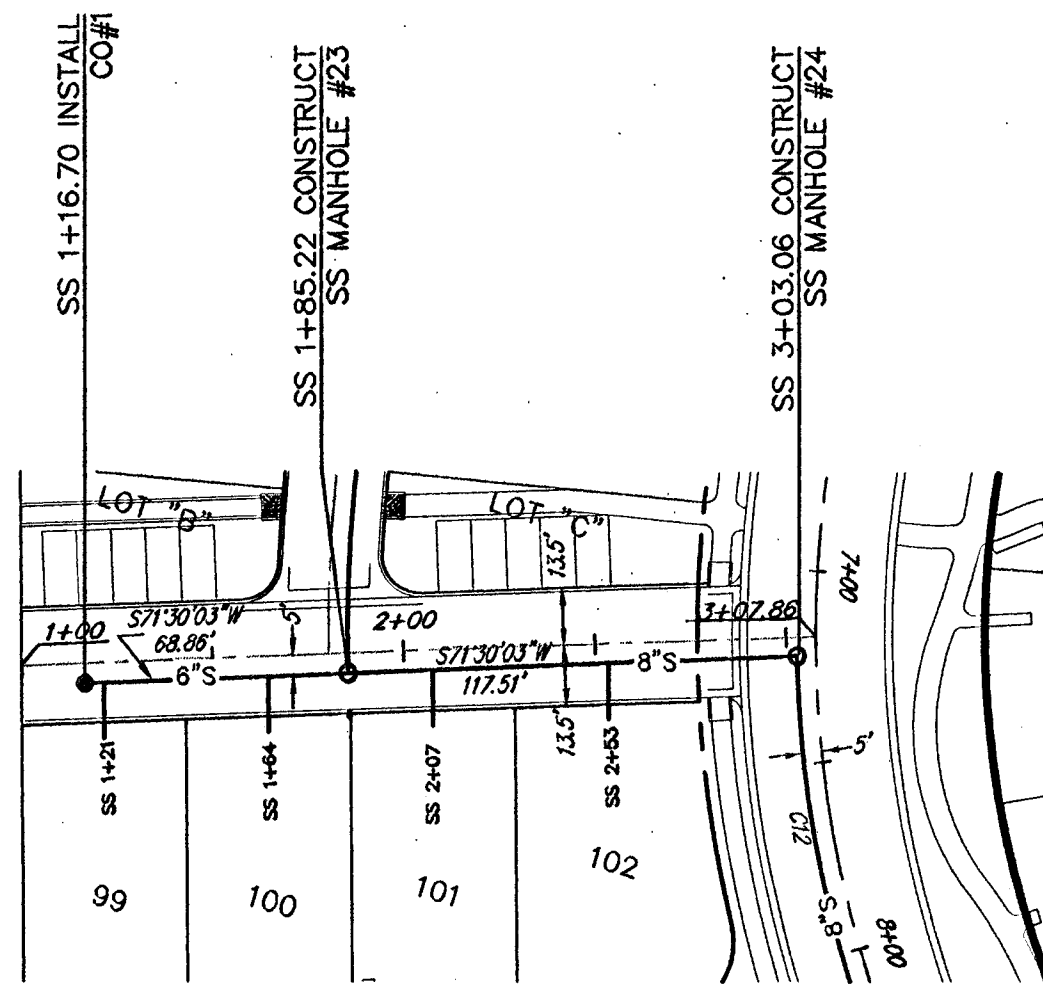

HORIZONTAL: 1" = 50'  
VERTICAL: 1" = 4'

**RED HILLS LANE**  
(PRIVATE)


SUNSET HILLS  
LANE  
SEE RIGHT

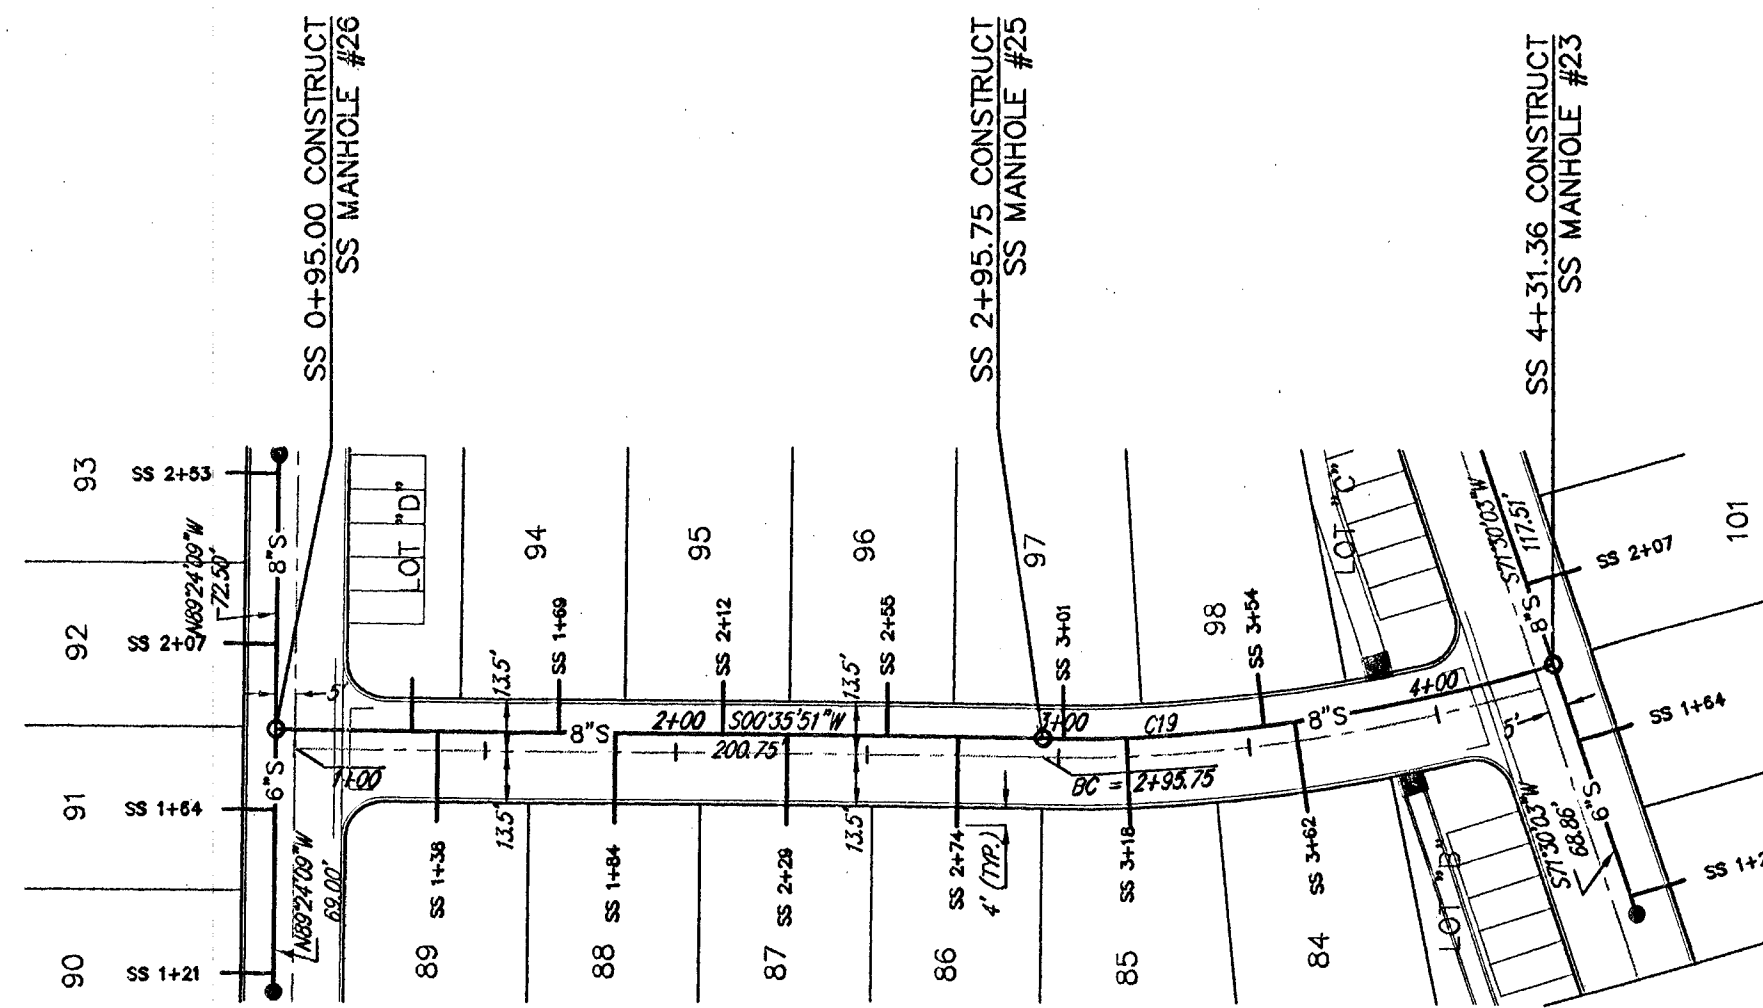

HORIZONTAL: 1" = 50'  
VERTICAL: 1" = 4'





**ROLLING HILLS LANE**  
(PRIVATE)

LODGE SITE

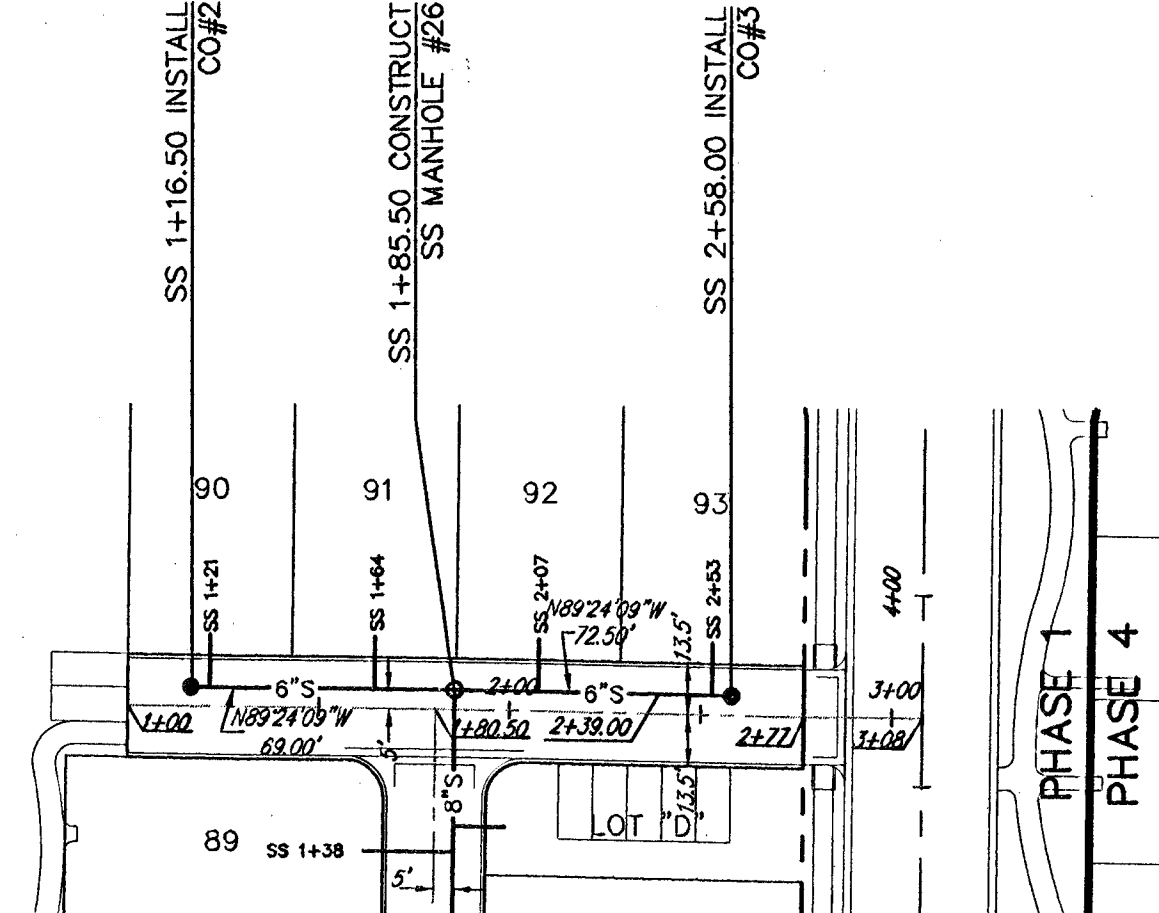

HORIZONTAL: 1" = 50'  
VERTICAL: 1" = 4'

**SUNSET HILLS LANE**  
(PRIVATE)

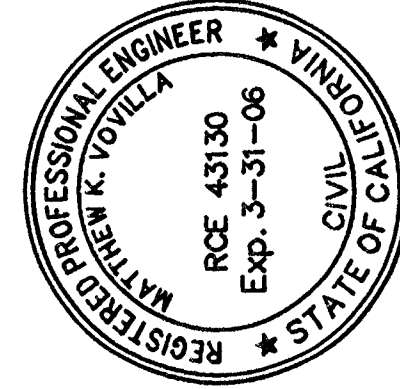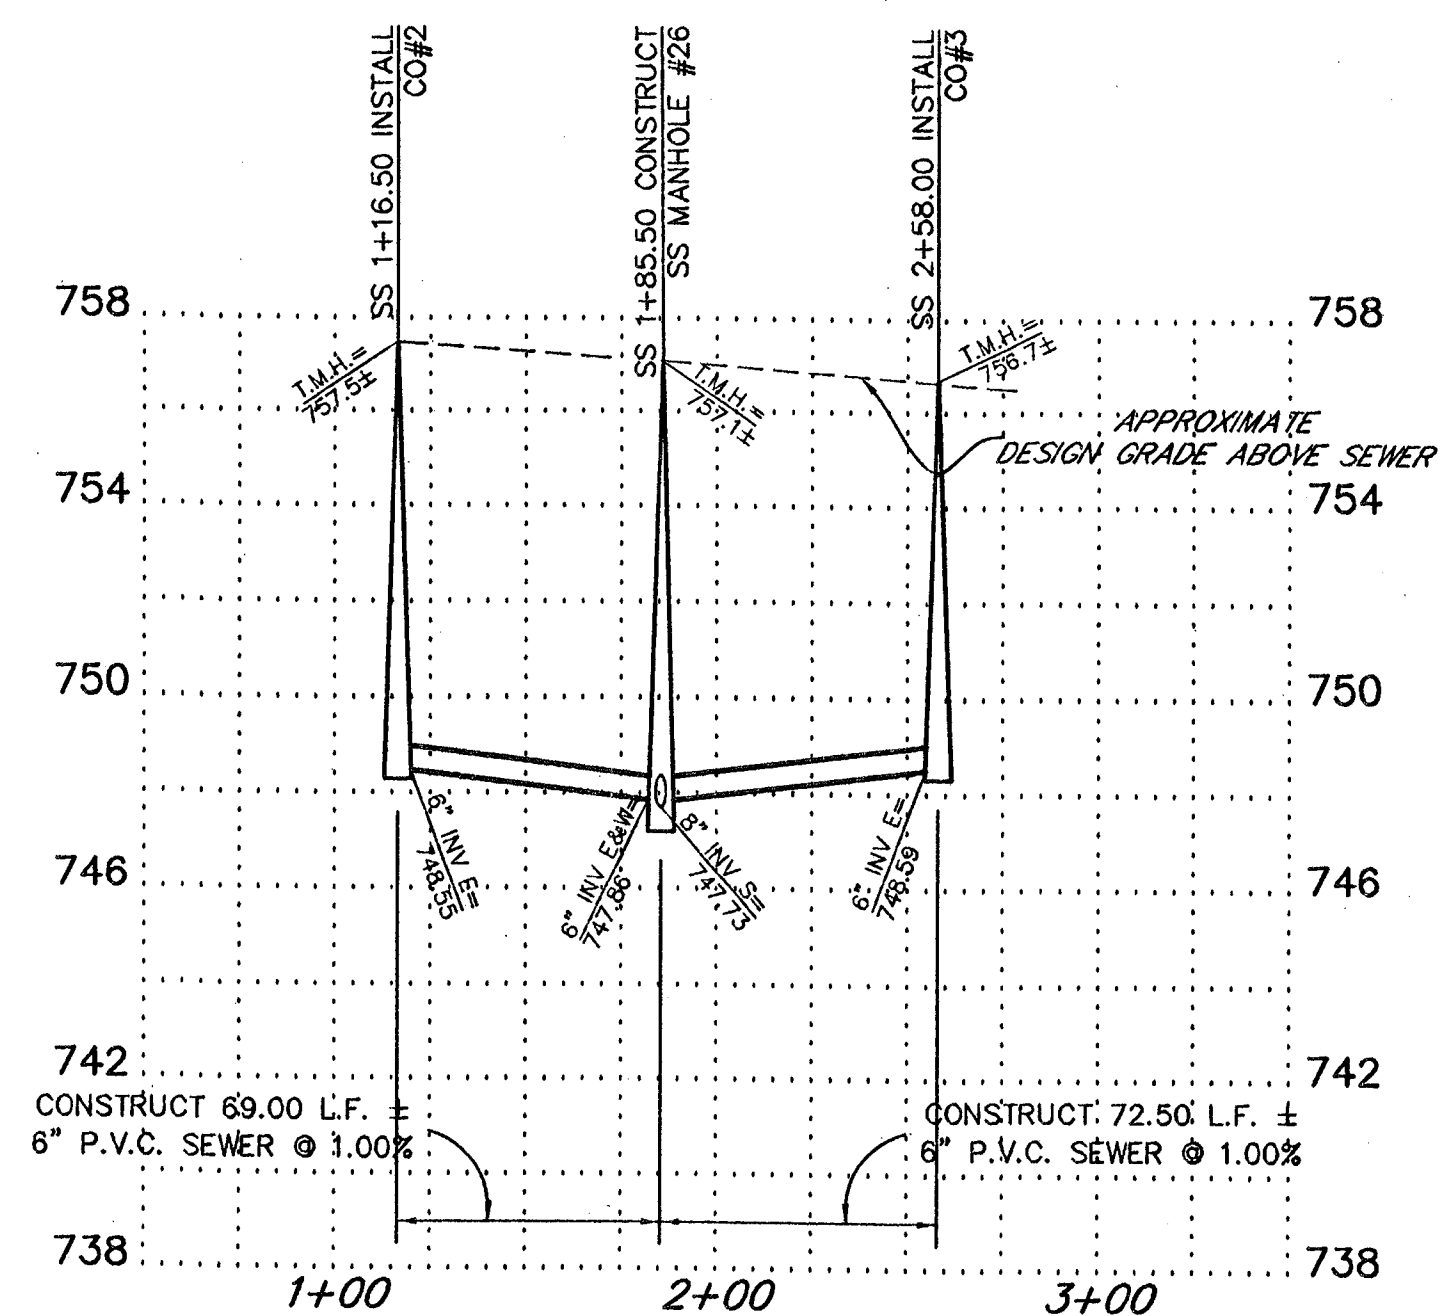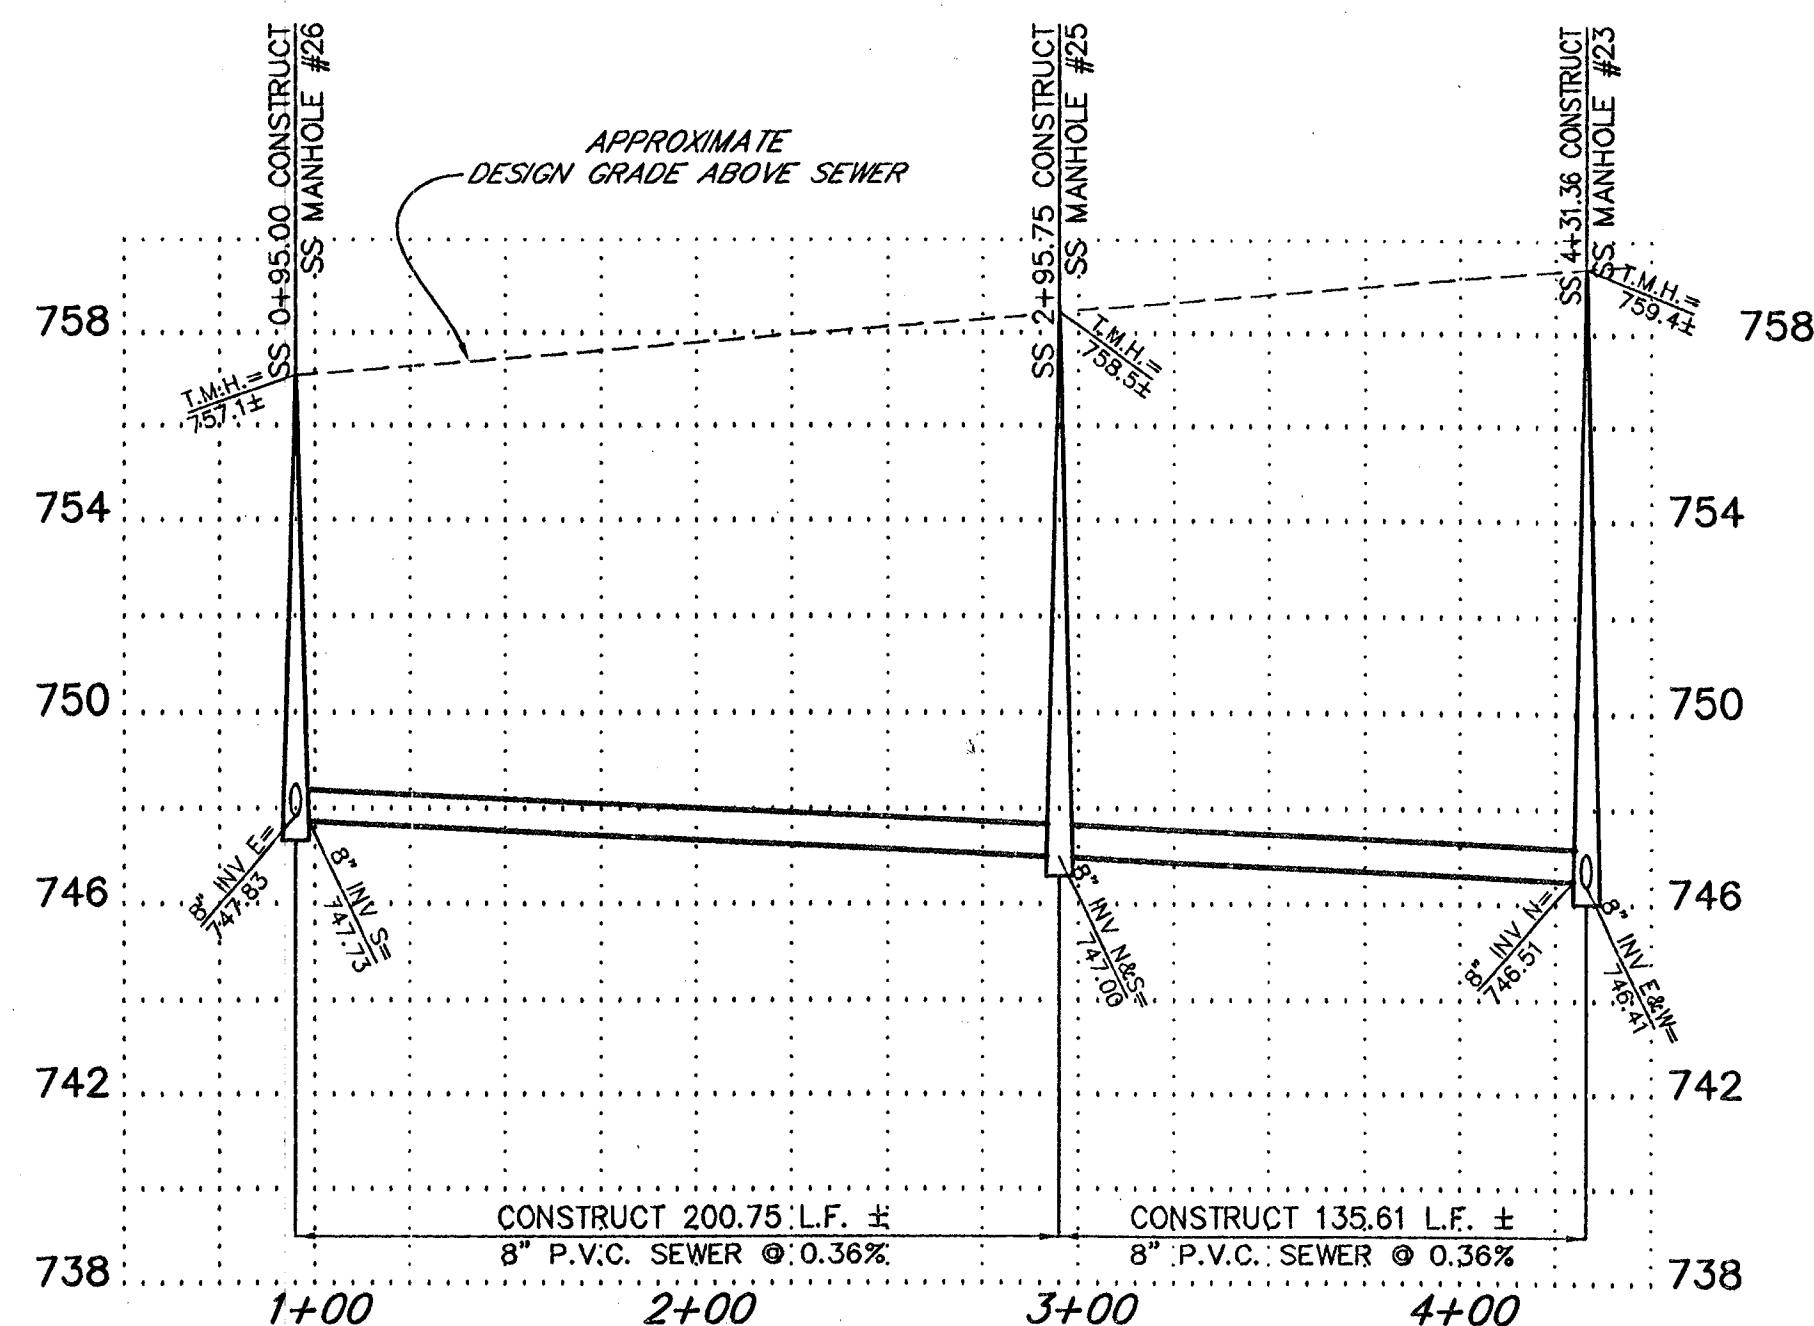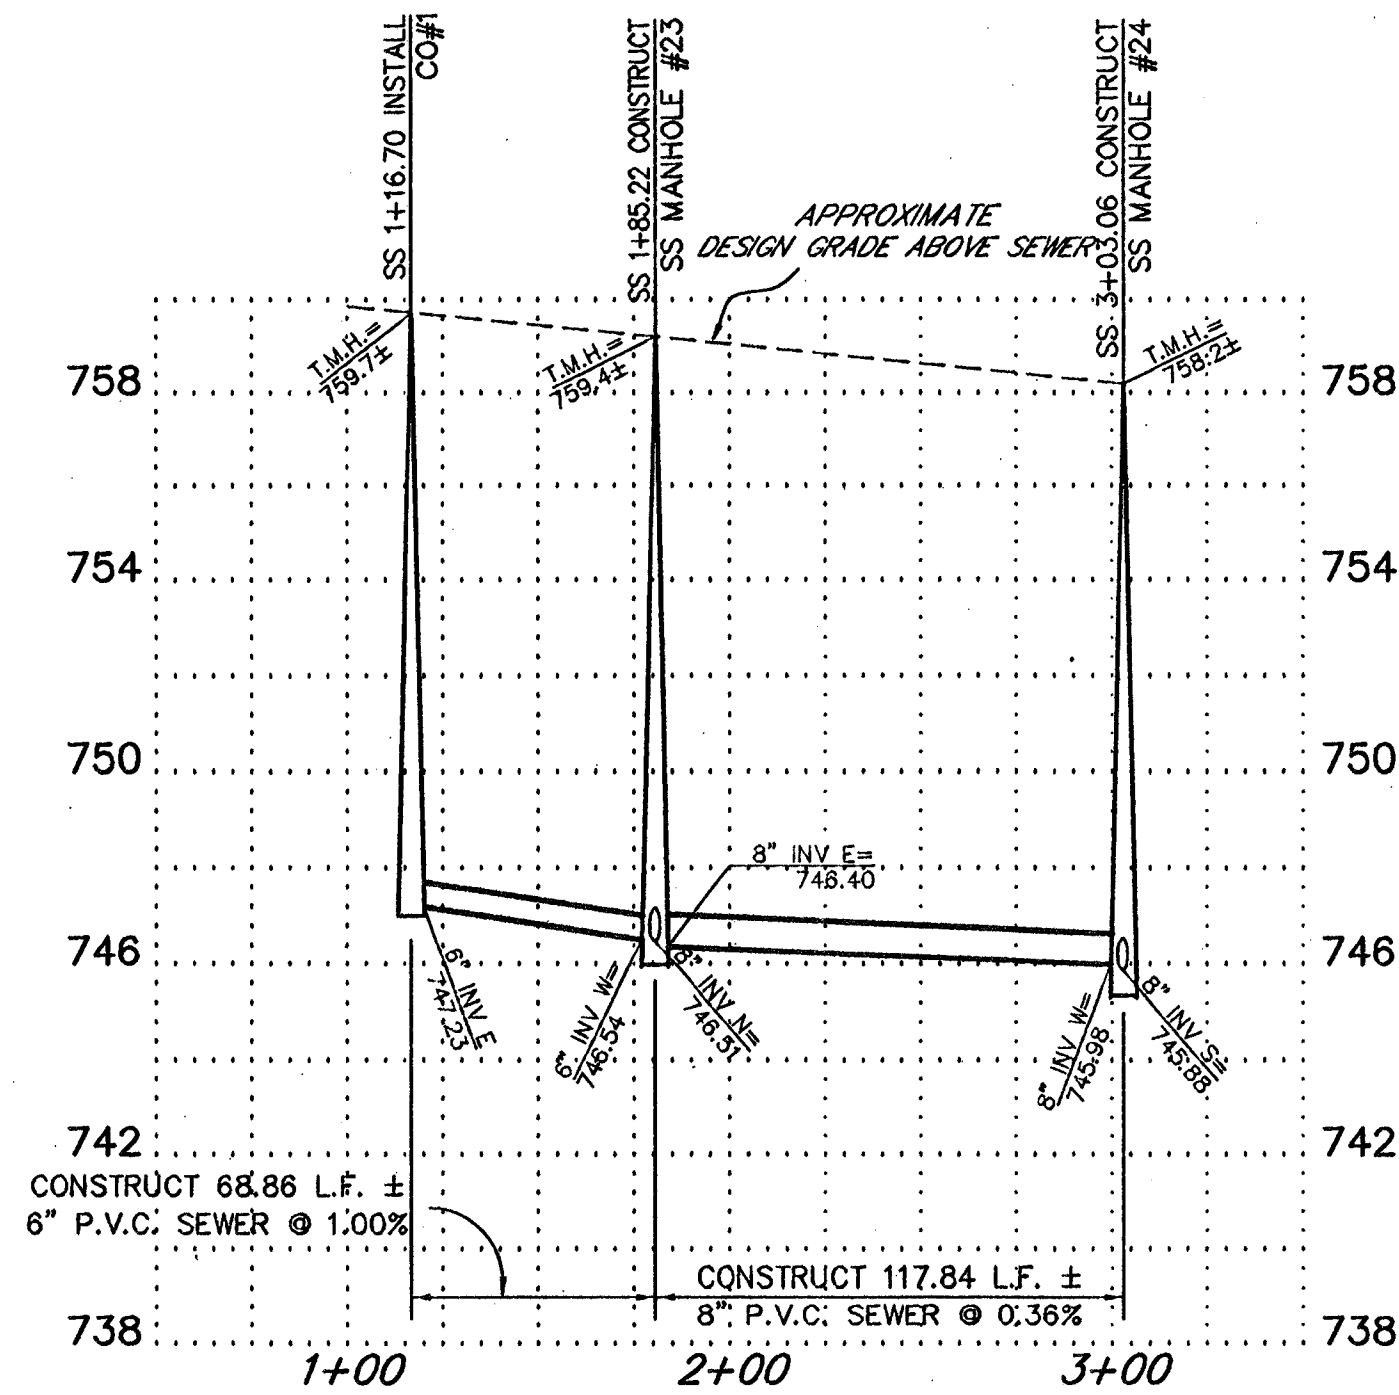

**PINNACLE Civil Engineering, Inc.**  
1712 19th Street, Suite 101, Bakersfield, CA 93301  
Phone: (661) 869-0184 Fax: (661) 328-0607

REVISIONS  
DATE  
A. UPDATED STREET NAMES  
5/16/06

**TRACT NO. 6444 - PHASE 1  
SEWER & STORM DRAIN PLANS  
K. HOVNANIAN  
BAKERSFIELD, CALIFORNIA**

JOB NO.: 04-158  
DWG NO.: 04-158SIVRBM01  
DATE: 11/21/05  
DRAWN BY: MUS  
CHECKED BY: MKV  
SHEET 11  
OF 13 SHEETS

12-6444 1





# LEGEND

- PROPOSED SEWER MANHOLE w/NUMBER
- 8" S PROPOSED SEWER LINE w/SIZE
- PROPOSED RIGHT-OF-WAY
- SS SEWER STATION
- SD STORMDRAIN STATION


ALL SEWER LATERALS ARE 4" UNLESS OTHERWISE NOTED  
ALL SEWER LATERALS ARE TO HAVE A 4.5' MIN. - 7' MAX. OF COVER AT THE PROPERTY LINE AND A MINIMUM OF 2.5' OF COVER AT GUTTER FLOWLINE.

- PROPOSED STORM-DRAIN MANHOLE
- 18" SD PROPOSED STORM-DRAIN LINE w/SIZE
- CONSTRUCT TYPE "A" CATCH BASIN PER C.O.B. STD. DWG. D-14
- CATCH BASIN (WITHIN PHASE 3) TO BE CONSTRUCTED WITH PHASE 3 IMPROVEMENTS(TYP.) LATERALS TO EACH CATCH BASIN TO BE CONSTRUCTED AS SHOWN.

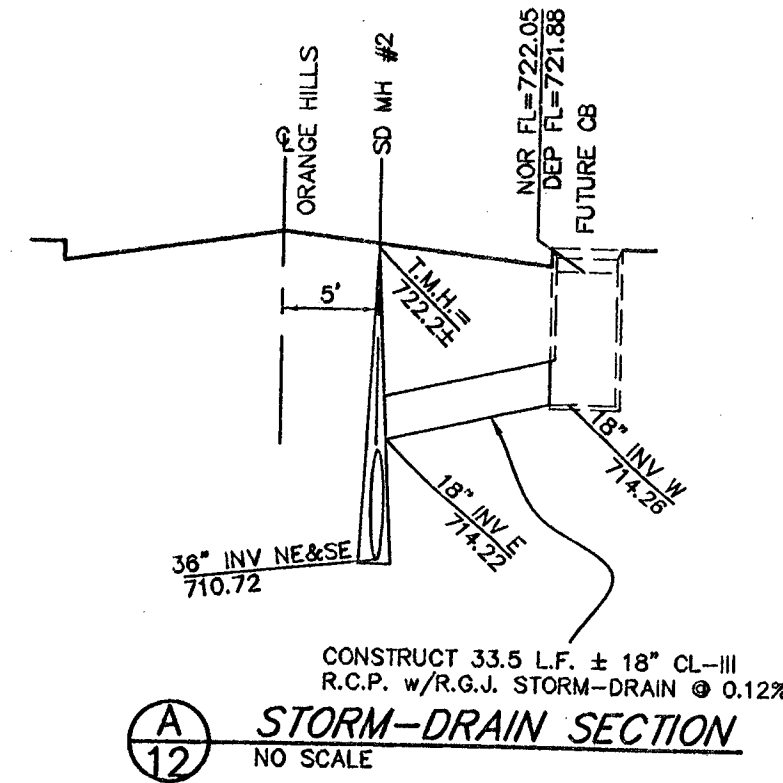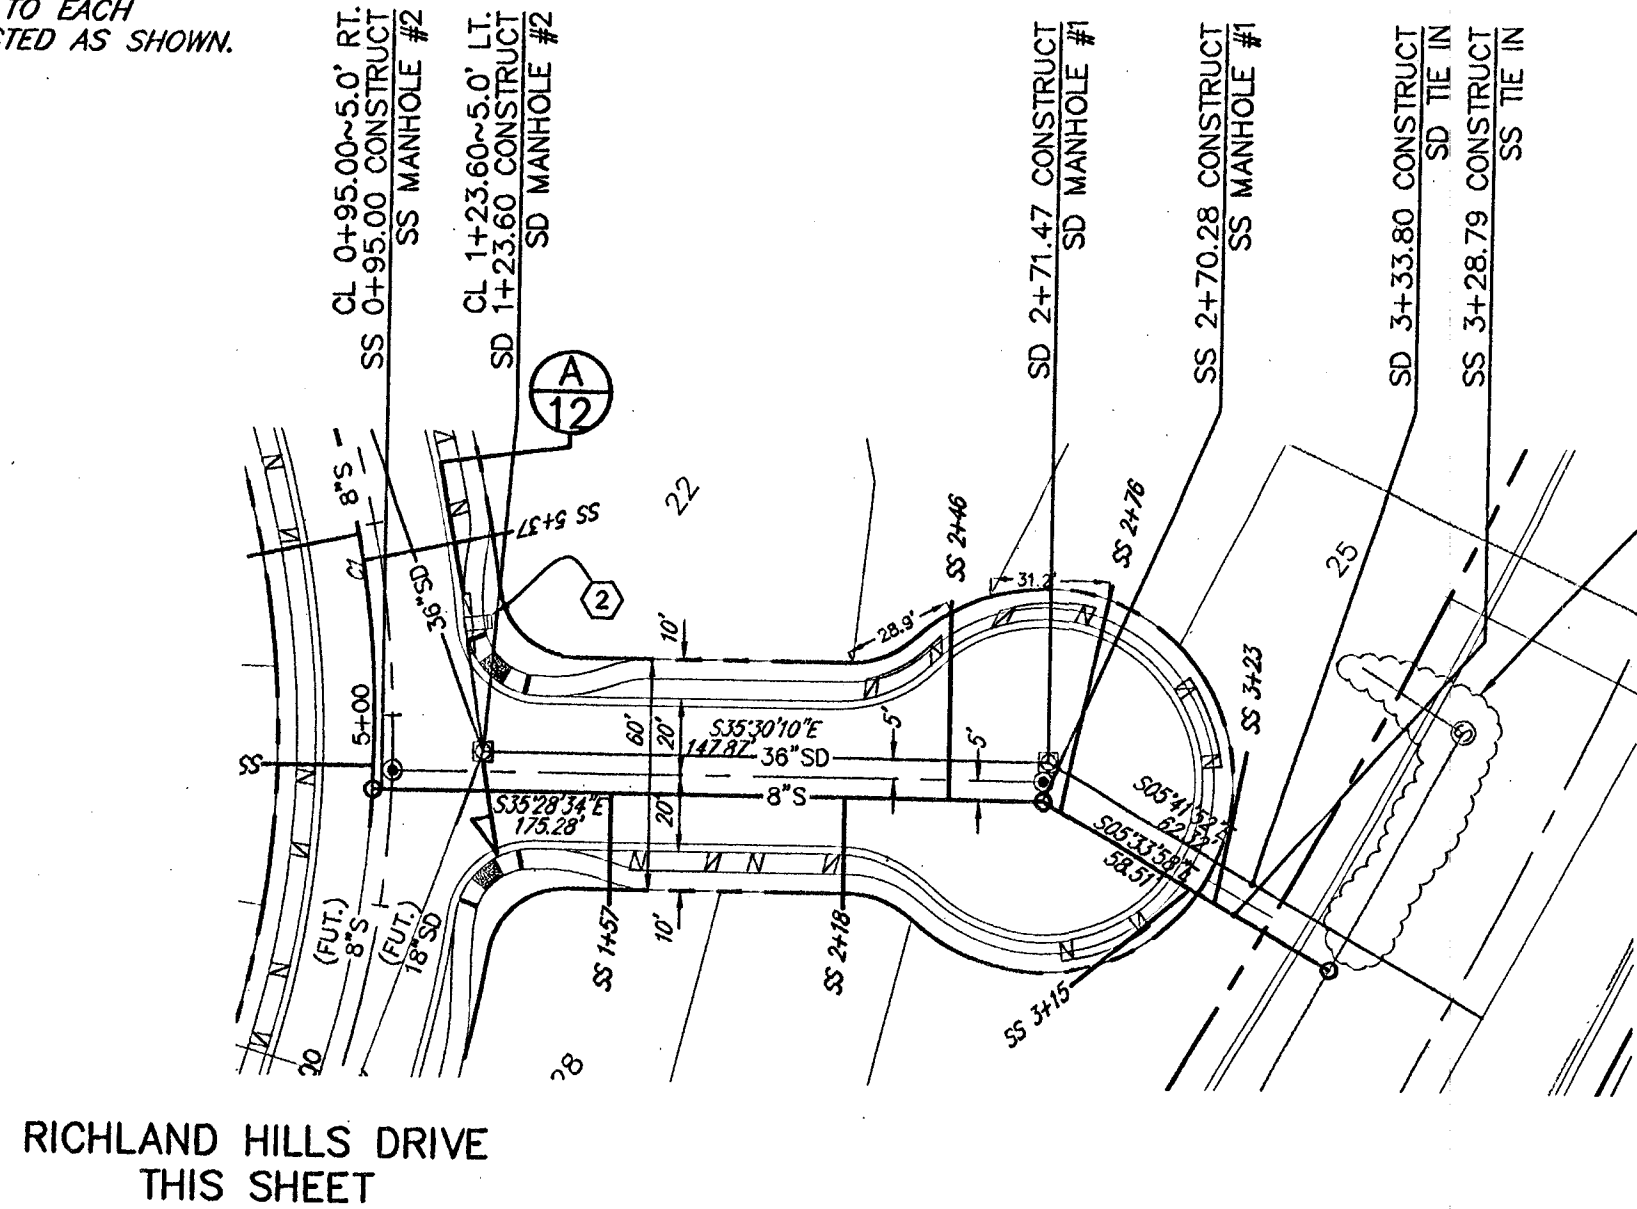


HORIZONTAL: 1" = 50'  
VERTICAL: 1" = 4'

## ORANGE HILLS PLACE (PRIVATE)

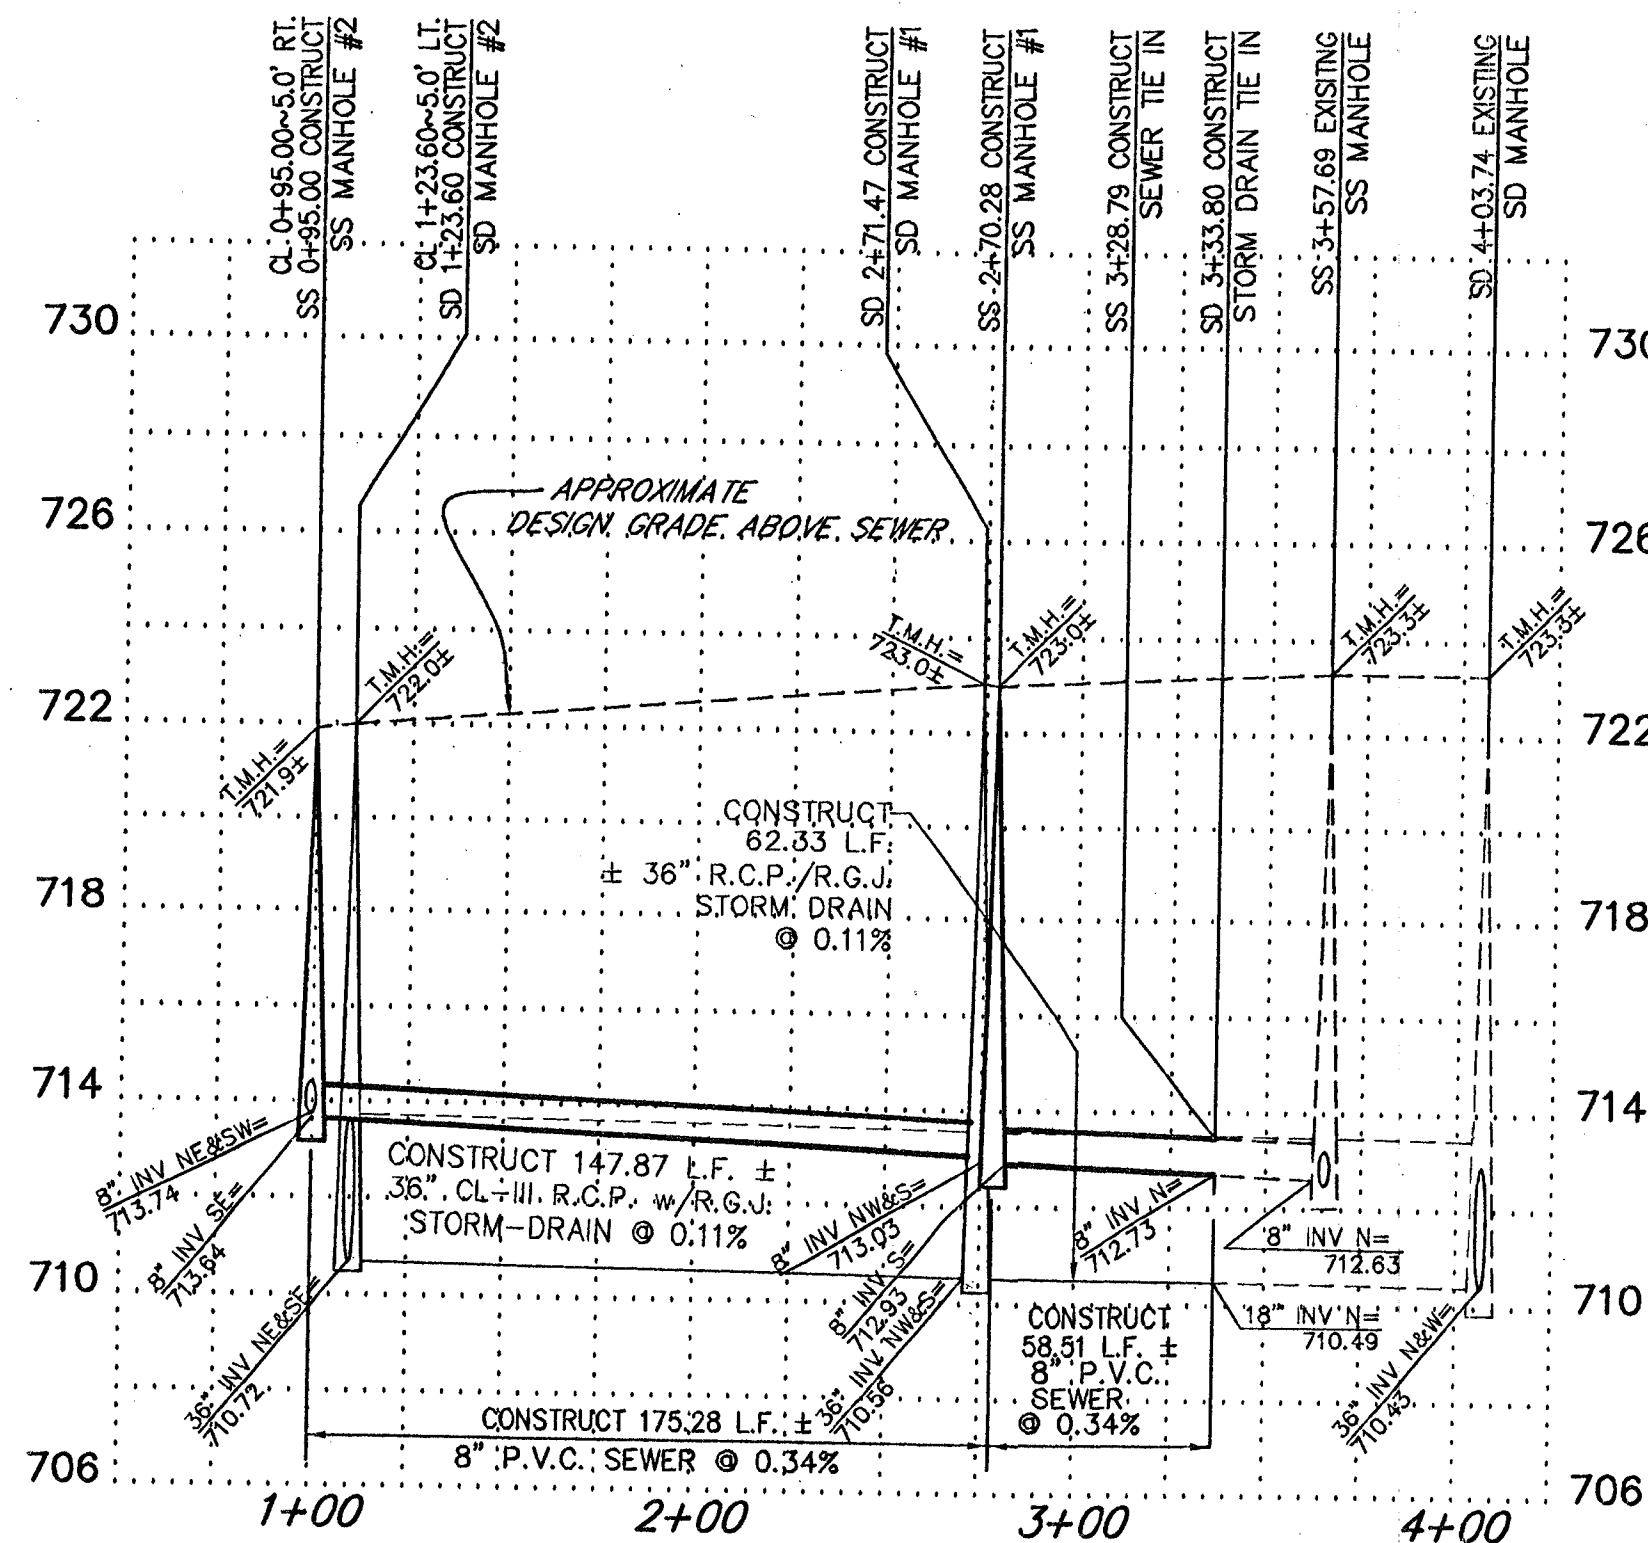

## RICHLAND HILLS DRIVE (PRIVATE)

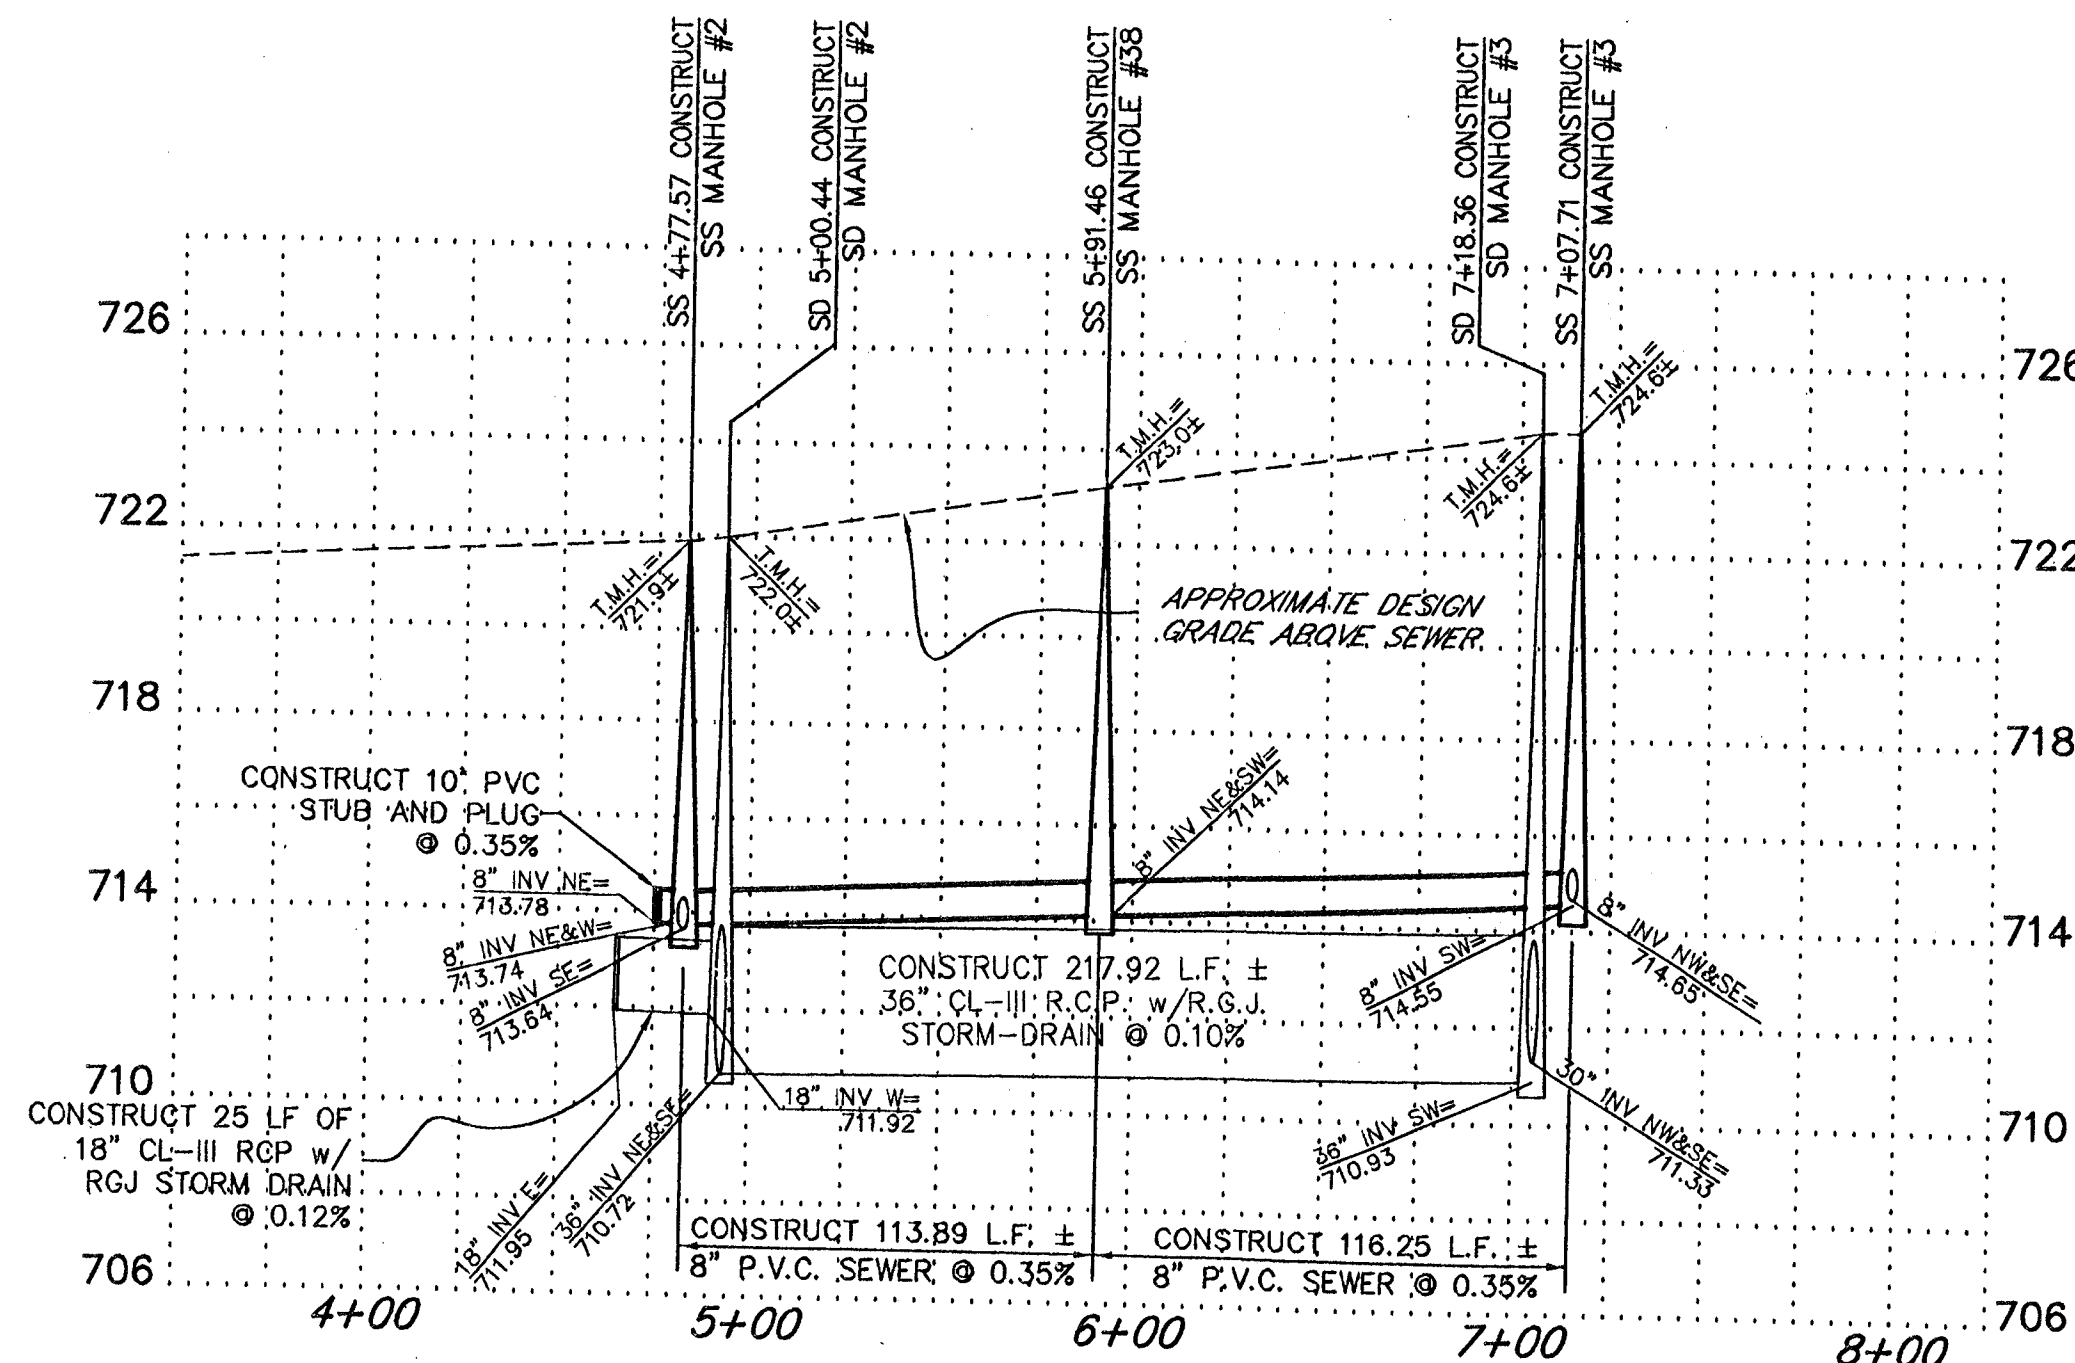


HORIZONTAL: 1" = 50'  
VERTICAL: 1" = 4'

CURVE TABLE				
CURVE	LENGTH	RADIUS	TANGENT	DELTA
C1	113.90	270.28	57.91	24°08'42"

### RECORD DRAWING

MATTHEW K. VOVILLA  
RCE 43130 EXP. 3-31-06  
DATE 5/11/07

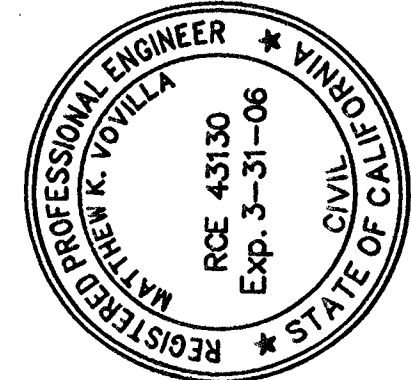

**PINNACLE Civil Engineering, Inc.**

1712 19th Street, Suite 101, Bakersfield, CA 93301  
Phone: (661) 869-0184 Fax: (661) 328-0607

MATTHEW K. VOVILLA  
RCE 43130 EXP. 3/31/06

DATE

TRACT NO. 6444 - PHASE 1  
SEWER & STORM DRAIN PLANS  
K. HOVNANIAN  
BAKERSFIELD, CALIFORNIA

JOB NO.: 04-158  
DWG NO.: 04-158S\WB01  
DATE: 11/21/05  
DRAWN BY: MUS  
CHECKED BY: MKV  
SHEET 12  
OF 13 SHEETS

1.2-6444 1



