


KEY NOTES
THIS SHEET ONLY

- (E)Q.01 EXISTING PLASTER CEILING TO REMAIN NO WORK AT THIS LOCATION.
- (E)Q.02 EXISTING PLASTER CEILING TO REMAIN AS REQUIRED. SEE SURFACE-PREP AS REQUIRED. PREP SURFACE-PREP.
- (E)Q.03 EXISTING ACOUSTIC TILE CEILING TO REMAIN. PREP SURFACE-PREP.
- (E)Q.04 EXISTING PLASTER CEILING TO REMAIN. REMOVE ANY DAMAGED PANELS. PREP SURFACE-PREP.
- (E)Q.05 PATCH EXISTING CEILING FINISH AS REQUIRED. WALLS (SEE DEMO PLAN)-PREP & PAINT.
- D.Q.01 REMOVE EXISTING LIGHT FIXTURES. CEILING FINISH AS REQUIRED. PATCH, MATCH EXISTING FINISHES. REMOVE ACOUSTIC TILE-PREP & PAINT. PROVIDE NEW LIGHTING FIXTURES. PROVIDE/INSTALL NEW LIGHTING FIXTURES. EXISTING (SEE DEMO PLAN).
- (N)Q.01 PROVIDE/INSTALL 12"x12" ACOUSTIC TILE (MATCH EXISTING).
- (N)Q.02 PROVIDE/INSTALL NEW 1/2" GYP. BOARD W/ 1/8" PLASTER VENEER CEILING-PAINT.
- (N)UTE PROVIDE/INSTALL NEW LIGHT FIXTURES-SEE ELECTRICAL PLANS.

LEGEND

- ☒ SURFACE MOUNTED LIGHT FIXTURE SEE ELECTRICAL.
- ☒ SURFACE MOUNTED LIGHT FIXTURE TO REMAIN SEE ELECTRICAL.
- ☒ LIGHT FIXTURE TO BE REMOVED SEE ELECTRICAL.
- ☒ 12" x 12" ACOUSTIC CEILING
- ☒ TILE
- ☒ 1/2" x 1/2" ACOUSTIC CEILING
- ☒ CEMENT PLASTER
- ☒ EXTERIOR CEMENT PLASTER
- ☒ SUPPLY AIR GRILL-SEE MECHANICAL
- ☒ RETURN AIR GRILL-SEE MECHANICAL
- ☒ EXHAUST FAN-SEE MECHANICAL
- 000 XXXXXX ROOM NUMBER
- +0-0 FINISHED CEILING HEIGHT

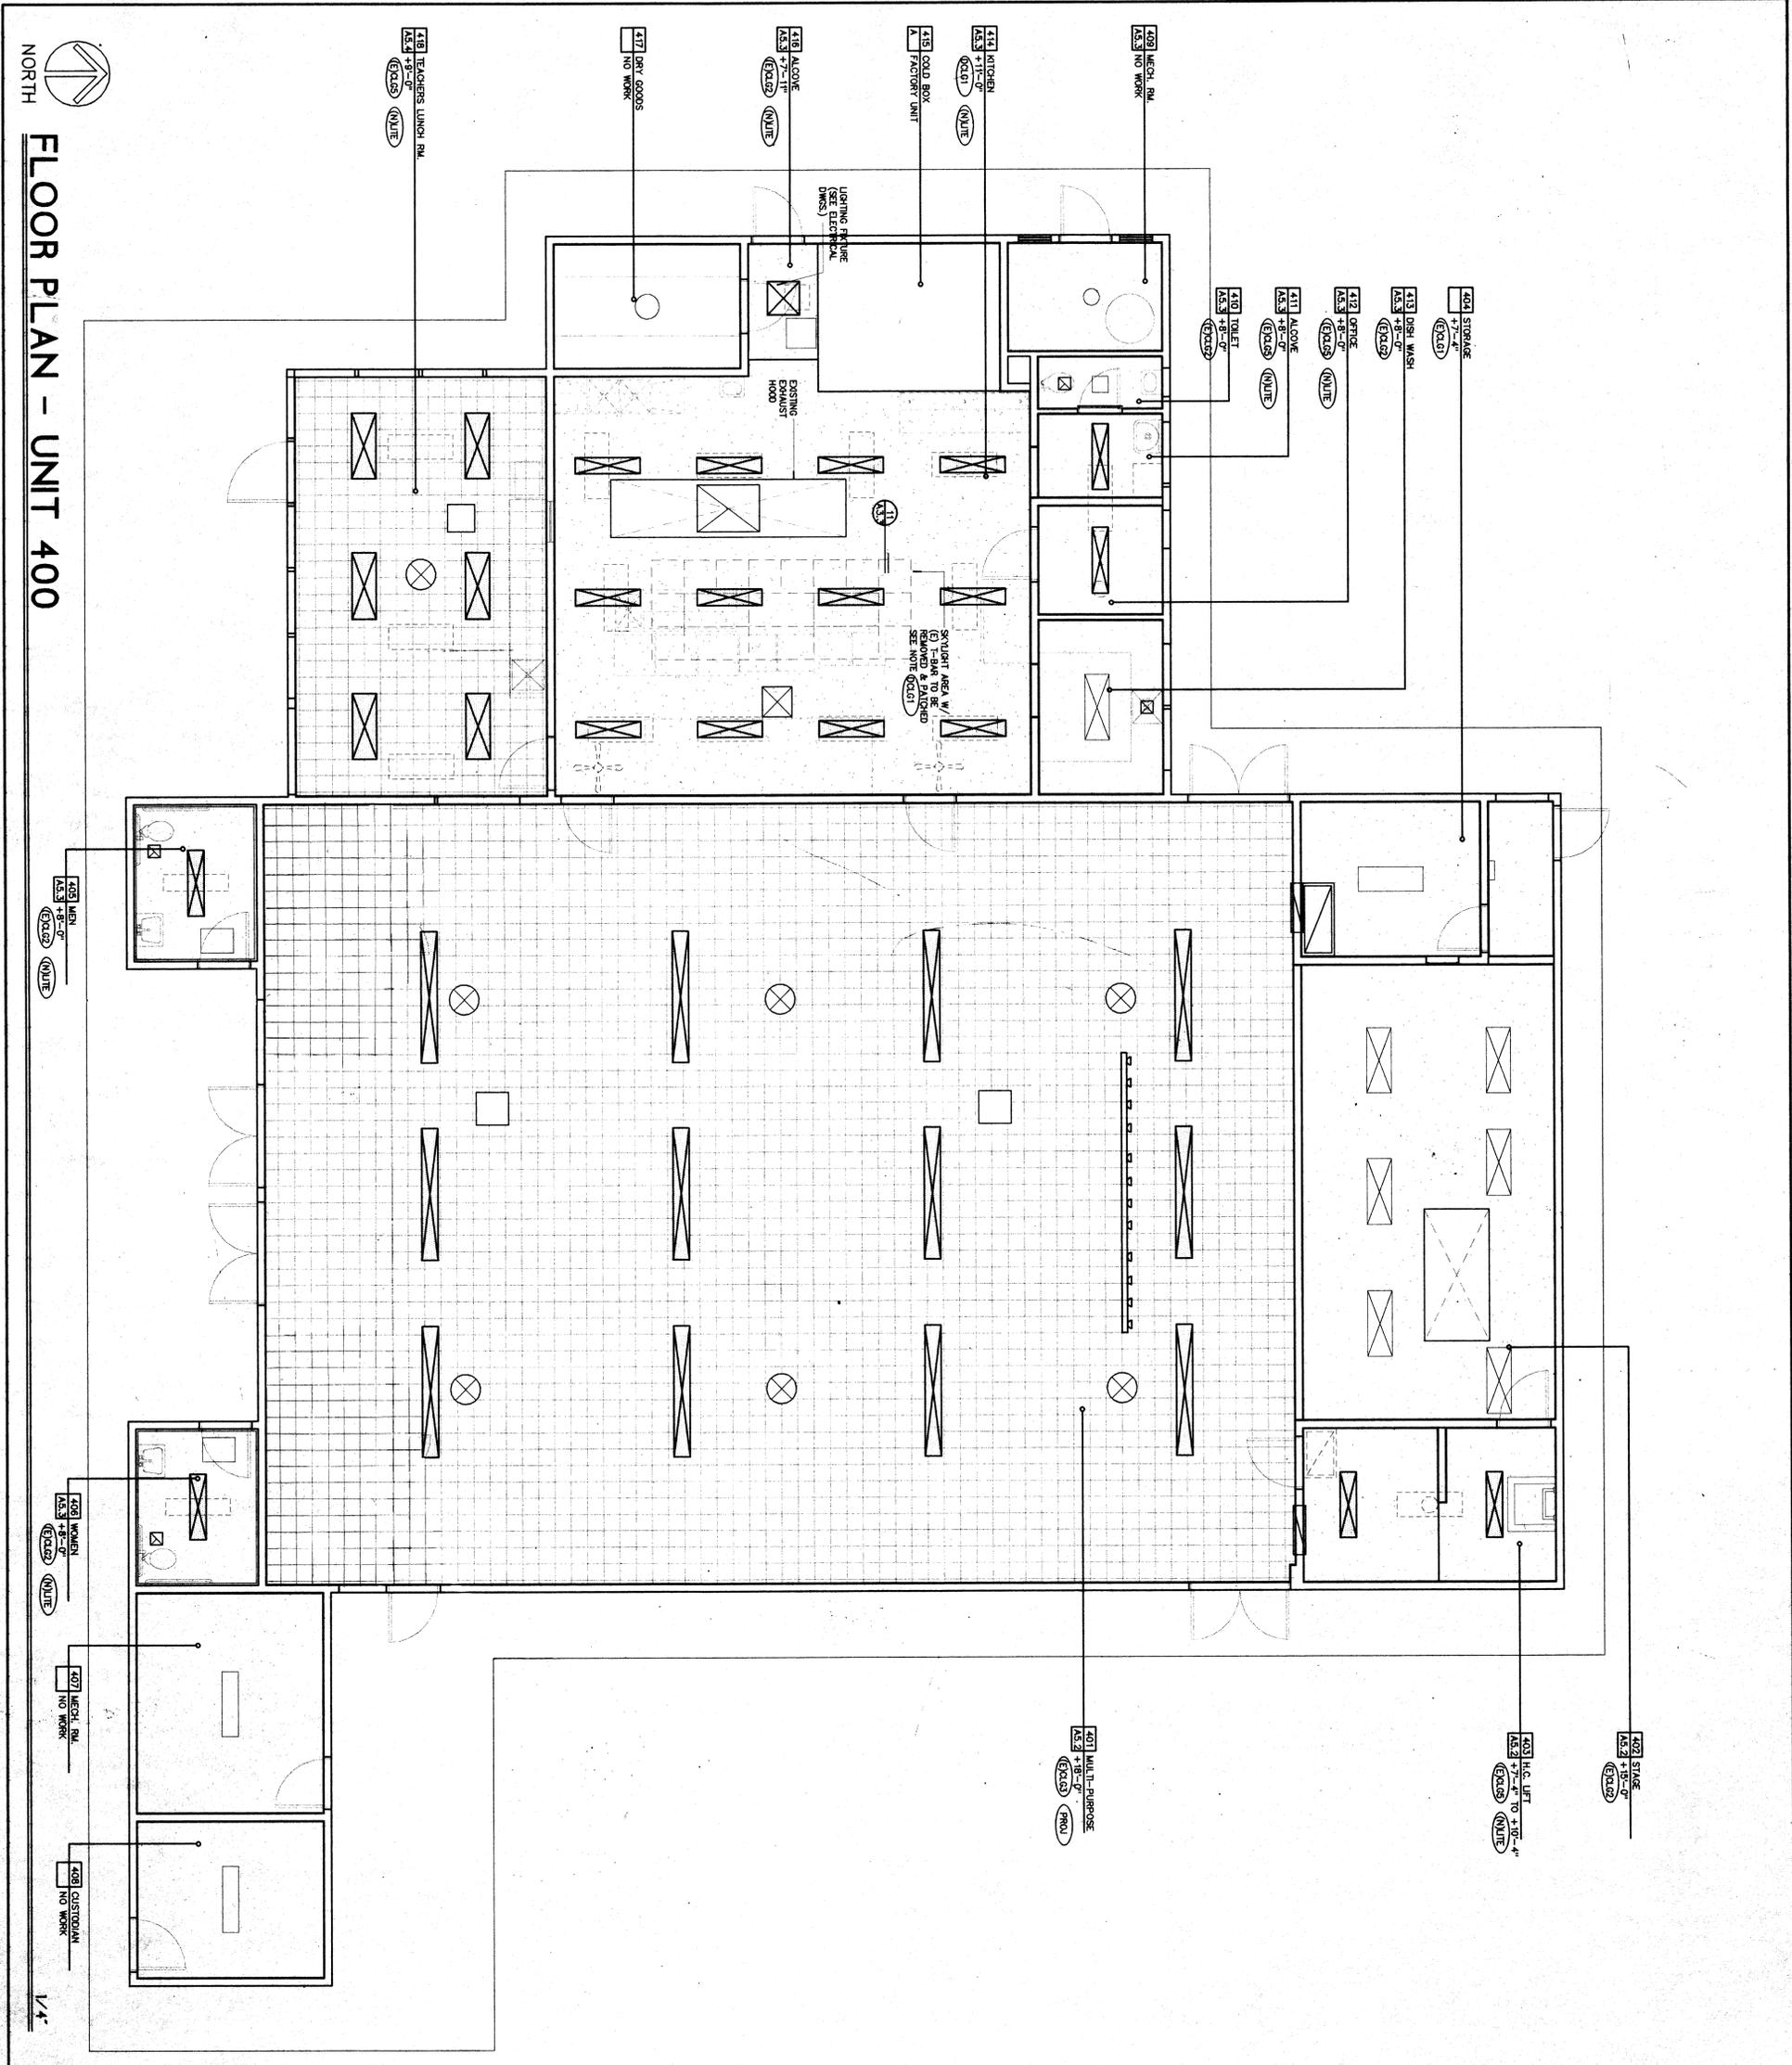

BAKERSFIELD CITY SCHOOL DISTRICT

2551 SUNNY LN.
BAKERSFIELD, CALIFORNIA 93305

MODERNIZATION OF COLLEGE HEIGHTS ELEM. SCHOOL FOR:

AS BUILT DRAWINGS

IDENTIFICATION STAMP
DIV. OF STATE ARCHITECT
OFFICE OF REGULATIONS SERVICES

APPL 101484
DATE 1-15-1977

6520 DISTRICT BLVD. #108
BAKERSFIELD, CA. 93313
TEL (805) 832-5258
FAX (805) 832-4281

ORDIZ MELBY ARCHITECTS INC.

DANNY E. ORDIZ A.I.A.
ARCHITECT C-14,728

WILLIAM J. MELBY A.I.A.
ARCHITECT C-16,636

KEY MAP NO SCALE

CHECK AND VERIFY ALL DIMENSIONS BEFORE REPORT DISCREPANCIES TO THE ARCHITECT

MARK DATE REVISION

REFLECTED CLG. PLAN

UNIT 400

DATE 1/8/98
DRAWN BY M.A.B.

SHEET 3.1 OF 20