

**LIGHTING COMPLIANCE SUMMARY**  
 BUILDING #100 (KINDERGARTEN)  
 DATE: 01-06-04

LUMINAIRE NAME	DESCRIPTION	F/F LUMINAIRES	WATTS PER LUMINAIRE (INCLUDING BALLAST)	YES	NO	TOTAL WATTS
0	0' - 4 LAMP SERVICE HOOP	21	110	<input checked="" type="checkbox"/>	<input type="checkbox"/>	2310
SUB-TOTAL FROM THIS PAGE: 2310						
PLUS SUB-TOTAL FROM CONTINUATION PAGE: 2310						
LESS CONTROL (SEE NOTE 1)						
ADJUSTED ACTUAL WATTS: 2310						

AREA CATEGORY METHOD: AREA CATEGORY (FROM TABLE 1-N)

CLASSROOMS	WATTS	AREA SF	ALLOWED WATTS
0	2.0	1166	3598
SERVICE SPACE	0.0	314	255
TOTALS		2007	3791

NOTES: 1. IF NOT USING THE SEE DETAIL VALUE, PLEASE PROVIDE SUPPORTING DOCUMENTATION.  
 2. ALL ROOMS EXCEPT CLASSROOMS ARE MARKED "N".

**LIGHTING COMPLIANCE SUMMARY**  
 BUILDING #100 (KINDERGARTEN)  
 DATE: 01-06-04

LUMINAIRE NAME	DESCRIPTION	F/F LUMINAIRES	WATTS PER LUMINAIRE (INCLUDING BALLAST)	YES	NO	TOTAL WATTS
C	4' - 3 LAMP HOOP	6	64	<input checked="" type="checkbox"/>	<input type="checkbox"/>	384
A	4' - 2 LAMP HOOP	1	62	<input checked="" type="checkbox"/>	<input type="checkbox"/>	62
E	4' - 4 LAMP HOOP	12	110	<input checked="" type="checkbox"/>	<input type="checkbox"/>	1320
SUB-TOTAL FROM THIS PAGE: 4166						
PLUS SUB-TOTAL FROM CONTINUATION PAGE: 1916						
LESS CONTROL (SEE NOTE 1)						
ADJUSTED ACTUAL WATTS: 1916						

AREA CATEGORY METHOD: AREA CATEGORY (FROM TABLE 1-N)

CLASSROOMS	WATTS	AREA SF	ALLOWED WATTS
0	0.0	395	316
KITCHEN	2.2	752	1634
CONCRETO, TOILETS AND SERVICE SPACE	0.0	120	46
TOTALS		1267	2006

NOTES: 1. IF NOT USING THE SEE DETAIL VALUE, PLEASE PROVIDE SUPPORTING DOCUMENTATION.  
 2. ALL ROOMS EXCEPT CLASSROOMS ARE MARKED "N".

**LIGHTING COMPLIANCE SUMMARY**  
 BUILDING #600  
 DATE: 01-06-04

LUMINAIRE NAME	DESCRIPTION	F/F LUMINAIRES	WATTS PER LUMINAIRE (INCLUDING BALLAST)	YES	NO	TOTAL WATTS
0	0' - 4 LAMP SERVICE HOOP	36	110	<input checked="" type="checkbox"/>	<input type="checkbox"/>	3960
SUB-TOTAL FROM THIS PAGE: 3960						
PLUS SUB-TOTAL FROM CONTINUATION PAGE: 3960						
LESS CONTROL (SEE NOTE 1)						
ADJUSTED ACTUAL WATTS: 3960						

AREA CATEGORY METHOD: AREA CATEGORY (FROM TABLE 1-N)

CLASSROOMS	WATTS	AREA SF	ALLOWED WATTS
0	2.0	3530	7076
TOTALS		3530	7076

NOTES: 1. IF NOT USING THE SEE DETAIL VALUE, PLEASE PROVIDE SUPPORTING DOCUMENTATION.  
 2. ALL ROOMS EXCEPT CLASSROOMS ARE MARKED "N".






**LIGHTING COMPLIANCE SUMMARY**  
 BUILDING #100  
 DATE: 01-06-04

LUMINAIRE NAME	DESCRIPTION	F/F LUMINAIRES	WATTS PER LUMINAIRE (INCLUDING BALLAST)	YES	NO	TOTAL WATTS
0	0' - 4 LAMP SERVICE HOOP	21	110	<input checked="" type="checkbox"/>	<input type="checkbox"/>	2310
SUB-TOTAL FROM THIS PAGE: 2310						
PLUS SUB-TOTAL FROM CONTINUATION PAGE: 2310						
LESS CONTROL (SEE NOTE 1)						
ADJUSTED ACTUAL WATTS: 2310						

AREA CATEGORY METHOD: AREA CATEGORY (FROM TABLE 1-N)

CLASSROOMS	WATTS	AREA SF	ALLOWED WATTS
0	2.0	2043	5166
TOTALS		2043	5166

NOTES: 1. IF NOT USING THE SEE DETAIL VALUE, PLEASE PROVIDE SUPPORTING DOCUMENTATION.  
 2. ALL ROOMS EXCEPT CLASSROOMS ARE MARKED "N".

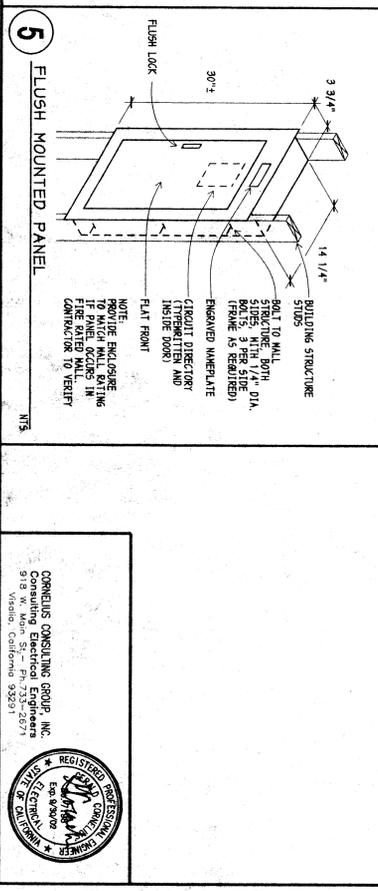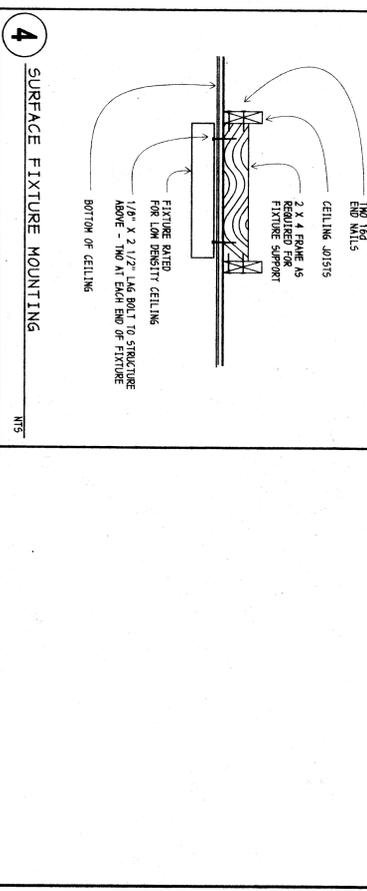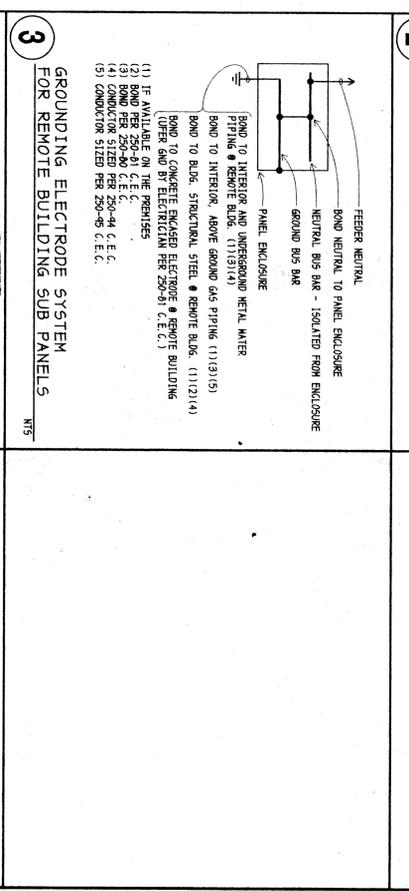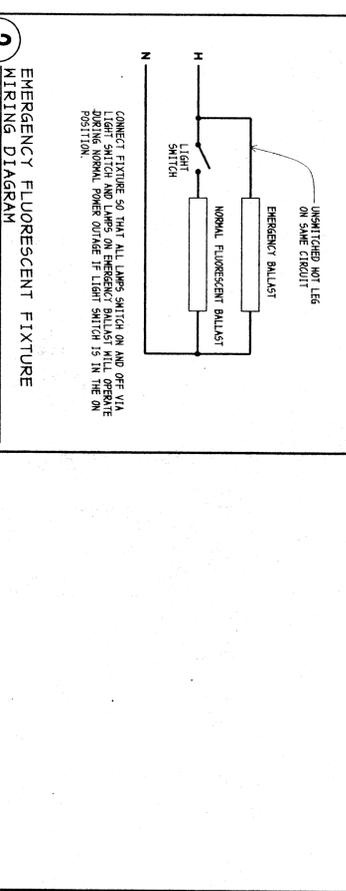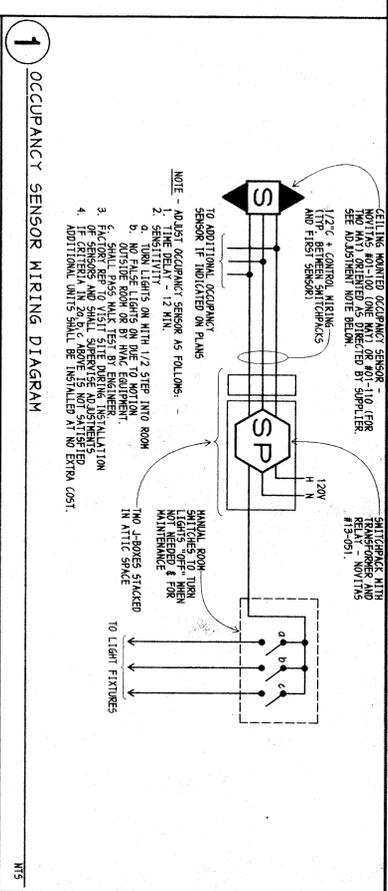

**ORDIZ MELBY ARCHITECTS**  
 5620 DISTRICT BLVD., #105  
 BAKERSFIELD, CA 93318  
 TEL. (805) - 892-9288  
 FAX. (805) - 892-4291

**REGISTRATION SEAL**  
 APR. NO. 101464  
 FILE NO. SA  
 DANNY E. ORNDIZ, AIA  
 ARCHITECT C-14,750  
 WILLIAM J. MELBY, AIA  
 ARCHITECT C-16,088

**BAKERSFIELD CITY SCHOOL DISTRICT**  
 2551 SUNNY LN.  
 BAKERSFIELD, CALIFORNIA 93305

AS BUILT DRAWINGS  
 MODERNIZATION OF COLLEGE HEIGHTS FOR:  
 BAKERSFIELD CITY SCHOOL DISTRICT

**APPENDIX #1 DRAWING #E1.1**

DATE: 01/07/01  
 REVISION: 11  
 CHECK AND VERIFY ALL DIMENSIONS AND PROPORTIONS AND THE ARCHITECT'S THE ARCHITECT

**CONQUEST CONSULTING GROUP, INC.**  
 Consulting Electrical Engineers  
 510 Mission, California 92921

DATE: 01/07/01  
 REVISION: 11  
 CHECK AND VERIFY ALL DIMENSIONS AND PROPORTIONS AND THE ARCHITECT'S THE ARCHITECT