

MODERNIZATION OF COLLEGE HEIGHTS ELEM. SCHOOL FOR:

5620 DISTRICT BLVD. #105
BAKERSFIELD, CA 93313
TEL. (805)-832-5258
FAX. (805)-832-4291

DANNY E. ORD ARCHITECT /

A.I.A. -14,728

WILLIAM J. ARCHITECT

MELBY A.I.A. C-16,835

IDENTIFICATION STAMP
DIV. OF STATE ARCHITECT
OFFICE OF REGULATIONS SERVICES

101484


1-15-1779


ORDIZ MELBY


ARCHITECTS


2551 SUNNY LN.
BAKERSFIELD,
CALIFORNIA
93305


BAKERSFIELD CITY SCHOOL DISTRICT

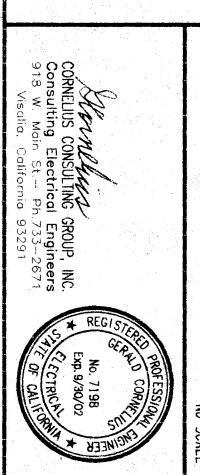


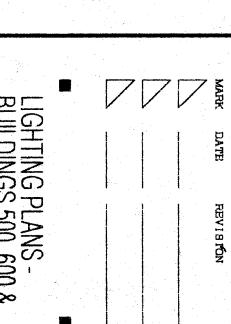


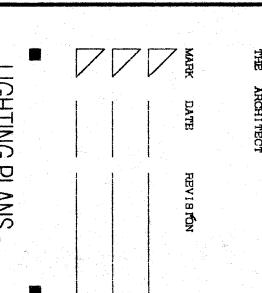


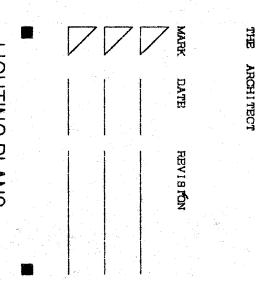


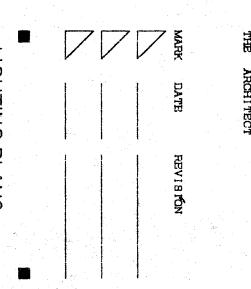

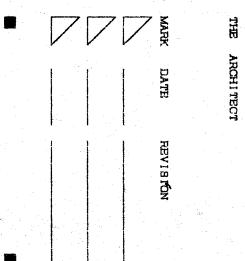


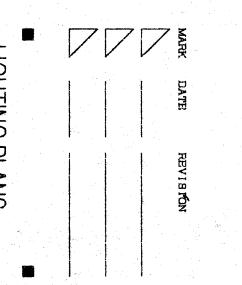


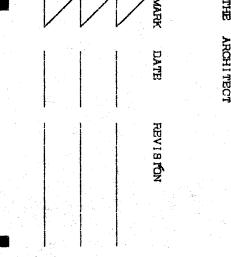


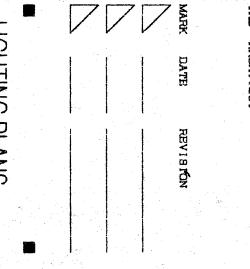

LIGHTING PLANS -BUILDINGS 500, 600 & 700

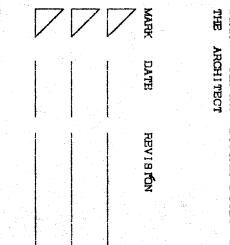

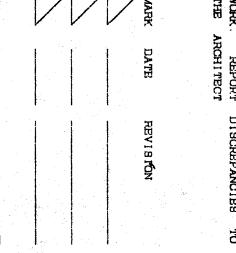

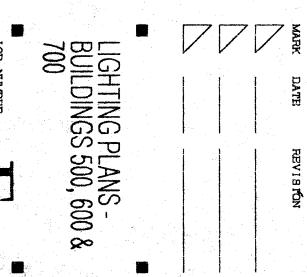

ש

L

