# CLASS LEASING, INC.

P.O. Box 51150 Riverside, CA 92517-2150 1221 Harley Knox Blvd. Perris, CA 92571-7408 Fax (951) 943-5768 (951) 943-1908

#### **SPECIFICATIONS** RELOCATABLE CLASSROOMS

#### 4.01 MATERIAL SPECIFICATIONS:

- 1. Structural framing shall be Hem Fir- Larch graded in accordance with the standard grading rules of the Western Wood Products Association or standard grading rules No. 16 of the West Coast Lumber Inspection Bureau, latest editions. Grades shall be as follows unless noted otherwise on the drawings. (Hem Fir South is not allowed.) Each piece shall be grade marked and no piece may fall below grades indicated. All framing except as noted Hem Fir No. 2
- 2. Plywood shall be as shown on these drawings with exterior glue in accordance with U.S. Product Standard PS 1-95. All panels shall be marked with an APA grade mark with an identification index as shown on drawings. Use 4'x8' panels-minimum, except at boundaries and at framing changes where minimum panel dimension shall be 24" at roofs and floors and 12" at walls.
- 3. Bolts for timber connections shall conform to ANSI/ASME Standard B18.2.1-1981 & 2005 edition of NDS (the National Design Specification for Wood Construction by the National Forest Products Association). Bolts shall be installed in accordance with the requirement of 200 NDS. Bolt holes shall be 1/32 to 1/16 inch larger than bold diameter. Bolts shall be full body steel bolts with minimum yield strength of 45,000 PSI. Re-tighten bolts before closing in work.
- 4. Lag screws shall be steel and conform to ANSI/ASME Standard B18.2.1 and 2005 NDS Holes for lag screw shanks shall be bored the same depth and diameter as the shank. The remaining depth of penetration of the screw shall be bored to 70% of the shank diameter. One quarter inch (1/4") diameter lag screws need not have pre-drilled holes if it can be shown that wood members are not damaged during installation. Provide full diameter body lag screws with bending yield strengths per Table 9.3 in NDS
- 5. Provide malleable iron washers or equivalent cut plate washers (not less than a standard cut washer) under nuts and bolt or lag screw heads which bear on wood.
- 6. Wood screws shall conform to ANSI/ASME Standard B18.6.1 and the requirements of the 2005 NDS. Galvanized or other corrosion resistant coating where exposed to weather or used in Screws shall be steel with cut threads and bending yield strengths per Table 11.3 in NDS.
- 7. Wood members shall be cut or notched only as shown on structural drawings.
- 8. When required nailing tends to split wood members, nail holes shall be pre-bored to 3/4 of the nail
- 9. Structural nailing shall be with BOX NAILS per all requirements of 2005 NDS. Nailing not specifically indicated shall comply with CCR Title 24, Part 2, Table 2304.9.1. All nails shall be galvanized or other corrosion resistant coating where exposed to weather, in foundations and as noted on plans, per the requirements of CCR Title 24, Part 2, with minimum bending yields per table 11N in NDS. (See nail equivalence below.)
- 10. Nail equivalence:

(provide minimum nail lengths as required for specified penetration, TYPICAL: U.N.O.)

6d equals .113" DIA. - provide 1.36" minimum point penetration 8d equals .131" DIA. - provide \*1.57" minimum point penetration 10d equals .148" DIA. - provide \*1.78" minimum point penetration 16d equals .162" DIA. - provide \*1.94" minimum point penetration (\* 1 1/2" at 2x members)

- 11. Pressure preservative treatment shall be per Section 2303.1.8, CCR Title 24, Part 2. Provide quality mark on all treated foundation members from agency approved by DSA. All foundation members shall be marked as "For ground contact (LP22)" or "For above ground use (LP2)" as appropriate. Treat all cut ends of pressure treated members with an approved preservative. (Willard W/B Copper Green 2% or an approved equivalent). Where noted, members below the sub floor that are not a part of the foundation shall be pressure treated per LP2.
- 12. Only material in contact with ground needs to be pressure treated, all other foundation lumber can be DF or HF#2 or equal.
- 13. If machine nailing is utilized for this project, contractor shall comply with all requirements of CCR Title 24, Part 2. Machine nailing is subject to approval by the Structural Engineer or Architect and the Division of the State Architect.
- 14. Fasteners for pressure-preservative treated and fire-retardant treated wood shall comply with Section 2304.9 of CBC.
- 15. Nails and spikes used in wet or exterior locations shall comply with Section 2304.9.1.1 of CBC.
- 16. Shim material shall be plywood CD EXP 1 or equal (not pressure treated).
- 17. Used lumber in good condition is acceptable for use in foundation system.
- 5.01 SITE INSTALLATION REQUIREMENTS FOR DSA CLASSROOM BUILDINGS:

In the case of equipment located in the State of California, the LESSEE (School District) is responsible for the site being cleared (free of grass, trees, shrubs, etc) and graded to within 4 1/2" of level grade for each building. If the site exceeds the 4 1/2" level grade requirement additional costs may be charged to lessee.

Under no circumstances should the site be greater that 9" from level grade or have less than a 1000 PSF MINIMUM SOIL BEARING PRESSURE.

Prior to delivery, the lessee shall mark the four corners of the building on the site, including door location. Should special handling be required to either place, install or relocate the classroom on the lessee's site due to site obstruction such as fencing, landscaping, other classrooms, etc., additional costs will be charge to the lessee.

# 6.01 TEST AND INSTALLATION:

- 1. Provide Electrical Grounding Test per DSA IR E-1.
- 2. No other tests and inspections are required.

## 1.01 GENERAL REQUIREMENTS:

- 1. The requirements of the general conditions of the agreement and these General Requirements apply to the several trade sections with the same force as though fully repeated in each section.
- 2. Name brands are indicated to establish a standard of quality. Items of equal or better quality may be substituted for the listed brand named products.

#### 1.02 SCOPE OF WORK:

- 1. The work consists of manufacturing off-site in a plant, and installing on-site, modular relocatable building as defined herein, shown and detailed on the drawings. In the case of a Stockpile: the modular relocatable building is manufactured in-plant and stored off-site until such time that it is relocated from the off-site storage location and installed on-site.
- 2. All requirements of CCR (California Code of Regulation) Title 19 and 24 relating to inspections and verified reports shall be complied with and shall include:
- a) General responsible charge of Field Administration by the Architect of Record.
- b) Inspection during the course of construction by an Inspector approved by DSA (Division of the State Architect) and the District Architect. The Inspector shall be responsible for and approved to inspect the general construction, welding, mechanical and electrical work. Cost of these inspections shall be borne by the School District.
- c) On site inspection of the building installation, electrical and utility of the building installation or connection by an Inspector approved by the DSA and retained by the School District.
- d) Other special tests or inspections as may be required by DSA. Cost of these inspections/tests shall be borne by the School District.

#### 1.03 WORK NOT INCLUDED:

- 1. All on-site or off-site utilities and the connection of them to the building unless indicated on
- 2. All leveling, grading or other site preparation (except concrete or wood leveling strips, where Required) unless otherwise indicated on the drawings.
- 3. Fire alarm system, program bell, clock, public address system, intercom system, TV system, computer data or any other low voltage system, unless otherwise indicated on the drawings or the lease agreement.

## 1.04 ACCESSIBILITY OF SITE:

The School District shall provide access to the site for the installation of the building. Removal of trees, shrubs, fencing, sprinklers, etc. necessary for move-in and removal of the buildings shall be the responsibility of the School District.

#### 2.01 SITE ASSEMBLY:

1. Scope of Work: Contractor (Class Leasing Inc.) shall provide all labor, materials and services to prepare the building elements, transport them from the plant to the site and to complete the assembly at the site.

The condition of the site, such as drainage and soil bearing capacity, shall be the responsibility of the School District and the District Architect.

## 2. Assembly of Elements:

- a) In a location on the site as determined by the District Architect. The contractor shall place the foundation as detailed on the drawings.
- b) The elements shall be brought to the site on wheel assembly and transferred to the prepared site. Great care shall be taken to avoid damage to the elements by racking or bumping.
- c) Connection of the elements together shall be done according to instructions on the drawings. Flashing, trim and other loose items shall be installed per plans and details of the original building manufacturer's drawings.

#### 3.01 CARPENTRY:

- 1. Scope of Work: Contractor shall provide all labor, materials and services to install carpentry.
- 2. Workmanship:
- a) FRAMING: securely nailed, bridged and blocked to form rigid structure. Work cut, fitted and assembled level, plumb and true to line. Trim in as long lengths as possible with all standing trim in one piece. Trim sealed at all edges.
- b) NAILING: in accordance with the title 24 CCR-Table 2304.9.1. Nails shall be corrosion resistant box nails.
- c) Machine applied nailing shall have prior demonstration and approval by DSA Field Inspector and the Architect. The approval is subject to continuous satisfactory performance. Plywood shall have a minimum thickness of 3/8". If nail heads penetrate the outer ply more than would be normal for a hand hammer or if minimum allowable edge distances are not maintained, the performance will be deemed unsatisfactory.
- d) TRIM: sealed at all edges. Sealant painted to match trim or siding.

# APPLICABLE BUILDING CODES

- ALL NEW WORK SHALL COMPLY AND CONFORM TO THE REQUIREMENTS OF THE 2010 CBC
- **2010 CALIFORNIA CODE OF REGULATIONS (CCR)**
- -2010 CALIFORNIA BUILDING STANDARDS ADMINISTRATIVE CODE ( PART 1, TITLE 24, CCR)
- -2010 CALIFORNIA BUILDING CODE (CBC) (PART 2, TITLE 24, CCR)
- (2009 INTERNATIONAL BUILDING CODÉ VOLUMES 1-3 WITH 2010 CALIFORNIA AMENDMENTS)
- -2010 CALIFORNIA ELECTRICAL CODE (CEC) (PART 3, TITLE 24, CCR) (2008 NATIONAL ELECTRICAL CODE WITH 2010 CALIFORNIA AMENDMENTS)
- -2010 CALIFORNIA MECHANICAL CODE (CMC) (PART 4, TITLE 24, CCR) (2009 UNIFORM MECHANICAL CODE WITH 2010 CALIFORNIA AMENDMENTS)
- -2010 CALIFORNIA PLUMBING CODE (CPC) (PART 5, TITLE 24, CCR) (2009 UNIFORM PLUMBING CODE WITH 2010 CALIFORNIA AMENDMENTS)
- -2010 CALIFORNIA ENERGY CODE (PART 6, TITLE 24, CCR)
- -2010 CALIFORNIA REFERENCED STANDARDS CODE (PART 12, TITLE 24, CCR)
- -2010 CALIFORNIA FIRE CODE (PART 9, TITLE 24, CCR) (2009 INTERNATIONAL FIRE CODE WITH 2010 CALIFORNIA AMENDMENTS)
- TITLE 19 CCR PUBLIC SAFETY, STATE FIRE MARSHALL REGULATIONS

# **DESIGN DATA:**

FLOOR LIVE LOAD = 50 PSF, 50 + 20 PSF PARTITIONS, 100 PSF ROOF LIVE LOAD = 20 PSF REDUCIBLE FOR TRIBUTARY AREA WIND SPEED = 85 MPH (V) (3 SECOND GUST), K zT = 1.0 SNOW LOAD: PROJECT IS NOT LOCATED IN A SNOW REGION.

SEISMIC DESIGN DATA:	MOMENT FRAME PC'S	SEISMIC DES
Basic Seismic-Force-Resisting System	= STEEL MOMENT FRAME	Basic Seismic-
ANALYSIS PROCEDURE USED	= EQUIVALENT LATERAL FORCE	ANALYSIS PR
Seismic Design Category	= E (per CBC Section 1613A.5.6)	Seismic Design
Design Rase Shear : 24x40 BUILDING	= 9404 # (Roof, Floor, Walls & Partitions)	Design Base S
36x40 BUILDING	= 14110 # (Roof, Floor, Walls & Partitions)	•
48x40 BUILDING	= 18810 # (Roof, Floor, Walls & Partitions)	
	,	,

BUILDING CODES = IBC AND CBC 2007

SIGN DATA: SHEAR WALL PC'S
c-Force-Resisting System = WOOD PANEL SHEAR WALLS = EQUIVALENT LATERAL FORCE = E (per CBC Section 1613A.5.6) Shear: 24x40 BUILDING = 9404 # (Roof, Floor, Walls & Partitions) 36x40 BUILDING = 14110 # (Roof, Floor, Walls & Partitions) 48x40 BUILDING = 18810 # (Roof, Floor, Walls & Partitions) L = 1.0 Cs2 = 0.286 R: = 3.5 SITE CLASS = D L: = 1.0 Cs2 = 0.154 R: = 6.5 SITE CLASS = D Ss = 2.0 per CBC Figure 1613A.5(3), REDUCED TO 1.5 per ASCE 7-05 Section 12.8 1.3 Ss = 2.0 per CBC Figure 1613A.5(3), REDUCED TO 1.5 per ASCE 7-05 Section 12.8 1.3

S1 = 1.3 per CBC Figure 1613A.5(2)

FLOOD DESIGN DATA: Project is not located in a flood zone **LIMITATIONS WOOD FOUNDATION PC ONLY:** 

WOOD FOUNDATION ONLY PC IS DESIGNED TO SUPPORT THE SUPERSTRUCTURE FOR THE RELOCATABLE BUILDINGS AS LISTED ON THIS DRAWING.


- THE DESIGN CALCULATIONS ARE BASED ON THE FOLLOWING:
- 1. DSA APPROVED STOCKPILE BUILDINGS


\$1 = 1.3 per CBC Figure 1613A.5(2)


- 2. ROOF OVERHANGS OF 5'-0" MAXIMUM
- 3. SINGLE SLOPE OR DUAL SLOPE BUILDINGS WALL HEIGHT: 9'-0" MAXIMUM ON DUAL SLOPE BUILDING. WALL HEIGHT: 10'-4" MAXIMUM ON SINGLE SLOPE BUILDING. (HEIGHT DETERMINED FROM FINISH FLOOR IN BUILDING TO BOTTOM OF STEEL ROOF STRUCTURE: BEAMS OR ROOF HEADERS)


WALL HEIGHT: 9'-10" MAXIMUM ON SHEAR WALL-DUAL SLOPE BUILDING


- 4. WALL DEAD LOAD OF 10 PSF (NO STUCCO)

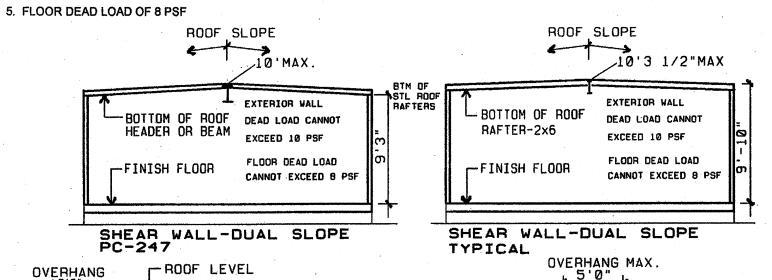

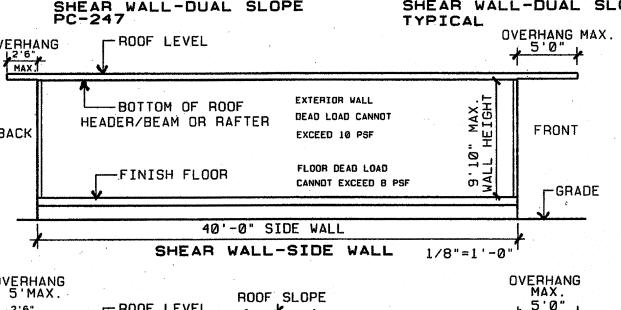

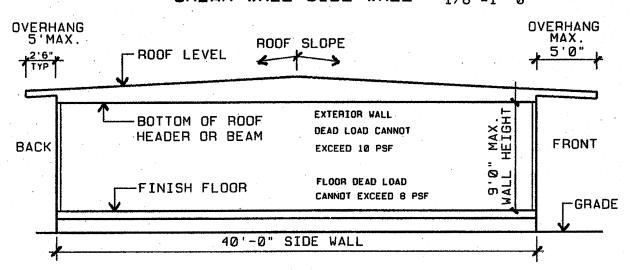

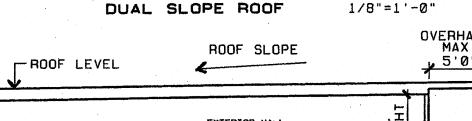

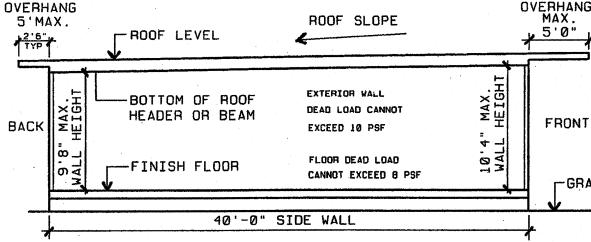

MONO SLOPE ROOF

1/8"=1'-0"

TYPICAL ELEVATIONS ARE SHOWN TO CLARIFY FOUNDATION PC ONLY LIMITATIONS DOCUMENTATION SHALL BE PROVIDED BY ENGINEER OF GENERAL RESPONSIBLE CHARGE TO BE REVIEWED AND APPROVED BY THE DSA STRUCTURAL PLAN REVIEWER.

SCOPE OF WORK: DSA FOUNDATION PLANS FOR EXISTING STOCKPILE BUILDINGS FOR CLASS LEASING, INC.

SHEET INDEX: STOCKPILE BUILDING FOUNDATION PC# 04-111441 - 2010 CODE UPDATE F1.0 COVER SHEET, BUILDING DATA, STOCKPILE APPROVAL INDEX

ELA 12 × 40 50 50 20 DEE MOOD FOUNDATION DE AN SODETAILS AD JACENT BUILDING BAD

F2.0 24 x 40 - 50 PSF FOUNDATION PLAN & DETAILS, ADJACENT BUILDING PAD

52.1 24 x 40 50+20 PSE FOUNDATION PLAN & DÉTAILS ADJACENT PUIL DINC PAD

F2.0 35 x 40 50 PSF FOUNDATION PLAN & DETAILS, ADJACENT PUILDING PAD 52.4 26 × 40 50+20 PSE FOUNDATION PLAN & DETAILS, AD LOCENT PUIL DING DAD

F3.2 - 36 × 40 - 100 PSF --- FOUNDATION PLAN & DETAILS, AD LACENT PUBLISHED PAD F4.0 48 is 40 50 PSF FOUNDATION PLAN & DETAILS, AD INCENT RUIL DING DAD

F1.1 48 x 40 50-20 PSE FOUNDATION PLAN & DETAILS AD LOCENT BUILDING PAD

ADJACENT BUILDINGS: ONLY THOSE BUILDINGS MANUFACTURED BY THE SAME COMPANY


MAY BE PLACED ADJACENT TO EACH OTHER.


<del>4.2 - 48 x 40 - 400 PSF --- FOUNDATION PLAN & DETAILO, AD M</del>CENT PLIL DINC PAG

#### CLASS LEASING- APPROVED STOCKPILE A NUMBERS FOR THIS FOUNDATION PC

**BUILDING DATA-24x40 SHEAR WALL** DSA A# PC-BASE DATE SIZE FLOOR LOAD BLDG MFG.

STKP#	DSA A#	PC-BASE	DATE	SIZE	FLOOR LOAD	BLDG MFG.
TKI II	52402	MRF	00/10/01	<del>21x10</del>	50+20#	MODTEOH
TKP 20	55031	PC 70	00/49/00	24:40	50#	MODTECH
TI(F 21	55002	PO-70	00/10/00	21,10	50#	MODTEOH
TKP 20	55047	PG 70	44/26/00	24:40	50#	MODTECH
TKP OW	57101	PO 70	11/00/01	21,10	E0-20#	MODTECH
TKI 14	57079	PO 00	90/10/02	24×10	59#	MODTEON
7740 40	60000	PG 249	95/94/95	24::40	EÓ#	MODTECH
77147	00021	00.040	05/11/05	21,10	50%	MODTEOH
J11(1-10	22.00	50.000	07/01/00	24×10	150#	MODTEOH
3TKF 27	00430	DC 266	444000	24.40	E0.004	MODTEON
37147 00	07000	50.000	00/44/07	0 (- (0)	60"	MORTEON
OTIVO OF	01 100117	DC 266	04/45/00	24:40	50.00%	MODTECL
3TKD 00	04.400505	00.075	20/40/00	24-42	50.004	MODIFICU
07KF 00	0.1.100000	DO 000	00/10/00	21//10	50-004	MODIFICU
OTICO 40	0.1 100000	DC 000	00/10/00	04.40	90.501	MODIFOLI
OTTA 40	01 100000	DO 000	04/07/00	21/10	50-20#	MODIFOL
3TKP 42	101 100020	1.0 200	01101100	24×10	- C0+23#	mooreon
97KP 40	04 101555	PO 275	66/66/66	21,10		MODTEOH
OTKP 44	04 101002	PC-200	99/99/99	21×10	-G0+20#	MODTEOH
9 <del>71(7-40</del>	01 101700	PO 101260	12/10/00	21×10	- CO#	MODITEOH
OTKP 51	01 102015	PG 101268	00/16/00	24:40	50#, CO+20#	MODTECH
STKP 53	04-102365	PC 101268	07/06/00	24x40	50+20#	MODTECH
OTKP 60	04 102021	PO 101268	12/21/00	£1×10	<del> 50#</del>	MODTEOH
OTKP 02	01 101100	PO-101268	0 1/1 0/02	21×10	50-20#	MODTEOH
OTKP O7	04 104012	PO 101260	12/05/02	21,10	50+20#	MODTECH
CTKP 70	04 105200	PC 104801	05/22/02	24440	50-20#	MODTECH
OTKP 70	04 105155	PG 191796	07/17/00	21,10	50#	MODTEON
OTKP 70	01 100208	PG 106981	12/10/07	24:40	T04	OURRENT/O

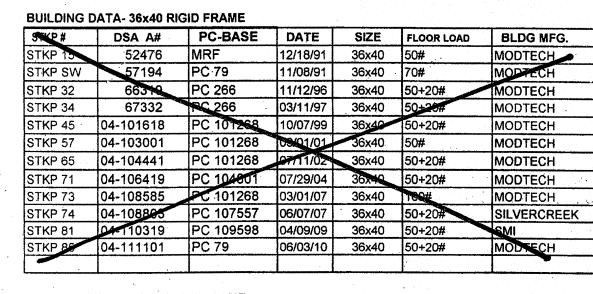

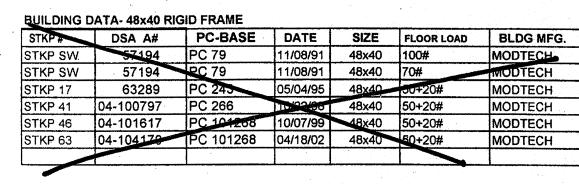

IDENTIFICATION STAMP

DIV. OF THE STATE ARCHITECT

AC\_\_\_FLS\_\_\_SS\_GD\_ DATE\_\_\_JAN 0 8 2014

APPO3 115335

PRE-CHECK (PC) DOCUMENT **CODE: 2010 CBC** A SEPARATE PROJECT APPLICATION FOR CONSTRUCTION IS REQUIRED DIV. OF THE STATE ARCHITECT OFFICE OF REGULATION SERVICES

STOCKPILE CLASSROOM **RELOCATION FOUNDATION PLAN & DETAILS** 

PC 04-112161 FLS TO SS TE 995: D. CONNOLLY

REVISIONS BY

AUG 25 TUB

CL P. 0. 1221 VOIC

SING, INC.
CLASSROC
ON
DN

24×40·50

08-15-2011 DRAWN LAM-CLLS