

**Pinnacle Civil Engineering, Inc.**  
 2161 Saturn Court, Bakersfield, CA 93308  
 Phone: (661) 869-0184 Fax: (661) 377-0076

REVISIONS	DATE
MATTHEW K. VOVILLA	RCE 43130 EXP. 3/31/10

**SITE IMPROVEMENT & GRADING PLAN**  
**MUNSEY ELEMENTARY**  
**3801 BRAVE AVENUE**  
**BAKERSFIELD, CALIFORNIA**



JOB NO.:	09-388
DWG NO.:	09-388-BM
DATE:	09/23/2009
DRAWN BY:	ADK
CHECKED BY:	MKV
SHEET	X-1

SEE SHEET 7

**SEE SHEET 7 FOR LEGEND**  
**SHEET 3 FOR NOTES**  
 (OF ORIGINAL APPROVED SET)

IDENTIFICATION STAMP  
 DIV. OF THE STATE ARCHITECT  
 03-112985  
 AC FL S SS  
 DATE 2/10/10  
 NORTH  
 SCALE: 1" = 10'  
 0 5 10 20

NOTE: THIS SHEET (X-1) FORMERLY SHEET 6 OF 8.

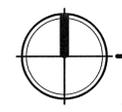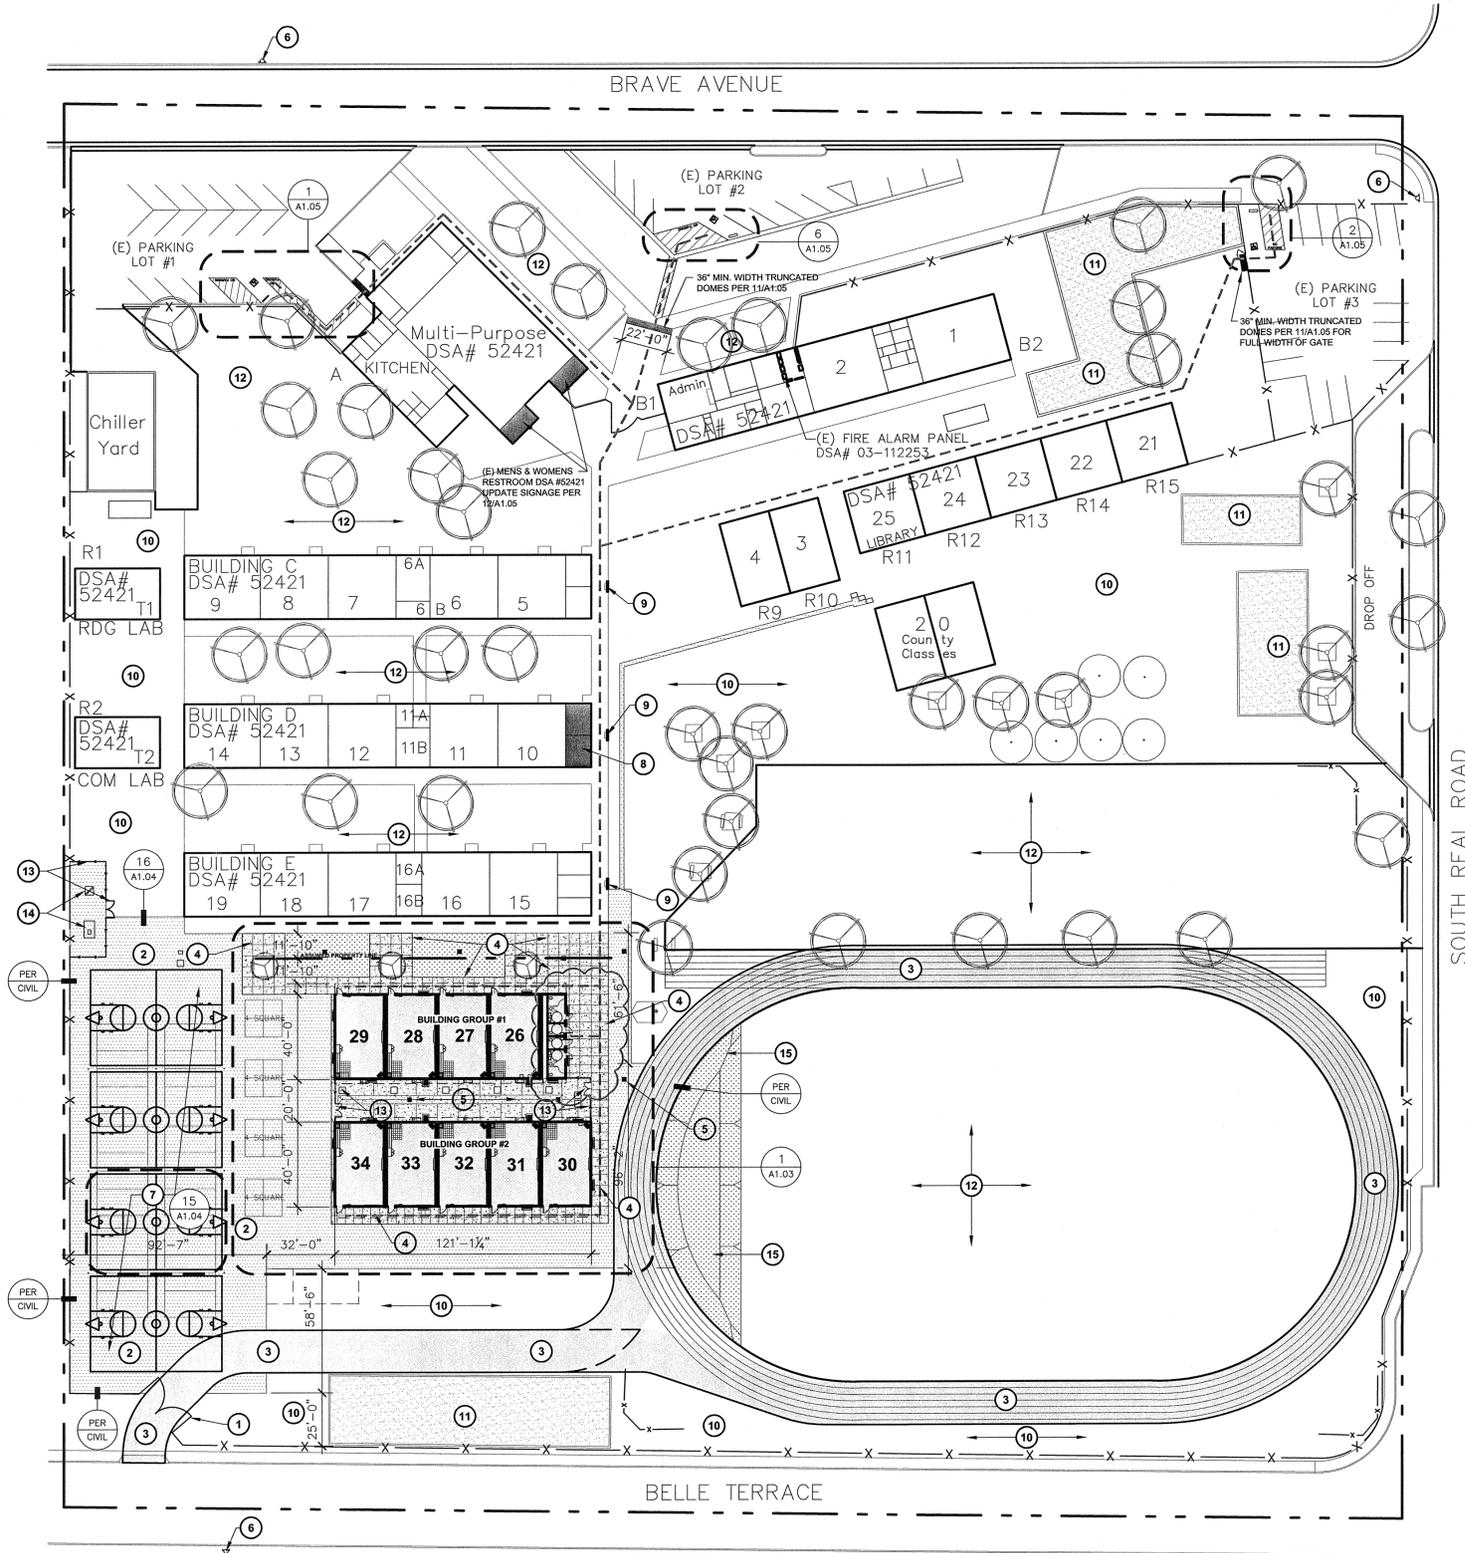

**SITE PLAN**  
**10 NEW PORTABLE CLASSROOMS**

SCALE: 1:40

**KEY NOTES**

- EXISTING CHAIN LINK FENCE AND GATE TO REMAIN. PROVIDE W/ KNOX BOX LOCK PER KERN COUNTY STANDARDS
- NEW AC PAVING PER DETAIL 11/A1.04
- PROPOSED 20' WIDE FIRE TRUCK ACCESS LANE OVER EXISTING AC-PAVING, APPROVED BY THE LOCAL JURISDICTION.
- NEW 4" THICK CONCRETE WITH MEDIUM BROOM FINISH AND SCORE JOINTS PER DETAIL 1A/1.03
- NEW DRAIN INLET. REFER TO CIVIL FOR ALL GRADING AND DRAINAGE INFORMATION.
- EXISTING FIRE HYDRANT TO REMAIN
- NEW BASKETBALL COURT (TYP. OF 4) PER DETAIL 15/A1.04
- EXISTING BOYS AND GIRLS RESTROOM
- EXISTING DRINKING FOUNTAIN TO REMAIN
- EXISTING AC-PAVING TO REMAIN
- EXISTING SAND PLAY AREA TO REMAIN
- EXISTING TURF TO REMAIN
- NEW 6' HIGH CHAIN LINK FENCE w/ PRIVACY SLATES AND 3' WIDE GATE

**GENERAL NOTES**

- THE OWNER SHALL BE RESPONSIBLE FOR RE-ROUTING THE EXISTING IRRIGATION SPRINKLER LINES AND HEADS AS REQUIRED FOR PROPER COVERAGE IN THE AREA OF NEW CONSTRUCTION.
- NEW CONCRETE WALKS SHALL HAVE SLOPES NOT TO EXCEED 1 IN 20 IN THE DIRECTION OF PATH OF TRAVEL. PROVIDE CONTROL JOINTS ("C.J.") AT 5'-0" o.c. MAX. AND EXPANSION JOINTS NOT TO EXCEED 30'-0" MAX. PROVIDE MEDIUM BROOM FINISH ON ALL WALKS.
- CONTRACTOR WILL BE RESPONSIBLE TO COORDINATE RELOCATABLE BUILDING DELIVERY DATES TO THE SCHOOL SITE WITH THE MANUFACTURER
- THE CONTRACTOR SHALL CONSTRUCT ALL NEW RELOCATABLE BUILDING CONCRETE FOUNDATIONS AS PER THE RELOCATABLE BUILDING MANUFACTURERS DRAWINGS AND SPECIFICATIONS.
- THE CONTRACTOR SHALL FURNISH AND INSTALL ALL NEW RELOCATABLE BUILDING PERIMETER SILL SHEET METAL FLASHING AFTER THE RELOCATABLE BUILDING IS SET IN PLACE.
- THE CONTRACTOR SHALL BE RESPONSIBLE TO PROVIDE ALL HOOK-UPS TO THE RELOCATABLE BUILDINGS AFTER INSTALLATION HAS BEEN COMPLETED BY THE MANUFACTURER.
- 5'-0" DEEP x 5'-0" WIDE MINIMUM CONCRETE LANDINGS AT DOORWAYS SHALL BE AS DETAILED AND SHALL HAVE SLOPES (IN ANY DIRECTION) OF NOT GREATER THAN 1/4 IN 12 SLOPE (2%). SLOPES SHALL BE AWAY FROM DOORWAYS.
- CONTRACTOR SHALL FIELD VERIFY THAT EXISTING PATH OF TRAVEL (P.O.T.) IS A MINIMUM OF 4'-0" WIDE AND IS SLIP RESISTANT. IF IT IS NOT, THEN THE CONTRACTOR SHALL NOTIFY THE ARCHITECT OF RECORD AND A REMEDY OR ALTERNATE P.O.T. WILL BE PROVIDED.
- THE MAXIMUM DROP BETWEEN EXISTING FINISHED GRADES AND THE TOP OF THE P.O.T. SHOULD NOT EXCEED 4". IF IT DOES, PROVIDE THE NECESSARY WARNING CURB PER CBC SEC. 1133B.8.1.
- THE CONTRACTOR SHALL BE RESPONSIBLE FOR ALL TEMPORARY FENCING.

**PARKING CALCULATION**

<b>PARKING LOT #1</b>	TOTAL STALLS PROVIDED - 16 STALLS
	ACCESSIBLE STALLS REQUIRED - 1 VAN STALL
	ACCESSIBLE STALLS PROVIDED - 1 VAN STALL
<b>PARKING LOT #2</b>	TOTAL STALLS PROVIDED - 10 STALLS
	ACCESSIBLE STALLS REQUIRED - 1 VAN STALL
	ACCESSIBLE STALLS PROVIDED - 1 VAN STALL
<b>PARKING LOT #3</b>	TOTAL STALLS PROVIDED - 16 STALLS
	ACCESSIBLE STALLS REQUIRED - 1 VAN STALL
	ACCESSIBLE STALLS PROVIDED - 1 VAN STALL

**LOCAL FIRE AUTHORITY REVIEW**

LOCAL FIRE AUTHORITY TO INITIAL THE ITEMS AS APPLICABLE TO THIS PROJECT AND SIGN BELOW

**ACCESS ROADS AND FIRE HYDRANTS**

- JK ACCESS ROADS AND GATE ENTRANCES ARE IN ACCORDANCE WITH TITLE 19, CALIFORNIA CODE OF REGULATIONS DIV. 1, CHAP. 1, SUB. CHAP. 1, ARTICLE 3 NUMBER 3.05 (ACCESS ROADS) AND 3.16 (GATE ENTRANCES) TO SCHOOL SITES.
- JK FIRE FLOW, FIRE HYDRANT LOCATION AND DISTRIBUTION ARE IN ACCORDANCE WITH CALIFORNIA FIRE CODE, APPENDIX C (FIRE FLOW) AND APPENDIX B (HYDRANT LOCATIONS)
- NA WILDLAND URBAN INTERFACE AREA

**BUILDING DATA**

OCCUPANCY = E  
TYPE OF CONSTRUCTION = VB (NON-SPRINKLERED)  
BUILDING GROUP #1 + GROUP #2  
(9) CLASSROOMS @ 960 S.F. (24'x40') EA. = 8,640 S.F.  
(1) RESTROOM @ 480 S.F. (12'x40') EA. = 480 S.F.  
PER 2007 C.B.C. TABLE 503:  
9,120 PROPOSED < 9,500 ALLOWABLE =  OK

**AUTOMATIC FIRE SPRINKLER SYSTEMS**

- NA THE LOCATION(S) OF THE PROPOSED POST INDICATOR VALVE (PIV) AND FIRE DEPARTMENT CONNECTION (FDC) MEETS THE REQUIREMENTS OF THIS JURISDICTION AT THIS TIME.
- NA THE LOCATION(S) OF THE DETECTOR CHECK VALVE ASSEMBLY (DCVA) MEETS THE REQUIREMENTS OF THIS JURISDICTION AT THIS TIME.
- NA THE FIRE PUMP ASSEMBLY/BACKFLOW PREVENTER MEETS THE REQUIREMENTS OF THIS JURISDICTION AT THIS TIME.

LOCAL FIRE AUTHORITY: KERN COUNTY FIRE DEPT  
ADDRESS: 5642 VICTOR ST.  
CITY/STATE/ZIP: BAKERSFIELD CA DATE: 05/27/09  
PHONE NUMBER: (661) 391-7080  
APPROVAL ISSUED BY: JIM KILLAM  
RANK/TITLE: FPS-2  
COMMENTS: ORIGINAL SIGNATURE ON FILE WITH DSA

**ACCESSIBILITY NOTE**

PATH OF TRAVEL (P.O.T.) AS INDICATED IS A BARRIER FREE ACCESSIBLE ROUTE AT LEAST 48" WIDE WITHOUT ANY ABRUPT CHANGES EXCEEDING 1/4" AT 1:2 MAX. SLOPE, EXCEPT THAT LEVEL CHANGES DO NOT EXCEED 1/4" VERTICAL. MAXIMUM CROSS SLOPE 2% TYPICAL AND A MAXIMUM SLOPE IN THE DIRECTION OF TRAVEL IS 5% OR LESS, UNLESS OTHERWISE NOTED. P.O.T. SHALL BE MAINTAINED FREE OF OVERHEAD OBSTRUCTIONS TO 80" MIN. (CBC 1133B.2) AND SIDE OBJECTS PROTRUDING GREATER THAN 4" INTO P.O.T. BETWEEN 27" AND 80" ABOVE THE FINISHED FLOOR

**LEGEND**

- INDICATES EXISTING BUILDING TO REMAIN (NO WORK)
- INDICATES NEW RELOCATABLE BUILDING UNDER THIS APPLICATION
- NEW 4" THICK CONCRETE WALK WITH MEDIUM BROOM FINISH
- INDICATES NEW ASPHALT PAVING REFER TO CIVIL FOR ADDITIONAL INFO
- INDICATES FIRE TRUCK ACCESS OVER EXISTING AC PAVING
- HALF-TONE DASHED LINE INDICATES ACCESSIBLE PATH OF TRAVEL

**Ownership of Documents**  
This document, the ideas and designs incorporated herein, as an instrument of Professional Service is the property of Integrated Design by SOMAM Inc. and is not to be used, in whole or in part for any other project without written authorization.  
© COPYRIGHT 2009

**integrated designs** by SOMAM, Inc.  
ARCHITECTURE • INTERIOR DESIGN • CONSTRUCTION MANAGEMENT  
801 N. Fresno, Suite 130 - Fresno, California 93710  
Phone (559) 436-0881 Fax (559) 436-0887 E-Mail: design@somam.com  
www.integrateddesigns.com

Rev. No.	Date	Description

**SITE PLAN**

**MUNSEY ELEMENTARY SCHOOL**  
10 NEW PORTABLE CLASSROOMS

BAKERSFIELD CITY SCHOOL DISTRICT  
3801 BRAVE AVE. BAKERSFIELD, CA 93309

Issue Date: 02/04/10  
Date: 02/04/10  
Designer: JIM KILLAM  
DR: JIM KILLAM  
PC: CJM

FILE #15-6  
IDENTIFICATION STAMP  
DIV. OF THE STATE ARCHITECT  
OFFICE OF REGULATION SERVICES

03-112985  
AC FLSC SS JK  
DATE 2/10/10

TRACKING #: 63321-96

Stamp(s):


LICENSED ARCHITECT  
SOMAM, INC.  
No. C 28966  
STATE OF CALIFORNIA

Job No.: **3832**

Sheet No.: **X-2**


Release: -

1" = 40'-0"  
 1" = 30'-0"  
 1" = 20'-0"  
 1" = 1'-0"  
 1/8" = 1'-0"  
 1/4" = 1'-0"

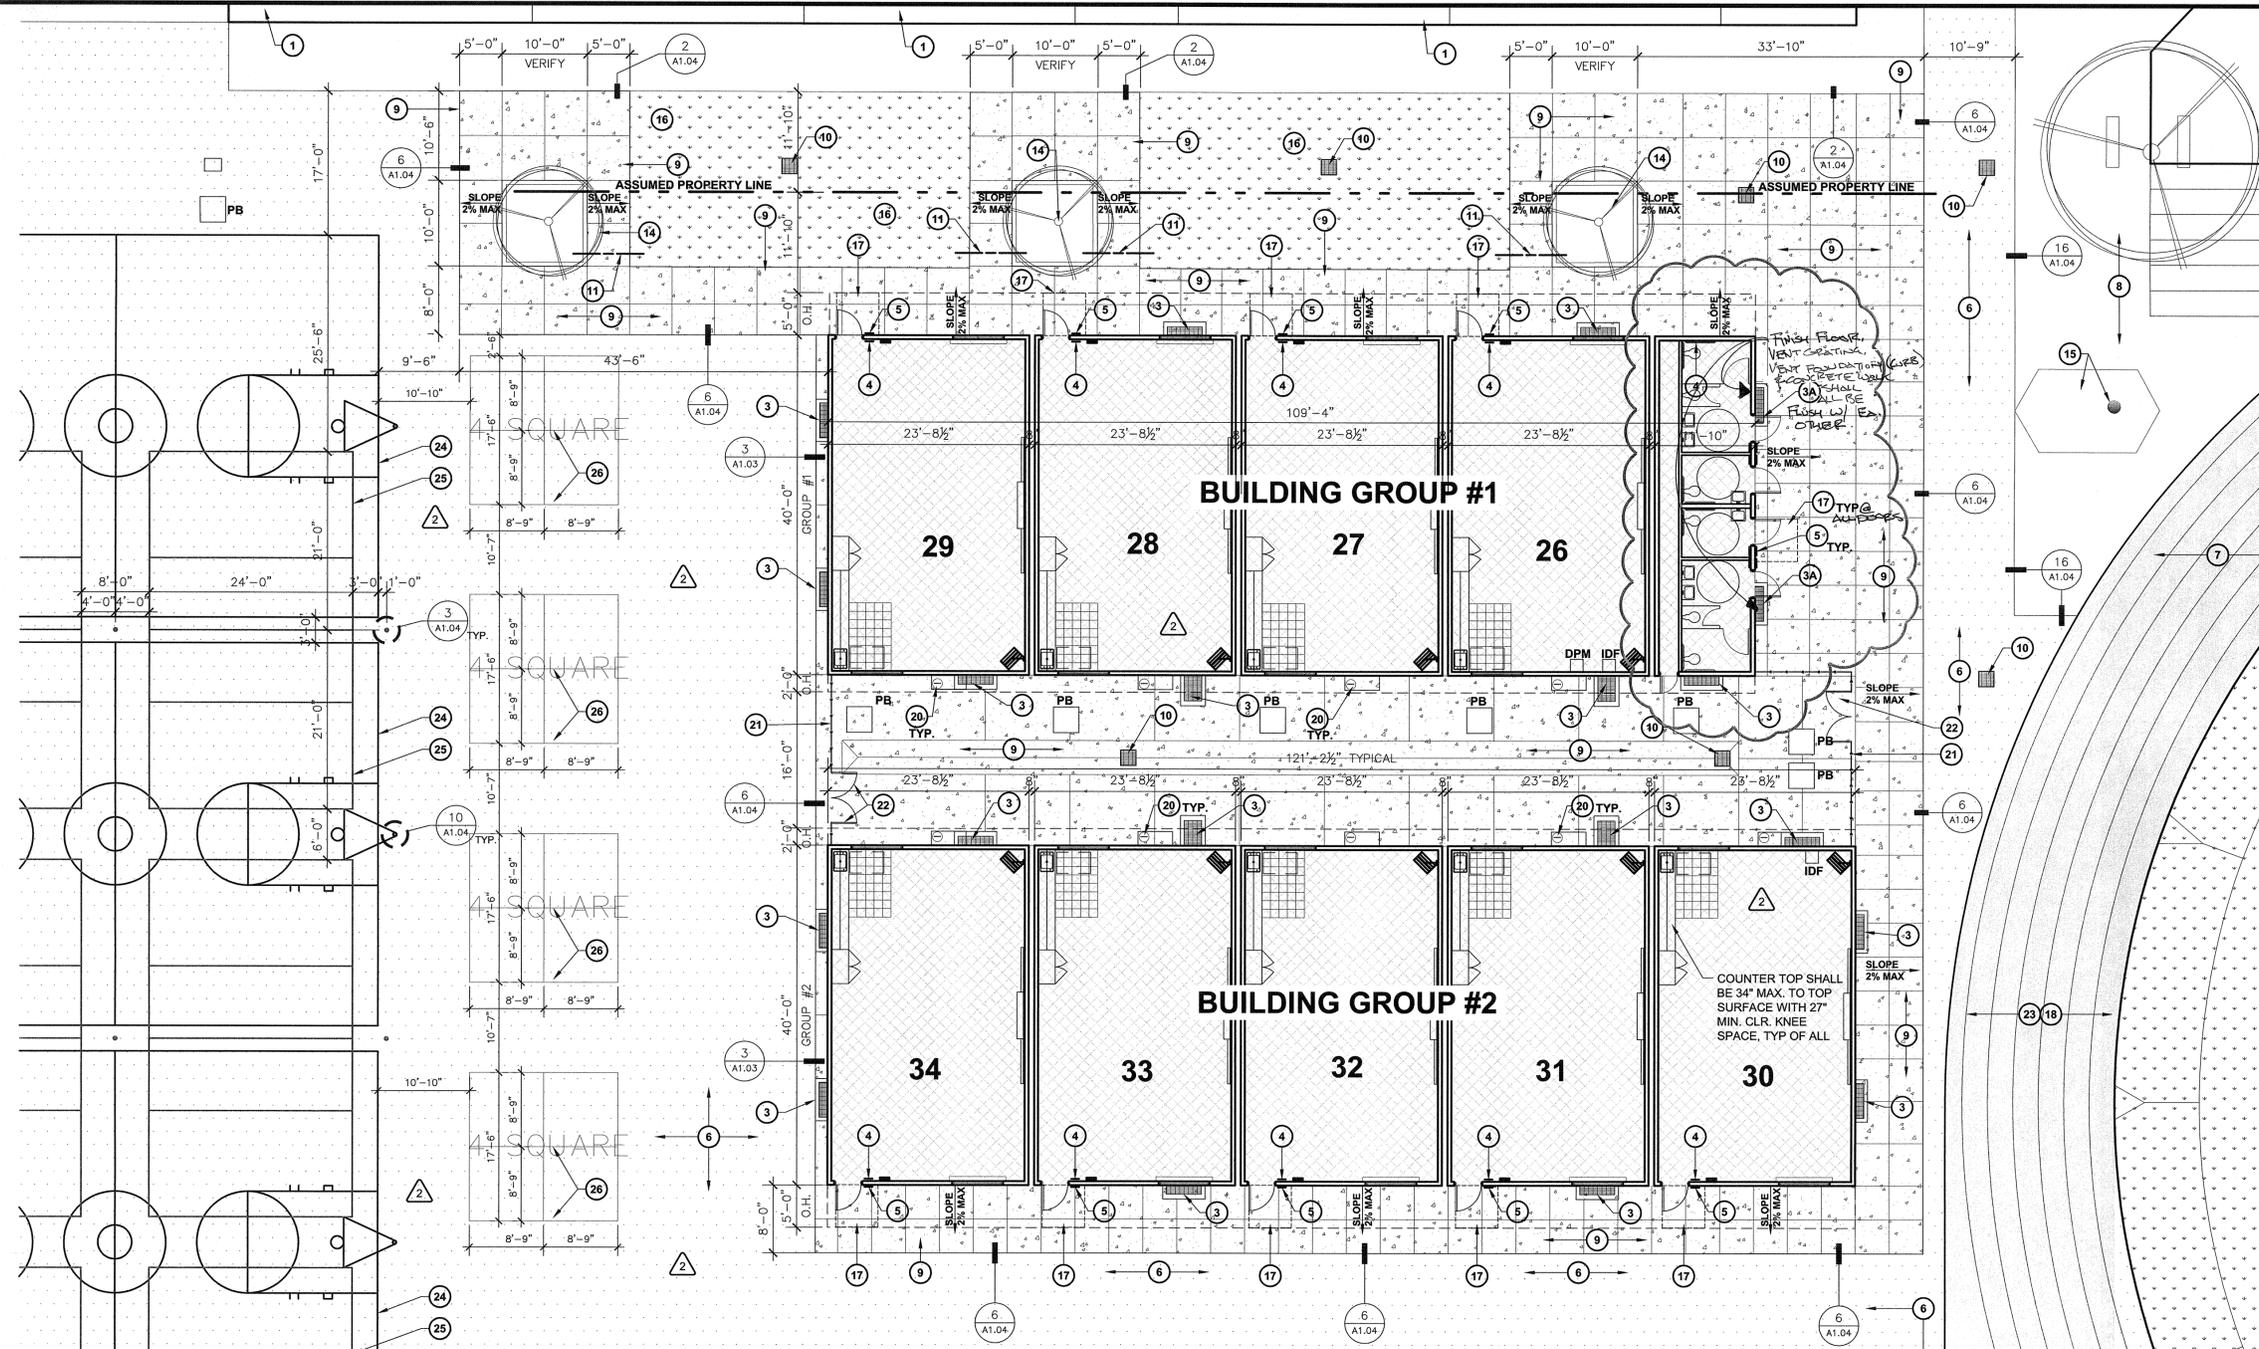

**ENLARGED SITE PLAN**  
 10 NEW PORTABLE CLASSROOMS

SCALE: 1:10

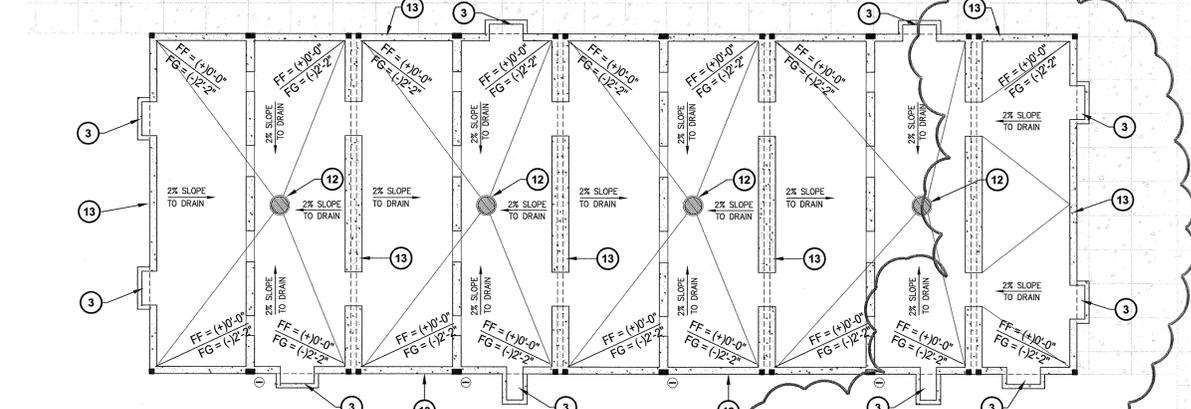

**FOUNDATION DRAINAGE PLAN - GROUP #1**  
 10 NEW PORTABLE CLASSROOMS

SCALE: 1:10

**KEY NOTES**

1. EXISTING BUILDING TO REMAIN, NO WORK
2. EXISTING ELECTRICAL ENCLOSURE. REFER TO ELECTRICAL DRAWINGS FOR ADDITIONAL INFO.
3. NEW FLOOR VENT AND ACCESS GRATING TO BE ADA ACCESSIBLE / APPROVED AND SHALL BE FLUSH WITH ALL ADJACENT WALKWAYS. REFER TO BUILDING MANUFACTURER'S DRAWINGS FOR VENT CALCS. AND INSTALLATION REQUIREMENTS.
- 3A. FOUNDATION VENT GRATING SHALL HAVE A MAXIMUM OF 1/2" MAX GRATE BAR SPACING IN BOTH DIRECTIONS. THIS LOCATION ONLY.
4. NEW TACTILE EXIT SIGN PER 8/A1.04
5. NEW ROOM IDENTIFICATION SIGN PER 4/A1.04
6. NEW AC PAVING PER DETAIL 11/A1.04
7. PROPOSED 20' WIDE FIRE TRUCK ACCESS LANE OVER EXISTING AC-PAVING, APPROVED BY THE LOCAL JURISDICTION.
8. EXISTING AC-PAVING TO REMAIN
9. NEW 4" THICK CONCRETE WITH MEDIUM BROOM FINISH AND SCORE JOINTS PER DETAIL 1/A1.04
10. NEW DRAIN INLET REFER TO CIVIL FOR ALL GRADING AND DRAINAGE INFORMATION.
11. NEW IRRIGATION SLEEVE PER 10/A1.05
12. NEW DRYWELL DRAIN. LOCATE ONE BELOW EACH CLASSROOM A MINIMUM OF 2' BELOW THE BOTTOM OF THE FOOTING WALL, REFER TO DETAIL 8/A1.04 AND MANUFACTURER'S DRAWINGS FOR ADDITIONAL INFORMATION.
13. CONCRETE CLASSROOM FOUNDATION. REFER TO MANUFACTURER'S DRAWINGS FOR ADDITIONAL INFORMATION
14. EXISTING TREE & PLANTER TO REMAIN. WATER REGULARLY AND PROTECT FROM DAMAGE DURING CONSTRUCTION
15. EXISTING FLAG POLE AND BASE TO REMAIN
16. NEW LAWN SHALL BE THE RESPONSIBILITY OF THE OWNER. OWNER TO CONNECT NEW IRRIGATION SYSTEM TO EXISTING IRRIGATION SYSTEM.
17. 60"x60" LEVEL LANDING AREA, SLOPE SHALL BE 2% MAXIMUM IN ANY DIRECTION
18. NEW AC-PAVED FIRE TRUCK ACCESS LANE, REFER TO CIVIL FOR PAVEMENT SECTION
19. NEW TREE AND PLANTER, SPECIES SELECTED BY OWNER, PLANTER PER DETAIL 3/A1.04
20. HVAC CONDENSATE DRAIN PER DETAIL 9/A1.05
21. NEW 6'-0" HIGH CHAIN LINK FENCE
22. NEW 6'-0" HIGH CHAIN LINK GATE WITH FORK LATCH AND LOCK KEYS TO DISTRICT STANDARD
23. NEW AC-PAVING SHALL BE RE-STRIPED WHERE PAVEMENT HAS BEEN REMOVED TO MATCH EXISTING TRACK STRIPING
24. NEW BASKETBALL COURT PER DETAIL 15/A1.04
25. NEW VOLLEYBALL COURT PER DETAIL 15/A1.04
26. NEW 4-SQUARE COURT, PAINT 2" WHITE LINES AS DIMENSIONED.

**LEGEND**

- INDICATES EXISTING BUILDING TO REMAIN (NO WORK)
- NEW 4" THICK CONCRETE WALK WITH MEDIUM BROOM FINISH
- INDICATES NEW ASPHALT PAVING, REFER TO CIVIL FOR ADDITIONAL INFO.
- INDICATES FIRE TRUCK ACCESS OVER AC PAVING
- INDICATES NEW TURF AND IRRIGATION SYSTEM INSTALLED BY CONTRACTOR
- HALF-TONE DASHED LINE INDICATES ACCESSIBLE PATH OF TRAVEL

Ownership of Documents  
 This document, the ideas and designs incorporated herein, as an instrument of Professional Service is the property of Integrated Designs by SOMAM, Inc. and is not to be used, in whole or in part for any other project without written authorization.  
 © COPYRIGHT 2009

**integrated designs** by SOMAM, Inc.  
 ARCHITECTURE · INTERIOR DESIGN · CONSTRUCTION MANAGEMENT  
 6011 N. Fresno, Suite 330 - Fresno, California 93710  
 Phone (559) 436-0887 Fax (559) 436-0887 E-Mail: design@somam.com  
 www.integrateddesigns.com

Rev. No.	Date	Description


**ENLARGED SITE PLAN AND FOUNDATION DRAINAGE**  
 Project Name & Address:  
**MUNSEY ELEMENTARY SCHOOL**  
**10 NEW PORTABLE CLASSROOMS**  
 BAKERSFIELD CITY SCHOOL DISTRICT  
 3801 BRAVE AVE. BAKERSFIELD, CA 93309

Issue Date: 01/25/10  
 Date: 01/25/10  
 Designer: [Signature]  
 DR: [Signature]  
 PC: CJM

DSA Identification Stamp:  
 FILE # 15-6  
 IDENTIFICATION STAMP  
 DIV. OF THE STATE ARCHITECT  
 OFFICE OF REGULATION SERVICES  
 03-112985  
 AC: [Signature] FLS: [Signature] SS: [Signature]  
 DATE: 2/10/10  
 TRACKING #: 63321-96

Stamp(s):

Job No.: **3832**  
 Sheet No.: **X-3**  
 Release:

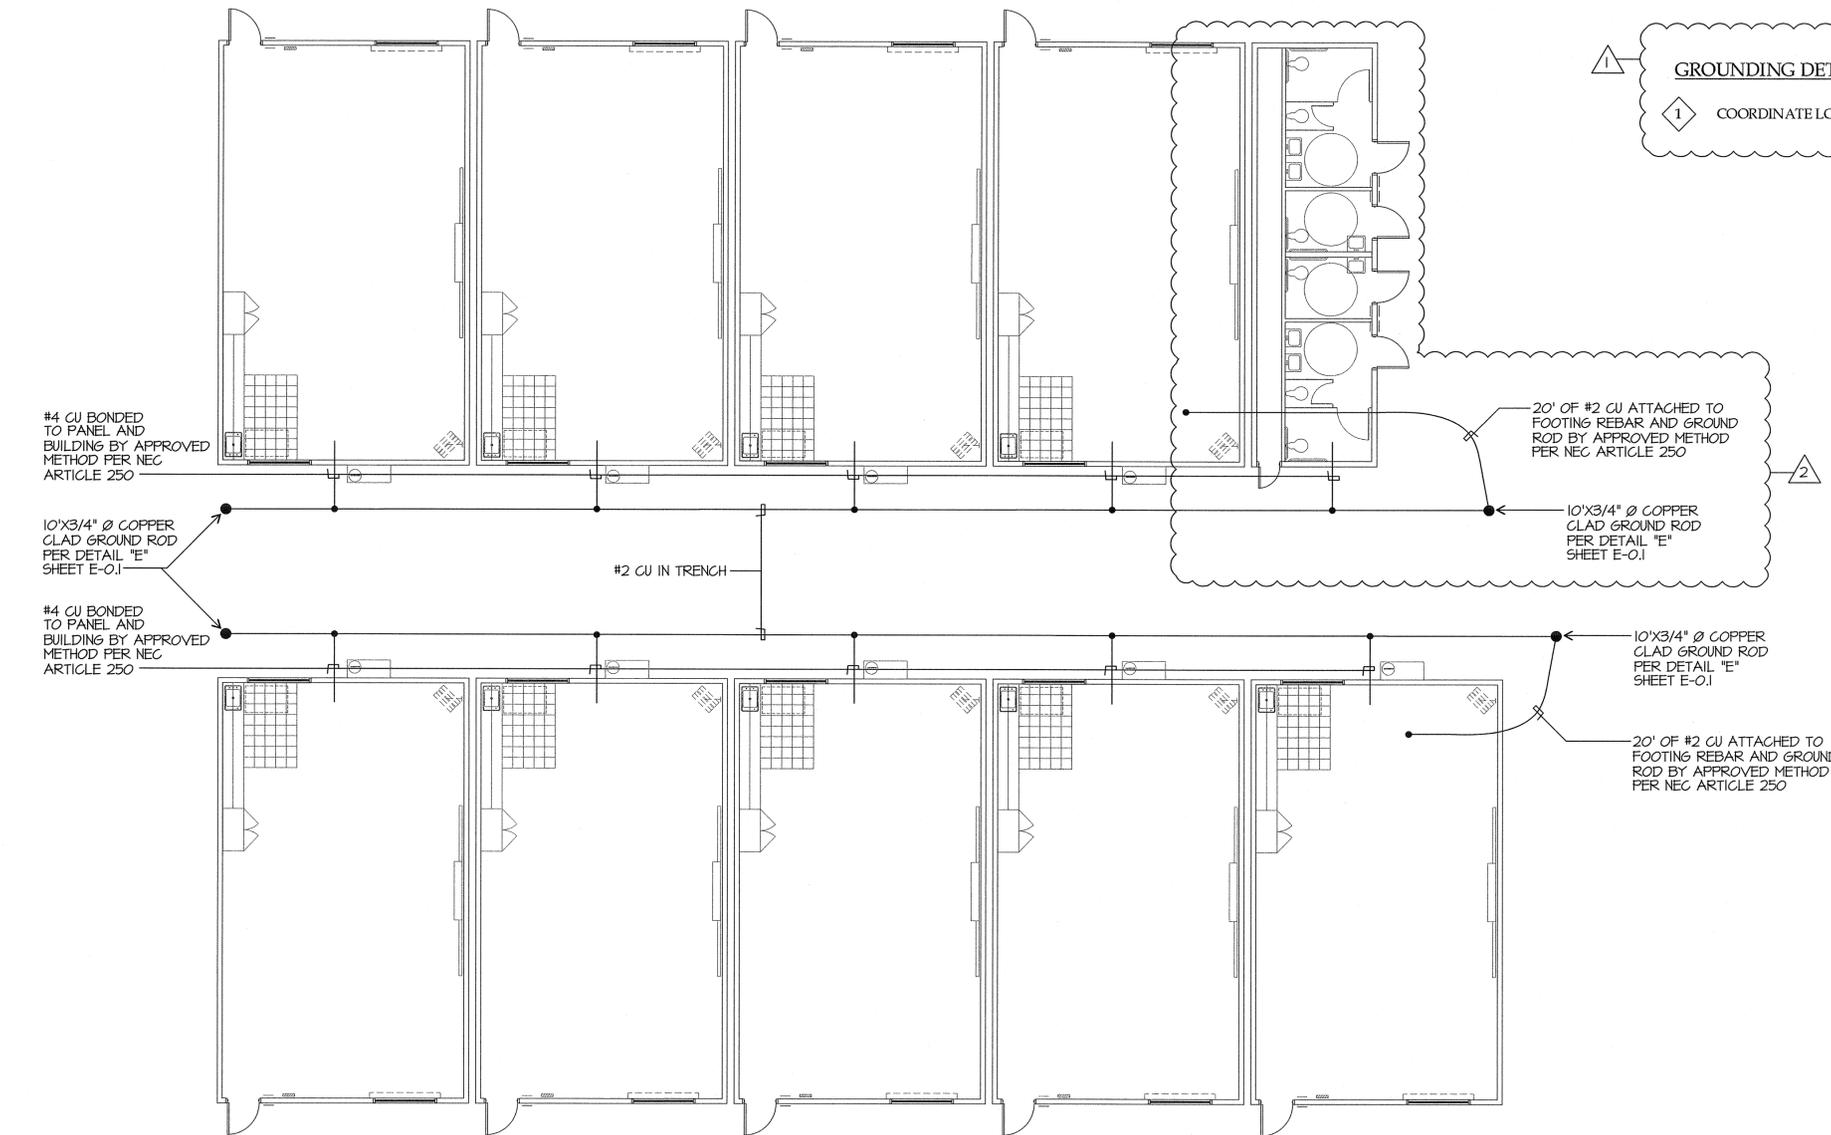


**GROUNDING DETAIL NOTES**


1 COORDINATE LOCATIONS OF WORK SHOWN WITH CIVIL DRAWINGS.

GROUNDING DETAIL


SCALE: 1/8"=1'-0"

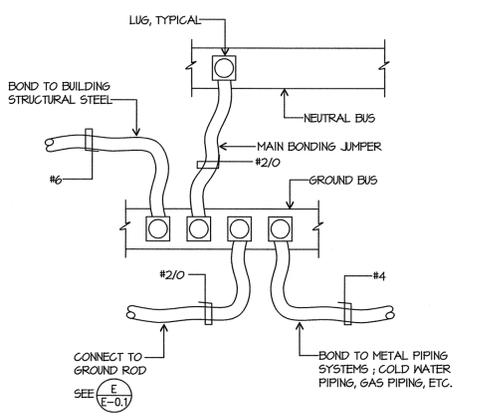

BONDING DIAGRAM "MSB"  
SCALE: NONE

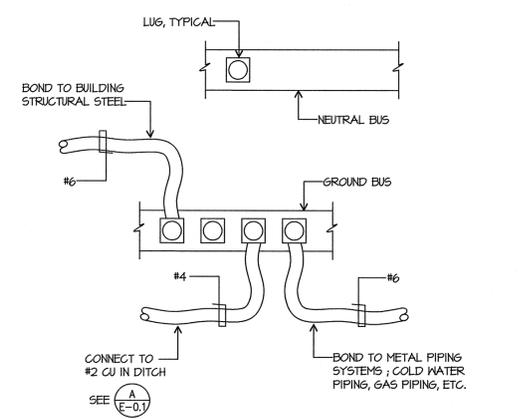


BONDING DIAGRAM PORTABLE PANEL  
SCALE: NONE

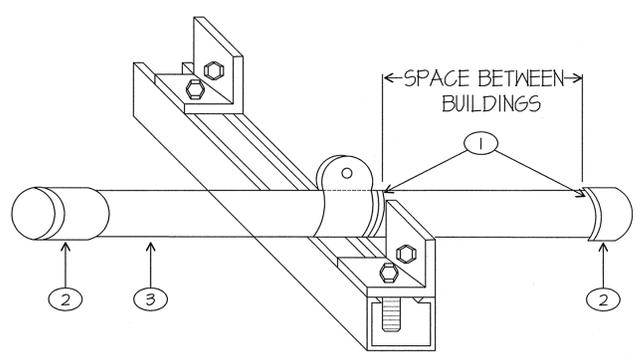


CONDUIT SLEEVE SUPPORT  
WALL MOUNTED UNISTRUT BRACKETS  
FOR ONE OR MORE CONDUITS  
SCALE: NONE

1 FOAM FILL AND FIRE CAULK THE WALLS AFTER CONDUITS ARE INSTALLED.  
2 INSULATED THROAT SET SCREW CONNECTOR  
3 USE OF EMT IS ACCEPTABLE FOR SLEEVE INSTALLATION.

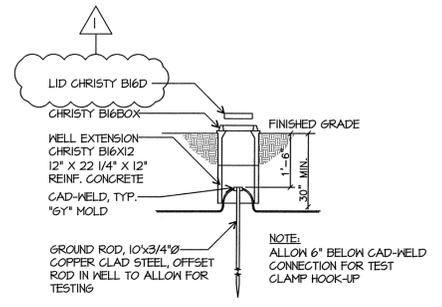

GROUND ACCESS BOX

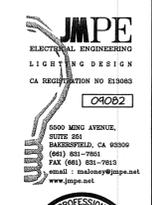

**Ownership of Documents**  
This document, the ideas and designs incorporated herein, as an instrument of Professional Service is the property of Integrated Designs by SOMAM, Inc. and is not to be used, in whole or in part for any other project without written authorization. © COPYRIGHT 2009

**integrated designs** by SOMAM, Inc.  
ARCHITECTURE • ENGINEERING • INTERIOR DESIGN • CONSTRUCTION MANAGEMENT  
6011 N. Fresno, Suite 130 - Fresno, California 93710  
Phone (559) 436-0881 Fax (559) 436-0887 E-Mail: design@somam.com  
www.integrateddesigns.com

Revision	Rev. Date	Rev. Description
1	10/15/09	ADDED JUM 1
2	01/22/10	CHANGE ORDER

Sheet Title: **SINGLE LINE DIAGRAM, SYMBOLS, DETAILS, GENERAL NOTES**

Project Name & Address: **MUNSEY ELEMENTARY SCHOOLS**  
BAKERSFIELD CITY SCHOOL DISTRICT  
3801 BRAVE AVE. BAKERSFIELD, CA 93309

Issue Date:	05/02/06
Designer:	DR. DRAFTER
DR:	FC: C.J.M.

DSA Identification Stamp:


IDENTIFICATION STAMP  
DIV. OF THE STATE ARCHITECT  
05-112985  
AC DATE  
DATE

Stamp(s):


Job No.: **3832**

Sheet No.: **X4-E-0.1**


Release: **CURTIS MCNALLY**

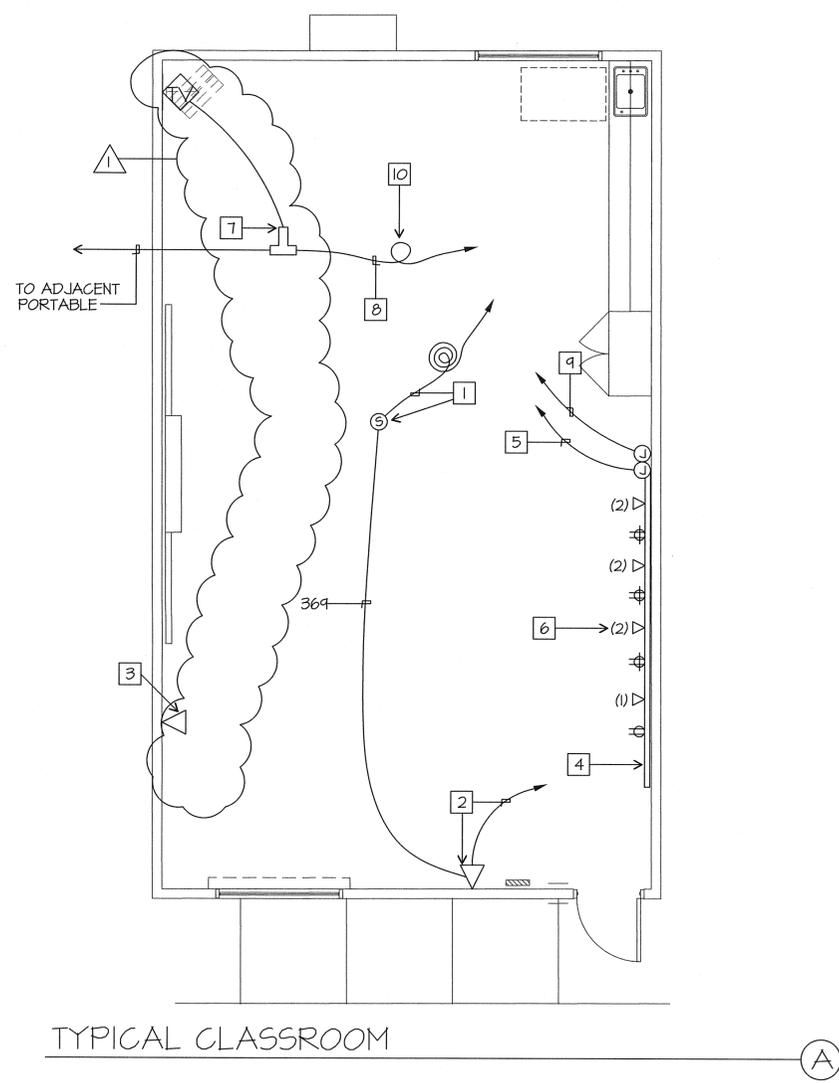


- TYPICAL CLASSROOM NOTES**
- 1 PROVIDE (ATLAS MODEL #SD72-W 25W/70W OR EQUAL) CEILING MOUNTED SPEAKER. PROVIDE A DEDICATED WESTPENN 369 CABLE BACK TO THE TERMINAL CABINET. TERMINATE ON 66 BLOCK. TERMINATE SHIELDED CABLE ON SPEAKER. PROVIDE 3 SERVICE LOOPS OF CABLE AT EACH SPEAKER LOCATION.
  - 2 PROVIDE (CORTEL CO EASYTOUCH MODEL #240085-VOE-21F, COLOR SANDSTONE) TELEPHONE WITH RJ11 JACK AT EXISTING OUTLET. EXTEND 369 CABLE FROM SPEAKER, USE ONE OF TWO PAIR LEFT FOR TELEPHONE CONNECTION. PROVIDE ONE DEDICATED CAT 5 CABLE, (GENERAL CABLE #5500) TO IDF CABINET (FUTURE SPARE).
  - 3 PROVIDE RJ45 DATA JACK AT (E) OUTLET. ROUTE (1) CAT5 CABLE (GENERAL CABLE #5500) BACK TO NEAREST IDF CABINET AND TERMINATE ON PATCH PANEL.
  - 4 SURFACE MOUNT WIREMOLD BRAND, TWO COMPARTMENT 5400 SERIES RACEWAY WITH SPLIT COVER. CONTRACTOR SHALL PROVIDE ALL ACCESSORIES, FITTINGS, FACEPLATES AND DEVICES FOR A COMPLETE SYSTEM. COORDINATE EXACT LOCATION WITH ROBERT VAN TASSLE, SUPERVISOR, PLANNING AND CONSTRUCTION BAKERSFIELD CITY SCHOOL DISTRICT, 661-631-5884. MOUNT AT 18" A.F.F.
  - 5 PROVIDE (7) CAT5 CABLES BACK TO CLOSEST IDF AND TERMINATE ON PATCH PANEL.
  - 6 NUMBER SIGNIFIES THE QUANTITY OF RJ45 JACKS AT DATA LOCATION. CONTRACTOR SHALL PROVIDE AND INSTALL CABLE, JACKS AND TERMINATIONS.
  - 7 PROVIDE BLONDER TONGUE T-TAPS WITH QUAD SHIELD COMPRESSION TERMINATIONS. CABLE CONTINUES TO ADJACENT PORTABLE CLASSROOM. INTERIOR TV CABLE SHALL BE RG6 QUAD SHIELD CABLE. PROVIDE 12' OF EXTRA CABLE PER CLASSROOM. COORDINATE WITH GARY TAYLOR, NETWORK SYSTEMS ENGINEER FOR BAKERSFIELD CITY SCHOOL DISTRICT, 661-631-4745.
  - 8 FROM COMMUNICATION TERMINAL CABINET.
  - 9 TO SPARE 120V CIRCUIT IN CLASSROOM PANEL. PROVIDE 20/1 CIRCUIT BREAKER AS NEEDED.
  - 10 PROVIDE 2' SERVICE LOOP, TYPICAL.

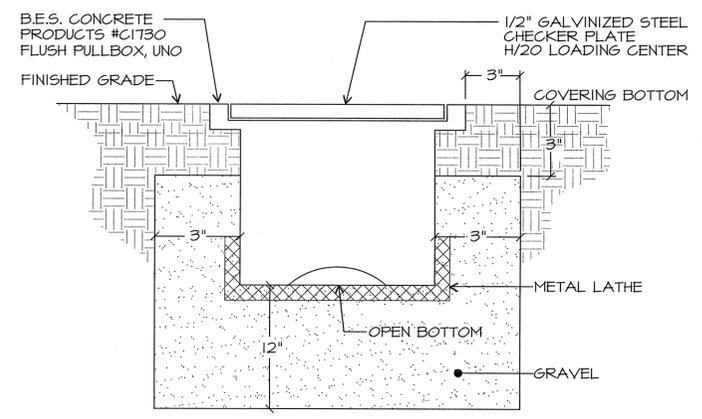

FLUSH PULLBOX DETAIL  
SCALE: NONE (C)

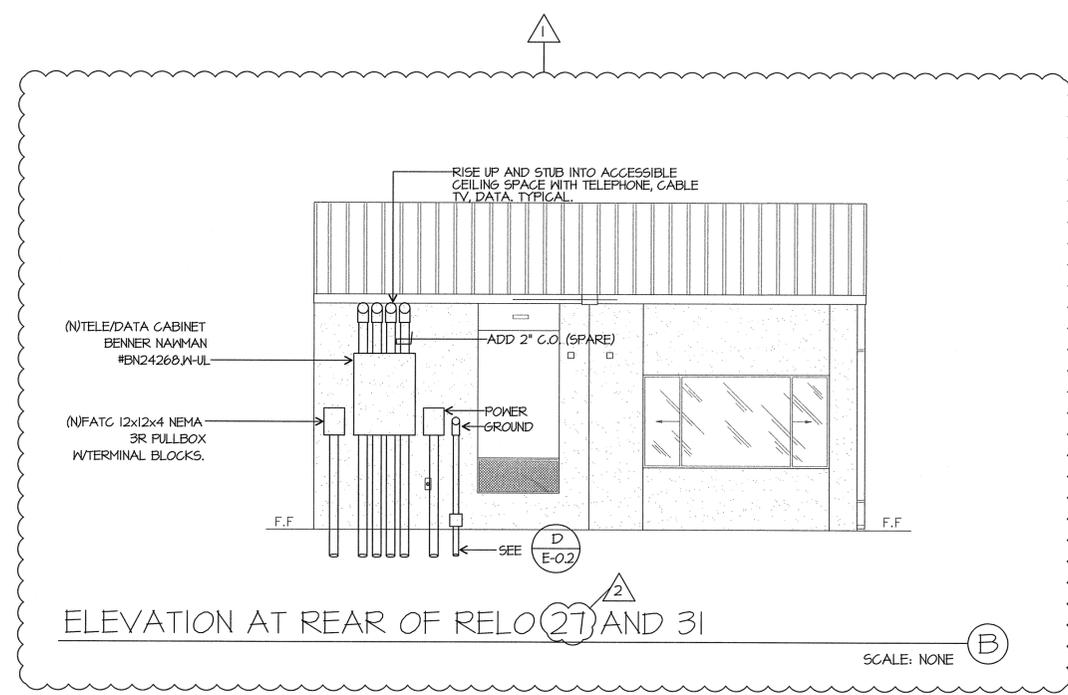

ELEVATION AT REAR OF RELO 27 AND 31  
SCALE: NONE (B)

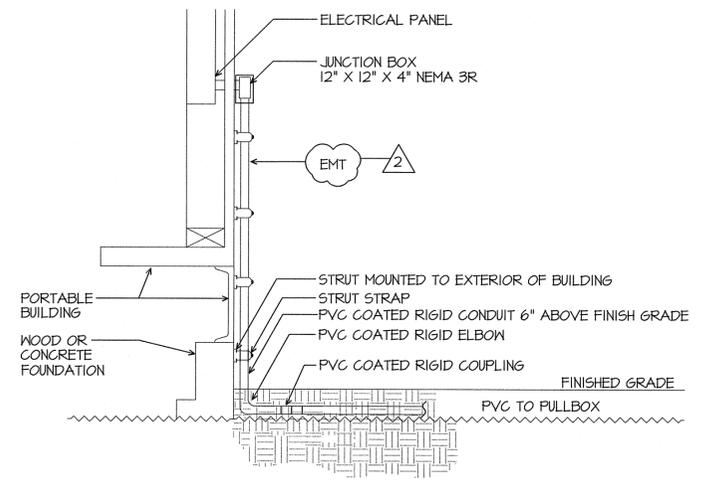

TYPICAL PORTABLE CONNECTION  
SCALE: NONE (D)

**Ownership of Documents**  
This document, the ideas and designs incorporated herein, as an instrument of Professional Service is the property of Integrated Designs by SOMAM, Inc. and is not to be used, in whole or in part for any other project without written authorization.  
© COPYRIGHT 2009

**integrated designs** by SOMAM, Inc.  
ARCHITECTURE - ENGINEERING - INTERIOR DESIGN - CONSTRUCTION MANAGEMENT  
6011 N. Fresno, Suite 130 - Fresno, California 93710  
Phone (559) 436-0881 Fax (559) 436-0887 E-Mail: design@somam.com  
www.integrateddesigns.com

Revision	Description	Rev. Date
1	ADDENDUM 1	10/15/09
2	CHANGE ORDER	01/22/10

Sheet Title:  
**SINGLE LINE DIAGRAM, SYMBOLS  
DETAILS, GENERAL NOTES**

Project Name & Address:  
**MUNSEY ELEMENTARY SCHOOL  
10 NEW PORTABLE CLASSROOMS**  
BAKERSFIELD CITY SCHOOL DISTRICT  
3801 BRAVE AVE. BAKERSFIELD, CA 93309

Issue Date:	Date:	Designer:	DR:	FC:
	05/02/06		DRAFTER	CJM

DSA Identification Stamp:

IDENTIFICATION STAMP  
DIV. OF THE STATE ARCHITECT  
03-112985  
AC FLS SS  
DATE 2/10/10

Stamp(s):

REGISTERED PROFESSIONAL ARCHITECT  
ELECTRICAL ENGINEERING  
LIGHTING DESIGN  
CA REGISTRATION NO 813083  
09082


5050 MIDWAY AVENUE,  
SUITE 200  
BAKERSFIELD, CA 93309  
(805) 991-7961  
FAX (805) 931-7913  
email: maloney@jpmpe.net  
www.jpmpe.net

STATE OF CALIFORNIA  
No. C 28966  
SINCE 5-31-09

Job No.: **3832**

Sheet No.: **X5-E-0.2**

Released by:  
**CURTIS MCNALLY**

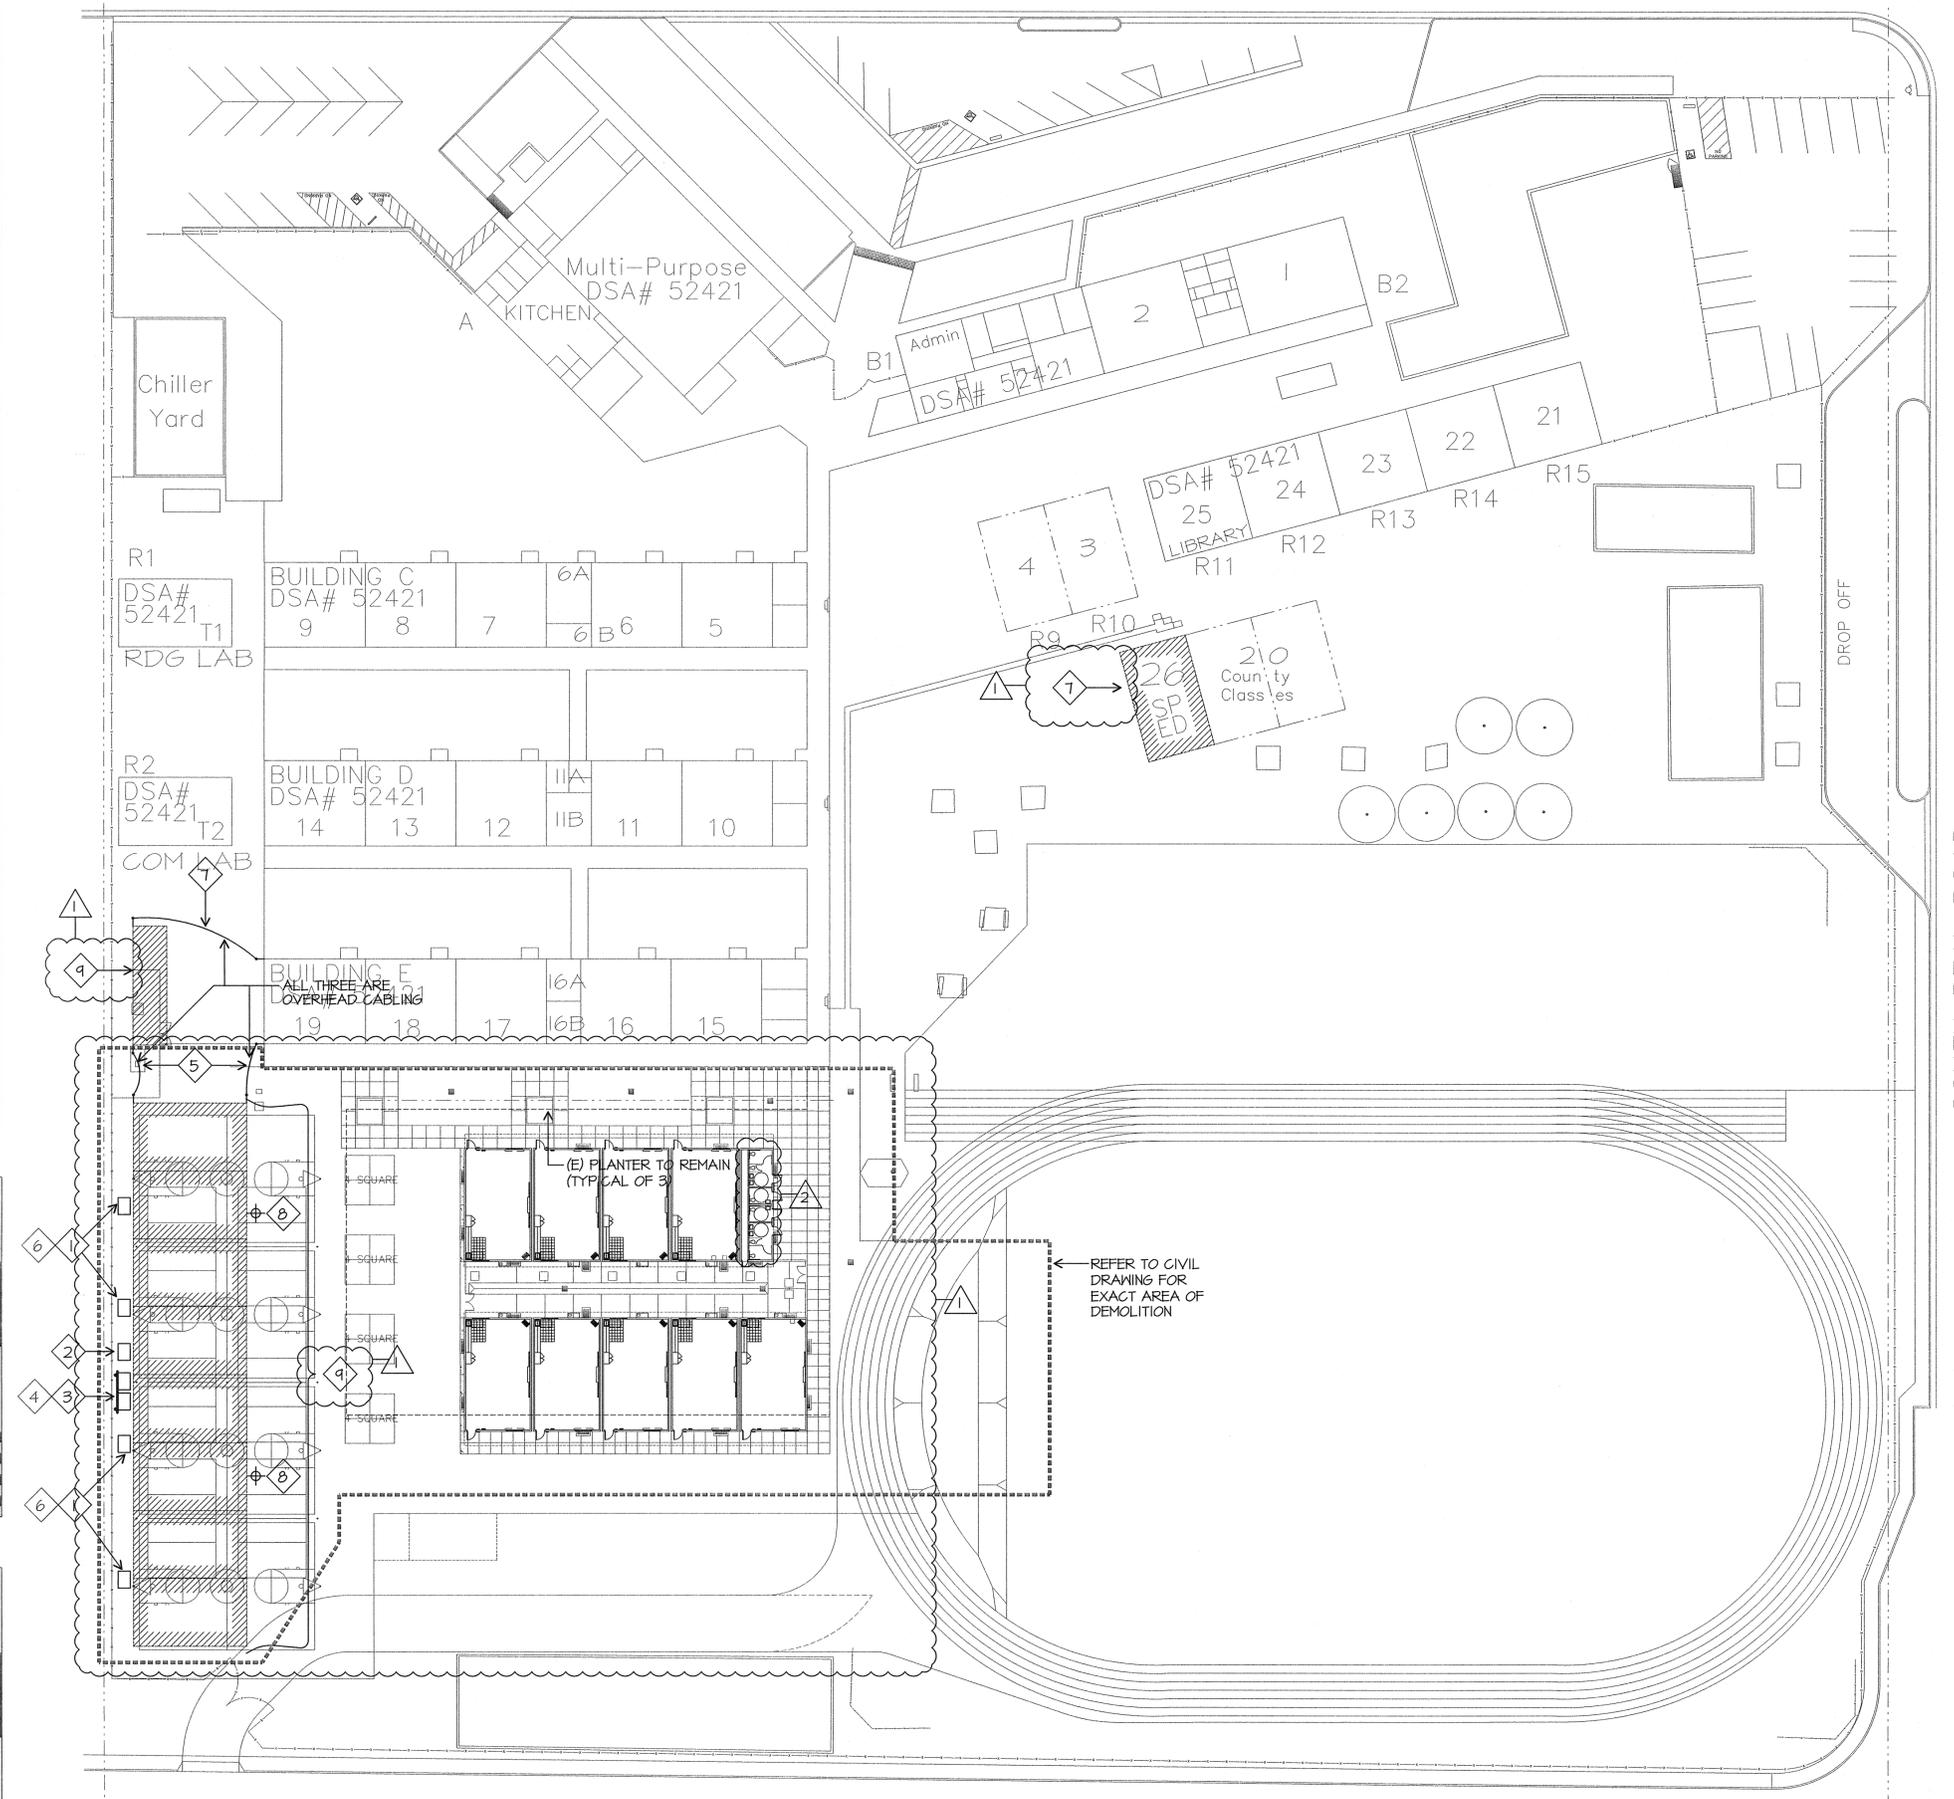

- DEMOLITION SITE ELECTRICAL PLAN NOTES**
- 1 REMOVE EXISTING CONDUCTORS FROM RELOCATED BUILDING PANELS AND CONDUITS BACK TO EXISTING CONCRETE PULL BOX.
  - 2 EXISTING CONCRETE PULL BOX TO REMAIN (N-36 PULL BOX.)
  - 3 DISCONNECT EXISTING FEEDER CONDUCTORS AND REMOVE FROM PANEL TO EXISTING CONCRETE PULL BOX. BACKBOARD AND PANELS TO REMAIN.
  - 4 AFTER PG&E HAS DISCONNECTED SERVICE AND REMOVED EXISTING METER, PROVIDE A BLANK METER SOCKET COVER.
  - 5 REMOVE EXISTING OVERHEAD CABLING FROM T4 TO T3 AND T4 TO ROOM 19. CUT CABLES AT T4 AND T3 AND REMOVE ANY RISER. CUT CABLES AT ROOM 19 AND WEATHER PROOF THE CABLE ENDS.
  - 6 REMOVE EXISTING ABOVE GROUND 12 X 12 X 4 NEMA 3R J-BOXES AND UNISTRUT SUPPORTS COMPLETELY. INSTALL (N) N-9 CONCRETE PULL BOXES OVER (E) CONDUITS. SET BOXES FLUSH TO EXISTING GRADE (TYPICAL).
  - 7 REMOVE EXISTING OVERHEAD SERVICE CONDUCTORS FROM T-3 BACK TO ROOM 19. REMOVE AT RISER ON ROOM 19 AND WEATHER PROOF THE CONDUCTOR ENDS. REMOVE RISER FROM PANEL ON T-3.
  - 8 REMOVE EXISTING RISER SUPPORTS AND EXTERIOR FLOOD LIGHTS.
  - 9 EXISTING BUILDING TO REMAIN UNTIL NEW BUILDINGS ARE COMPLETED.

DEMOLITION SITE ELECTRICAL PLAN

SCALE: 1"=30'-0"

JMPE/JOB#:04082/DATE:01-14-10 AC

Ownership of Documents  
 This document, the ideas and designs incorporated herein, as an instrument of Professional Service is the property of Integrated Designs by SOMAM Inc. and is not to be used, in whole or in part for any other project without written authorization.  
 © COPYRIGHT 2009

integrated designs by SOMAM, Inc.  
 ARCHITECTURE • ENGINEERING • INTERIOR DESIGN • CONSTRUCTION MANAGEMENT  
 6011 N. Fresno, Suite 130 - Fresno, California 93710  
 Phone (559) 436-0881 Fax (559) 436-0887 E-Mail: design@somam.com  
 www.integrateddesigns.com

Revision	Rev. Date	Rev. Description
1	10/15/09	ADDENDUM 1
2	01/22/10	CHANGE ORDER

Sheet Title: **DEMOLITION SITE ELECTRICAL PLAN**

Issue Date: 05/02/06  
 Designer: DR. DRAFTER  
 PC: CJM

Project Name & Address:  
**MUNSEY ELEMENTARY SCHOOL**  
**10 NEW PORTABLE CLASSROOMS**  
 BAKERSFIELD CITY SCHOOL DISTRICT  
 3801 BRAVE AVE. BAKERSFIELD, CA 93309


DSA Identification Stamp:  
 IDENTIFICATION STAMP  
 DIV. OF THE STATE ARCHITECT  
 03-112985  
 AC FLS SS  
 DATE 2/10/10

Stamp(s):  
 JMPE  
 LICENSED ARCHITECT  
 CURTIS E. FLEWELL  
 No. C 28966  
 REG. 5-31-09  
 STATE OF CALIFORNIA

Job No.: **3832**


Sheet No.: **X6-E-1**

Release: **CURTIS MCNALLY**

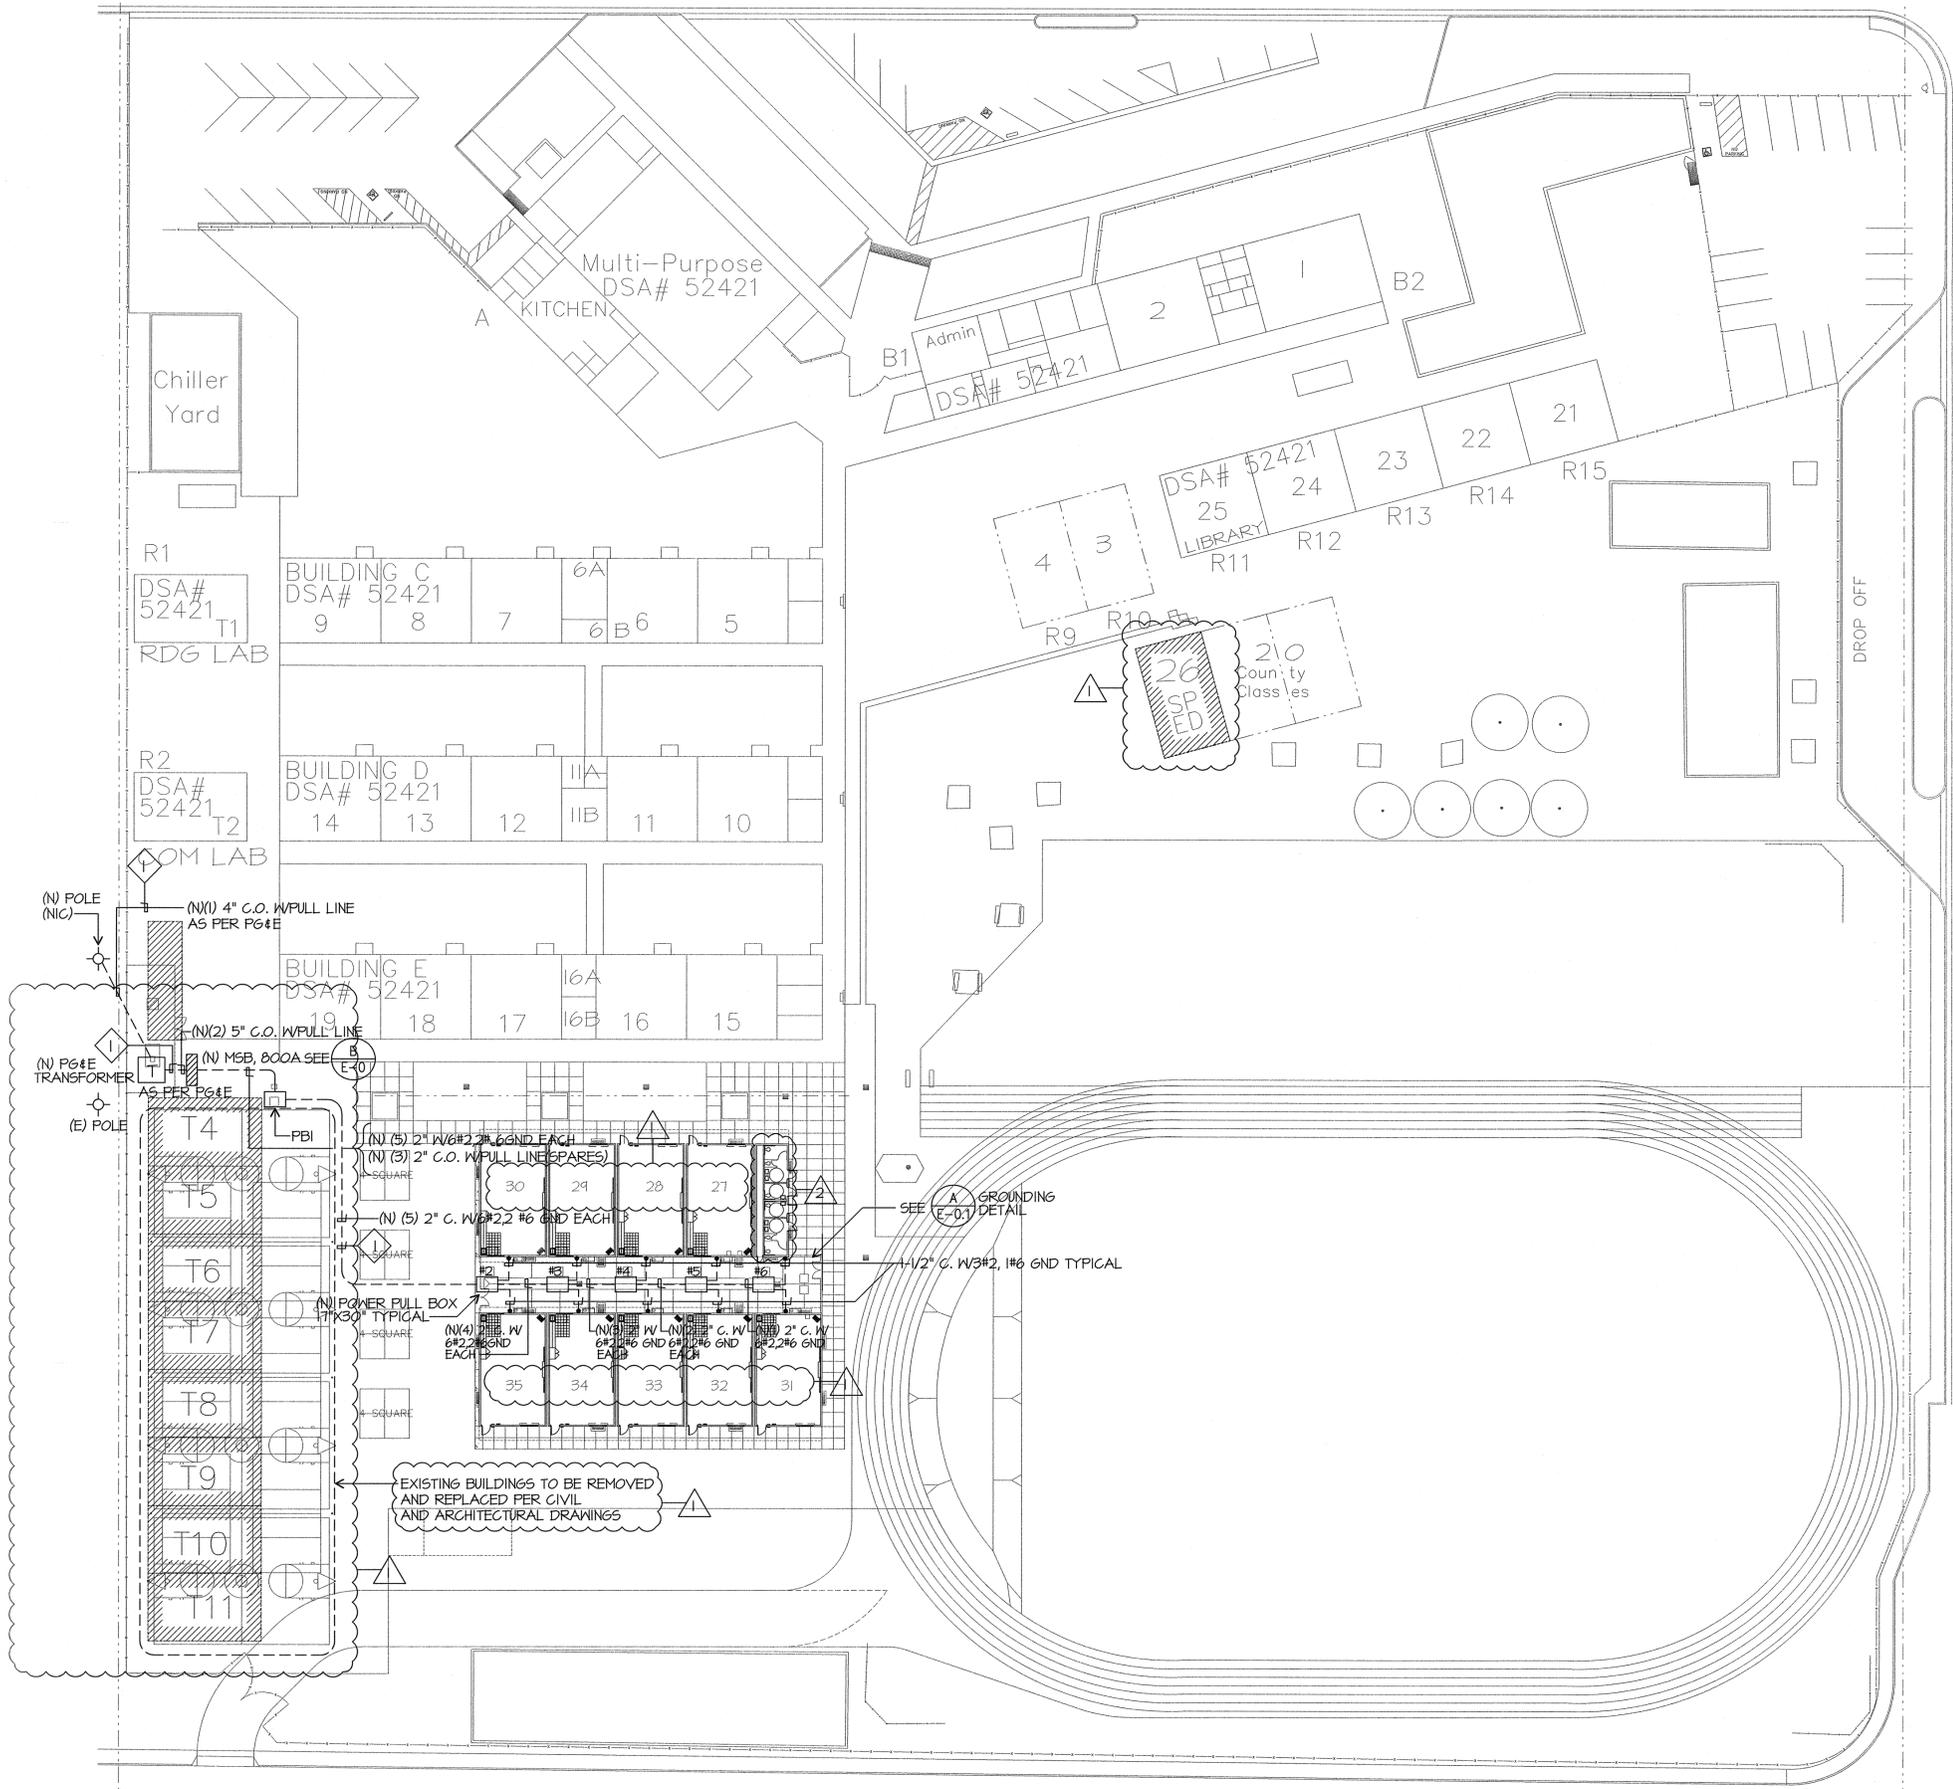

SITE ELECTRICAL PLAN

BELLE TERRACE

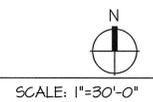

**ELECTRICAL SITE PLAN NOTES**

- 1 SAWCUT AND REPAIR TO MATCH EXISTING. BORING IS AN ACCEPTABLE METHOD OF CONDUIT INSTALLATION. PROVIDE METHOD OF PROCEDURE FOR BORING TO ENGINEER FOR REVIEW AND APPROVAL. DETAIL BORING PROCEDURE. IDENTIFY TYPE OF CONDUIT TO BE USED IN BORE.

Ownership of Documents  
 This document, the ideas and designs incorporated herein, as an instrument of Professional Service is the property of Integrated Designs by SOMAM, Inc. and is not to be used, in whole or in part for any other project without written authorization.  
 © COPYRIGHT 2009

**integrated designs** by SOMAM, Inc.  
 ARCHITECTURE • ENGINEERING • INTERIOR DESIGN • CONSTRUCTION MANAGEMENT  
 6011 N. Fresno, Suite 130 - Fresno, California 93710  
 Phone (559) 436-0887 Fax (559) 436-0887 E-Mail: design@somam.com  
 www.integrateddesigns.com

Revision	Rev. Date	Rev. Description
1	10/15/09	ADDENDUM 1
2	01/22/10	CHANGE ORDER

Sheet Title:  
**SITE ELECTRICAL PLAN**

Project Name & Address:  
**MUNSEY ELEMENTARY SCHOOLS**  
**10 NEW PORTABLE CLASSROOMS**  
 BAKERSFIELD CITY SCHOOL DISTRICT  
 3801 BRAVE AVE. BAKERSFIELD, CA 93309

Issue Date:	Date:	Designer:	DR:	DRAFTER:	FC:
05/02/06	05/02/06	DESIGNER	DR:	DRAFTER	CJM

DSA Identification Stamp:

Stamp(s):

Job No.: **3832**


Sheet No.: **X7-E-1.1**

Released by: CURTIS MCNALLY

**JMPE**  
 LICENSED ELECTRICAL ENGINEERING  
 LIGHTING DESIGN  
 CA REGISTRATION NO. E12003  
 09082

5000 KING AVENUE  
 SUITE 201  
 BAKERSFIELD, CA 93309  
 (805) 831-7961  
 FAX (805) 831-7913  
 email: madsen@jmpe.net  
 www.jmpe.net


**Professional Engineer**  
 CURTIS MCNALLY  
 LICENSED ELECTRICAL ENGINEER  
 STATE OF CALIFORNIA

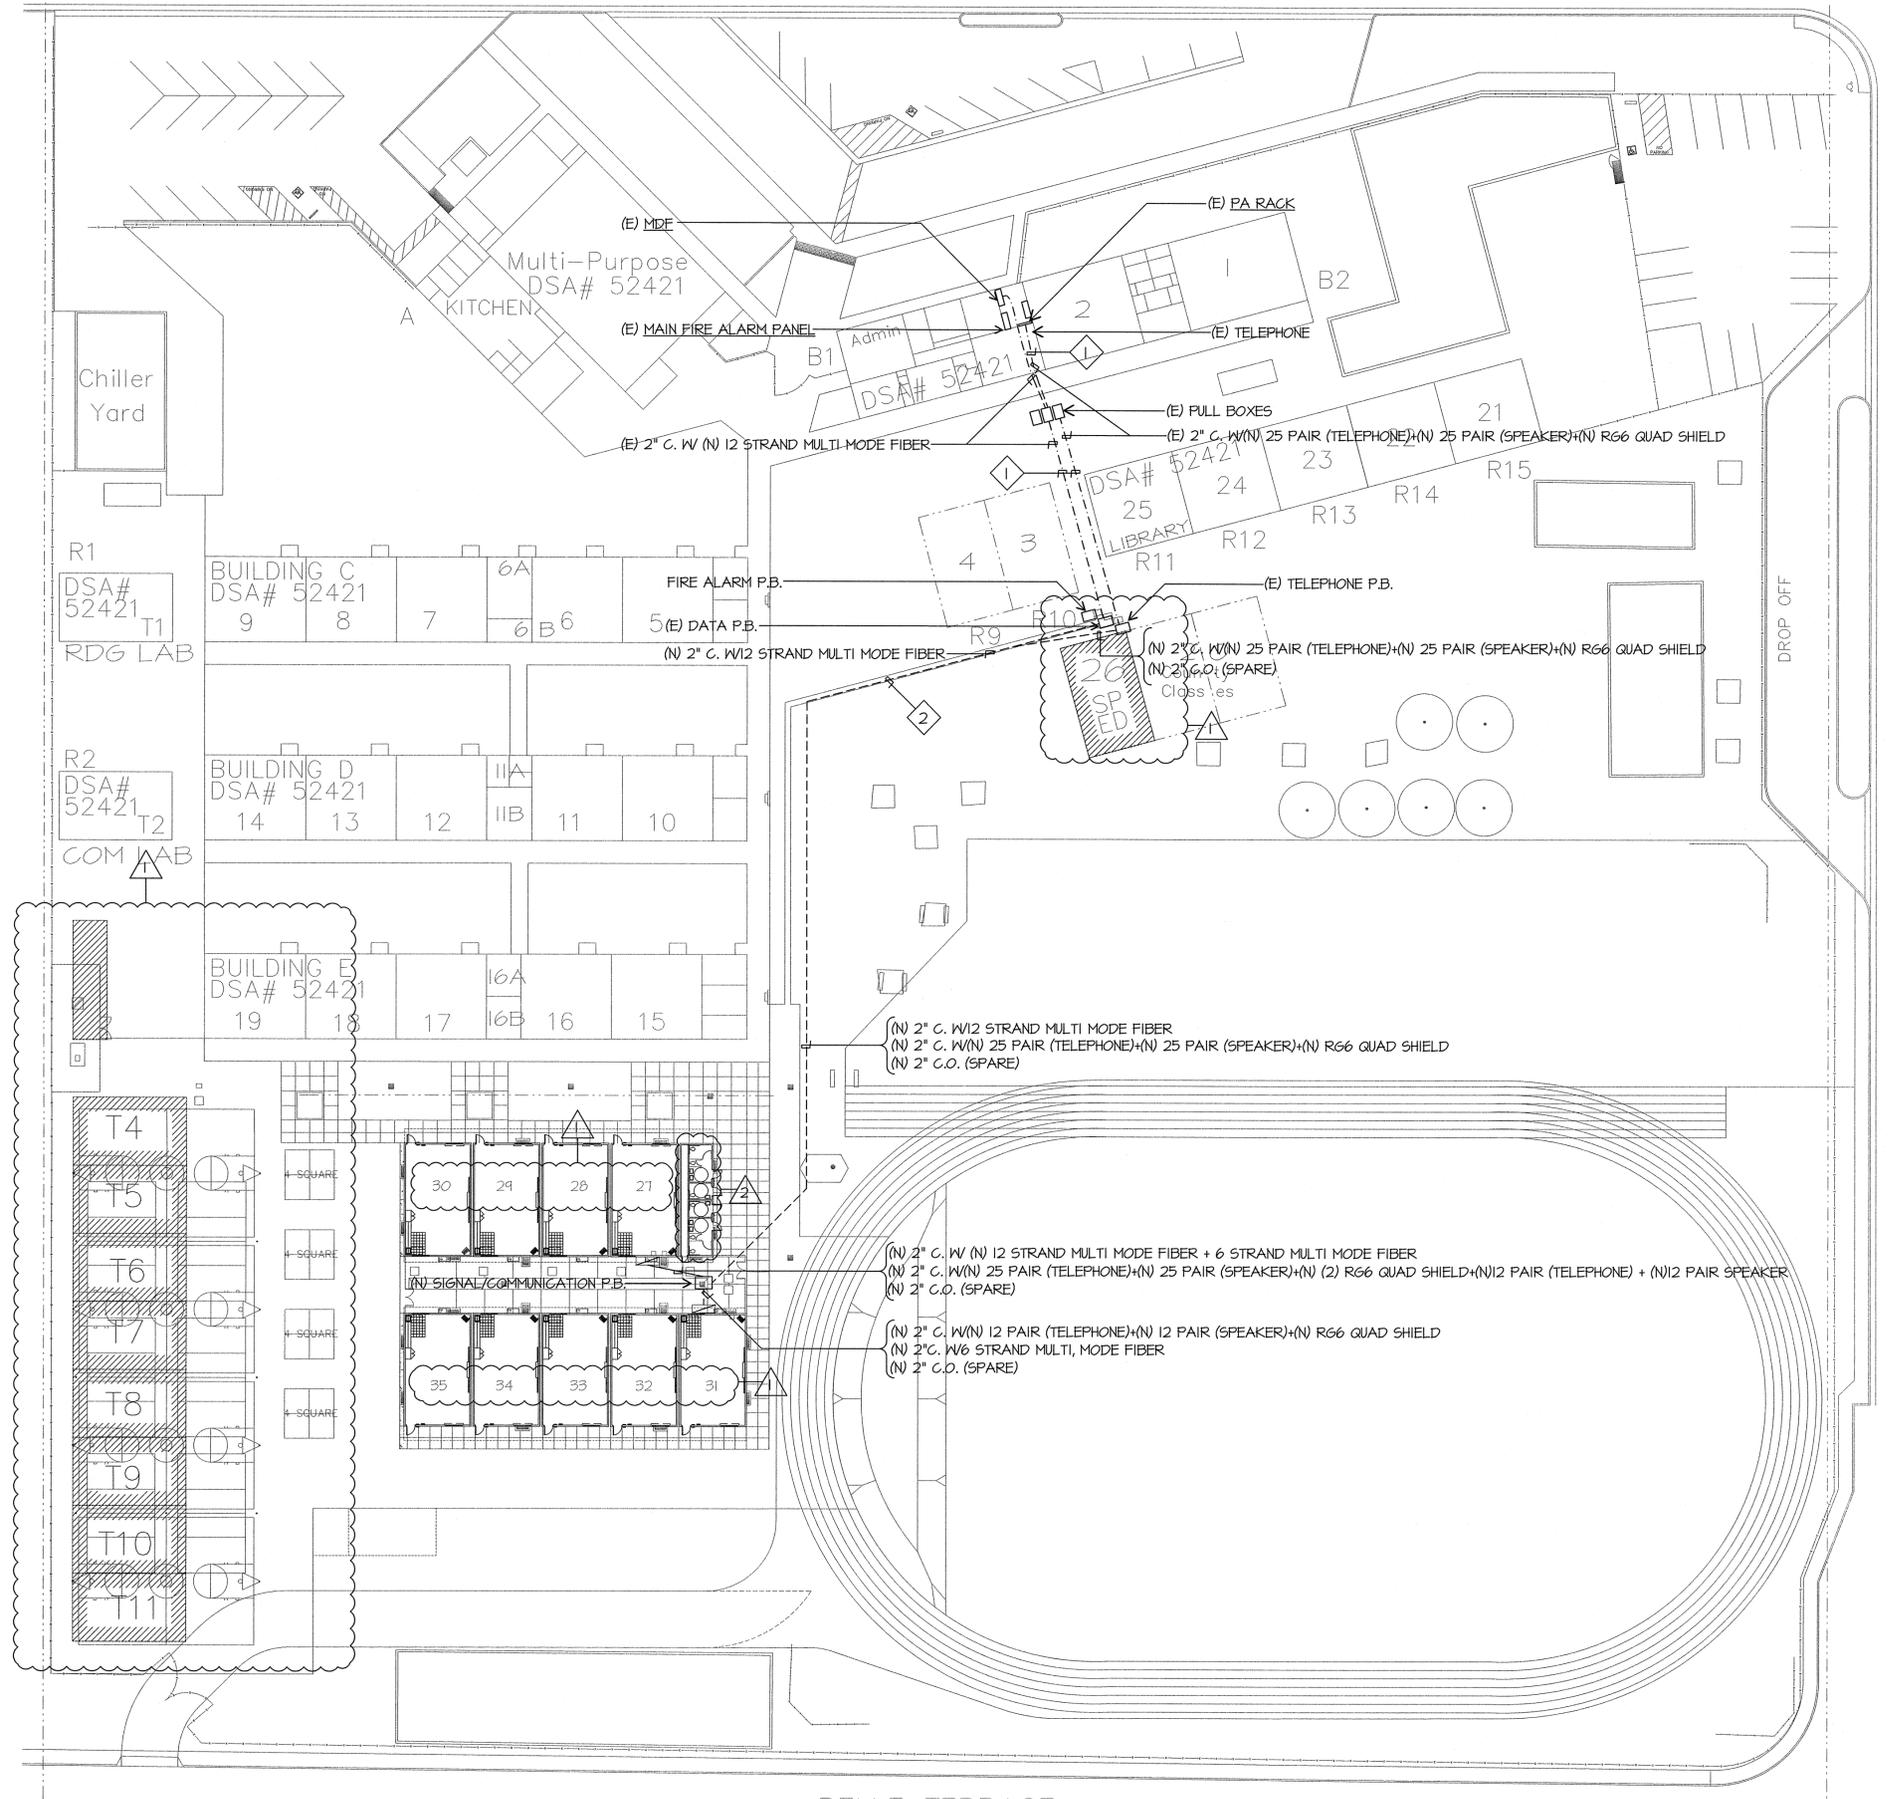

**SITE COMMUNICATION PLAN NOTES**

- 1 PULL NEW CABLES IN EXISTING CONDUIT. PULL PAST EXISTING CABLES.
- 2 SAWCUT AND REPAIR TO MATCH EXISTING. BORING IS AN ACCEPTABLE METHOD OF CONDUIT INSTALLATION. PROVIDE METHOD OF PROCEDURE FOR BORING TO ENGINEER FOR REVIEW AND APPROVAL. DETAIL BORING PROCEDURE. IDENTIFY TYPE OF CONDUIT TO BE USED IN BORE.

**SITE COMMUNICATION PLAN**

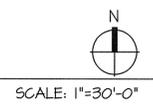

Ownership of Documents  
 This document, the ideas and designs incorporated herein, as an instrument of Professional Service is the property of Integrated Designs by SOMAM, Inc. and is not to be used, in whole or in part for any other project without written authorization. © COPYRIGHT 2009

Integrated Designs by SOMAM, Inc.  
 ARCHITECTURE • ENGINEERING • INTERIOR DESIGN • CONSTRUCTION MANAGEMENT  
 6011 N. Fresno, Suite 130 - Fresno, California 93710  
 Phone (559) 436-0887 Fax (559) 436-0887 E-Mail: design@somam.com  
 www.integrateddesigns.com

Rev. No.	Rev. Date	Rev. Description
1	10/15/09	ADDENDUM 1
2	01/22/10	CHANGE ORDER

Revision:  
 Addendum:  
 Change Order:

Issue Date:  
 Date: 05/02/06  
 Designer:  
 DR: DRAFTER  
 FC: C.J.M.


Sheet Title:  
**SITE COMMUNICATION PLAN**  
 Project Name & Address:  
**MUNSEY ELEMENTARY SCHOOL**  
**10 NEW PORTABLE CLASSROOMS**  
 BAKERSFIELD CITY SCHOOL DISTRICT  
 3801 BRAVE AVE. BAKERSFIELD, CA 93309

DSA Identification Stamp:  
 DIV. OF THE STATE ARCHITECT  
 02-113985  
 AC: PLS  
 DATE: 5/1/06

Stamp(s):


Job No.: **3832**  
 Sheet No.: **X8-E-2**

Release:  
 JMPE/JOB#:04082/DATE:01-14-10 AC  
 CURTIS MCNALLY

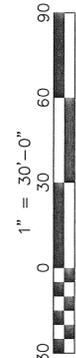


**COMMUNICATION PLAN NOTES**

- 1 CONNECT TO SPARE 20/1 CIRCUIT BREAKER IN PANEL PROVIDED WITH CLASSROOM.
- 2 PROVIDE (1) RE4 EQUIPMENT CABINETS WITH (1) 48 PORT PATCH PANEL, AMO BCSD CONNECTORS, BY HUBBELL COMPANY. COORDINATE WITH GARY TAYLOR, NETWORK SYSTEMS ENGINEER FOR BAKERSFIELD CITY SCHOOL DISTRICT, 661-631-4745.
- 3 SUPPORT CABLE EVERY 5' VIA J-HOOKS, INSTALLED AT LEAST 8" ABOVE CEILING ON PERIMETER WALLS, TYPICAL.
- 4 ADD RECEPTACLE NEXT TO (N) IDF. PROVIDE 20/1 CIRCUIT BREAKER FROM PANEL PROVIDED WITH PORTABLE. PROVIDE MATERIALS NEEDED FOR DEDICATED CIRCUIT TO BE USED FOR INTRUSION POWER SUPPLY. COORDINATE REQUIREMENTS WITH BAKERSFIELD CITY SCHOOL VENDOR MORGAN CLAYTON, 661-397-5511.

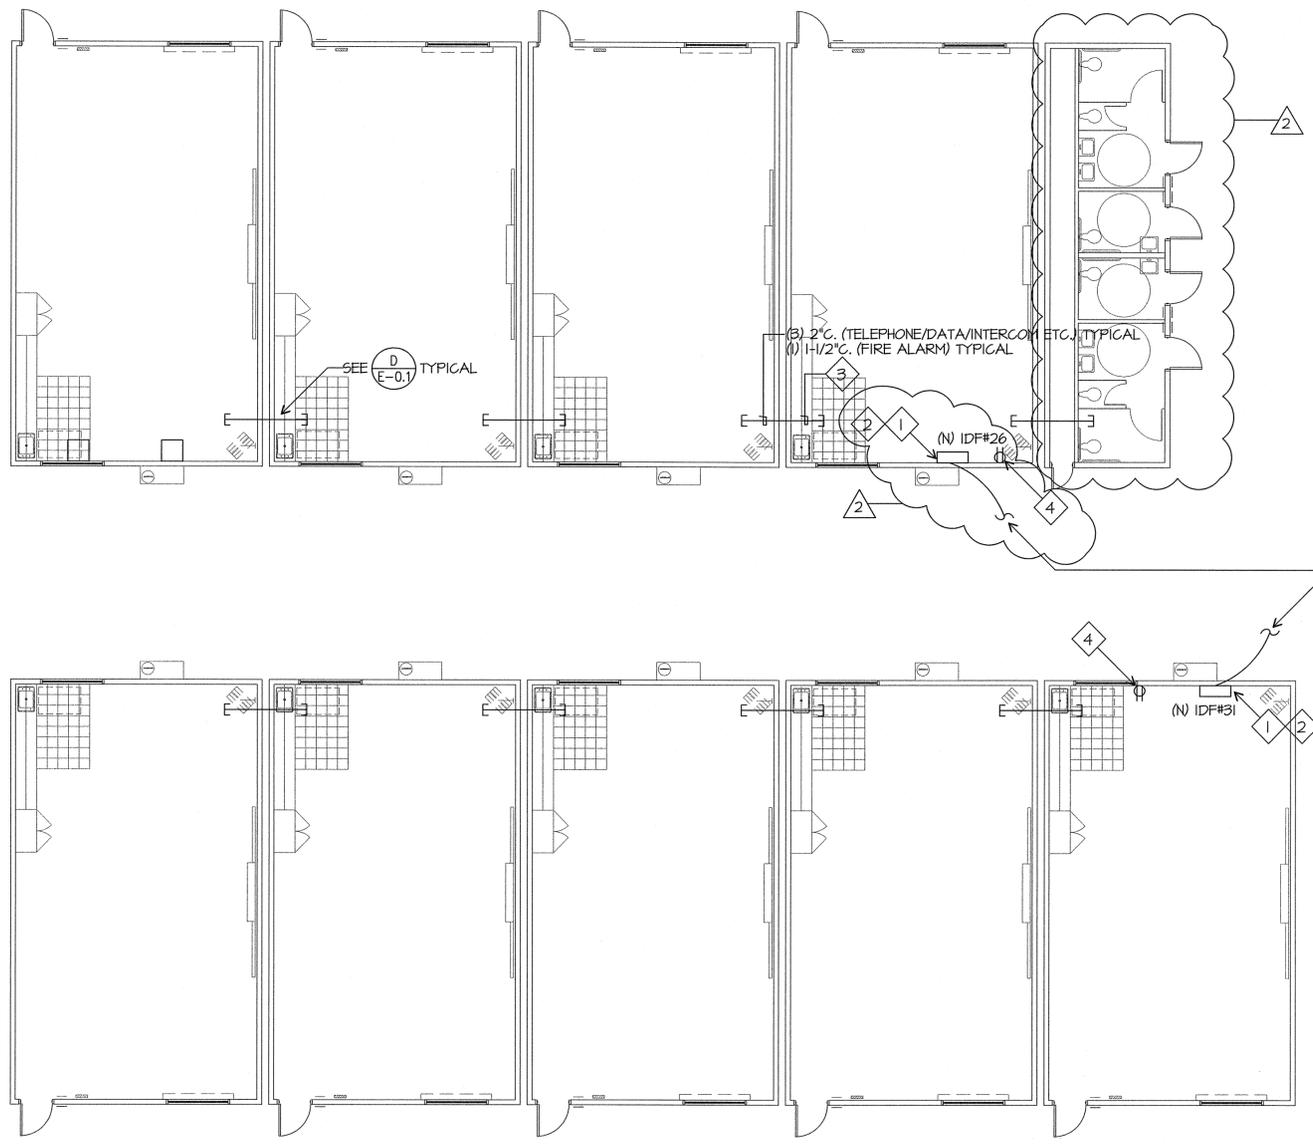

SEE SHEET E-2 FOR CONTINUATION

**COMMUNICATION PLAN**

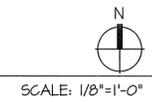

**Ownership of Documents**  
 This document, the ideas and designs incorporated herein, as an instrument of Professional Service is the property of Integrated Designs by SOMAM Inc. and is not to be used, in whole or in part for any other project without written authorization. © COPYRIGHT 2009

**integrated designs** by SOMAM, Inc.  
 ARCHITECTURE • ENGINEERING • INTERIOR DESIGN • CONSTRUCTION MANAGEMENT  
 6011 N. Fresno, Suite 130 - Fresno, California 93710  
 Phone (559) 436-0887 Fax (559) 436-0887 E-Mail: design@somam.com  
 www.integrateddesigns.com

Revision	Rev. Date	Revision Description
1	10/15/09	CHANGE ORDER
2	01/22/10	

**COMMUNICATION PLAN**

Project Name & Address:  
**MUNSEY ELEMENTARY SCHOOL**  
**10 NEW PORTABLE CLASSROOMS**  
 BAKERSFIELD CITY SCHOOL DISTRICT  
 3801 BRAVE AVE. BAKERSFIELD, CA 93309

Issue Date:	Date:	05/02/06
Designer:	DR:	DESIGNER
DRAFTER:	FC:	DRAFTER
CJM		

DSA Identification Stamp:

IDENTIFICATION STAMP  
 DIV. OF THE STATE ARCHITECT  
 CS-112985  
 AC FLS  
 DATE 2/10/10

Stamp(s):

**JMPE**  
 LICENSED ARCHITECT  
 CURTIS E. FLYNN  
 No. C 28966  
 REG. 5-31-09  
 STATE OF CALIFORNIA

Job No.: **3832**

Sheet No.: **X9-E-2.1**


Release: CURTIS MCNALLY

**JMPE**  
 LICENSED PROFESSIONAL ELECTRICAL ENGINEER  
 MALCOLM J. MURPHY  
 6600 KING AVENUE,  
 SUITE 200  
 BAKERSFIELD, CA 93309  
 (805) 831-7901  
 FAX (805) 831-7913  
 email: malmoj@jmpe.net  
 www.jmpe.net



**SITE FIRE ALARM PLAN NOTES**

- 1 PULL NEW CABLES IN EXISTING CONDUIT. PULL PAST EXISTING CABLES.
- 2 SAWCUT AND REPAIR TO MATCH EXISTING. BORING IS AN ACCEPTABLE METHOD OF CONDUIT INSTALLATION. PROVIDE METHOD OF PROCEDURE FOR BORING TO ENGINEER FOR REVIEW AND APPROVAL. DETAIL BORING PROCEDURE. IDENTIFY TYPE OF CONDUIT TO BE USED IN BORE.

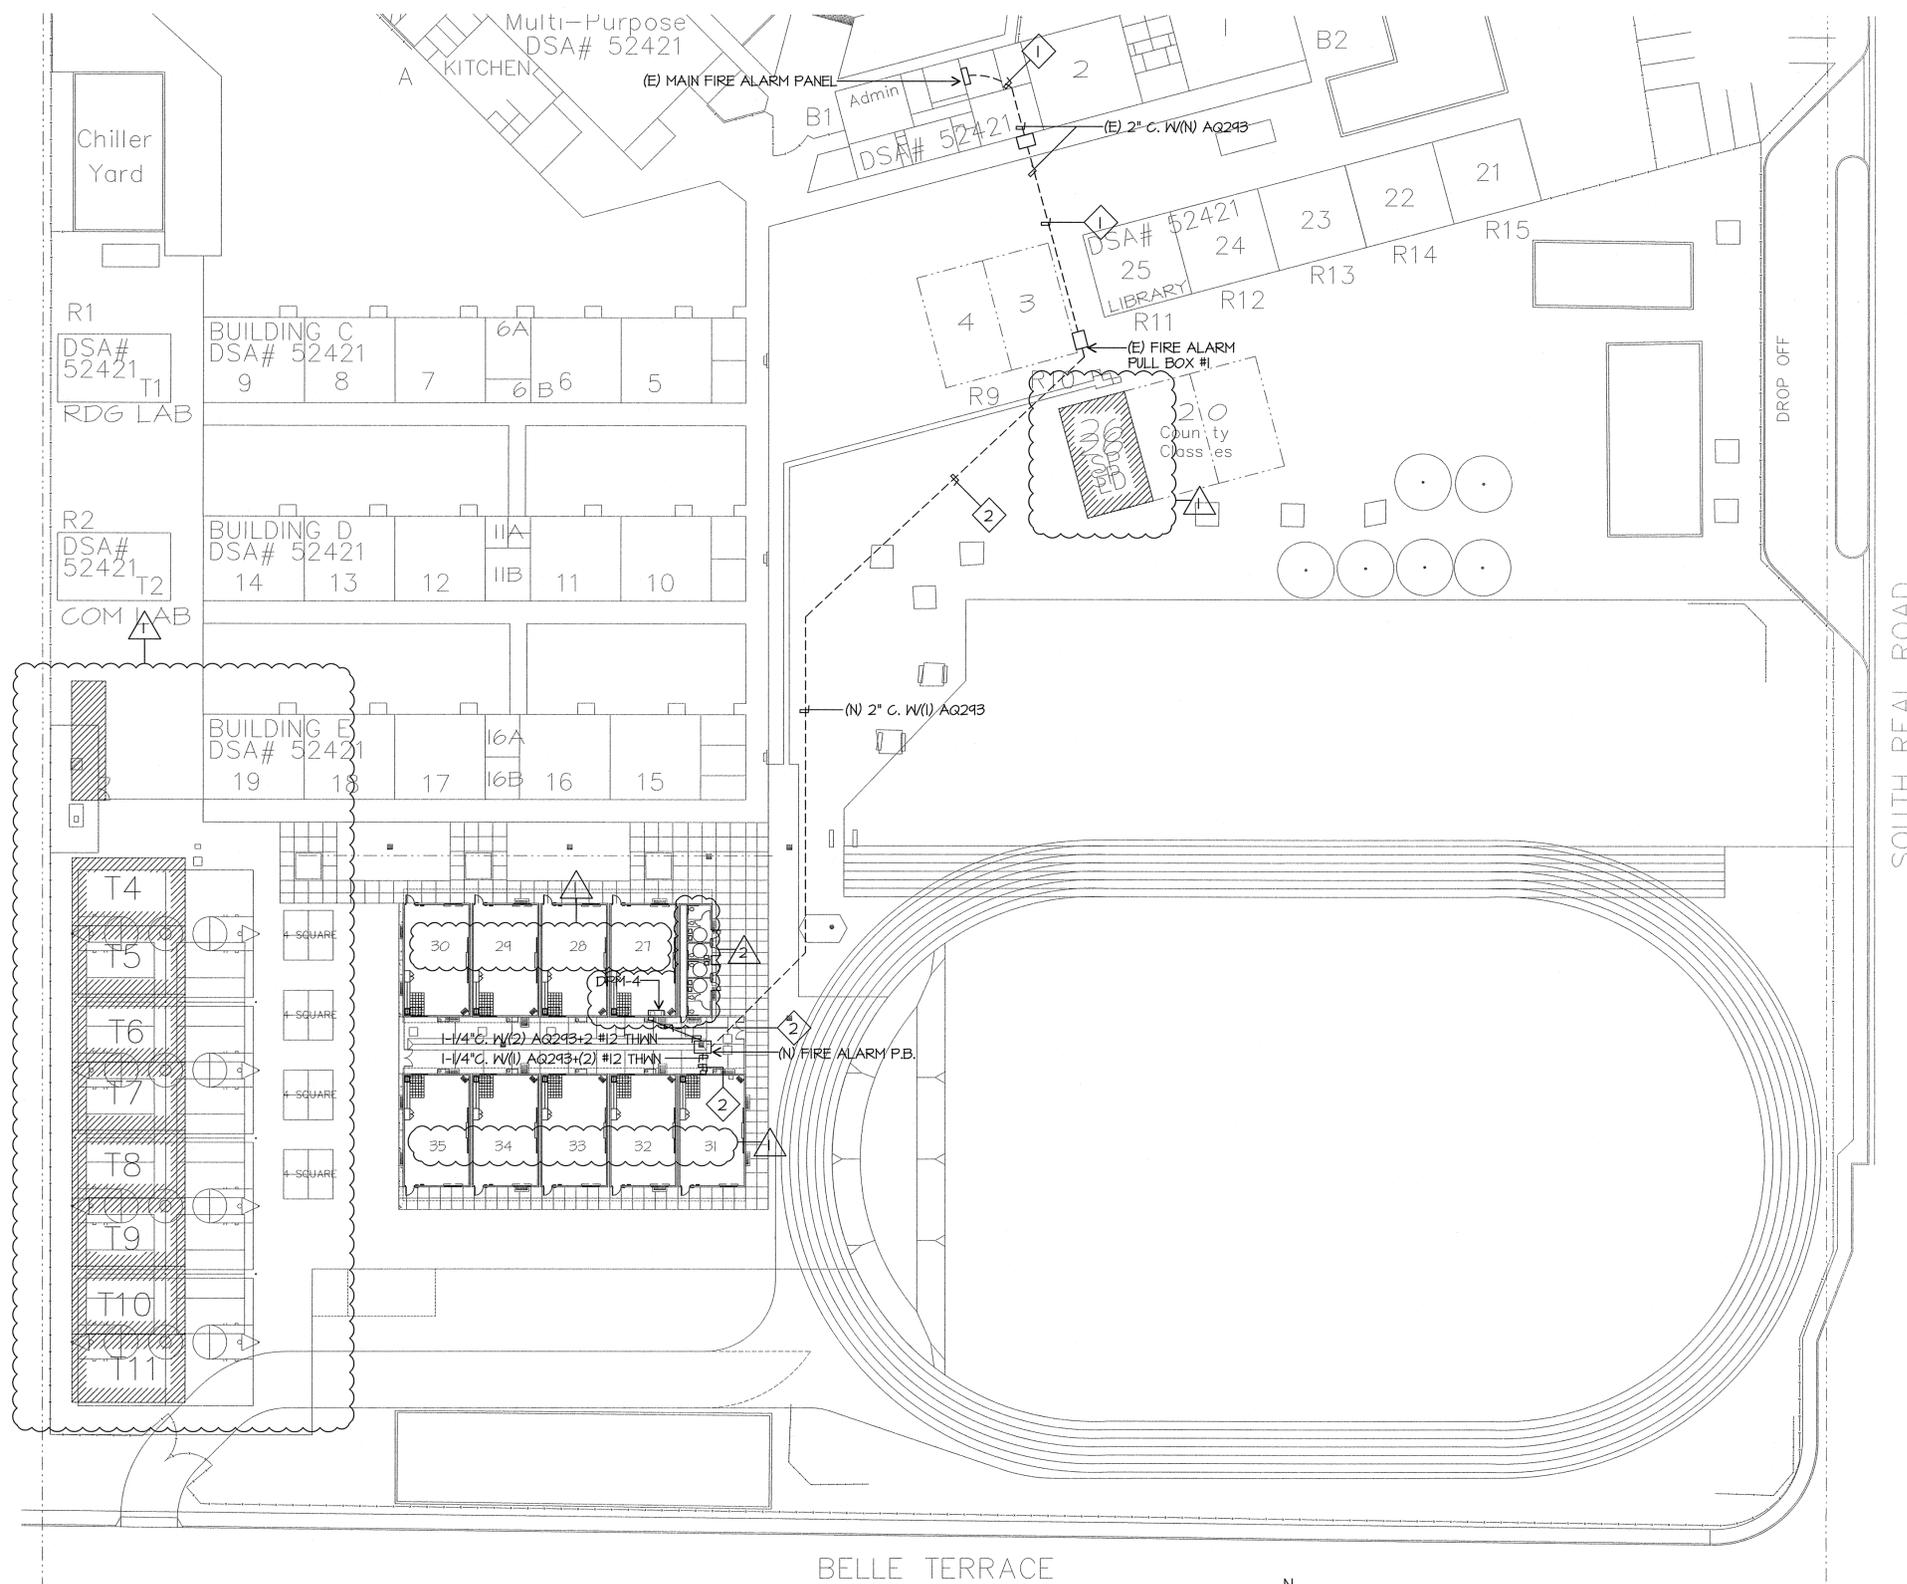

**SITE FIRE ALARM PLAN**

SCALE: 1"=30'-0"

JMPE/JOB#:04082/DATE:01-14-10 AC

Ownership of Documents  
This document, the ideas and designs incorporated herein, as an instrument of Professional Service is the property of Integrated Designs by SOMAM, Inc. and is not to be used, in whole or in part for any other project without written authorization.  
© COPYRIGHT 2009

**integrated designs** by SOMAM, Inc.  
ARCHITECTURE • INTERIOR DESIGN • CONSTRUCTION MANAGEMENT  
6011 N. Fresno, Suite 130 - Fresno, California 93710  
Phone (559) 435-0881 Fax (559) 435-0887 E-Mail: design@somam.com  
www.integrateddesigns.com

**SITE FIRE ALARM PLAN**  
**MUNSEY ELEMENTARY SCHOOL**  
**10 NEW PORTABLE CLASSROOMS**  
BAKERSFIELD CITY SCHOOL DISTRICT  
3801 BRAVE AVE. BAKERSFIELD, CA 93309

Issue Date:	Date:	05/02/06
Designer:	DESIGNER	
DR:	DRAFTER	
PC:	CJM	

DSA Identification Stamp:

IDENTIFICATION STAMP  
DIV. OF THE STATE ARCHITECT  
03-112985  
AC: [Signature] PLS: [Signature] DATE: [Signature]


Stamp(s):

**JMPE**  
LICENSED ARCHITECT  
ELECTRICAL ENGINEERING  
LIGHTING DESIGN  
CA REGISTRATION NO. E13063  
04082  
6600 KING AVENUE,  
SUITE 201  
BAKERSFIELD, CA 93309  
(805) 881-7901  
FAX (805) 831-7913  
email: maloney@jmpe.net  
www.jmpe.net

**CURTIS E. FLYNN**  
REGISTERED ARCHITECT  
No. C 28966  
REV. 5-31-09  
STATE OF CALIFORNIA


Job No.: **3832**  
Sheet No.: **X10-E-3**

Release: CURTIS MCNALLY

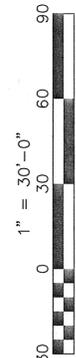


**FIRE ALARM PLAN NOTES**

- 1 FIRE ALARM CABLE SHALL BE INSTALLED IN 3/4" CONDUIT IN WALLS, TYPICAL.
- 2 SUPPORT FIRE ALARM CABLE EVERY 5' VIA J-HOOKS INSTALLED AT LEAST 8" ABOVE CEILING ON PERIMETER WALLS, TYPICAL.
- 3 PROVIDE 20/1 CIRCUIT BREAKER PER NFPA 72 FOR DPM.

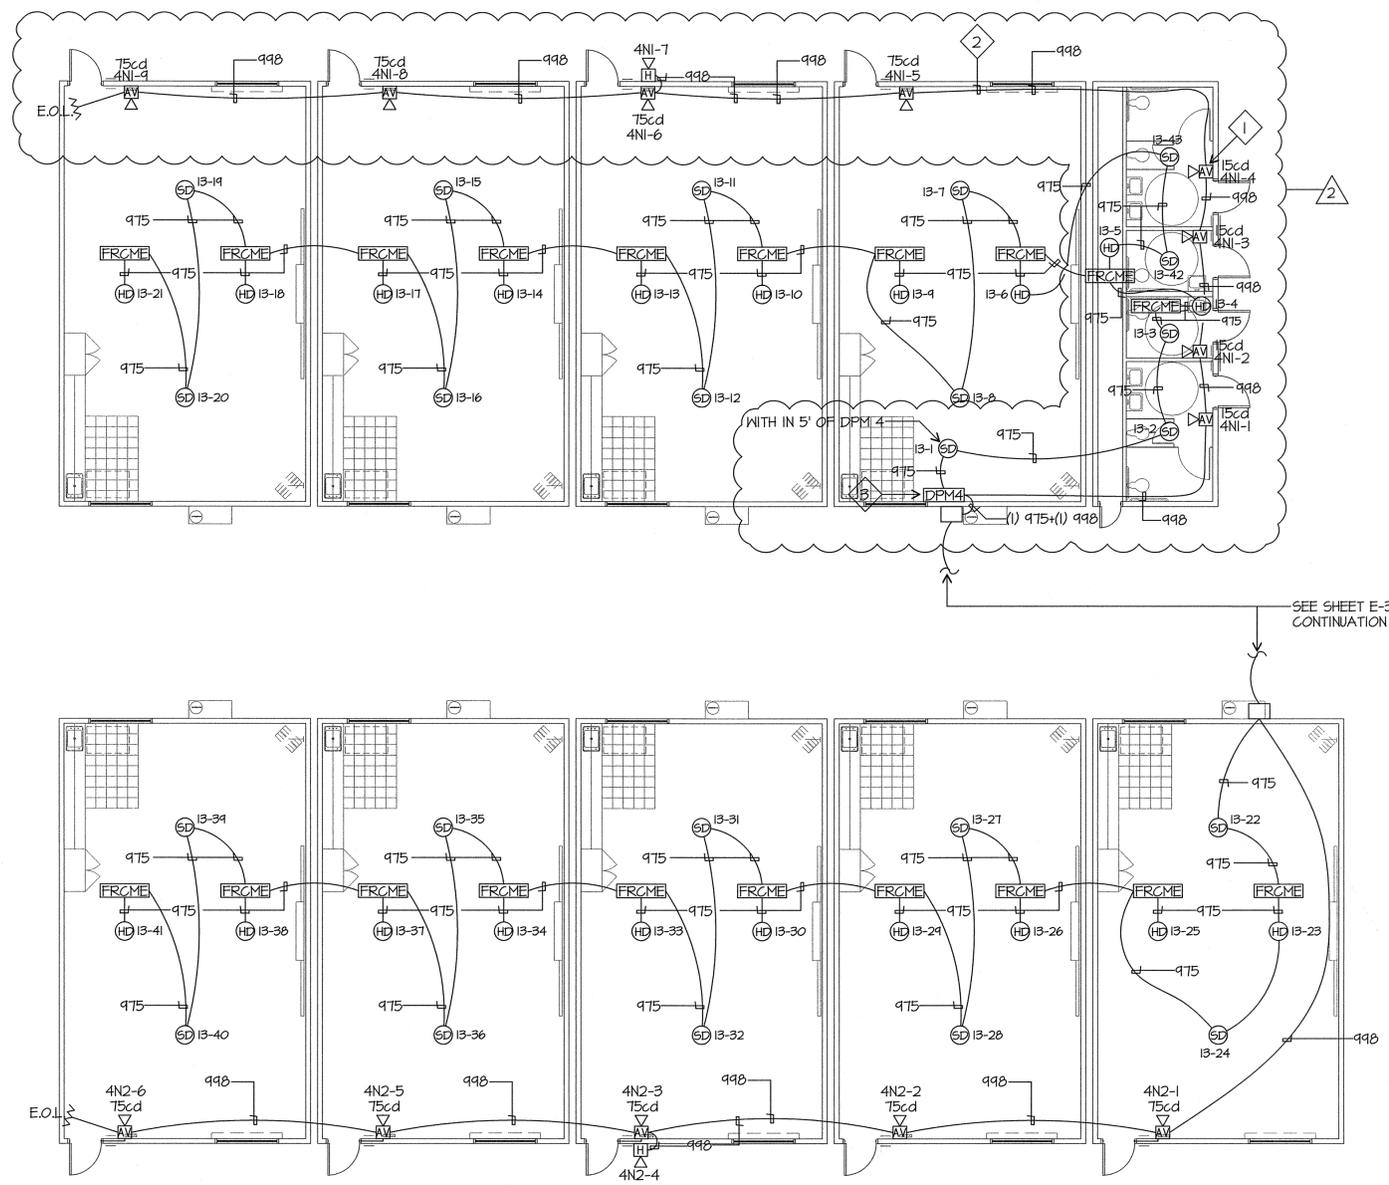

**FIRE ALARM PLAN**

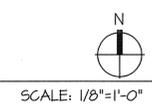


Ownership of Documents  
This document, the ideas and designs incorporated herein, as an instrument of Professional Service is the property of Integrated Designs by SOMAM Inc. and is not to be used, in whole or in part for any other project without written authorization.  
© COPYRIGHT 2009

**integrated designs** by SOMAM, Inc.  
ARCHITECTURE • INTERIOR DESIGN • CONSTRUCTION MANAGEMENT  
8011 N. Fresno, Suite 130 - Fresno, California 93710  
Phone (559) 335-0881 Fax (559) 335-0887 E-Mail: design@somam.com  
www.integrateddesigns.com

Revision	Revision Description	Rev. Date	Rev. Date
1	CHANGE ORDER	01/22/10	

**FIRE ALARM PLAN**  
Project Name & Address:  
**MUNSEY ELEMENTARY SCHOOLS**  
10 NEW PORTABLE CLASSROOMS  
BAKERSFIELD CITY SCHOOL DISTRICT  
3801 BRAVE AVE. BAKERSFIELD, CA 93309




Issue Date:	Date:	05/02/06
Designer:	DR:	DESIGNER
DRAFTER:	FC:	CJM

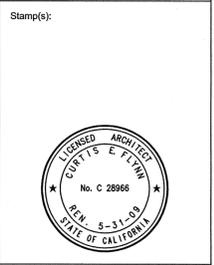


Job No.: **3832**  
Sheet No.: **XII-E-3.1**

**JMPE**  
LICENSED PROFESSIONAL ENGINEER  
ELECTRICAL ENGINEERING  
LIGHTING DESIGN  
CA REGISTRATION NO. ELS0483  
04082

5000 MENO AVENUE,  
SUITE 202  
BAKERSFIELD, CA 93309  
(805) 833-7861  
FAX (805) 831-7913  
EMAIL: jmcnally@jmpe.net  
WWW.JMPE.NET

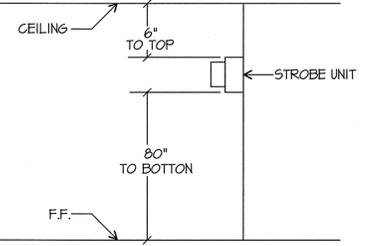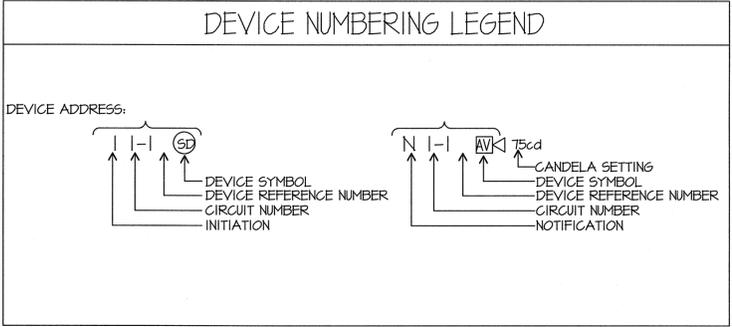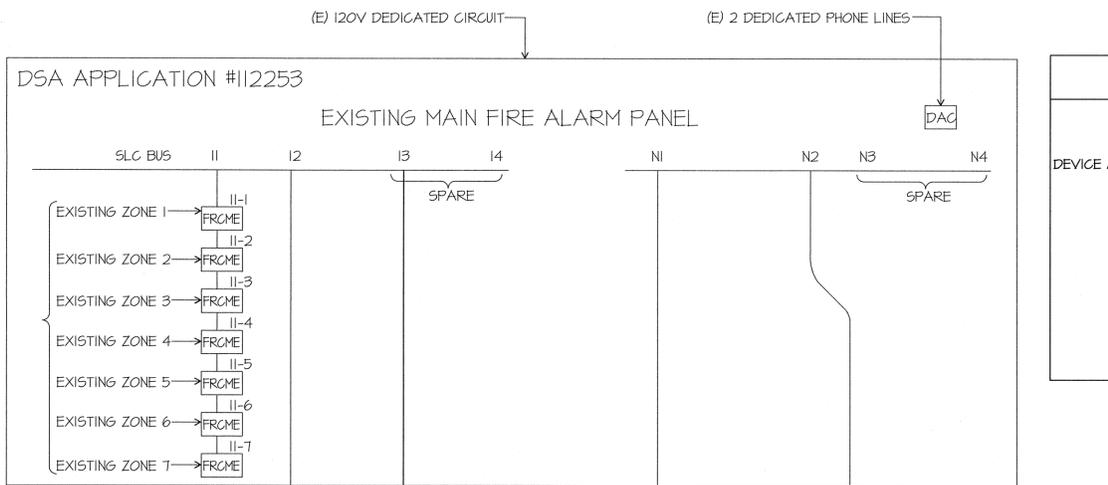

HORN/STROBE MOUNTING DETAIL  
SCALE: NONE

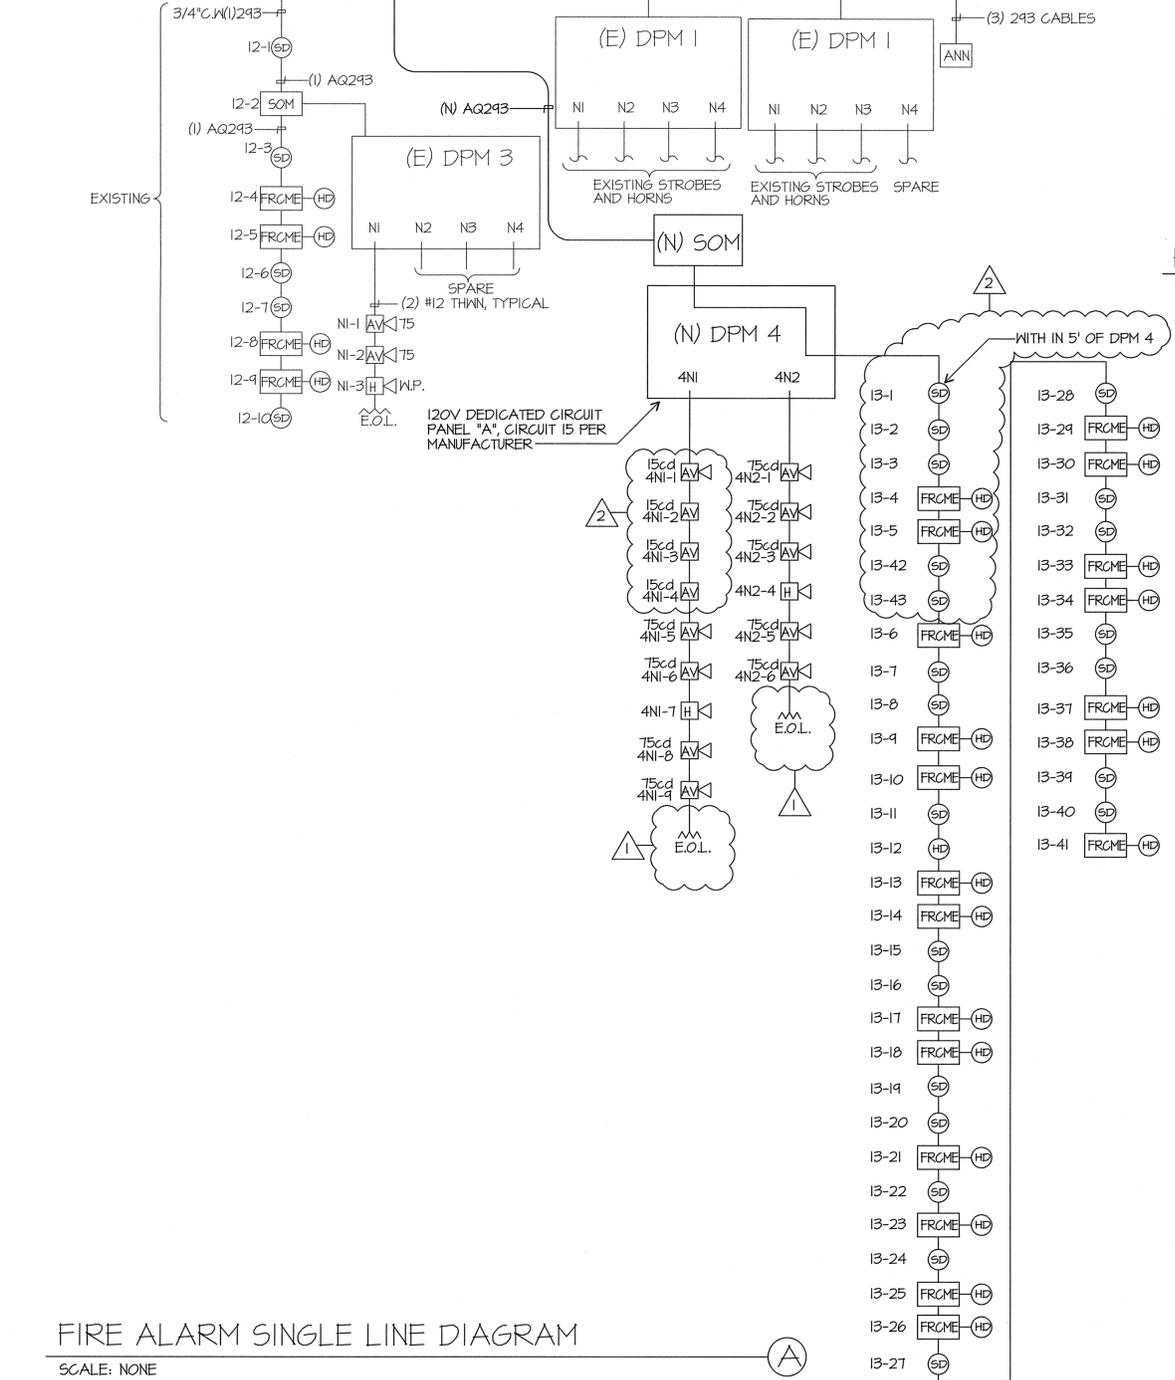

CONTRACTOR SHALL DISCONNECT AND RECONNECT ALL ZONES ASSOCIATED WITH EXISTING BUILDINGS ON CAMPUS AND PROVIDE TESTING FOR POSITIVE REPORTING. PROVIDE FIRE WATCH DURING IMPAIRMENT OF SYSTEM, PER NFPA & CFC (CHAPTER 14 + 9)

EQUIPMENT DESCRIPTION	QUANTITY		SUPERVISORY CURRENT (AMPERES)		ALARM CURRENT (AMPERES)	
	EXISTING	NEW	EACH	SUB-TOTAL	EACH	SUB-TOTAL
MASTER PANEL	1		0.1	0.1	0.1	0.1
REMOTE ANNUNCIATOR PANEL	1		0.15	0.15	0.27	0.27
SUPERVISED OUTPUT MODULE	3	1	0.0003	0.0012	0.0003	0.0012
FAST RESPONSE CONTACT MODULE	11	20	0.00055	0.01705	0.008	0.248
DIGITAL ALARM COMMUNICATOR	1		0.02	0.02	0.02	0.02
SMOKE DETECTOR	21		0.00039	0.00936	0.00039	0.00936
HEAT DETECTOR	20		0.00035	0.007	0.00035	0.007
<b>SUB TOTAL AMPERES</b>				<b>0.30601 AMPS</b>		<b>0.6596 AMPS</b>
<b>SUB TOTAL AMPERE-HOURS</b>				<b>x 24 HOURS</b>		<b>x 0.084 HOURS</b>
				<b>7.34424 A.H.</b>		<b>0.055185 A.H.</b>
<b>TOTAL REQUIRED AMPERE-HOURS FOR DISTRIBUTED POWER MODULE</b>						<b>7.399425 A.H.</b>
<b>BATTERY NON-LINEAR DISCHARGE CHARACTERISTIC FACTOR</b>						<b>x 1.2</b>
<b>TOTAL MINIMUM AMPERE HOURS REQUIRED</b>						<b>8.87931 A.H.</b>
<b>EXISTING BATTERY CAPACITY</b>						<b>24.00 A.H.</b>

EQUIPMENT DESCRIPTION	QUANTITY		SUPERVISORY CURRENT (AMPERES)		ALARM CURRENT (AMPERES)	
	EXISTING	NEW	EACH	SUB-TOTAL	EACH	SUB-TOTAL
DISTRIBUTED POWER MODULE		1	0.075	0.075	0.175	0.175
AUDIBLE/VISUALS	75 cd	10		0	0.121	1.21
HORN EXTERIOR		2		0	0.062	0.124
AUDIBLE/VISUALS	15 cd	4		0	0.052	0.208
<b>SUB TOTAL AMPERES</b>				<b>0.075 AMPS</b>		<b>1.717 AMPS</b>
<b>SUB TOTAL AMPERE-HOURS</b>				<b>x 24 HOURS</b>		<b>x 0.084 HOURS</b>
				<b>1.8 A.H.</b>		<b>0.144228 A.H.</b>
<b>TOTAL REQUIRED AMPERE-HOURS FOR DISTRIBUTED POWER MODULE</b>						<b>1.944228 A.H.</b>
<b>BATTERY NON-LINEAR DISCHARGE CHARACTERISTIC FACTOR</b>						<b>x 1.2</b>
<b>TOTAL MINIMUM AMPERE HOURS REQUIRED</b>						<b>2.333074 A.H.</b>
<b>PROVIDED BATTERY CAPACITY</b>						<b>7.90 A.H.</b>

SYMBOL	DEVICE	MFR & CAT#	REMARKS	CSFM LISTING
DPM	NAC POWER EXTENDER	HOCHIKI FN-642-ULADA		7315-0410:166
SD	SMOKE DETECTOR	HOCHIKI ALG-V	WITH HSB-NSA-6 BASE	7272-0410:149
HD	HEAT DETECTOR	HOCHIKI DFE-190	WITH NS6-100 BASE	7270-0410:119
FRCME	FAST RESPONSE CONTACT MODULE	HOCHIKI DCP-FRCME		7300-0410:150
SOM	SUPERVISED OUTPUT MODULE	HOCHIKI SOM		7300-0410:150
AV	HORN STROBE	WHEELLOCK AS24MCW 90dBA		7125-0785:131
H W.P.	HORN	WHEELLOCK ASWP 99dBA	EXTERIOR W.P. HORN	7125-0785:131

	INITIATION	AREA SMOKE DETECTOR	AREA THERMAL DETECTOR	AC POWER FAILURE
<b>RESPONSE</b>				
ANNUNCIATE AT FIRE CONTROL ROOM		YES	YES	YES (TROUBLE)
ANNUNCIATE AT 24 HOUR ATTEND LOCATION		YES	YES	YES (TROUBLE)
<b>ALARM</b>				
CENTRAL STATION MONITORING		YES	YES	YES

CIRCUIT	2x	LENGTH x	AMPS x	RESISTANCE x	= VOLTS	VOLTAGE DROP
4N1	2	150	0.754	0.00205	0.464	1.93 %
4N2	2	170	0.667	0.00205	0.465	1.94 %

FIRE ALARM SINGLE LINE DIAGRAM  
SCALE: NONE

Ownership of Documents  
This document, the ideas and designs incorporated herein, as an instrument of Professional Service is the property of Integrated Designs by SOMAM Inc. and is not to be used, in whole or in part for any other project without written authorization. © COPYRIGHT 2009

integrated designs by SOMAM, Inc.  
ARCHITECTURE • ENGINEERING • INTERIOR DESIGN • CONSTRUCTION MANAGEMENT  
6011 N. Fresno, Suite 130 - Fresno, California 93710  
Phone (559) 436-0881 Fax (559) 436-0887 E-Mail: design@somam.com  
www.integrateddesigns.com

Rev. Date: 10/15/09  
Rev. Description: ADDENDUM 1  
CHANGE ORDER

Sheet Title: FIRE ALARM SINGLE LINE DIAGRAM CALCULATIONS

Project Name & Address: MUNSEY ELEMENTARY SCHOOL 10 NEW PORTABLE CLASSROOMS BAKERSFIELD CITY SCHOOL DISTRICT BAKERSFIELD, CA 93309

Issue Date: 05/02/06  
Date: 05/02/06  
Designer: DR. DRAFTER  
CJM

DSA Identification Stamp: IDENTIFICATION STAMP DIV. OF THE STATE ARCHITECT  
03-112985  
AC. FLS. DATE: 5/2/06


Stamp(s):

Job No.: 3832

Sheet No.: X14-E-3.2

Reliance: JIMPE/JOB#09082/DATE:01-14-10 AC

Reliance: CURTIS MCNALLY

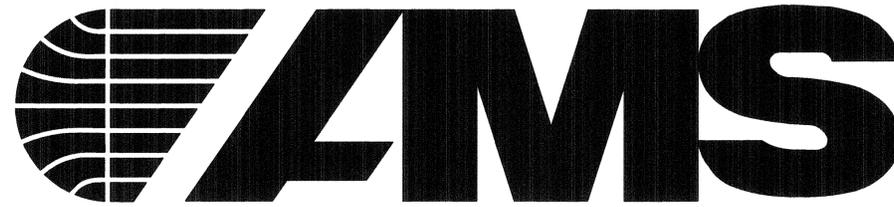

American Modular Systems Inc.

12'x40' RELOCATABLE BUILDING
BAKERSFIELD SCHOOL DISTRICT
MUNSEY ELEMENTARY SCHOOL

EXPOSED - STEEL

MODULAR STEEL MOMENT FRAME TEST & INSPECTION GUIDELINE

A SEPARATE TEST AND INSPECTION LIST IS TO BE SUBMITTED AS PART OF THE APPROVAL PROCESS. THIS GUIDE DOES NOT REPLACE THE TEST AND INSPECTION LIST.

TYPE OF MODULAR STEEL MOMENT FRAME BUILDING PROJECT (X - INDICATES TEST OR INSPECTION TO BE DONE)

Table with columns: MATERIAL TYPE, DESCRIPTION, STOCKPILE, CONSTRUCTION OF (diaphragm material/foundation material), RELOCATION OF CERTIFIED BUILDING. Rows include: COMPACTED FILL, CONCRETE, REINFORCING STEEL, STRUCTURAL STEEL, GROUNDING, SHOT PINS, EXPANSION ANCHORS, EPOXY ANCHORS, INSPECTOR CLASS, SELECTION OF THE PROJECT INSPECTOR AND TESTING AGENCY, COST OF THE PROJECT INSPECTOR, COPIES OF THE REPORT TO.

ITEMS IN RED FONT COLOR ARE USER NOTES AND INDICATE ITEMS THAT NEED TO BE VERIFIED FOR EACH SPECIFIC PC. THE NOTES IN RED ABOVE AND BELOW ARE TO BE REMOVED PRIOR TO PLACING THE GUIDELINE ON THE DRAWINGS. Note 1: Verify that either Condition a or b are met... Note 2: Air Content Test as required based on site location... Note 3: Required where the details of the PC specify a Welding... Note 4: Required where the details of the PC specify the use of this type of anchor

BUILDING DATA

Table with columns: OCCUPANCY, TYPE OF CONSTRUCTION, WIND LOAD, FLOOR LIVE LOAD, ROOF LIVE LOAD, FIRE SPRINKLER SYSTEM WEIGHT (PSF), ALLOWABLE SOIL PRESSURE (PSF), FLOOD HAZARD AREA, BUILDING AREA, CLIMATE ZONES, MODULES, SYSTEM, FOUNDATION TYPE, SEISMIC.

APPLICABLE CODES

PARTIAL LIST OF APPLICABLE CODES AS OF JANUARY 1, 2008. 2007 BUILDING STANDARDS ADMINISTRATIVE CODE, PART 1, TITLE 24 C.C.R. 2007 CALIFORNIA BUILDING CODE (CBC), PART 2, TITLE 24 C.C.R. (2006 INTERNATIONAL BUILDING CODE VOLUMES 1-3 AND 2007 CALIFORNIA AMENDMENTS) 2007 CALIFORNIA ELECTRICAL CODE (CEC), PART 3, TITLE 24 C.C.R. (2005 NATIONAL ELECTRICAL CODE AND 2007 CALIFORNIA AMENDMENTS) 2007 CALIFORNIA MECHANICAL CODE (CMC) PART 4, TITLE 24 C.C.R. (2006 UNIFORM MECHANICAL CODE AND 2007 CALIFORNIA AMENDMENTS) 2007 CALIFORNIA PLUMBING CODE (CPC), PART 5, TITLE 24 C.C.R. (2006 UNIFORM PLUMBING CODE AND 2007 CALIFORNIA AMENDMENTS) 2007 CALIFORNIA ENERGY CODE, PART 6, TITLE 24 C.C.R. 2004 SAFETY CODE FOR ELEVATORS AND ESCALATORS (ASME A17.1-2004) 2007 CALIFORNIA FIRE CODE, PART 9, TITLE 24 C.C.R. (2006 INTERNATIONAL FIRE CODE AND 2007 CALIFORNIA AMENDMENTS) 2007 CALIFORNIA EXISTING BUILDING CODE, PART 10, TITLE 24 C.C.R. (2006 INTERNATIONAL EXISTING BUILDING CODE AND 2007 CALIFORNIA AMENDMENTS) 2007 CALIFORNIA "GREEN" BUILDING REQUIREMENTS, PART 11, TITLE 24 C.C.R. (PENDING ADOPTION) 2007 CALIFORNIA REFERENCED STANDARDS, PART 12, TITLE 24 C.C.R. TITLE 19 C.C.R., PUBLIC SAFETY, STATE FIRE MARSHAL REGULATIONS. PARTIAL LIST OF APPLICABLE STANDARDS NFPA 13 Automatic Sprinkler Systems 2002 Edition NFPA 14 Standpipe Systems 2003 Edition NFPA 17 Dry Chemical Extinguishing Systems 2002 Edition NFPA 17a Wet Chemical Systems 2002 Edition NFPA 20 Stationary Pumps 2003 Edition NFPA 24 Private Fire Mains 2002 Edition NFPA 72 National Fire Alarm Code (California Amended) 2002 Edition (Note See UL Standard 1971 for "Visual Devices") NFPA 253 Critical Radiant Flux of Floor Covering Systems 2006 Edition NFPA 2001 Clean Agent Fire Extinguishing Systems 2004 Edition ASME 17.1 Elevator Standard 2004 Edition Reference code sections for applicable Standards - 2007 CBC Chapter 35 and 2007 CFC Chapter 45.

GENERAL NOTES

- 1. PC BUILDING EXISTING IS BASED ON THE USE OR OCCUPANCY AND WILL BE REVIEWED AS SITE SPECIFIC.
2. PC BUILDING LOCATED IN FIRE HAZARD SEVERITY ZONES PER WILDLAND URBAN INTERFACE FIRE AREAS (WUI) SHALL CONFORM TO CBC CHAPTER 7A.
3. SITE USE SPECIFIC REQUIREMENT FOR AUTOMATIC SPRINKLER SYSTEM MIGHT BE REQUIRED BUT NOT INCLUDED IN THIS PC APPROVAL.

DRAWING INDEX

- T-S COVER SHEET
A1 TYPICAL FLOOR PLANS
A3 TYPICAL INTERIOR ELEVATIONS
A5 TYPICAL EXTERIOR ELEVATIONS (SYNT. STUCCO OPTION)
A5A ARCHITECTURAL DETAILS (SYNT. STUCCO OPTION)
AD ACCESSIBLE DETAILS
N1 GENERAL NOTES
N2 GENERAL NOTES
P1 ISOMETRIC PLANS & DETAILS
M1 TYPICAL CEILING PLAN & NOTES
M2 MECHANICAL BUILDING SECTION & CEILING DETAILS
M3 CEILING & MECHANICAL NOTES
E1 TYPICAL ELECTRICAL PLAN & NOTES
E2 ELECTRICAL NOTES & DETAILS
S1A CONCRETE FOUNDATION PLAN, 50 PSF LIVE LOAD + 15 PSF & 125 PSF
S1B CONCRETE FOUNDATION DETAILS
S1C CONCRETE FOUNDATION DETAILS
S2 FLOOR FRAMING PLAN & DETAILS (PLYWOOD OPTION)
S3 ROOF FRAMING PLAN & DETAILS (OPEN SOFFIT OPTION)
S3.1 ROOF FRAMING DETAILS
S3A ROOF FRAMING PLAN & DETAILS (ENCLOSED SOFFIT OPTION)
S4 TYPICAL FRAME ELEVATIONS
S4A FRAME CONNECTION DETAILS
S5 WALL FRAMING ELEVATIONS
S5A WALL FRAMING DETAILS
S7 BUILDING SECTIONS

BASED ON PC# 02-109808

Table with columns: NO, DATE, DESCRIPTION. Revisions section.

DATE: 01/14/10
SCALE: NOTED
DRAWN BY: RS
SERIAL NO.:

CUSTOMER: BAKERSFIELD SCHOOL DISTRICT
MUNSEY ELEMENTARY SCHOOL
12'x40' RELOCATABLE BUILDING
COVER SHEET



APPROVALS:



IDENTIFICATION STAMP
DIV. OF THE STATE ARCHITECT
OFFICE OF REGULATION SERVICES
No. C12831
Ren. 3-31-11
AC, FL, SS
DATE 2/10/10

PROJECT No.
T-S

THESE DRAWINGS AND SPECIFICATIONS ARE THE PROPERTY OF AMERICAN MODULAR SYSTEMS, INC. AND ARE NOT TO BE REPRODUCED, CHANGED OR COPIED IN ANY FORM OR MANNER, NOR ARE THEY TO BE ASSIGNED TO ANY THIRD PARTY WITHOUT THE WRITTEN AUTHORIZATION OF AMERICAN MODULAR SYSTEMS, INC.



ROOM FINISHES SCHEDULE										DOOR SCHEDULE										
ROOM NUMBER	ROOM NAME	FINISHES								REMARKS	DOORS					FRAMES				
		FLOOR	BASE	WALLS	CEILING	HEIGHT	DOOR NO.	FRAME OPENING SIZE	MATERIAL		FIRE RATING	SET NO.	QUANTITY	MATERIAL	HEAD DETAIL	JAMB DETAIL	REMARKS			
1	GIRLS RESTROOM	B	E	1	1	1	1	1	1	8'-6"	1	3'-0" x 7'-0"	HM	A	1	STL	5/AS	4/AS		
2	STAFF RESTROOM	B	E	1	1	1	1	1	1	8'-6"	1	3'-0" x 7'-0"	HM	A	1	STL	5/AS	4/AS		
3	STAFF RESTROOM	B	E	1	1	1	1	1	1	8'-6"	1	2'-0" x 7'-0"	HM	A	1	STL	5/AS	4/AS		
4	BOYS RESTROOM	B	E	1	1	1	1	1	1	8'-6"										

WINDOW SCHEDULE									
WINDOW NO.	AMT.	TYPE	WIDTH	HEIGHT	FINISH	GLASS TYPE	U-FACTOR	SHGC	REMARKS
2	SLIDER		3'-0"	1'-0"	BRONZE	OBSCURE	0.780	0.430	


HM - HOLLOW METAL  
 AL - ALUMINUM  
 SST - STAINLESS STEEL  
 STL - STEEL FRAME, 16 ga. FULLY WELDED  
 W/F - WINDOW WALL FRAME  
 SC - SOLID CORE WOOD  
 HC - HOLLOW CORE WOOD

\*CLASSROOMS > 1000 S.F.  
 WILL REQ PANIC HARDWARE PER CBC 1008.1.3

NOTE: REFER TO SHEETS A5A, A5A & A7A FOR HEAD & JAMB DOOR DETAILS W/ OPTIONAL EXTERIOR FINISHES

EXTERIOR LITE - 3/16" MINIMUM TEMPERED GLASS OR LAMINATED AS - 1 GLASS OF SOLAR GRAY GLARE REDUCING TYPE WITH A LIGHT TRANSMISSION FACTOR OF 45% MAXIMUM.

A - CARPET PER STATE OF CALIF SPEC COMPLYING WITH GROUP 1, TYPE A OR TYPE B, CLASS 2, DENSITY 4600, DIRECT GLUE DOWN.  
 B - VINYL SHEET FLOORING  
 C - VCT, ARISTON STAIR OR EXCELON  
 D - TOP SET BASE, 4" BURKE  
 E - TOP SET BASE, 6" BRINGANTINE OR SANDOVAL  
 F - WALL FINISH, 1/2" VINYL TACKBOARD CLASS 1 OVER 1/2" GYP BOARD BACKING  
 G - 1/2" W.R. GYP BOARD, TAPE, TEXTURE, PAINTED FINISH  
 H - 1/2" GYP BOARD, TAPE, TEXTURE, PAINTED FINISH  
 I - 3/32" F.R.P. OVER 1/2" W.R. GYP BOARD  
 J - ACoustICAL LAY IN GRID CEILING PANELS (SEE SPECIFICATIONS)  
 K - 1/2" VINYL TACKBOARD CLASS 1 OVER 5/8" TYPE "X" GYP BOARD BACKING  
 L - 5/8" TYPE "X" GYP BOARD, TAPE, TEXTURE, PAINTED FINISH

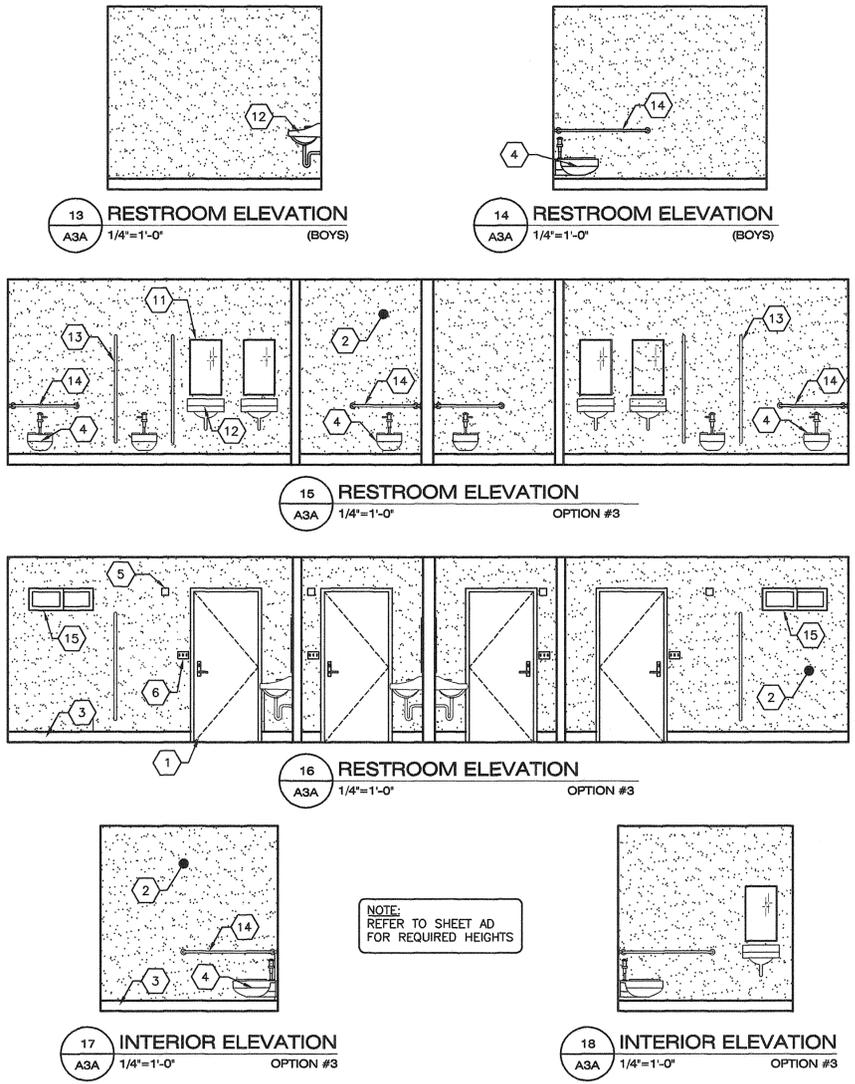

**- KEY NOTES -**

1 TYP EXTERIOR DOOR	10 TYP. URINAL
2 F.R.P. FIBER REINFORCED PLASTIC	11 TYP. MIRROR
2A VINYL WRAPPED TACKABLE WALLS	12 TYP. LAVATORY
3 6" BASE	13 TOILET PARTITION
3A 4" BASE	14 GRAB BAR
4 TYP. TOILET	15 TYP. WINDOW
5 HORN/STROBE J-BOX SEE ELECTRICAL SHEETS	
6 LIGHT SWITCH SEE ELECTRICAL SHEETS	
7 NOT USED	
8 TYP GFIC OUTLET SEE ELECTRICAL SHEETS	
9 WATER HEATER FOR DETAILS REFER TO SHEET 9/M2	

NOTE: ALL INTERIOR SURFACE REQUIREMENTS PER CBC CHAPTER II


**- BUILDING FIXTURE SCHEDULE -**

MARK	FIXTURE	TYPE @ KINDERGARTEN	TYPE @ ELEMENTARY	TYPE @ ADULT	REMARKS
WC 1	WATER CLOSET	WALL MOUNT TYPE AMERICAN STANDARD MODEL AFWALL 2257.103 OR EQUAL	WALL MOUNT TYPE AMERICAN STANDARD MODEL AFWALL 2257.103 OR EQUAL	WALL MOUNT TYPE AMERICAN STANDARD MODEL AFWALL 2257.103 OR EQUAL	MOUNT AS SPECIFIED IN FLOOR PLANS
WC 2	WATER CLOSET	FLOOR MOUNT TANK TYPE AMERICAN STANDARD MODEL BABY DEVORO 2315.016 OR EQUAL	FLOOR MOUNT TANK TYPE AMERICAN STANDARD MODEL COLONY 2399.010 OR EQUAL	FLOOR MOUNT TANK TYPE AMERICAN STANDARD MODEL CADET 2998.012 OR EQUAL	MOUNT AS SPECIFIED IN FLOOR PLANS
WC 3	WATER CLOSET	FLOOR MOUNT FLUSH VALVE TYPE AMERICAN STANDARD MODEL BABY DEVORO 2282.010 OR EQUAL	FLOOR MOUNT FLUSH VALVE TYPE AMERICAN STANDARD MODEL MADERA 2234.015 OR EQUAL	FLOOR MOUNT FLUSH VALVE TYPE AMERICAN STANDARD MODEL MADERA 3043.102 OR EQUAL	FLUSH VALVE ZURN MODEL Z6000 OR EQUAL. MOUNT AS SPECIFIED IN FLOOR PLANS
L 1	LAVATORY	KOHLER MODEL HUDSON #K-2861 OR EQUAL			CHICAGO SINGLE CONTROL LAVATORY FAUCET 3300-CP STAFF OR 3400-CP STUDENT IN FLOOR PLANS
L 2	LAVATORY	AMERICAN STANDARD MODEL LUCERNE 0355.012 OR EQUAL			AS SPECIFIED IN FLOOR PLANS
UR 1	URINAL	WALL MOUNT TYPE AMERICAN STANDARD MODEL ALLBROOK 6541.132 OR EQUAL			FLUSH VALVE ZURN MODEL Z6003 OR EQUAL. MOUNT AS SPECIFIED IN FLOOR PLANS
M 1	MIRROR	WALL MOUNT TYPE BRADLEY MODEL 781-1830 OR EQUAL			MOUNT AS SPECIFIED IN FLOOR PLANS
GB 1	36" GRAB BARS	WALL MOUNT TYPE CREATIVE SPECIALTIES INTERNATIONAL MODEL R7436 (1 1/4" EXPOSED SCREW 36" & 42") OR EQUAL			18 GA. 304 STAINLESS STEEL SATIN FINISH MOUNT AS SPECIFIED IN FLOOR PLANS (STRUCTURAL STRENGTH OF GRAB BARS 250# MIN.)
GB 2	42" GRAB BARS				
WH 1	WATER HEATER	RHEEM/CLAS ENERGY MISER ELECTRIC WATER HEATER RHEEM POINT OF USE MODEL 81VP2S THRU 82VP30-1 OR EQUAL			AVAILABLE IN 2 1/2, 6, 10, 15, 20 AND 30 GALLON MODELS MOUNT AS SPECIFIED IN FLOOR PLANS
FLS 1	FLOOR SINK	FLORESTONE FLOOR SINK MOLDED MOP RECEPTORS MODEL MSR-2424			AMERICAN STANDARD EXPOSED YOKE WALL MOUNT UTILITY FAUCET MODEL 8344.112
ULS 1	UTILITY SINK	WALL MOUNT TYPE ELJER RADFORD SINK MODEL 241-0354			AMERICAN STANDARD EXPOSED YOKE WALL MOUNT UTILITY FAUCET MODEL 8344.112
FV 1	FLUSH VALVE	SLOAN REGAL FLOSHOMETER MODEL #111			FLOW OPTIONS: 1.6 GAL. LOW CONSUMPTION FLUSH WATER CLOSET VALVE MOUNT AS SPECIFIED IN FLOOR PLANS. HANDLE AT WIDE SIDE
FV 2	FLUSH VALVE	ZURN FLUSH VALVE MODEL EXPOSED Z6003			FLOW OPTIONS: 1.0 GAL. LOW CONSUMPTION FLUSH 3/4" URINAL VALVE MOUNT AS SPECIFIED IN FLOOR PLANS. HANDLE AT WIDE SIDE
CS 1	CLASSROOM SINK	TEKA SINGLE BOWL SINK MODEL #256-413 OR EQUAL			AS SPECIFIED IN FLOOR PLANS
CS 1	KITCHEN SINK	TEKA DOUBLE BOWL SINK MODEL #336-413 OR EQUAL			AS SPECIFIED IN FLOOR PLANS

**- STANDARD EQUIPMENT SCHEDULE -**

A. SEWER AND WATER STUB OUTS - SHALL BE LOCATED WITHIN THE ALLOWABLE AREA AS SHOWN ON FLOOR PLAN AND CONNECTIONS SHOULD BE EASILY ACCESSIBLE FOR FUTURE RELOCATION. STUB OUT HEIGHT SHOULD BE COORDINATED WITH THE MANUFACTURER.  
 B. PIPING - WATER, COPPER TYPE "L", 95/5 SOLDER, WASTE DRAIN AND VENT ABS.  
 C. TOILET TISSUE DISPENSER - BRADLEY MODEL 508-32 OR EQUAL  
 D. TOILET PARTITIONS - ACCURATE SOLID PLASTIC OR EQUAL  
 E. TOILET SEAT COVER - BOBRICK B-221 OR EQUAL

- SHEET NOTES -**
- RESTROOM CONFIGURATION MAY VARY PER BUILDING CONFIGURATION
  - INTERIOR WALLS MAY OCCUR THROUGHOUT BUILDING REFER TO SHEET SSA FOR ATTACHMENTS.
  - REFER TO SCHEDULE 15/AD FOR ACCESSIBLE HEIGHTS @ TOILETS
  - REFER TO DETAILS 16 & 17/AD FOR TOILET ANCHORAGE

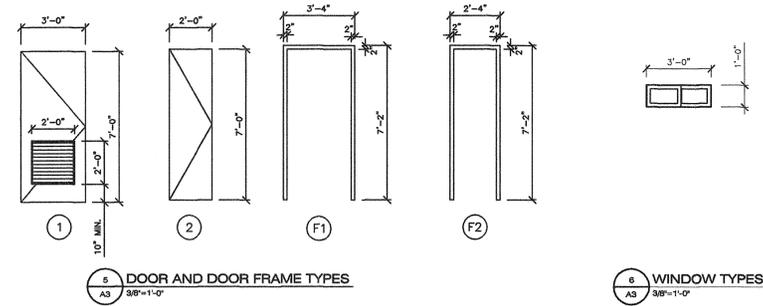

**REVISIONS**

NO	DATE	DESCRIPTION

DATE: 01/12/10  
 SCALE: NOTED  
 DRAWN BY: RS  
 SERIAL NO.:

CUSTOMER:  
 BAKERSFIELD SCHOOL DISTRICT  
 MUNSEY ELEMENTARY SCHOOL

12'X40' RELOCATABLE BUILDING  
 TYPICAL RESTROOM INTERIOR ELEVATIONS

**AMS**  
 American Modular Systems Inc.  
 787 Spreckels Ave. Manteca, CA 95336  
 (209)925-1921 Fax: (209)925-7016  
 americanmodular.com

APPROVALS:  
 \_\_\_\_\_  
 \_\_\_\_\_  
 \_\_\_\_\_

**A**  
 A3A

**FIXTURE CALL OUTS**

IDENTIFICATION STAMP  
 DIV. OF THE STATE ARCHITECT  
 OFFICE OF REGULATION SERVICES  
 No. C12831  
 Ren. 3.3.11  
 AC. FLS. SS.  
 DATE 2/10/10

PROJECT NO.  
 \_\_\_\_\_  
**A3**


BASED ON PC# 02-109808

THESE DRAWINGS AND SPECIFICATIONS ARE THE PROPERTY OF AMERICAN MODULAR SYSTEMS, INC. AND ARE NOT TO BE REPRODUCED, CHANGED OR COPIED IN ANY FORM OR MANNER, NOR ARE THEY TO BE ASSIGNED TO ANY THIRD PARTY WITHOUT THE WRITTEN AUTHORIZATION OF AMERICAN MODULAR SYSTEMS, INC.


- SHEET NOTES -

- 1 CONTROL JOINT (LOCATIONS MAY VARY)
- 1A 16 GA. FLASHING TRIM @ MODLINES TYP.
- 2 STANDING SEAM METAL ROOFING
- 3 OVERHANG
- 4 TYPICAL EXTERIOR DOOR
- 5 WINDOW SEE SPEC'S
- 6 HVAC UNIT TYP.
- 7 ACRYLIC TEXTURED FINISH OVER HARDI-BOARD
- 8 DOWNSPOUT (QUANTITY & LOCATION MAY VARY)
- 9 ROOM ID SIGNAGE (NIC) TYP REFER TO DETAIL 5/AD
- 10 GUTTER
- 11 EXTERIOR LIGHT FIXTURE TYP
- 12 MODULAR IDENTIFICATION TAG, +90" ABOVE F.F.
- 13 FIRE ALARM HORN (REFER TO E1)
- 14 WP/G.F.C.I. TYP. @ HVAC UNITS SEE ELECTRICAL SHEETS.


R RAMP NOT SHOWN FOR RAMP DETAILS REFER TO SHEET S6R

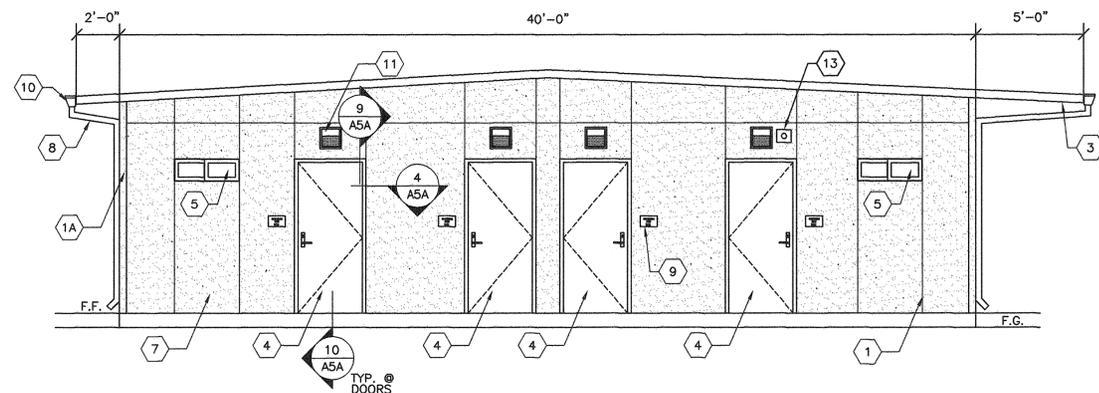


A FRONT EXTERIOR ELEVATION  
A5 1/4"=1'-0"

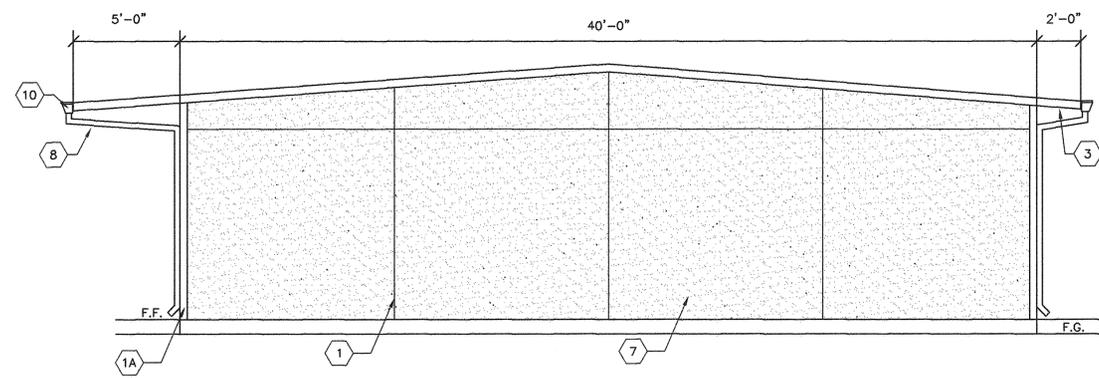

D REAR EXTERIOR ELEVATION  
A5 1/4"=1'-0"

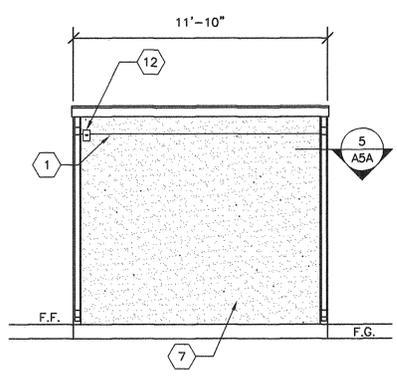

G SIDE EXTERIOR ELEVATION  
A5 1/4"=1'-0"

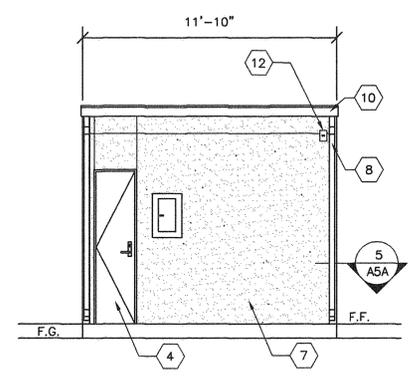

H SIDE EXTERIOR ELEVATION  
A5 1/4"=1'-0"

BASED ON PC# 02-109808

REVISIONS		
NO	DATE	DESCRIPTION


DATE: 01/12/10  
SCALE: NOTED  
DRAWN BY: RS  
SERIAL NO.:

CUSTOMER:  
BAKERSFIELD SCHOOL DISTRICT  
MUNSEY ELEMENTARY SCHOOL

12'X40' RELOCATABLE BUILDING  
TYPICAL EXTERIOR ELEVATIONS (SYNT. STUCCO OPTION)

787 Spreckels Ave. Manteca, CA 95336  
(209)925-1921 Fax: (209)925-7018  
americanmodular.com

APPROVALS:

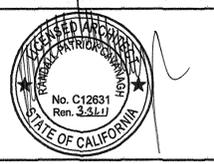


IDENTIFICATION STAMP  
DIV. OF THE STATE ARCHITECT  
OFFICE OF REGULATION SERVICES


03-112985  
AC, FLS, SS  
DATE 2/18/10

PROJECT No.  
  
A5


THESE DRAWINGS AND SPECIFICATIONS ARE THE PROPERTY OF AMERICAN MODULAR SYSTEMS, INC. AND ARE NOT TO BE REPRODUCED, CHANGED OR COPIED IN ANY FORM OR MANNER, NOR ARE THEY TO BE ASSIGNED TO ANY THIRD PARTY WITHOUT THE WRITTEN AUTHORIZATION OF AMERICAN MODULAR SYSTEMS, INC.

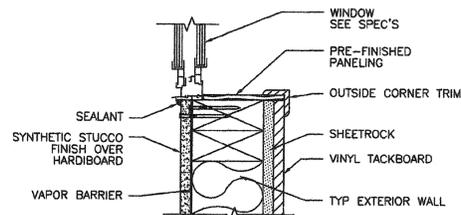


1 TYP WINDOW SILL DETAIL  
ABA 3'-1'-0"

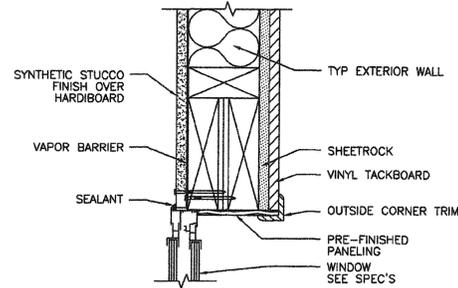


2 TYP WINDOW HEADER DETAIL  
ABA 3'-1'-0"

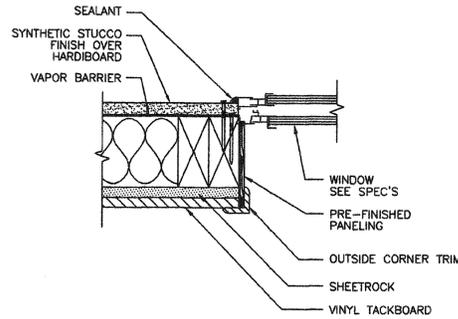


3 TYP WINDOW JAMB DETAIL  
ABA 3'-1'-0"

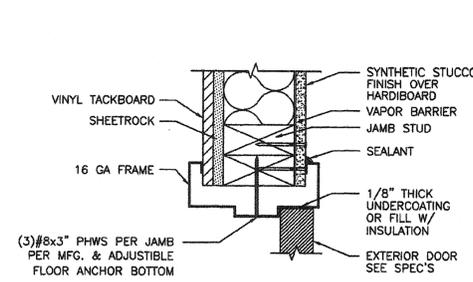


4 TYP DOOR JAMB DETAIL  
ABA 3'-1'-0"

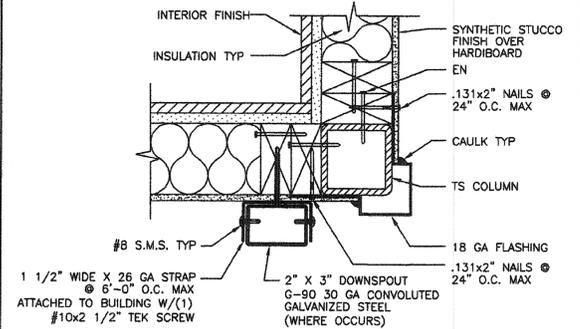


5 DOWNSPOUT ATTACHMENT DETAIL  
ABA 3'-1'-0"

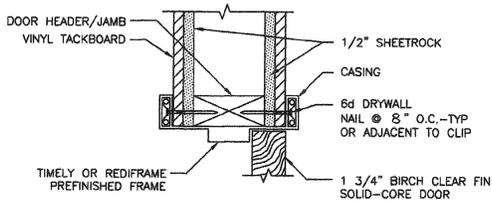


6 TYP INTERIOR DOOR HEADER DETAIL  
ABA 3'-1'-0"

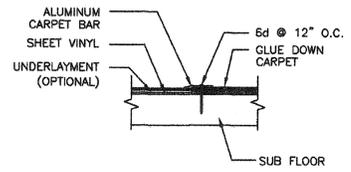


7 FLOORING DETAIL  
ABA 3'-1'-0"

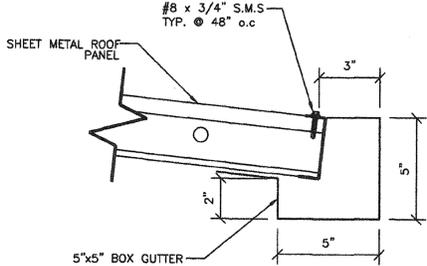

8 TYP GUTTER ATTACHMENT DETAIL  
ABA 3'-1'-0"

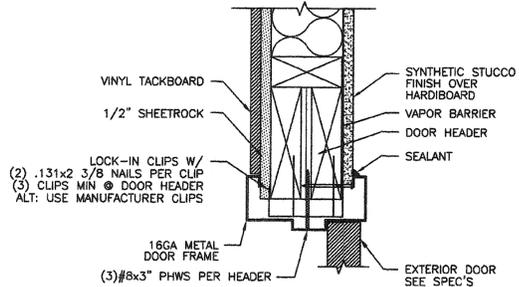

9 TYP DOOR HEADER DETAIL  
ABA 3'-1'-0"

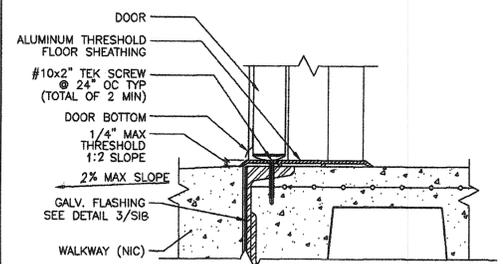

10 THRESHOLD DETAIL  
ABA 1 1/2'-1'-0"

REVISIONS		
NO	DATE	DESCRIPTION











DATE: 2/24/09  
SCALE: NOTED  
DRAWN BY: DM  
SERIAL NO.:

CUSTOMER:  
12X40' RELOCATABLE BUILDING  
ARCHITECTURAL DETAILS (SYNT. STUCCO OPTION)

APPROVALS:








PROJECT No.  
A5A

THESE DRAWINGS AND SPECIFICATIONS ARE THE PROPERTY OF AMERICAN MODULAR SYSTEMS, INC. AND ARE NOT TO BE REPRODUCED, CHANGED OR COPIED IN ANY FORM OR MANNER, NOR ARE THEY TO BE ASSIGNED TO ANY THIRD PARTY WITHOUT THE WRITTEN AUTHORIZATION OF AMERICAN MODULAR SYSTEMS, INC.

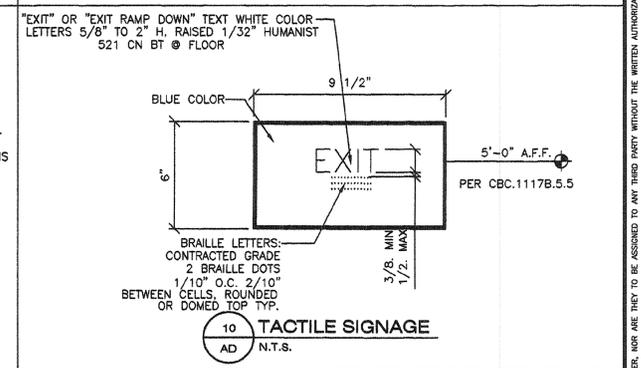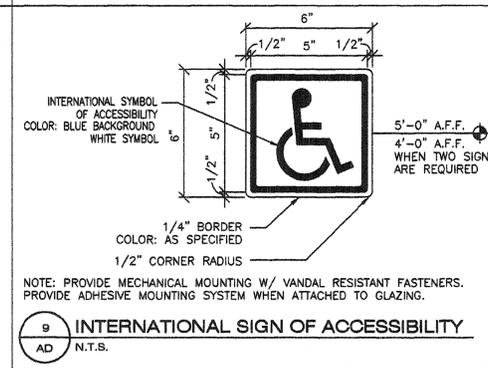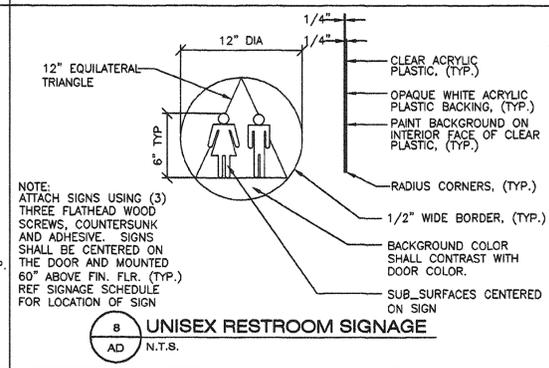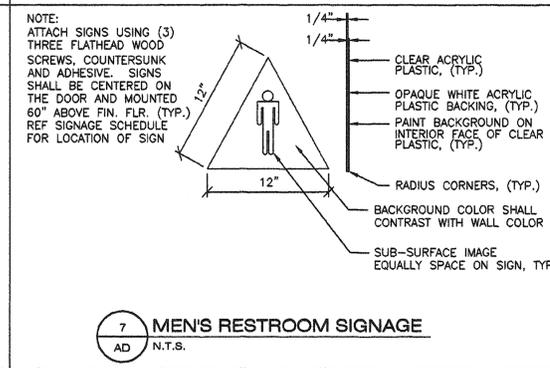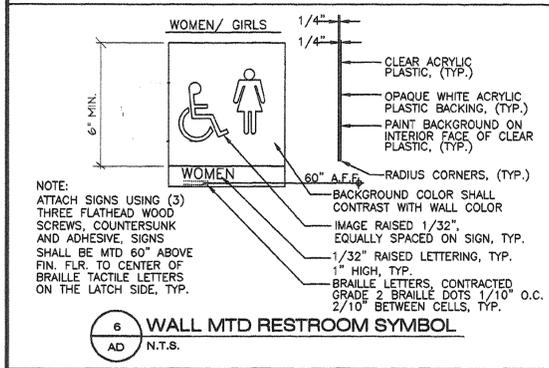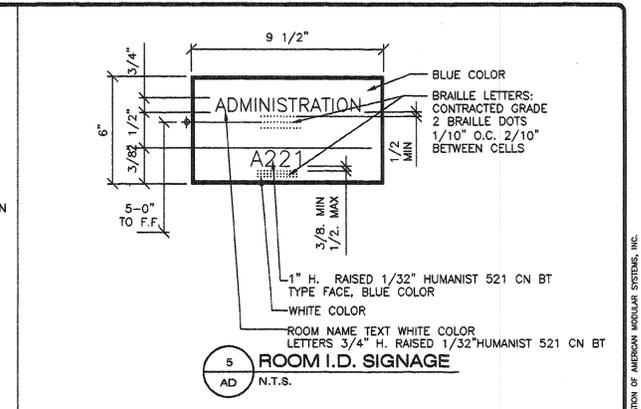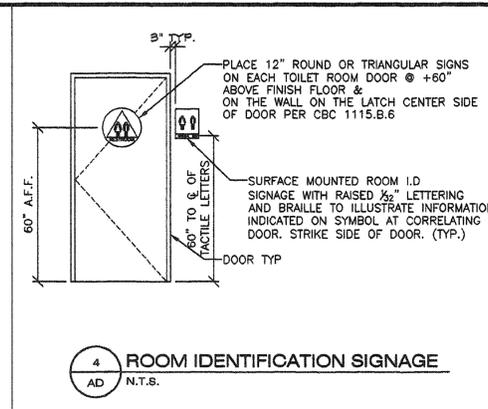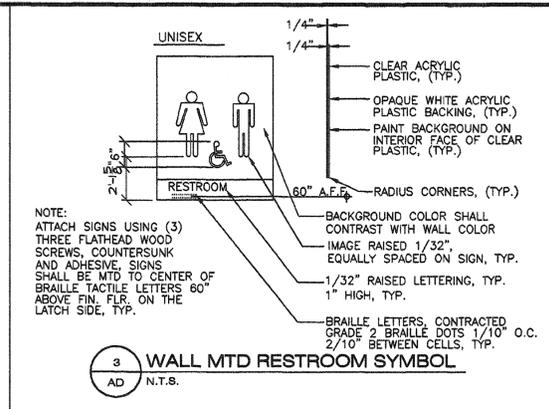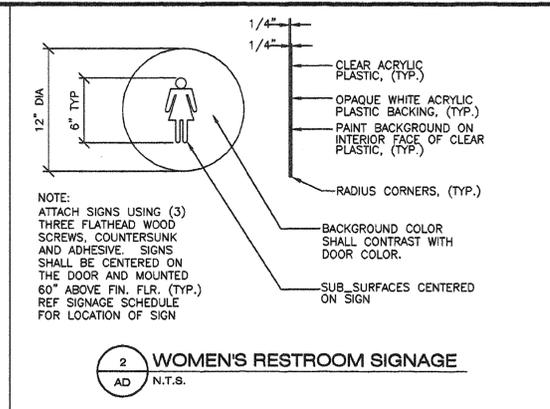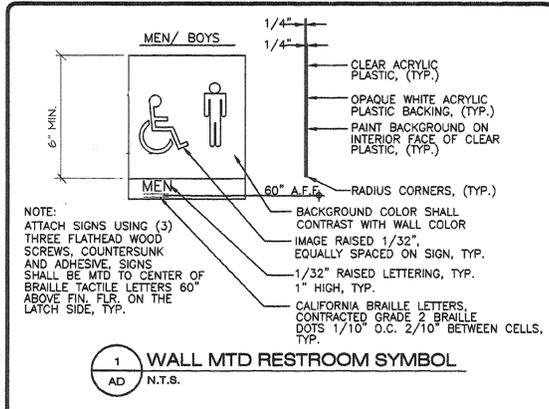

DIMENSIONS FOR ACCESSIBILITY IN TOILET FACILITIES				
FIXTURE TYPE	ADULT (AGE 12 AND OVER) DIMENSION	ELEMENTARY DIMENSION	KINDERGARTEN & PRE-SCHOOL DIMENSION	REMARKS
A TOILET CENTERLINE FROM WALL	18"	15"	12"	FLUSH VALVE TO WIDE SIDE OF STALL TYP
B TOILET SEAT HEIGHT (TO TOP OF SEAT)	17"-19"	15"	10"-12"	
C GRAB BAR HEIGHT	33"	27"	20"-22" ABOVE SEAT *	36" GRAB BAR @ REAR OF TOILET (250 LB CAPACITY TYP) (ALLOWED @ 36" A.F.F. @ TANK TYPE TOILET) 42" GRAB BAR @ SIDE OF TOILET
D TOILET PAPER DISPENSER IN FRONT OF TOILET (TPD)	12" MAX.	6" MAX.	6" MAX. **	12" IN FRONT OF TOILET ROLL PAPER HOLDER WITHOUT STOPS 24" IN FRONT OF TOILET (BY OWNER)
E NAPKIN DISPOSAL IN FRONT OF TOILET (SND)	12" MAX.	12" MAX.	N/A	
F DISPENSER OR MIRROR HEIGHT	40" MAX.	36" MAX.	32" MAX.	
G LAVATORY/SINK TOP HEIGHT	34" MAX.	29" MAX.	24" MAX.	WRAP DRAIN WATER IF HOT WATER OCCURS
H LAVATORY/SINK KNEE CLEARANCE	27" MIN.	24" MIN.	19" MIN.	
I URINAL LIP HEIGHT	17" MAX.	15" MAX.	13" MAX.	
J URINAL FLUSH HANDLE HEIGHT	44" MAX.	37" MAX.	32" MAX.	
K DRINKING FOUNTAIN BUBBLER HEIGHT	36" MAX.	32" MAX.	30" MAX.	
L DRINKING FOUNTAIN KNEE CLEARANCE	27" MIN.	24" MIN.	22" MIN.	
M RAMP/STAIR HANDRAIL HEIGHT	34"-38"	27"	22"	

\* = ABOVE SEAT  
 \*\* = DEVIATES FROM CODE REQUIREMENTS AND REQUIRES A WRITTEN FINDING OF UNREASONABLE HARDSHIP  
 NOTE: 1. ALL ITEMS ON THIS SCHEDULE DO NOT NECESSARILY OCCUR IN THE PROJECT  
 2. HEIGHTS NOTED ON INTERIOR ELEVATIONS SHALL GOVERN OVER THOSE SHOWN HERE.  
 SCD = SEAT COVER DISPENSER      TPD = TOILET PAPER DISPENSER  
 PTD = PAPER TOWEL DISPENSER      SND = SANITARY NAPKIN DISPOSAL (WHERE APPLICABLE)  
 SD = SOAP DISPENSER      (ALL TOILET ACCESSORIES ARE N.J.C.)  
 THIS DIAGRAM ILLUSTRATES THE SPECIFIC REQUIREMENTS OF THESE REGULATIONS AND IS INTENDED ONLY AS AN AID FOR BUILDING AND CONSTRUCTION

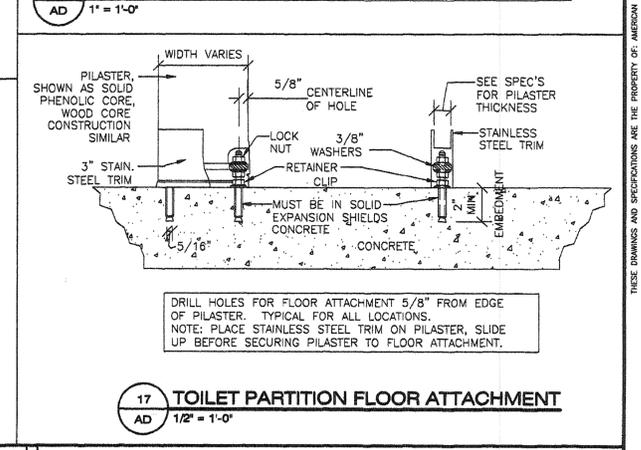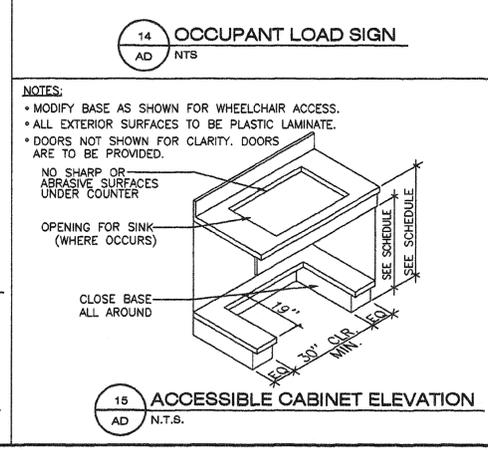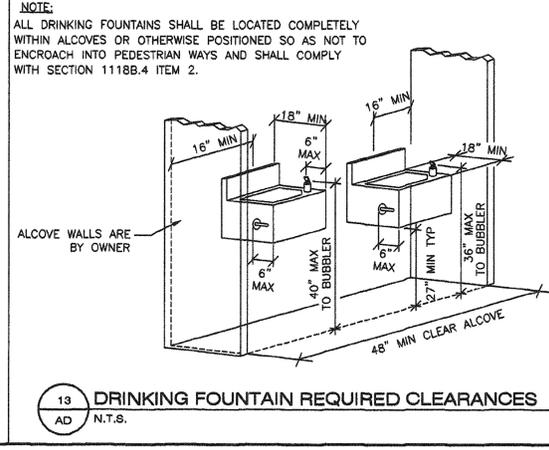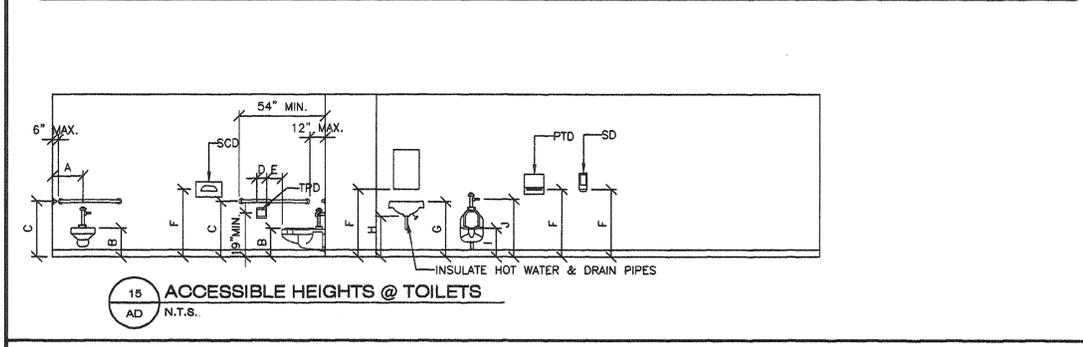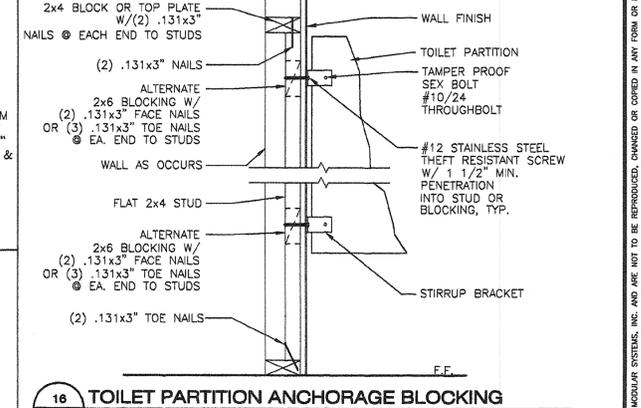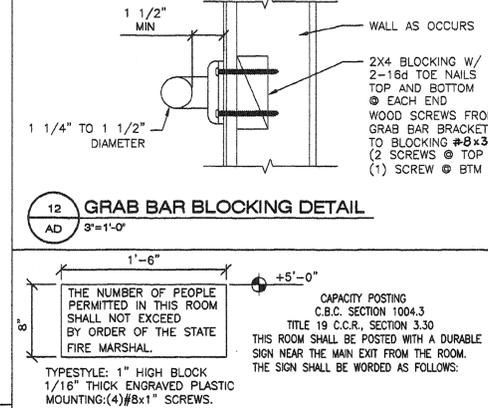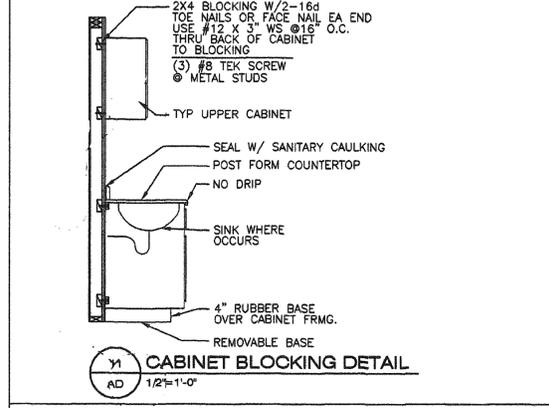

REVISIONS	
NO	DESCRIPTION

DATE: 2/24/09  
 SCALE: NOTED  
 DRAWN BY: DM  
 SERIAL NO.:

CUSTOMER:  
 12'X40' RELOCATABLE BUILDING  
 ACCESSIBLE DETAILS



APPROVALS:  
 IDENTIFICATION STAMP  
 DIV. OF THE STATE ARCHITECT  
 No. C12831  
 Ren. 5.3.07  
 DATE: 4/1/09

IDENTIFICATION STAMP  
 DIV. OF THE STATE ARCHITECT  
 OFFICE OF REGULATION SERVICES  
 PC 02-109808  
 DATE: 4/1/09  
 PROJECT No. AD

THESE DRAWINGS AND SPECIFICATIONS ARE THE PROPERTY OF AMERICAN MODULAR SYSTEMS, INC. AND ARE NOT TO BE REPRODUCED, CHANGED OR COPIED IN ANY FORM OR MANNER, NOR ARE THEY TO BE ASSIGNED TO ANY THIRD PARTY WITHOUT THE WRITTEN AUTHORIZATION OF AMERICAN MODULAR SYSTEMS, INC.

**GENERAL NOTES AND SPECIFICATIONS**

**SECTION 1A GENERAL REQUIREMENTS**

1. GENERAL
  - A. THE REQUIREMENTS OF THE GENERAL CONDITIONS OF THE AGREEMENT AND THIS GENERAL REQUIREMENT APPLY TO THE SEVERAL TRADE SECTIONS WITH THE SAME FORCE AS THOUGH FULLY REPEATED IN EACH TRADE SECTION.
  - B. NAME BRANDS ARE INDICATED TO ESTABLISH A STANDARD OF QUALITY. ITEMS OF EQUAL OR BETTER QUALITY MAY BE SUBSTITUTED FOR THE LISTED BRAND NAMED PRODUCTS WITH THE WRITTEN APPROVAL OF D.S.A. AND THE ARCHITECT.
  - C. ALL WORK SHALL COMPLY WITH THE REQUIREMENTS OF TITLES 19 AND 24 CALIFORNIA CODE OF REGULATIONS 2007 C.B.C. NO CHANGES SHALL BE MADE FROM D.S.A. APPROVED DRAWINGS OR SPECIFICATIONS WITHOUT PRIOR WRITTEN APPROVAL OF D.S.A. AND THE ARCHITECT.
2. SCOPE OF WORK
  - A. THE WORK CONSISTS OF MANUFACTURING OFF-SITE IN A PLANT AND INSTALLING ON-SITE, MODULAR, RELOCATABLE BUILDINGS AS DEFINED HEREIN AND SHOWN AND DETAILED ON DRAWINGS.
  - B. ALL REQUIREMENTS OF TITLES 24 OF THE STATE OF CALIFORNIA CODE OF REGULATIONS RELATING TO INSPECTIONS AND VERIFIED REPORTS SHALL BE COMPLIED WITH AND SHALL INCLUDE:
    1. GENERAL RESPONSIBLE CHARGE OF FIELD ADMINISTRATION BY THE ARCHITECT OF RECORD.
    2. INSPECTION IN-PLANT DURING THE COURSE OF CONSTRUCTION BY AN INSPECTOR APPROVED BY THE DIVISION OF THE STATE ARCHITECT AND THE DISTRICT ARCHITECT. THE INSPECTOR SHALL BE RESPONSIBLE FOR AND APPROVED TO INSPECT THE GENERAL CONSTRUCTION WELDING, MECHANICAL, AND ELECTRICAL WORK. COST OF THESE INSPECTIONS SHALL BE BORNE BY THE SCHOOL DISTRICTS.
    3. ON-SITE INSPECTION OF THE BUILDING INSTALLATION ELECTRICAL AND UTILITY INSTALLATION OR CONNECTIONS BY AN INSPECTOR APPROVED BY THE DIVISION OF THE STATE ARCHITECT AND THE DISTRICT ARCHITECT AND RETAINED BY THE SCHOOL DISTRICT.
    4. OTHER SPECIAL TESTS OR INSPECTIONS AS MAY BE REQUIRED BY THE DIVISION OF THE STATE ARCHITECT.
    5. ADDENDUMS SHALL BE SIGNED BY THE ARCHITECT & APPROVED BY D.S.A.
    6. CHANGE ORDERS SHALL BE SIGNED BY THE OWNER & ARCHITECT & APPROVED BY D.S.A.
    7. THE TESTING LAB SHALL BE IN THE EMPLOY OF THE OWNER.
    8. ALL CONTRACTORS SHALL VERIFY ALL WORK CONDITIONS, DIMENSIONS AND DETAILS AND REPORT ANY OR ALL OMISSIONS AND DISCREPANCIES TO THE DESIGNER/OWNER IMMEDIATELY BEFORE COMMENCING WORK.
    9. EACH CONTRACTOR TO BE RESPONSIBLE TO SEE THAT THEIR WORK CONFORMS TO ALL GOVERNMENTAL CODES WHETHER OR NOT SO STATED ON THE DRAWINGS.
    10. ALL MATERIALS AND WORKMANSHIP TO CONFORM TO THE LATEST REQUIREMENTS OF THE GOVERNING BUILDING CODES IN EFFECT AT TIME OF DSA APPLICATION.
    11. ALL MANUFACTURED ARTICLES, MATERIALS AND EQUIPMENT SHALL BE APPLIED, INSTALLED, CONNECTED AND ERECTED PER MANUFACTURER'S DIRECTIONS AND INSTRUCTIONS.
    12. SHOP DRAWINGS MAY BE REQUIRED. IF SO, THEY WILL BE ACCURATELY DRAWN TO A LARGE ENOUGH SCALE TO SHOW ALL PERTINENT FEATURES OF THE ITEM AND ITS CONNECTION TO RELATED WORK.
    13. THE MANUFACTURER OF BUILDING IS TO PLACE TWO PERMANENT METAL IDENTIFICATION LABEL ON EACH MODULE, MECHANICALLY FASTENED TO THE FRAME SEE "GENERAL DESIGN REQUIREMENTS", THIS PAGE.  
FOR PROJECTS MANUFACTURED OFF-SITE, THE PLANT INSPECTOR IS TO INDICATE THE MANUFACTURER'S NAME AND SERIAL NUMBER OF EACH MODULE ON THE VERIFIED REPORT AND D.S.A. APP. NUMBER.
    14. ALL TESTS AND INSPECTIONS REQUIRED BY DSA SHALL BE COMPLIED WITH. ALL TESTS REQ. BY FIRE AND LIFE SAFETY REGULATIONS SHALL BE BY A NATIONALLY RECOGNIZED TESTING LABORATORY.

**SECTION 2 FOUNDATION**

1. ASSUMED ALLOWABLE SOIL BEARING: 1000 PSF FOR WOOD FOUNDATIONS, 1500 P.S.F. FOR CONCRETE FOUNDATIONS EMBEDDED 12" MIN BELOW GRADE.
  2. FOOTINGS SHALL BE LOCATED ON UNDISTURBED FIRM NATURAL SOIL, APPROVED COMPACTED FILL OR ON AN APPROVED PAVED SURFACE.
- NOTE: THE FOUNDATION SYSTEM PRESENTED HEREIN COMPLIES WITH INTERPRETATION OF REGULATIONS, IR 16-1, ISSUED BY DIVISION OF THE STATE ARCHITECT FOR TEMPORARY BUILDINGS. THIS FOUNDATION SYSTEM IS NON-CONVENTIONAL AND THE STRUCTURAL ENGINEER TAKES NO RESPONSIBILITY FOR ITS CONSTRUCTION OR LONGEVITY.
- WORK NOT INCLUDED:**
- A. ALL ON-SITE OR OFF-SITE UTILITIES AND THE CONNECTION OF THEM TO THE BUILDING UNLESS INDICATED ON THE DRAWINGS.
  - B. ALL LEVELING, GRADING OR OTHER SITE PREPARATION EXCEPT CONCRETE OR WOOD LEVELING STRIPS WHERE REQUIRED, UNLESS OTHERWISE INDICATED ON THE DRAWINGS.
  - C. FIRE ALARM SYSTEM, PROGRAM BELL, PUBLIC ADDRESS SYSTEM, INTERCOM SYSTEM, TV, TELEPHONE SYSTEM UNLESS OTHERWISE INDICATED ON THE DRAWINGS, OR MODIFIED BY CHANGE ORDER.
  4. WHEELS AND HITCH SHALL REMAIN THE PROPERTY OF THE CONTRACTOR.
  5. ACCESSIBILITY OF SITE  
THE SCHOOL DISTRICT SHALL PROVIDE ACCESS TO THE SITE FOR THE INSTALLATION OF BUILDINGS. REMOVAL OF TREES SHRUBS, FENCING, SPRINKLERS ETC. NECESSARY FOR THE MOVE-IN OF BUILDINGS SHALL BE THE RESPONSIBILITY OF THE SCHOOL DISTRICT.

**SECTION 5 STEEL**

- A. GENERAL - ALL WORK SHALL CONFORM TO THE REQUIREMENTS OF AISC STANDARD SPECIFICATIONS, TITLE 24 OF CALIFORNIA CODE OF REGULATIONS AND THE AMERICAN IRON AND STEEL INSTITUTE SPECIFICATIONS FOR DESIGN OF STEEL STRUCTURAL MEMBERS. A COPY OF TITLE 24 SHALL BE KEPT AT THE JOBSITE AT ALL TIMES.
- B. WELDING - ALL WELDING DONE BY SHIELDED ELECTRIC-ARC OR FLUX CORED-ARC PROCESS COMPLYING WITH REQUIREMENTS OF THE "STRUCTURAL WELDING CODE" OF THE AMERICAN WELDING SOCIETY. WELDING DONE BY OPERATORS QUALIFIED BY TESTS ACCEPTABLE TO THE DIVISION OF THE STATE ARCHITECT.
- C. WELDING INSPECTION PER TITLE 24, PART 2, CCR, SECTION 1704A.3.1 WELDING ELECTRODE SHALL BE E70XX. ALL WELDS USED IN PRIMARY MEMBERS AND CONNECTIONS IN THE LATERAL FORCE-RESISTING SYSTEMS SHALL BE MADE WITH A FILLER METAL THAT HAS A MINIMUM CHARPY V-NOTCH TOUGHNESS OF 20FT-LBS AT ZERO DEGREES F, AS DETERMINED BY AWS CLASSIFICATION OR MANUFACTURER'S CERTIFICATIONS PER SECTION 2211A2.3 CBC 2007.
  1. STRUCTURAL STEEL SHALL CONFORM TO A.S.T.M. A-36
  2. PIPE COLUMNS SHALL CONFORM TO A.S.T.M. A-53 WITH SULFUR CONTENT NOT EXCEEDING 0.05%.
  3. STEEL TUBING SHALL CONFORM TO A.S.T.M. A-500 GRADE B OR A.S.T.M. A579 GRADE 50 FOR GAUGE TUBING-TYP. U.N.O.
  4. STRUCTURAL WELDS ARE DESIGNED FOR FULL ALLOWABLE STRESS UNLESS OTHERWISE NOTED.
- D. ERECTION - STRUCTURAL STEEL ERECTED TRUE, STRAIGHT, PLUMB AND TO ITS DESIGNATED LOCATIONS. FIELD CONNECTIONS BOLTED OR WELDED AS INDICATED ON THE DRAWINGS.
- E. NAILS, BOLTS, SCREWS AND NUTS ETC. - FOR EXTERIOR WORK SHALL BE CADMIUM PLATED OR GALVANIZED.
  1. BOLTS FOR STRUCTURAL STEEL JOINTS SHALL CONFORM TO A.S.T.M. A-307 UNLESS OTHERWISE NOTED. ALL HOLES FOR MACHINE AND CARRIAGE BOLTS THROUGH STEEL TO BE DRILLED, OR TORCH PLOT HOLE AND REAM MIN. 1/16" TO BOLT SIZE. NELSON STUDS (WELDED TO STEEL) MAY BE SUBSTITUTED FOR BOLTS SAME LENGTH AND DIAMETER.
- F. HANDRAILS - FABRICATED, AS DETAILED, WELDS GROUND SMOOTH.
- G. SHOP PAINT
  1. EXPOSED STEEL COATED WITH ONE SHOP COAT OF RED OXIDE PRIMER.
  2. NON-EXPOSED STEEL COATED WITH ONE SHOP COAT OF RED OXIDE PRIMER.
  3. ALL SURFACES THOROUGHLY CLEANED BY EFFECTIVE MEANS PRIOR TO APPLICATION OF SHOP COATS.
- H. TESTS
  1. PROVIDE MILL CERTIFICATES OR TEST ALL STEEL MEMBERS PER 7-24 PART 2, CCR SECTION 2212A.1

**SECTION 6A CARPENTRY**

1. SCOPE OF WORK  
CONTRACTOR SHALL PROVIDE ALL LABOR, MATERIALS AND SERVICES TO INSTALL CARPENTRY
2. MATERIALS  
LUMBER GRADE MARKED IN ACCORDANCE WITH "STANDARD GRADING AND DRESSING RULE NO. 17" OF WEST COAST LUMBER INSPECTION BUREAU, OR "GRADING RULES FOR LUMBER, 3RD EDITION OF WESTERN WOOD PRODUCTS ASSOCIATION OR W.C.L.I.B. PLYWOOD GRADE MARKED IN ACCORDANCE WITH PRODUCT STANDARD PS 1-95 FOR SOFTWOOD PLYWOOD, OF AMERICAN PLYWOOD ASSOCIATION.  
EACH SHEET SHALL BEAR THE STAMP OF APA, PITTSBURGH TESTING, OR TFCO.
- A. JOISTS, PLATES, STUDS-DOUGLAS FIR S4S #2 U.N.O.  
NOTE: MSR 1650 E1.5 MAY BE SUBSTITUTED FOR #2 GRADE IF IT MEETS THE STRUCTURAL REQUIREMENTS FOR FLOOR AND ROOF MEMBERS.
- B. H.F. HEADERS, POSTS AND TIMBERS-DOUGLAS FIR S4S #1
- C. BLOCKING - DOUG FIR #3, OR HEM FIR #3, OR STD. & BET.
- D. SILLS AND LUMBER & SHIM PLATES IN CONTACT WITH CONCRETE, MASONRY OR EARTH, DOUG FIR #2 PRESSURE TREATED IN ACCORDANCE WITH CBC 2304.11.2 EACH PIECE SHALL BEAR AWPB STAMP. AWPB STANDARD U1 & T1 GROUND CONTACT, D.F.#2 ABOVE GROUND.
- E. MOISTURE BARRIER - KRAFT WATERPROOF BUILDING PAPER, OR 15 LB. FELT, CBC 2007 17-1 FOR KRAFT, 32-1 FOR FELT.
- F. STUDS - S4S DOUG FIR #2, OR #2 HEM FIR. MAXIMUM MOISTURE CONTENT OF 19% AT TIME OF INSTALLATION.
- G. FASTENERS - NAILS SHALL BE CORROSION RESISTANT PER C.B.C. 2304.9.1.1 COMMON NAILS FOR EXT. SIDING & FNDN. ONLY.
- H. BUILDING TRIM - 2X RESAWN SELECT D.F., H.F. OR CEDAR
- J. DOOR/WINDOW TRIM - 1X4 RESAWN D.F., H.F. OR CEDAR.
- K. FRAMING CONNECTORS SHALL BE FROM SIMPSON CATALOG LATEST ED.
- M. FIRE BLOCKS SHALL CONFORM TO CBC SECTION 717
- N. ALL NAILS SHALL BE COMMON NAILS UNLESS OTHERWISE NOTED.
- O. FOUNDATION LUMBER: ALL CUT ENDS AND HOLES IN PRESSURE TREATED LUMBER SHALL BE TREATED WITH "CUPRINOL".
3. WORKMANSHIP
  - A. FRAMING - SECURELY NAILED, BRIDGED AND BLOCKED TO FORM RIGID STRUCTURE. WORK CUT, FITTED AND ASSEMBLED LEVEL PLUMB AND TRUE TO LINE. TRIM IN AS LONG LENGTHS AS POSSIBLE WITH ALL STANDING TRIM IN ONE PIECE. TRIM SEALED AT ALL EDGES.
  - B. NAILING - IN ACCORDANCE WITH TITLE 24, CALIFORNIA BUILDING CODE, TABLE 2304.9.1.
  - C. EXTERIOR WALLS - FACTORY FABRICATED. CAULKING PROVIDED BETWEEN PERIMETER OF WALL AND STRUCTURAL MEMBERS PROVIDING WEATHER-PROOF AND WATER-TIGHT SEAL. NECESSARY CLOSERS, SEALS, AND FLASHINGS PLACED AT TOP AND BASE SUPPORT OF PANELS AND AROUND OPENINGS.
  - D. NAILS INTO P.T. LUMBER TO BE HOT DIPPED GALVANIZED.

- E. MACHINE APPLIED NAILING: USE OF MACHINE NAILING IS SUBJECT TO A SATISFACTORY JOBSITE DEMONSTRATION FOR EACH PROJECT AND THE APPROVAL BY THE PROJECT ARCHITECT OR STRUCTURAL ENGINEER AND THE DIVISION OF THE STATE ARCHITECT. THE APPROVAL IS SUBJECT TO CONTINUED SATISFACTORY PERFORMANCE.  
MACHINE NAILING WILL NOT BE APPROVED IN 5/16" PLYWOOD. IF NAILHEADS PENETRATE THE OUTER PLY MORE THAN WOULD BE NORMAL FOR A HAND HAMMER OR IF MINIMUM ALLOWABLE EDGE DISTANCES ARE NOT MAINTAINED THE PERFORMANCE WILL BE DEEMED UNSATISFACTORY.
- F. MOISTURE BARRIER - APPLIED TO STUDS WEATHER-BOARD FASHION, HORIZONTAL JOINTS LAPPED MIN 6" INCLUDING BUILDING CORNERS. SHEATHING APPLIED OVER MOISTURE BARRIER.
- G. TRIM SEALED AT ALL EDGES. SEALANT PAINTED TO MATCH TRIM OR SIDING UNLESS TRANSPARENT TYPE.

**SECTION 7B SHEET METAL**

1. SCOPE OF WORK  
CONTRACTOR SHALL PROVIDE ALL LABOR, MATERIALS AND SERVICES TO INSTALL INDICATED SHEET METAL.
2. MATERIALS
  - A. SHEET METAL - STEEL SHEETS HOT DIP GALVANIZED WITH 1.25 OZ. PER SQUARE FOOT ZINC COATING CONFORMING TO ASTM A526. MINIMUM 26 GA. UNLESS OTHERWISE NOTED ON THE DRAWINGS.
  - B. SOLDER - OF STAND. GRADE "A" OF EQUAL PARTS ARD BRAND LEAD AND TIN ASTM B32.
  - C. FLUX - ZINC SATURATED MURIATIC ACID.
  - D. GUTTERS: 26 GA. G-90 GALV. STEEL.
  - E. DOWNSPOUTS: 2"x3" CONVULGATED 30 GA. G-90 GALV. STEEL.
  - F. GUTTER ENDCAPS: 26 GA. G-90 GALV. STEEL.
  - G. GUTTER CLIPS: 18 GA. G-90 GALV. STEEL.
3. WORKMANSHIP  
SHEET METAL ACCURATELY FORMED TO DIMENSIONS AND SHAPES DETAILED WITH TRUE STRAIGHT LINES, CORNERS AND ANGLES. FLASHING INSTALLED IN LONGEST LENGTHS POSSIBLE. EXTERIOR WORK FORMED, FABRICATED AND INSTALLED SO THAT IT ADEQUATELY PROVIDES FOR EXPANSION AND CONTRACTION IN THE COMPLETED WORK AND FINISHES WATER AND WEATHER TIGHT. ALUMINUM SHALL BE SEPARATED FROM FERROUS METAL BY POLYETHYLENE TAPE OR FLOOD COAT OF ASPHALTIC PAINT.

**SECTION 7C METAL ROOFING**

1. SCOPE OF WORK  
CONTRACTOR SHALL PROVIDE ALL LABOR, MATERIALS AND SERVICES TO INSTALL METAL ROOFING. TEST RESULTS SHOWING THE ROOFING SYSTEM WILL WITHSTAND THE UPLIFT OF A 85 MPH WIND SHALL BE SUBMITTED WITH THE PLANS AND SPECIFICATIONS.
2. MATERIALS
  - A. ROOFING - 1 1/4" INCH STANDING SEAM MIN 26-GAUGE G-90 GALV. INTERLOCKING (UNPENETRATED) SHEET STL PANELS (G90).
  - B. ALTERNATE: ROOFING - 3 INCH STANDING SEAM MIN 20-GAUGE G-90 GALV. INTERLOCKING (UNPENETRATED) SHEET STL PANELS (G90).
  - C. ROOFING: CLASS B FIRE RATING

**SECTION 7J SEALANT**

1. SCOPE OF WORK  
CONTRACTOR SHALL PROVIDE ALL LABOR, MATERIAL AND SERVICES TO SEAL BUILDINGS.
2. MATERIALS  
VULKEM SEALANT, POLYURETHANE, MANUFACTURED BY MAMECO INTERNATIONAL FOR ROOFS. "GEOCEL" SILICONIZED CAULK, GE, DUPONT, EAGLESEAL OR DAP FOR ALL OTHER APPLICATIONS, OR EQUAL.
3. WORKMANSHIP  
SEALANT APPLIED TO DRY CLEAN SURFACES, WHEREVER INDICATED ON DETAILS AND AS NEEDED TO MAKE BUILDING WATER TIGHT IN ACCORDANCE WITH MANUFACTURER'S SPECIFICATIONS.

**SECTION 8 CONCRETE**

1. CONCRETE CONSTRUCTION SHALL CONFORM TO ACI 318-05
2. THE MINIMUM 28 DAY STRENGTH AND TYPE OF CONCRETE SHALL BE A FOLLOW:  
SLABS ON GRADE & FOUNDATIONS 2500 PSI (150 PCF)  
CONCRETE OVER METAL DECK 2500 PSI (110 PCF) OR (150 PCF)
3. REINFORCING SHALL CONFORM TO ASTM A615--GRADE 40 UN.
4. CONCRETE COVERAGE SHALL BE AS FOLLOWS, UNON ON DRAWINGS:  
CONCRETE DEPOSITED DIRECTLY AGAINST GROUND (EXCEPT SLABS) ....."  
CONCRETE EXPOSED TO GROUND BUT PLACED IN FORMS .....2"  
SLABS (ON GROUND).....POSITION IN CENTER OF SLAB
5. ALL BARS SHALL HAVE A CLASS B MINIMUM SPLICE LAP UN.
6. NOTIFY THE STRUCTURAL ENGINEER PRIOR TO PLACING CONCRETE.

**SECTION 8A EXTERIOR PLASTER**

- LATHING AND PLASTERING MATERIALS AND ACCESSORIES SHALL BE MARKED BY THE MANUFACTURER'S DESIGNATION TO INDICATE COMPLIANCE WITH THE APPROPRIATE STANDARDS REFERENCED IN THIS SECTION AND STORED IN SUCH A MANNER TO PROTECT THEM FROM THE WEATHER. PER 2507.1
- LATHING AND PLASTERING MATERIALS SHALL CONFORM TO THE STANDARDS LISTED IN TABLE 2507.2 AND CHAPTER 35 AND, WHERE REQUIRED FOR FIRE PROTECTION, SHALL ALSO CONFORM TO THE PROVISIONS OF CHAPTER 7. PER 2507.2
- GYPSSUM BOARD AND GYPSUM PLASTER CONSTRUCTION SHALL BE OF THE MATERIALS LISTED IN TABLES 2506.2 AND 2507.2. THESE MATERIALS SHALL BE ASSEMBLED AND INSTALLED IN COMPLIANCE WITH THE APPROPRIATE STANDARDS LISTED IN TABLES 2508.1 AND 2511.1, AND CHAPTER 35 PER 2508.1
1. GENERAL NOTES  
PLASTERING WITH CEMENT PLASTER SHALL NOT BE LESS THAN THREE COATS WHEN APPLIED OVER METAL LATH OR WIRE FABRIC LATH AND SHALL NOT BE LESS THAN TWO COATS WHEN APPLIED OVER MASONRY CONCRETE OR GYPSUM BACKING AS SPECIFIED IN SECTION 2510.5

- A. THE FIRST COAT SHALL BE APPLIED WITH SUFFICIENT MATERIAL AND PRESSURE TO FILL SOLIDLY ALL OPENINGS IN THE LATH. THE SURFACE SHALL BE SCORED HORIZONTALLY SUFFICIENTLY ROUGH TO PROVIDE ADEQUATE BOND TO RECEIVE THE SECOND COAT.
- B. THE SECOND COAT SHALL BE BROUGHT OUT TO PROPER THICKNESS, RODDED AND FLOATED SUFFICIENTLY ROUGH TO PROVIDE ADEQUATE BOND FOR THE FINISH COAT. THE SECOND COAT SHALL HAVE NO VARIATION GREATER TO THAN 1/4 INCH (6.4 mm) IN ANY DIRECTION UNDER 5-FOOT STRAIGHT EDGE.
- C. THE FINISH COATS SHALL BE APPLIED OVER BASE COATS THAT HAVE BEEN IN PLACE FOR THE TIME PERIODS SET FORTH IN ASTM C 926 THE THIRD OR FINISH COAT SHALL BE APPLIED WITH SUFFICIENT MATERIAL AND FORCE TO BOND TO AND TO COVER THE BROWN COAT AND SHALL BE OF SUFFICIENT THICKNESS TO CONCEAL THE BROWN COAT.

**SECTION 8B HOLLOW METAL DOORS AND FRAMES**

1. SCOPE OF WORK  
CONTRACTOR SHALL PROVIDE ALL LABOR, MATERIALS AND SERVICES TO INSTALL HOLLOW METAL DOORS AND FRAMES.
2. MATERIALS
  - A. DOORS - INSULATED TYPE L FULL FLUSH, MANUFACTURED BY AMWELD MANUFACTURING COMPANY, 18 GA. 1 3/4" THICK PER CS242 MIN. REINFORCE FOR HARDWARE--BOTH FACES FOR CLOSER, SOUND DEADEN INTERIOR.
  - B. FRAMES - 16 GA COLD ROLLED, 2" FACES, CS242 MIN. 3 ANCHORS PER JAMB & ADJUSTABLE FLOOR ANCHOR EACH JAMB REINFORCE FOR HARDWARE. PROVIDE STRIKE BOX, PROVIDE SOUND DEADENING: 1/8" UNDERCOATING OR INSULATING FILL.
3. WORKMANSHIP  
ALL WORK FABRICATED IN SHOP TO REQUIRED PROFILES BY FORMING AND WELDING, WITH ARISES AND EDGES STRAIGHT, SHARP FIT FABRICATED ACCURATELY WITH SQUARE CORNERS, HAIRLINE JOINTS AND SURFACES FREE FROM WARP, WAVE, BUCKLE OR OTHER DEFECTS AFTER FABRICATION, DOORS AND FRAMES CLEANED THOROUGHLY, ALL WELDS GROUND SMOOTH AND GIVEN PRIME COAT.

**SECTION 9E PAINTING**

1. SCOPE OF WORK  
CONTRACTOR SHALL PROVIDE ALL LABOR, MATERIALS AND SERVICES TO PAINT BUILDING. ALL EXPOSED SURFACES OF BUILDING AND RAMPS SHALL BE PAINTED EXCEPT ALUMINUM WINDOW FRAMES, THRESHOLDS, AND ROOFING.
2. MATERIALS
  - A. FOR EXTERIOR WOOD:
 

REF. BRAND	DUNN	KELLY	SHERWIN	SINCLAIR
	EDWARDS	MOORE	WILLIAMS	
PRIMER	42-9M	1240	Y24W20	289-N
FINISH	0D-60-XX	1240-XXX	B54WZ102	GE2-NXX
  - B. FOR INTERIOR TRIM
 

REF. BRAND	DUNN	KELLY	SHERWIN	SINCLAIR
	EDWARDS	MOORE	WILLIAMS	
FINISH	W450-XX	1650-XXX	A26W11	40XX
  - C. FOR METAL
 

REF. BRAND	DUNN	KELLY	SHERWIN	SINCLAIR
	EDWARDS	MOORE	WILLIAMS	
PRIMER	43-4	1710	B50N26	15N
FINISH	10-XX	1700-XXX	B54WZ102	GE2-NXX
3. WORKMANSHIP  
ALL EXPOSED SURFACES SHALL BE PAINTED EXCEPT ALUMINUM WINDOW FRAMES AND THRESHOLDS. MATERIAL SHALL BE OF THE GRADE SPECIFIED OR EQUAL.  
EXTERIOR - WOOD SIDING, TRIM AND SKIRTING FLAT OR SEMI-GLOSS LATEX - APPLY ONE COAT OF PRIME AND AT LEAST ONE FINISH COAT. PRIME COAT SHALL BE BRUSHED ON OR SPRAYED AND BACK BRUSHED INTO ALL GROOVES IN THE SIDING. IF NECESSARY, IN THE OPINION OF THE INSPECTOR, AN EXTRA COAT SHALL BE APPLIED TO ALL GROOVES SO THAT THE FINISH COAT WILL HAVE A UNIFORM APPEARANCE. ALLOW PRIME COAT TO DRY ACCORDING TO MANUFACTURER'S RECOMMENDATION. PRIME AND FINISH COATS SHALL BE COMPATIBLE AND MANUFACTURED BY THE SAME COMPANY.  
INTERIOR TRIM - TRIM NOT PRECOATED SHALL BE PAINTED WITH TWO COATS OF SEMI-GLOSS LATEX OVER PRIMER.  
INTERIOR HARDWOOD CABINETS - TWO COATS LOW LUSTER POLYURETHANE FINISH. APPLY FIRST COAT THINNED WITH ONE QUART MINERAL SPIRITS PER GALLON. APPLY SECOND COAT AS RECOMMENDED BY MANUFACTURER.  
METAL - ALL METAL SURFACES SHALL BE PAINTED WITH TWO COATS OF ALKYL FINISH COAT OVER ZINC CHROMATE OR EQUAL RUST INHIBITING PRIMER.  
RAMP - ONE COAT OF FERROX NON-SLIP (0.8 MIN. C.O.F.) SURFACING AS MANUFACTURED BY AMERICAN ABRASIVE METALS OR COMPARABLE. ALL PAINTS OF THE TYPE INDICATED SHALL BE LISTED ON THE STATE OF CALIFORNIA QUALIFIED PRODUCTS LIST FOR MAINTENANCE PAINTS 8010-91C-98A DATED JULY 1989. OR EQUAL.  
SUBMIT ONE SET COLOR SAMPLES TO ARCHITECT FOR EACH PRODUCT TO ASSIST IN SELECTION.

**SECTION 13F SITE ASSEMBLY**

1. SCOPE OF WORK  
CONTRACTOR SHALL PROVIDE ALL LABOR MATERIALS AND SERVICES TO PREPARE THE BUILDING ELEMENTS, TRANSPORT THEM FROM THE PLANT TO THE SITE AND TO COMPLETE THE ASSEMBLY AT THE SITE. THE CONDITION OF THE SITE, SUCH AS DRAINAGE AND SOIL BEARING CAPACITY, SHALL BE THE RESPONSIBILITY OF THE SCHOOL DISTRICT. UNLESS SPECIFICALLY CALLED FOR IN THE CONTRACT, STEPS, RAMPS, OR HANDRAILS SHALL BE THE RESPONSIBILITY OF THE CONTRACTOR.
2. ASSEMBLY OF ELEMENTS
  - A. IN A LOCATION ON THE SITE AS DETERMINED BY THE SCHOOL DISTRICT (APPROVED BY DSA) THE CONTRACTOR SHALL PLACE WOOD LEVELING STRIPS OR OTHER SUITABLE SUPPORTS AS DETAILED ON THE DRAWINGS.
  - B. THE ELEMENTS SHALL BE BROUGHT TO THE SITE ON WHEEL ASSEMBLY AND TRANSFERRED TO THE PREPARED SITE. GREAT CARE SHALL BE TAKEN TO AVOID DAMAGE TO THE ELEMENTS BY RACKING OR BUMPING EACH OTHER.
  - C. CONNECTION OF THE ELEMENTS TOGETHER SHALL BE DONE ACCORDING TO INSTRUCTION ON THE DRAWINGS. FLASHINGS, TRIM AND OTHER LOOSE ITEMS SHALL BE INSTALLED PER DETAILS ON THE DRAWINGS.

**SECTION 15A AIR CONDITIONING**

1. SCOPE OF WORK (SEE SHEET M3 FOR HVAC SPEC. AND NOTES)  
CONTRACTOR SHALL PROVIDE ALL LABOR, MATERIALS AND SERVICES TO INSTALL THE AIR CONDITIONING SYSTEM AS SHOWN ON THE DRAWINGS AND SPECIFICATIONS, INCLUDING A/C UNITS AND ACCESSORIES, REMOTE THERMOSTAT, GRILLS AND POWER WIRING COMPLETE TO LOAD CENTER. CONTRACTOR SHALL INSTRUCT OWNER'S OPERATORS ON OPERATION AND MAINTENANCE OF A/C SYSTEM.
2. EQUIPMENT  
SEE NOTE ON FLOOR PLAN FOR SIZE AND TYPE.
3. WORKMANSHIP  
UNITS SHALL BE INSTALLED COMPLETE AND OPERATING WITH ALL ACCESSORIES IN ACCORDANCE WITH THE MANUFACTURER'S INSTRUCTIONS.

**SECTION 16A ELECTRICAL**

1. SCOPE OF WORK  
CONTRACTOR SHALL PROVIDE ALL LABOR, MATERIALS AND SERVICES FOR ELECTRICAL INSTALLATION COMPLETE WITH ASSOCIATED EQUIPMENT AND FIXTURES, IN OPERATING CONDITION READY FOR USE. THE WORK INCLUDES: LIGHT AND POWER SYSTEMS, LIGHTING FIXTURES COMPLETE WITH LAMPS, CONNECTIONS AND DISCONNECTS TO A/C EQUIPMENT.
- A. PROVIDE CONDUIT WITH PULL STRINGS AND JUNCTION BOXES FOR AUTOMATIC DETECTION FIRE ALARM SYTEM AND NOTIFICATION PER NFPA 72
2. MATERIALS  
ALL NEW COMPLYING WITH REQUIREMENTS OF CALIFORNIA ELECTRIC CODE AND NATIONAL FIRE PROTECTION ASSOCIATION
- A. ELECTRIC METALLIC TUBING - COUPLING AND FLEX CONDUIT GALVANIZED OR SHERARDIZED. EXTERIOR FLEX- GALV. STEEL W/ FACTORY APPLIED P.V.C. JACKET.
- B. PANELBOARDS - FLUSH MOUNTED.
- C. CONDUCTORS - COPPER, INSULATED FOR 600 VOLTS, TYPE THHN FOR SIZES #12 TO #6, TYPE THW FOR LARGER SIZES. MINIMUM SIZE - #14.
- D. RECEPTACLES - AS NOTED. +18" A.F.F. MIN.
- E. CLOCK RECEPTACLE - AS NOTED.
- F. SWITCHES - AS NOTED. +48" A.F.F. MAX.
- G. LIGHTING FIXTURES - AS NOTED ON THE DRAWINGS.
3. WORKMANSHIP  
MATERIALS AND EQUIPMENT INSTALLED IN A SECURE, NEAT WORKMANLIKE MANNER IN ACCORDANCE WITH CODE REQUIREMENTS. PANELBOARD CABS FILLED OUT. CONDUIT AND CABLE INSTALLED IN WALL AND CEILING SPACES. WORK PIERCING WATERPROOF AREAS FLASHED AND SEALED TO A WATER TIGHT CONDITION. BUILDING CONDUIT/WIRING FROM FACE OF BLDG TO SITE TERMINATION BY SITE CONTRACTOR (N.I.C.), (FLEXIBLE CONDUIT S-BEND SEALTITE)

**INSPECTION**

- INSPECTION OF PREFABRICATED BUILDINGS IS DIVIDED INTO TWO SEPARATE FUNCTIONS.
1. IN-PLANT INSPECTION.
  2. ON-SITE INSPECTION.

THE CONTRACTOR SHALL ALLOW UP TO SEVEN (7) DAYS FROM THE DATE OF PLAN APPROVAL TO OBTAIN AN IN PLANT INSPECTOR APPROVED BY D.S.A.

IN-PLANT INSPECTION AND MATERIAL TESTING SHALL BE ACCOMPLISHED UNDER THE SUPERVISION OF THE DISTRICT ARCHITECT. THE CONTRACTOR SHALL NOTIFY THE DISTRICT ARCHITECT, DSA, AND THE DESIGNATED INSPECTOR/INSPECTION AGENCY AT LEAST 48 HOURS PRIOR TO COMMENCING WORK. THE MANUFACTURER SHALL PROVIDE THE INSPECTOR WITH FULL ACCESS TO ALL PLANT OPERATIONS INVOLVING WORK UNDER THIS CONTRACT AND SHALL ADVISE THE INSPECTOR IN ADVANCE OF THE TIME AND PLACE WHEN OPERATIONS THAT THE INSPECTOR WANTS TO OBSERVE TAKE PLACE. BEFORE THE BUILDING(S) ARE REMOVED FROM THE PLANT FOR DELIVERY TO THE STORAGE FACILITY OR FROM THE STORAGE FACILITY TO THE SITE THE INSPECTOR SHALL DETERMINE THAT THEY ARE ACCEPTABLE AND ISSUE A WRITTEN RELEASE WHICH SHALL BE IN THE FORM OF A VERIFIED REPORT (FORM SSS-6). A COPY OF THE INSPECTOR'S VERIFIED REPORT SHALL ACCOMPANY EACH BUILDING TO STORAGE OR TO THE SITE. THE INSPECTOR SHALL PUT ONE COPY IN EACH BUILDING.

**COORDINATION OF WORK**

IT SHALL BE THE CONTRACTOR'S RESPONSIBILITY TO MAKE ALL NECESSARY ARRANGEMENTS WITH THE SCHOOL DISTRICT AUTHORIZED REPRESENTATIVE FOR ACCESS TO GROUNDS AND REMOVAL OF EQUIPMENT, IF NECESSARY. THIS CONTACT SHALL BE MADE AT LEAST 48 HOURS PRIOR TO DELIVERY OF ANY MODULE. ON-SITE INSPECTION SHALL BE DONE BY THE SITE INSPECTOR. ALL WORK WHICH THE MANUFACTURER OR HIS SUBCONTRACTORS PERFORM AT THE SITE SHALL BE SUBJECT TO THE INSPECTION OF THE SITE INSPECTOR. THE MANUFACTURER WILL FURNISH THE SITE INSPECTOR WITH SUCH INFORMATION AS MAY BE NECESSARY TO KEEP HIM FULLY INFORMED AS TO PROGRESS OF WORK AND DATES WHEN SITE WORK WILL OCCUR. THE CONTRACTOR SHALL NOTIFY THE INSPECTION AGENCY AT LEAST 48 HOURS PRIOR TO COMMENCING WORK.

THE CONTRACTOR SHALL VERIFY THAT THE DISTRICT'S SITE IS READY TO RECEIVE THE CLASSROOM(S) PRIOR TO THE DELIVERY OF ANY CLASSROOM(S) BY VISITING EACH SITE (THIS MAY BE DONE BY THE INSPECTOR).

REVISIONS		
NO	DATE	DESCRIPTION

DATE: 2/24/09
SCALE: NOTED
DRAWN BY: DM
SERIAL NO.:

CUSTOMER:
12'X40' RELOCATABLE BUILDING
GENERAL NOTES



APPROVALS:

	IDENTIFICATION STAMP DIV. OF THE STATE ARCHITECT 03-112985 AC HFLS SS ME DATE: 2/24/09	IDENTIFICATION STAMP OFFICE OF REGULATION SERVICES PC 02-109808 ACTV REV'D SSS 2/24/09 DATE: 2/24/09
--	--	--

PROJECT No.
N1

THESE DRAWINGS AND SPECIFICATIONS ARE THE PROPERTY OF AMERICAN MODULAR SYSTEMS, INC. AND ARE NOT TO BE REPRODUCED, CHANGED OR COPIED IN ANY FORM OR MANNER, NOR ARE THEY TO BE ASSIGNED TO ANY THIRD PARTY WITHOUT THE WRITTEN AUTHORIZATION OF AMERICAN MODULAR SYSTEMS, INC.

**MATERIALS AND WORKMANSHIP**

ALL CONTRACTORS SHALL CERTIFY THAT NO ASBESTOS-CONTAINING BUILDING MATERIALS WHICH EXCEED STATE AND FEDERAL MANDATED SAFE ASBESTOS LEVELS HAVE BEEN USED IN THE CONSTRUCTION OF RELOCATABLE FACILITIES.

ALL WORKMEN SHALL BE SKILLED AND QUALIFIED FOR THE WORK WHICH THEY PERFORM. ALL MATERIALS USED UNLESS OTHERWISE SPECIFIED SHALL BE NEW AND OF THE TYPES AND GRADES SPECIFIED. THE CONTRACTOR SHALL, IF REQUESTED, FURNISH EVIDENCE SATISFACTORY TO THE ARCHITECT THAT SUCH IS THE CASE.

CONTRACTOR'S CREWS ASSIGNED TO ANY WORK PERFORMED UNDER THIS CONTRACT SHALL INCLUDE ONE COMPETENT AND FULLY EXPERIENCED PERSON DESIGNATED AS THE RESPONSIBLE PERSON IN CHARGE. SUCH PERSON MUST BE IDENTIFIED BY NAME TO THE DISTRICT IN ADVANCE OF ANY WORK. UPON REQUEST, THE CONTRACTOR SHALL PROMPTLY FURNISH TO THE DISTRICT INFORMATION RELATING TO THIS EMPLOYEE'S EXPERIENCE.

WORKMANSHIP SHALL BE EQUAL OR BETTER IN QUALITY TO THAT REQUIRED BY THE CONSTRUCTION TRADES FOR A FINISHED PRODUCT. A QUALITY CONTROL SUPERVISOR, DESIGNATED BY THE MANUFACTURER, SHALL REVIEW ALL WORK IN PROGRESS AND SHALL REVIEW THE FINISHED BUILDING PRIOR TO FINAL INSPECTION TO ASSURE IT IS COMPLETE AND CORRECT. THE QUALITY CONTROL SUPERVISOR SHALL HAVE THE AUTHORITY TO HAVE MATERIALS REPLACED AND WORK REDONE IN ORDER TO CORRECT FAULTY MATERIALS OR WORKMANSHIP.

**GENERAL DESIGN REQUIREMENTS:**

UP TO (1) APPROXIMATELY 12' x 40' MODULES DESIGNED SO THAT TWO MODULES MAY BE JOINED TOGETHER TO FORM A COMPLETE STRUCTURE TO MAINTAIN A POSITIVE ALIGNMENT OF FLOORS, WALLS, AND ROOF AND TO PERMIT SIMPLE NON-DESTRUCTIVE DETACHMENT FOR FUTURE RELOCATION.

EACH MODULE SHALL BE PERMANENTLY IDENTIFIED WITH AN IMPRINTED (STAMPED NOT ENGRAVED) METAL IDENTIFICATION TAG 3"x1 -1/2" MINIMUM SIZE WITH THE FOLLOWING INFORMATION:

1. MANUFACTURER'S NAME AND BUILDING SERIAL NUMBER.
2. DESIGN WIND LOAD / EXPOSURE
3. DESIGN ROOF LIVE LOAD
4. DESIGN FLOOR LIVE LOAD
5. D.S.A. APPLICATION NUMBER.

2-TAGS PER MODULE ONE ON EXTERIOR AND ONE ON MODULE BEAM AT FRONT OF BUILDING ABOVE CEILING.

EACH MODULE SHALL BE CAPABLE OF RESISTING ALL VERTICAL AND LATERAL LOADS DURING TRANSPORTATION AND RELOCATION. (NORMAL INDUSTRY PRACTICE FOR BRACING MODULES DURING TRANSPORTATION AND RELOCATIONS IS ACCEPTABLE.) WHEN MODULES ARE ASSEMBLED JOINTS SHALL BE SEALED WITH REMOVABLE CLOSING STRIPS OR OTHER METHOD TO PRESENT A FINISHED APPEARANCE AND BE PERMANENTLY WATERPROOF.

EACH MODULE SHALL BE SUFFICIENTLY RIGID TO BE JACKED UP AT THE FRONT AND BACK CORNERS FOR RELOCATION WITHOUT DAMAGE OR THE MODULE SHALL HAVE LIFT LUGS AT FRONT AND BACK LOCATED AS REQUIRED SO THAT THE MODULE MAY BE JACKED UP FOR RELOCATION IN ONE PIECE WITHOUT ADDITIONAL SUPPORTS OF ANY TYPE. EVIDENCE OF EXCESSIVE BOWING DURING THE INSTALLATION OF THE MODULES WHICH, IN THE OPINION OF THE AGENCY ARCHITECT OR STRUCTURAL ENGINEER, CAUSES EXCESSIVE WORKING AT ANY JOINT OR COMPROMISES THE STRUCTURAL INTEGRITY OF THE MODULE SHALL BE SUFFICIENT REASON FOR REJECTION OF THE MODULE.

FINISH AND BASE MATERIALS AT EACH MODULE SHALL TERMINATE AT INTERIOR MODULE JOINTS IN A MANNER TO JOIN FLUSH AND TIGHT WITH SAME MATERIAL IN ADJACENT MODULE SO THE MODULE MAY BE RELOCATED WITH MINIMUM CUTTING AND PATCHING.

**MARKERBOARD SPECIFICATIONS**

MARKERBOARDS SHALL BE 24 ga. PORCELAIN STEEL FACING SHEET SUITABLE TO ACCEPT DRY ERASE FLET MARKERS. THE FACING SHEET SHALL BE LAMINATED TO PARTICLE BOARD SUBSTRATE WITH A MINIMUM DENSITY OF 45#/c. ft. THE PANEL SHALL HAVE A FOIL BACKING. THE PANELS SHALL HAVE EXTRUDED ALUMINUM MOLDING AND CHALKRAIL WITH A MINIMUM OF 2-1/8" PROJECTION FROM THE FACE OF PANEL. THREE MAP HOOKS WITH CLIPS PER PANEL SHALL BE PROVIDED. ONE FLAG HOLDER, 1/2" SIZE SHALL BE PROVIDED FOR EACH CLASSROOM. EACH CLASSROOM SHALL HAVE 2 EACH 4 X 8 PANELS INSTALLED SIDE BY SIDE TO MAKE A 4 X 16 PANEL, CENTERED ON THE LONG WALLS. REFERENCE BRANDS: CHATFIELD-CLARKE Co, Inc. SERIES 500 OR NELSON ADAMS Co. NACO SERIES 60.

**NOTE:**

WALL FINISH MATERIAL	PIPE INSULATION
FLAME SPREAD MAX = 200	FLAME SPREAD MAX = 25
SMOKE DENSITY MAX = 450	SMOKE DENSITY MAX = 450
BUILDING INSULATION	DUCT INSULATION
FLAME SPREAD MAX = 25	FLAME SPREAD MAX = 25
SMOKE DENSITY MAX = 450	SMOKE DENSITY MAX = 50

**INTERIOR**

1. FLOOR: CARPETS - CLASSROOM SHALL BE CARPETED AS INDICATED ON FLOOR PLAN WITH DIRECT GLUE DOWN TYPE PER STATE OF CALIFORNIA SPECIFICATION 7220-XXX-01, GROUP 1, TYPE A, CLASS 26. COLOR WILL BE SELECTED BY ARCHITECT AFTER AWARD OF BID. THE CARPET DENSITY SHALL BE 4600 MINIMUM. PILE YARN SHALL BE BRANDED NYLON. NO CROSS SEAMS SHALL BE ALLOWED. PILE HEIGHT 1/2" MAX
2. BASE: RESILIENT COVE BASE - BEST QUALITY, MOULDED RUBBER, 1/8" THICK, 4" HIGH, MOULDED TOP SET COVE. PROVIDE PREFORMED BASE FOR SQUARE EXTERNAL CORNERS AND PREFORMED END STOPS WHERE BASE DOES NOT ABUT. SOLID COLOR AS MANUFACTURED BY "JOHNSONITE CO.", FLEXCO, OR EQUAL. APPLY COVE TO COMPLETE PERIMETER OF CLASSROOM.
3. INTERIOR WALLS SHALL BE VINYL COVERED TACKBOARD(U.O.N.) APPLIED IN ONE CONTINUOUS LENGTH FROM FLOOR TO CEILING. THE TACKBOARD SHALL BE INDUSTRIAL INSULATION BOARD MANUFACTURED SPECIFICALLY AS A SUBSTITUTE FOR VINYL COVERED WALL PANELS. THE BOARD SHALL BE ASPHALT FREE, SHALL HAVE AN IRONED-ON COATING AND SHALL HAVE A MINIMUM DENSITY OF 18 LBS. PER FT. THE VINYL COATING SHALL BE MADE OF VIRGIN VINYL CALENDERED BASE COLOR, WEIGHING A MINIMUM OF 8 OZ. PER SQUARE YARD. THE COATING BACKING SHALL BE SHEETING OR NON-WOVEN FABRIC. THE VINYL COATING SHALL BE MECHANICALLY LAMINATED, WITH THE LONG EDGES WRAPPED, TO THE TACKBOARD. TACKBOARD SHALL BE APPLIED OVER 1/2" SHEETROCK OR PLYWOOD SHEATHING. THE VINYL WALL COVERED PANEL SHALL HAVE A CLASS III FLAME SPREAD RATING. THE PANEL SHALL BE APPROVED FOR CLASSROOM USE BY THE CALIFORNIA STATE FIRE MARSHAL. REFERENCE BRAND: VINYL COVERED TACKBOARD AS MANUFACTURED BY CHATFIELD-CLARKE OR COMPARABLE. CARE SHALL BE TAKEN IN MOUNTING THE TACKBOARD SO THAT THE TEXTURE OF ALL PANELS WILL HAVE THE SAME ORIENTATION AND COLOR MATCH.
4. CEILING: SUSPEND T-BAR SYSTEM, SEE SHEET 3 FOR DETAILS ETC. MATERIALS AND INSTALLATION PER CCR 2501A.5 AND IR #M-3 INCLUSIVE AS APPLICABLE TO CLASSROOMS.

**DOORS & WINDOWS**

EXTERIOR DOORS: METAL DOORS - 3'-0"x7'-0" HOLLOW METAL DOOR CONSTRUCTION OF 1 SHEET OF 18 GA. GRADE II STEEL ASSEMBLED PER CS242 MIN AND REINFORCED WITH 20 GA. MIN. FILL DOOR SPACES WITH MINERAL WOOL OR OTHER INSULATION. (REINFORCE BOTH FACES FOR CLOSURE) PROVIDE FLUSH TOP ON DOORS. HARDWARE REINFORCEMENT SHALL BE 10 GA. MIN FOR HINGES, DOOR FRAME SHALL BE 16 GA. PRESSED STEEL FRAME ASTM A366 & CS242. HARDWARE REINFORCEMENT SHALL BE 10 GA. PLATE. FRAMES SHALL BE DESIGNED WITH INTEGRAL STOP AND TRIM. PROVIDE (3) ANCHORS PER JAMB PLUS ADJUSTABLE FLOOR ANCHOR.

EXTERIOR WINDOWS: PROVIDE ANODIZED ALUMINUM FRAME 5/8" MINIMUM DUAL PANE WINDOW UNITS, AS SHOWN ON FLOOR PLANS. THE 5/8" DIMENSION IS THE MINIMUM THICKNESS FOR THE DUAL GLAZED WINDOW PANEL CONSISTING OF TWO LIGHTS OF GLASS AND THE AIR SPACE. GLAZING MATERIAL SHALL BE:

EXTERIOR LITE - 3/16" MINIMUM TEMPERED GLASS OR LAMINATED AS - 1 CLASS OF SOLAR GRAY GLARE REDUCING TYPE WITH A LIGHT TRANSMISSION FACTOR OF 45% MAXIMUM. INTERIOR LITE - 1/8" MINIMUM CLEAR TEMPERED. MINIMUM AIR SPACE SHALL BE 1/4".

SPACE - BENT OR SEALED CORNER ALUMINUM WITH DESICCANT FILL SEALER - BUTYL PRIMARY SEAL AND POLYSULFIDE OF SILICONE SECONDARY SEAL. CERTIFICATION - ALL GLAZING TO BE CERTIFIED IN ACCORDANCE WITH ASTM E-773, E-774. HEADER HEIGHT SHALL BE THE SAME AS THE DOOR. ALL OPERABLE SASH SHALL HAVE ALUMINUM SCREENS. WINDOWS SHALL NOT BE MOUNTED TO THE EXTERIOR PLYWOOD SURFACE. ALL WINDOWS SHALL MEET THE AAMA GS101-88 VOLUNTARY. SPEC. FOR ALUMINUM PRIME WINDOWS AND SLIDING GLASS (ANSI), COMMERCIAL GRADE.

**HARDWARE**

1. EXTERIOR DOOR
  - A) HINGES: HAGER 4-1/2x4-1/2 BUTTS, BB1279 US26D, 1-1/2 PAIR EACH DOOR WITH SET SCREW IN BARREL AND BALL BEARING DESIGN, OR APPROVED EQUAL.
  - B) EXTERIOR LOCKSET: SCHLAGE N070PD CORBIN OR YALE OR EQUIVALENT. ALUM. FINISH. OR PANIC BARS/PULL HANDLE PANIC BAR TYPE VON DUPRIN 22L (PULL ON EXT.) OR CORBIN OR YALE OR EQUIVALENT. ALUM. FINISH. PANIC BARS ARE ONLY REQUIRED WHERE THE OCCUPANT LOAD IS 50 OR MORE.
  - C) CLOSER: NORTON 8500DA OR 8500BF SERIES, LCN 1460 DEL SERIES OR EQUAL. MAXIMUM 5 LBS FOR EXTERIOR AND INTERIOR DOORS. THE MAXIMUM EFFORT FOR FIRE DOORS MAY BE INCREASED TO THE MAXIMUM ALLOWED BY THE APPROPRIATE ADMINISTRATIVE AUTHORITY, NOT TO EXCEED 15 LBS. THE SWEEP PERIOD FROM AN OPEN POSITION OF 70 DEGREES SHALL BE AT LEAST 3 SECONDS TO MOVE TO A POINT 3 INCHES FROM THE LATCH, MEASURED TO THE LEADING EDGE OF THE DOOR.
  - D) WEATHERSTRIPPING: ALL EXTERIOR DOORS SHALL BE WEATHERSTRIPPED WITH PEMKO 299D, ULTRA WS007, AT DOOR JAMBS AND HEAD OR EQUAL.
  - E) THRESHOLD: THRESHOLD SHALL BE PEMKO 271 AV 5" ALUMINUM WITH PEMKO 216 AV ULTRA TH042 DOOR BOTTOM.
  - F) DOORSTOP: QUALITY #44, OR EQUAL.
  - D) INTERIOR LOCKSET: SCHLAGE LEVER HANDLE LOCKSET, AS FOLLOWS:
 

STUDENT TOILETS	S10A PASSAGE LATCH OR EQUAL
OFFICES	S70D CLASSROOM LOCKSET OR EQUAL
CUSTODIAL	S80A LOCKSET OR EQUAL
PUBLIC TOILETS	S40A PRIVACY LATCHSET OR EQUAL

**FIRE EXTINGUISHER**

1. EACH PORTABLE CLASSROOM SHALL BE EQUIPPED WITH PRESSURE TYPE FIRE EXTINGUISHERS WITH 2A10BC UL RATING. TO BE MOUNTED ON THE INTERIOR WALL OF THE BUILDING NEAR THE DOORWAY(S) AT A MAXIMUM HEIGHT OF 4 FEET TO THE MOUNTING BRACKET AND THE BOTTOM OF FE MOUNTED 27" AFF. FIRE EXTINGUISHERS SHALL BE TOTALLY CHARGED AND HAVE A DIAL INDICATING THE STATE OF CHARGE.

**ACCESSIBILITY STANDARDS**

2007 CALIFORNIA BUILDING CODE (PART 2, TITLE 24, CCR) SEC. 1103B.1 BUILDING ACCESSIBILITY, GENERAL. THE 2007 CBC REQUIRES THAT BUILDINGS EXCEEDING 10,000 SQUARE FEET ON ANY FLOOR MUST HAVE AN ACCESSIBLE MEANS OF VERTICAL ACCESS VIA RAMP, ELEVATOR, OR LIFT WITHIN 200 FEET OF TRAVEL OF EACH STAIR AND EACH ESCALATOR. TABLE 1115B-1 SUGGESTED DIMENSIONS FOR CHILDREN'S USE. THE 2007 CBC REQUIRES A 27" MINIMUM DIMENSION FOR LAVATORY/SINK CLEARANCE, WHICH IS THE DISTANCE FROM THE FINISH FLOOR TO THE UNDERSIDE OF THE LAVATORY/SINK. SECTION 1115B.3.1 ACCESSIBLE WATER CLOSET COMPARTMENT. THE 2007 CBC REQUIRES AN ACCESSIBLE TOILET STALL TO HAVE A MINIMUM WIDTH OF 60" AND SHALL BE EQUIPPED WITH A DOOR THAT HAS AN AUTOMATIC-CLOSING DEVICE, AND SHALL HAVE A CLEAR, UNOBSTRUCTED OPENING WIDTH OF 32 INCHES WHEN LOCATED AT THE END AND 34 INCHES WHEN LOCATED AT THE SIDE WITH THE DOOR POSITIONED AT AN ANGLE OF 90 DEGREES FROM ITS CLOSED POSITION. THE INSIDE AND OUTSIDE OF THE COMPARTMENT DOOR SHALL BE EQUIPPED WITH A LOOP OR U-SHAPED HANDLE IMMEDIATELY BELOW THE LATCH. THE LATCH SHALL BE FLIP-OVER STYLE, SLIDING OR OTHER HARDWARE NOT REQUIRING THE USER TO GRASP OR TWIST. EXCEPT FOR DOOR-OPENING WIDTHS AND DOOR SWINGS, A CLEAR, UNOBSTRUCTED ACCESS OF NOT LESS THAN 44 INCHES SHALL BE PROVIDED TO THE WATER CLOSET COMPARTMENTS DESIGNED FOR USE BY PERSONS WITH DISABILITIES. SECTION 1115B.4.4.4. WATER CONTROLS. THE 2007 CBC REQUIRES THAT THE FORCE TO OPERATE A WATER CONTROL (VALVE) FOR AN ACCESSIBLE SHOWER SHALL NOT EXCEED 5LBS. MAXIMUM FORCE (PULL). SECTION 1117B.5 SIGNS AND IDENTIFICATION (ALSO REFER TO SECTIONS 1115B.6, 1116B, 1007.6.5 1007.7, 1008.1.8.6, 1011.3, 1020.1.5 & 1020.1.6.1-5. THE 2007 CBC MAKES SEVERAL GENERAL DESIGN CHANGES AND CLARIFICATIONS TO SIGNAGE. \*ALL GROUND FLOOR EXIT DOOR SHALL HAVE TACTILE EXIT SIGNAGE. \*AT STAIRS, EACH FLOOR SHALL RECEIVE TACTILE "STAIR LEVEL" SIGNAGE IN ADDITION TO SPECIAL TACTILE AT THE EXIT DISCHARGE LEVEL. \*EACH EXIT DOOR THAT LEADS TO A GRADE LEVEL EXIT BY MEANS OF A STAIRWAY SHALL HAVE TACTILE EXIT SIGNAGE. \*EACH EXIT ACCESS DOOR TO A CORRIDOR OR HALLWAY THAT IS REQUIRED TO HAVE A VISUAL EXIT SIGN SHALL BE IDENTIFIED BY TACTILE EXIT SIGNAGE. SECTION 1129B ACCESSIBLE PARKING REQUIRED. THE 2007 CBC REQUIRES THE WORDS "NO PARKING", IN 12" HEIGHT WHITE LETTERS, TO BE PAINTED ON THE PAVEMENT WITHIN ALL PARKING SPACE ACCESS AISLES. VAN PARKING ACCESS AISLES SHALL BE PLACED ON THE PASSENGER SIDE OF THE VEHICLE. RAMP MAY NOT ENDOACH INTO ANY REQUIRED ACCESS AISLE. PARKING SPACE ACCESS AISLES SHALL NOT EXCEED 2% SLOPE IN ANY DIRECTION. \*EXISTING SITES: AT EXISTING SITES, ANY RAMP WHICH EXCEEDS A 2% SLOPE ACCESS AISLES FOR ACCESSIBLE PARKING SPACES PER CBCS SECTION 1129B, MAY REQUIRED REMOVAL AND REDESIGN PER THE PATH OF TRAVEL (POT) PROVISIONS OF CBCS SECTION 1134B, IN ORDER TO APPROVE THE BUILDING PLACEMENT. SECTION 1133B.2.5 CLOSER EFFORT TO OPERATE DOORS. THE 2007 CBC REQUIRES THAT THE EFFORT TO OPEN AN EXTERIOR DOOR SHALL NOT EXCEED 5 POUNDS (PULL). THE 2007 CBC REQUIRES THAT THE SWEEP PERIOD OF ACCESSIBLE DOORS SHALL BE 3 SECONDS MAXIMUM, BASED ON AN OPEN DOOR POSITION OF 70 DEGREES (FROM CLOSED), TO A DOOR POSITION OF 3" FROM THE LATCH. SECTIONS 1133B.2.4.5 & 1133B.2.5.3 RECESSED DOORS. THE 2007 CBC REQUIRES THAT DOORS RECESSED 8" OR MORE SHALL HAVE STRIKE EDGE CLEARANCES IN ACCORDANCE WITH FIGURE 11B-33 (A). SECTION 1133B.4.2.4 HANDRAIL ORIENTATION. THE 2007 CBC SPECIFIES THAT AT LEAST ONE HANDRAIL SHALL BE PARALLEL TO THE DIRECTION OF THE STAIR RUN, AND PERPENDICULAR TO THE EDGE OF THE STAIR NOSING. SECTION 1133B.5.2 RAMP WIDTH: MINIMUM 48" CLEAR AT OCCUPANT LOAD 300 OR LESS, 60" CLEAR AT OCCUPANT LOAD MORE THAN 300. RADIUS MINIMUM OF 0.125" THE 2007 CBC REQUIRES THAT SIGN EDGES LESS THAN 80" ABOVE THE FINISHED FLOOR MUST CONTAIN ROUNDED OR EASED RADIUS MINIMUM OF 0.125" THE PROJECT PLANS OR SPECIFICATIONS SHALL INDICATE THE REQUIREMENT THAT THE MANUFACTURER SHALL PROVIDE A WRITTEN FIVE-YEAR PRODUCT WARRANTY, IN ACCORDANCE WITH THE BULLETIN.

1. ALL GALVANIZED STUDS AND JOISTS SHALL BE FORMED FROM STEEL THAT CORRESPONDS TO THE MINIMUM REQUIREMENTS OF THE 2001 AISI/COS/ANSI.
2. ALL GALVANIZED STUDS, JOISTS, TRACK, BRIDGING AND ACCESSORIES SHALL BE FORMED FROM STEEL HAVING A GALVANIZED COATING MEETING THE REQUIREMENTS OF ASTM A 653.
3. GALVANIZED FRAMING PRODUCTS SHALL BE COATED IN ACCORDANCE WITH REQUIREMENTS OF ASTM A 653. PRODUCTS WILL BE FURNISHED WITH A G-60 OR EQUIVALENT COATING IF SPECIFIED AND ORDERED TO BE IN CONFORMANCE WITH ASTM C-955 OTHERWISE, G-40 OR EQUIVALENT COATING WILL BE PROVIDED.

1. SECTION PROPERTIES SHALL BE DERIVED IN ACCORDANCE WITH AISI " SPECIFICATION FOR DESIGN OF COLD-FORMED STEEL STRUCTURAL MEMBERS, LATEST EDITION."
2. METAL DECKING IS TO BE ATTACHED TO THE STRUCTURAL FRAME IN CONFORMANCE WITH AWS D1.1 AND D1.3 "SPECIFICATION FOR WELDING SHEET STEEL IN STRUCTURES."
3. ASTM REFERENCE NUMBERS: A) ASTM A653, STEEL SHEET, ZINC-COATED (GALVANIZED) OR ZINC-IRON ALLOY-COATED (GALVANNEALED) BY THE HOT-DIP PROCESS STRUCTURAL (PHYSICAL) QUALITY.
4. STEEL DECK INSTITUTE (SDI)-METAL FLOOR DECK PROFILES SHALL BE IN CONFORMANCE WITH SDI STANDARDS.
5. METAL FLOOR DECK TO BE ASC STEEL DECK
  1. B-36, 18 GAUGE
  - 1 1/2" DEEP X 36" WIDE
  2. N-24, 18 GAUGE
  - 3" DEEP X 24" WIDE
6. DECK UNITS ARE TO BE FABRICATED FROM SHEET STEEL CONFORMING TO ASTM A653, Fy=38 KSI WITH A GALVANIZED COATING, G-60 OR G-90.

REVISIONS		
NO	DATE	DESCRIPTION

DATE: 2/24/09  
SCALE: NOTED  
DRAWN BY: DM  
SERIAL NO.:

CUSTOMER:  
**12'X40' RELOCATABLE BUILDING  
GENERAL NOTES**




APPROVALS:


STATE OF CALIFORNIA ARCHITECTURE No. C12881 Rev. 5-24-05 IDENTIFICATION STAMP DIV. OF THE STATE ARCHITECT OFFICE OF REGULATION SERVICES PC 02-109808 03-11-2009 AC FLS SS DATE 2/24/09

PROJECT No.  
**N2**

THESE DRAWINGS AND SPECIFICATIONS ARE THE PROPERTY OF AMERICAN MODULAR SYSTEMS, INC. AND ARE NOT TO BE REPRODUCED, CHANGED OR COPIED IN ANY FORM OR MANNER, NOR ARE THEY TO BE ASSIGNED TO ANY THIRD PARTY WITHOUT THE WRITTEN AUTHORIZATION OF AMERICAN MODULAR SYSTEMS, INC.

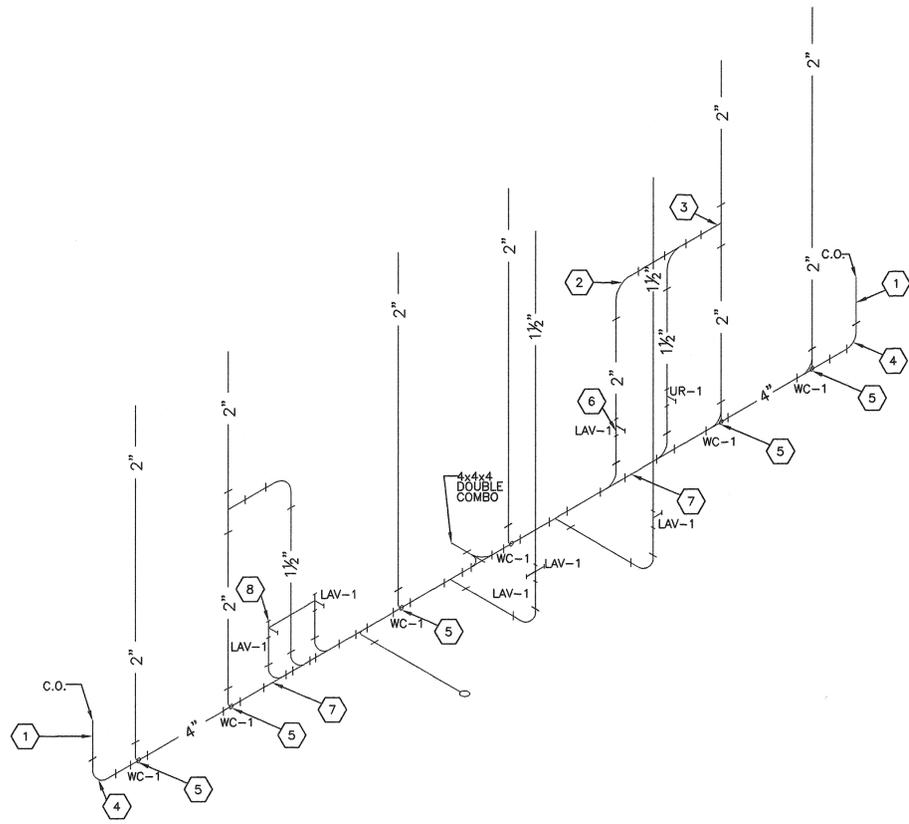


3C WASTE ISOMETRIC  
P1 NO SCALE

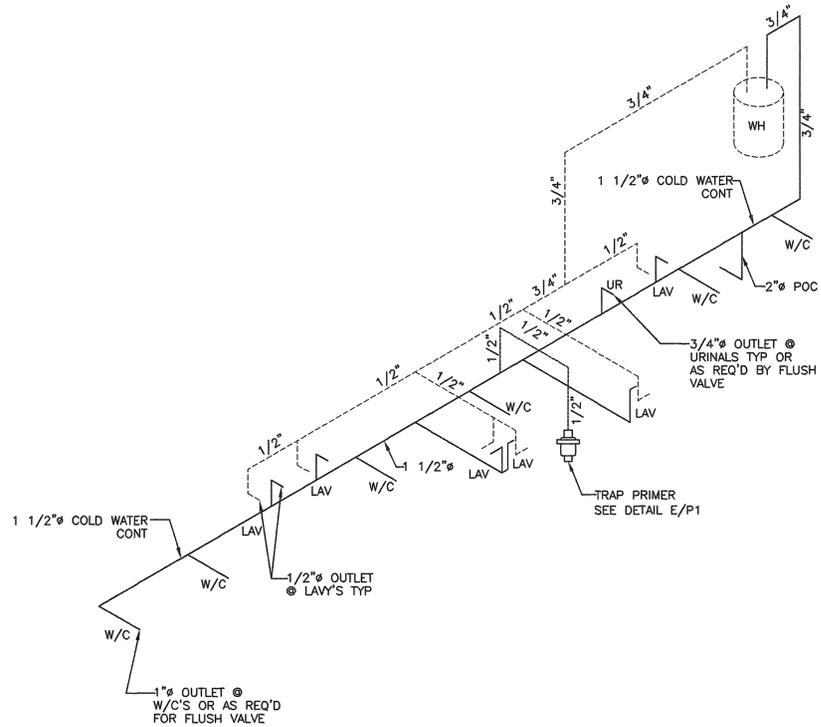


3B WATER SUPPLY ISOMETRIC  
P1 NO SCALE

3A RESTROOM OPTION #3  
P1 NO SCALE


— COLD WATER  
- - - - - HOT WATER

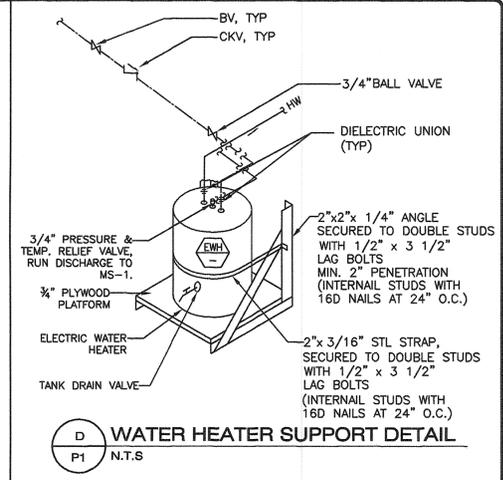

D WATER HEATER SUPPORT DETAIL  
P1 N.T.S

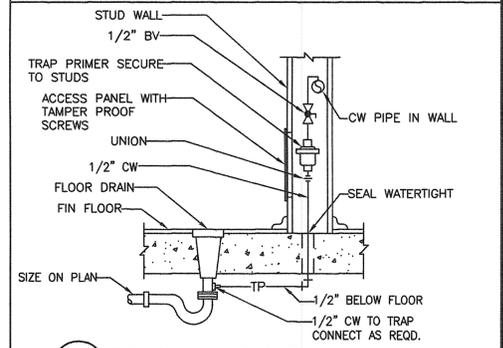

E TRAP PRIMER DETAIL  
P1 N.T.S

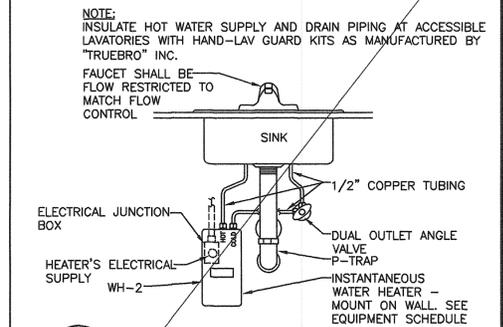

F INSTANT WATER HEATER DETAIL  
P1 N.T.S

SHEET NOTES

- DWV PIPING SHALL BE ABS PLASTIC
- COLD WATER SUPPLY SHALL BE TYPE L COPPER
- DWV PIPING:
  - MIN SLOPE 1/4" PER FOOT
  - MAY SLOPE 4" CI @ 1/8" PER FOOT
  - VENTS SHALL TERMINATE NOT LESS THAN 10 FEET FROM OR AT LEAST 3 FT. ABOVE ANY WINDOW, DOOR, AIR INTAKE OR VENT SHAFT, NOR LESS THAN 3 FT. IN EVERY DIRECTION FROM ANY LOT LINE, ALLEY AND STREET EXCEPTED; EXTEND 6" ABOVE THE ROOF

BASED ON PC# 02-109808

REVISIONS		
NO	DATE	DESCRIPTION


DATE: 01/19/10  
SCALE: NOTED  
DRAWN BY: MP  
SERIAL NO.:

CUSTOMER:  
BAKERSFIELD SCHOOL DISTRICT  
MUNSEY ELEMENTARY SCHOOL

12 x 40 RELOCATABLE BUILDING  
ISOMETRIC PLANS & DETAILS

**AMS**  
American Modular Systems Inc.  
787 Sprackels Ave, Manteca, CA 95336  
(209)925-1921 Fax: (209)925-7018  
americanmodular.com

APPROVALS:

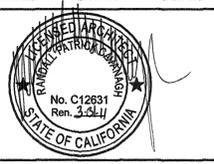

IDENTIFICATION STAMP  
DIV. OF THE STATE ARCHITECT  
OFFICE OF REGULATION SERVICES

03-112985  
AC, FLS, SS  
DATE 2/10/10

PROJECT No.  
**P1**

THESE DRAWINGS AND SPECIFICATIONS ARE THE PROPERTY OF AMERICAN MODULAR SYSTEMS, INC. AND ARE NOT TO BE REPRODUCED, CHANGED OR COPIED IN ANY FORM OR MANNER, NOR ARE THEY TO BE ASSIGNED TO ANY THIRD PARTY WITHOUT THE WRITTEN AUTHORIZATION OF AMERICAN MODULAR SYSTEMS, INC.

- SHEET NOTES -


- 1 WALL HUNG HVAC UNIT
- 2 THERMOSTAT @ +60" SEALED
- 3 MAIN RUNNER TYP
- 4 CROSS RUNNER TYP
- 5 INTERIOR LIGHT FIXTURE REFER TO SHEET SHEET E1 FOR SPEC'S
- 6 CEILING HEIGHT @ 8'-6" NOM
- 7 SPLAY WIRE SEE 4/M2 FOR DETAILS
- 8 FIXED CEILING END
- 9 FREE CEILING END
- 10 CENTER SECTION THAT CROSSES MODULE LINE TO BE FIELD INSTALLED
- 11 NOT USED
- 12 CONCEALED SUPPLY AIR DUCT ABOVE T-BAR CEILING
- 13 TYPICAL 4-WAY SUPPLY AIR REGISTER LOCATION AND SIZE MAY VARY PER CEILING LAYOUT AND BUILDING SIZE

NOTE:  
WHERE TWO OR MORE HVAC UNITS SERVE A COMMON SPACE, UNITS SHALL BE EQUIPPED WITH DUCT SMOKE DETECTOR FOR AUTO SHUTDOWN. INTERCONNECT WITH FIRE ALARM SYSTEM  
AUTOMATIC SHUT-OFF IS NOT REQUIRED WHEN ALL OCCUPIED ROOMS SERVED BY THE AIR HANDLING EQUIPMENT HAVE DIRECT ACCESS TO THE EXTERIOR AND THE TRAVEL DISTANCE DO NOT EXCEEDS 100 FT. PER CMC 609 EXEPTION #2

EXHAUST FAN						
MARK	DESCRIPTION	CFM	WATTS	S.P.	VOLT/PH	
EF 1	EXHAUST FAN	110	1050	.10"	115-1Ø	NUTONE 672 CEILING MOUNTED 180W INPUT
EF 2	EXHAUST FAN	200	1050	.10"	115-1Ø	CEILING MOUNTED 180W INPUT

BUILDING PLUMBING STANDARDS:

1. TOILETS SHALL BE KOHLER-KINGSTON #K-4330. FLUSH VALVES FOR TOILETS SHALL BE SLOAN-REGAL FLUSHOMETER #111. MOUNTING BRACKET BY J.R SMITH. SEATS SHALL BE BEMIS #1955C.
2. TOILETS MAY BE ALSO BE AMERICAN STANDARD AFWALL #2257.103. MOUNTING BRACKET BY J.R. SMITH #0600. FLUSH VALVES FOR TOILETS SHALL BE SLOAN-REGAL FLUSHOMETER #111. SEATS SHALL BE BEMIS #1955C.
3. LAVATORIES SHALL BE CAST IRON PORCELAIN FINISHED KOHLER-HUDSON #K-2861. STAFF LAVATORIES SHALL BE CHICAGO 3300-CP FAUCETS. STUDENT LAVATORIES SHALL BE CHICAGO 3400-CP FAUCETS. P-TRAP MAY BE DEARBORN BRASS COMPANY #704 ASSEMBLY OR EQUAL 17 GA. P-TRAP. COMPRESSION STOPS MAY BE BRASSCRAFT #OCR 19 CS OR EQUAL. PROVIDE STAINLESS STEEL BRAIDED CONNECTORS AT LEAST 16" LONG. MOUNTING BRACKETS SHALL BE J.R. SMITH #0800.

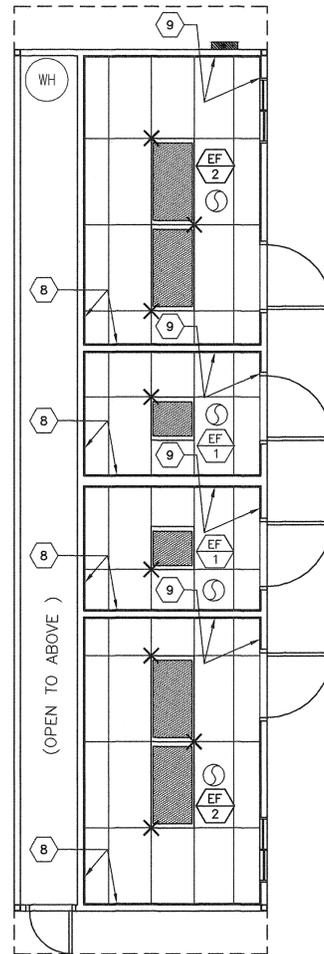

3 TYPICAL REFLECTED CEILING PLAN  
M1 1/4"=1'-0" OPTION #3

BASED ON PC# 02-109808

REVISIONS		
NO	DATE	DESCRIPTION

DATE: 01/13/10  
SCALE: NOTED  
DRAWN BY: RS  
SERIAL NO.:

CUSTOMER:  
BAKERSFIELD SCHOOL DISTRICT  
MUNSEY ELEMENTARY SCHOOL

12'X40' RELOCATABLE BUILDING  
TYPICAL CEILING PLAN & NOTES















APPROVALS:



IDENTIFICATION STAMP  
DIV. OF THE STATE ARCHITECT  
OFFICE OF REGULATION SERVICES  
02-112925  
AC, FLS, SS  
DATE 2/10/10

PROJECT No.  
M1

THESE DRAWINGS AND SPECIFICATIONS ARE THE PROPERTY OF AMERICAN MODULAR SYSTEMS, INC. AND ARE NOT TO BE REPRODUCED, CHANGED OR COPIED IN ANY FORM OR MANNER, NOR ARE THEY TO BE ASSIGNED TO ANY THIRD PARTY WITHOUT THE WRITTEN AUTHORIZATION OF AMERICAN MODULAR SYSTEMS, INC.

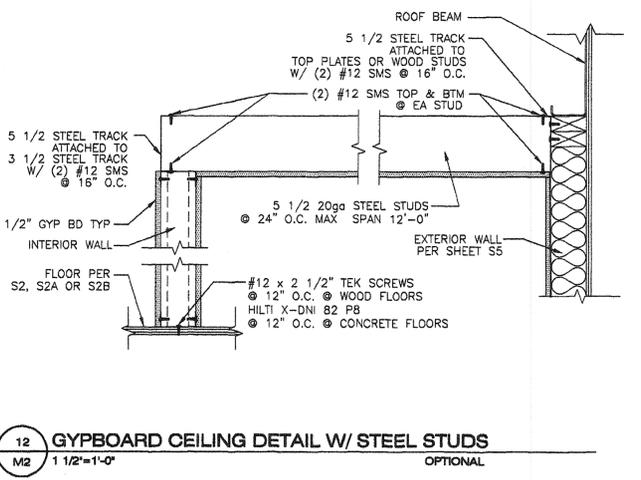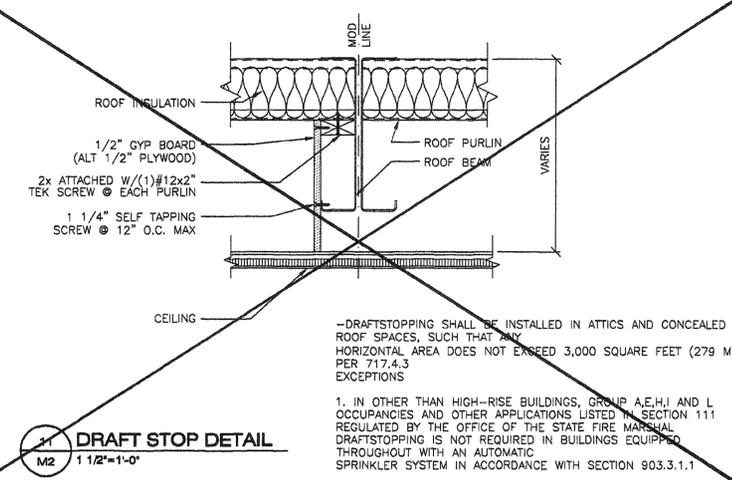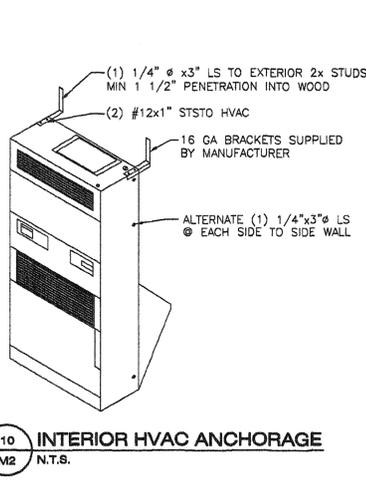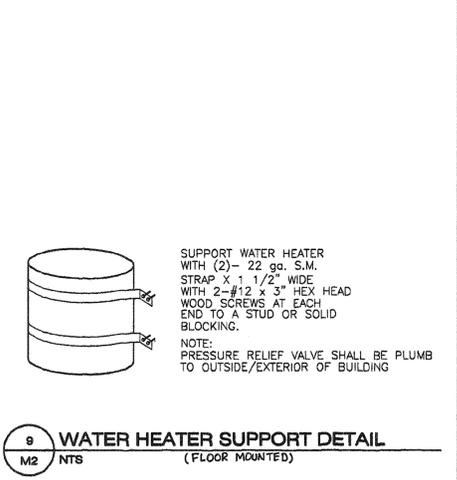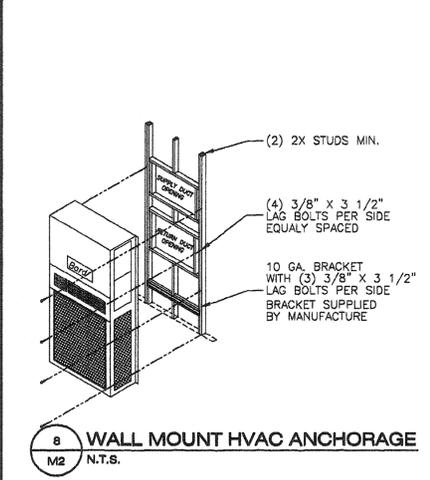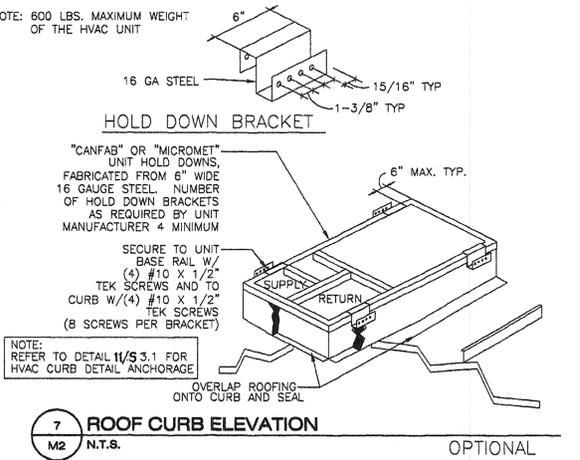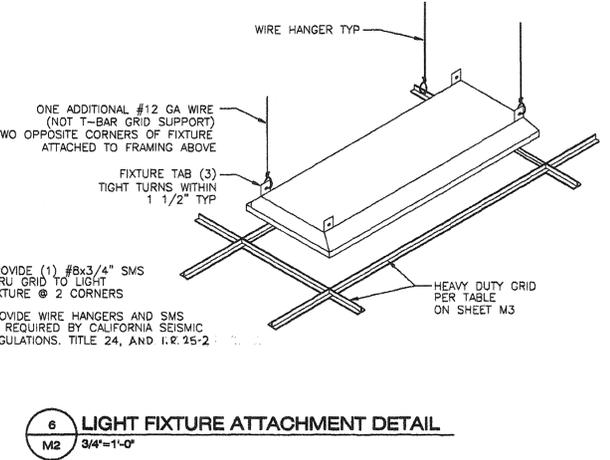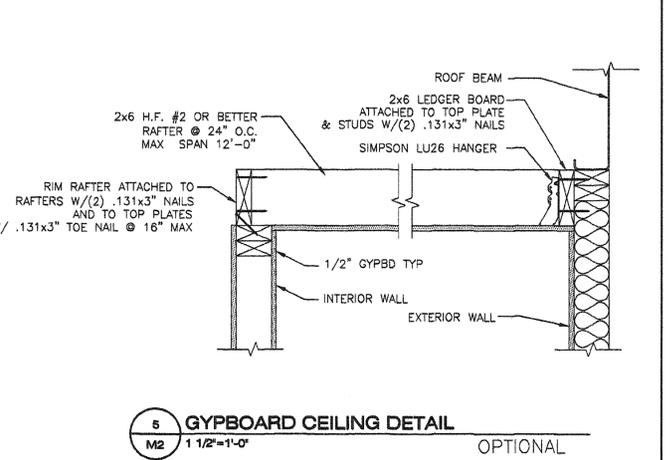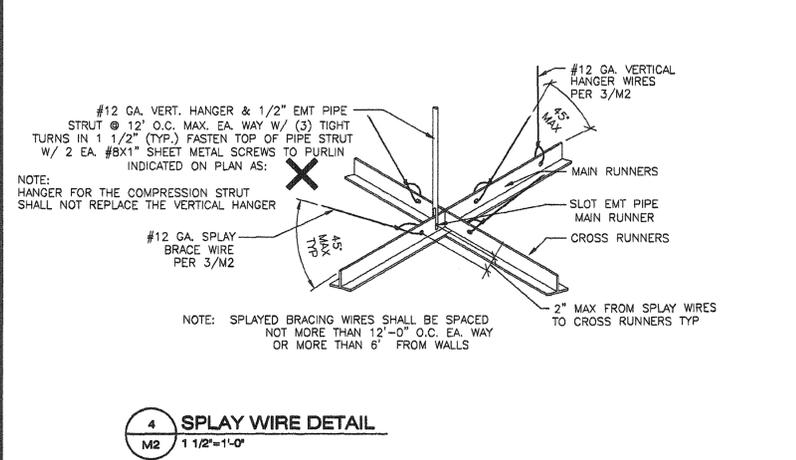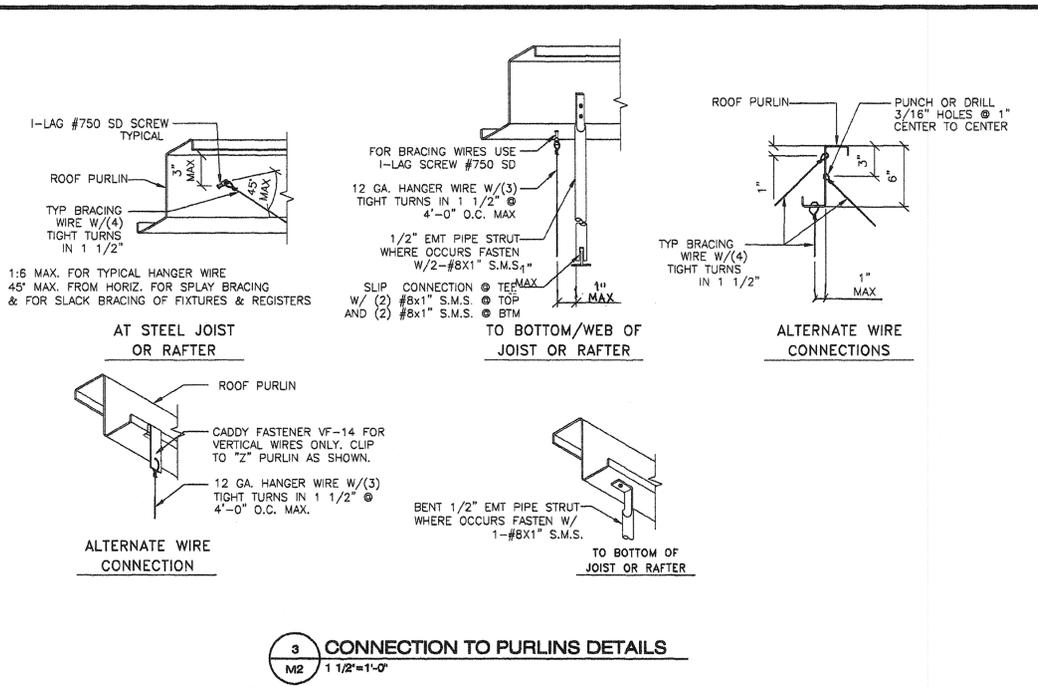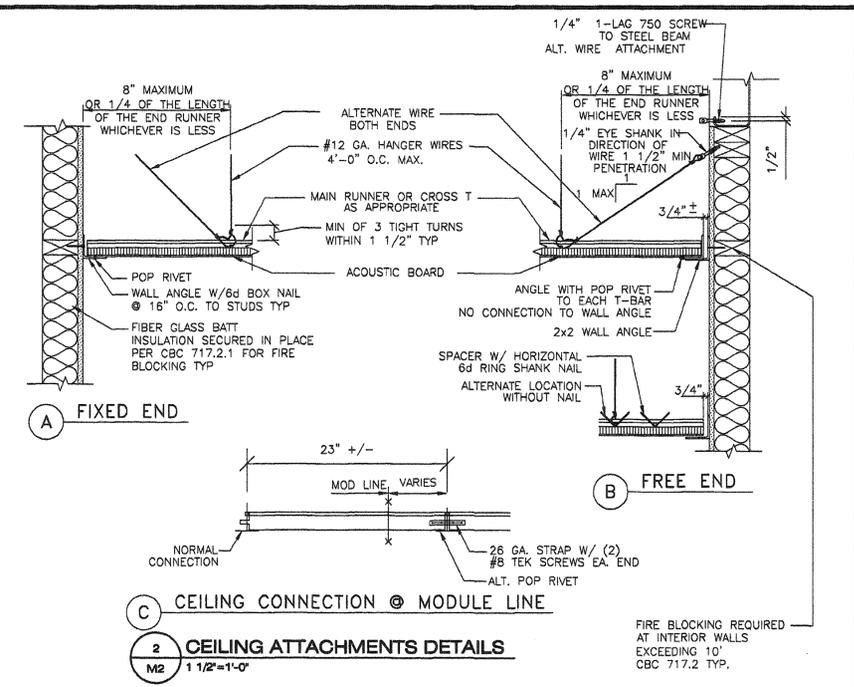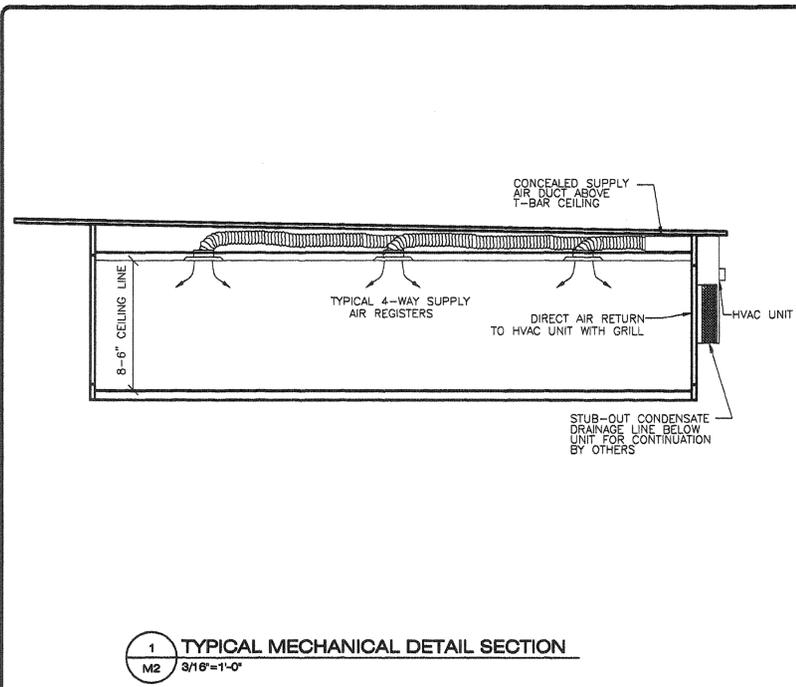

**REVISIONS**


NO.	DATE	DESCRIPTION

DATE: 2/24/09  
SCALE: NOTED  
DRAWN BY: DM  
SERIAL NO.:

CUSTOMER:  
**12'X40' RELOCATABLE BUILDING MECHANICAL BUILDING SECTION & CEILING DETAILS**



APPROVALS:

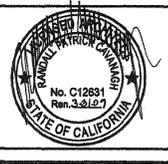

IDENTIFICATION STAMP  
DIV. OF THE STATE ARCHITECT  
1/23/09

IDENTIFICATION STAMP  
OFFICE OF REGULATION SERVICES  
PC 02-109808  
DATE: 2/24/09

PROJECT No.  
**M2**

THESE DRAWINGS AND SPECIFICATIONS ARE THE PROPERTY OF AMERICAN MODULAR SYSTEMS, INC. AND ARE NOT TO BE REPRODUCED, CHANGED OR COPIED IN ANY FORM OR MANNER, NOR ARE THEY TO BE ASSIGNED TO ANY THIRD PARTY WITHOUT THE WRITTEN AUTHORIZATION OF AMERICAN MODULAR SYSTEMS, INC.

**METAL SUSPENSION SYSTEMS FOR LAY IN PANEL CEILING**

- 12 GA. (MIN) HANGER WIRES MAY BE USED FOR UP TO AND INCLUDING 4'-0" x 4'-0" GRID SPACING, ALONG MAIN RUNNER. SPLICES WILL NOT BE PERMITTED IN ANY HANGER WIRES UNLESS SPECIFICALLY APPROVED BY DSA.
  - PROVIDE 12 GA HANGER WIRES WITHIN 8" OF THE ENDS OF ALL MAIN AND CROSS RUNNERS OR AT 1/4 OF THE LENGTH OF THE END TEE, WHICHEVER IS LESS AT THE PERIMETER OF THE CEILING AREA.
  - PROVIDE TRAPEZE OR OTHER SUPPLEMENTARY SUPPORT MEMBERS AT OBSTRUCTIONS TO MAINTAIN HANGER SPACING. PROVIDE ADDITIONAL HANGERS, STRUTS OR BRACES AS REQUIRED AT ALL CEILING BREAKS, SOFFITS OR DISCONTINUOUS AREA. HANGER WIRES THAT ARE MORE THAN 1 IN 6 OUT OF PLUMB ARE TO HAVE COUNTERBRACED WIRES.
  - CEILING GRID MEMBERS MAY BE ATTACHED TO NOT MORE THAN 2 ADJACENT WALLS. CEILING GRID MEMBERS SHOULD BE AT LEAST 1/2 INCH FREE OF OTHER WALLS. IF WALLS RUN DIAGONALLY TO CEILING GRID SYSTEM RUNNERS, ONE END OF MAIN AND CROSS RUNNERS SHOULD BE FREE AND A MINIMUM OF 1/2 INCH CLEAR OF WALL.
  - AT THE PERIMETER OF THE CEILING AREA WHERE MAIN OR CROSS RUNNERS ARE NOT CONNECTED TO THE ADJACENT WALL, PROVIDE INTERCONNECTION BETWEEN THE RUNNERS AT THE FREE END TO PREVENT LATERAL SPREADING. A METAL STRUT OR A 16 GA WIRE WITH A POSITIVE MECHANICAL CONNECTION TO THE RUNNERS MAY BE USED. WHERE THE PERPENDICULAR DISTANCE FROM THE WALL TO THE FIRST PARALLEL RUNNERS IS 12" OR LESS, THIS INTERLOCK IS NOT REQUIRED.
  - PROVIDE SETS OF 4-#12 GA. SPLAYED BRACING WIRES ORIENTED 90 DEGREES FROM EACH OTHER AT THE FOLLOWING SPACING:
    - FOR SCHOOL BUILDINGS, PLACE SETS OF SPLAY WIRES AT A SPACING NOT MORE THAN 12 FEET BY 12 FEET ON CENTER.
    - PROVIDE SPLAY WIRES AT LOCATIONS NOT MORE THAN 1/2 THE ABOVE SPACING FROM EACH PERIMETER WALL OR AT THE EDGE OF VERTICAL CEILING OFFSETS
- THE SLOPE OF THESE WIRES SHOULD NOT EXCEED 45 DEGREES FROM THE PLANE OF THE CEILING AND SHOULD BE TAUT WITHOUT CAUSING THE CEILING TO LIFT. SPLICES IN BRACING WIRES ARE NOT PERMITTED WITHOUT SPECIAL DSA APPROVAL.
- FASTEN HANGER WIRES WITH NOT LESS THAN 3 TIGHT TURNS. FASTEN SPLAY WIRES WITH 4 TIGHT TURNS. MAKE ALL TIGHT TURNS WITHIN A DISTANCE OF 1 1/2 INCHES. HANGER OR BRACING WIRE ANCHORS TO THE STRUCTURE SHOULD BE INSTALLED IN SUCH A MANNER THAT THE DIRECTION OF THE WIRE ALIGNS AS CLOSELY AS POSSIBLE WITH THE DIRECTION OF THE FORCES ACTING ON THE WIRE.
  - SEPARATE ALL CEILING HANGING AND BRACING WIRES AT LEAST 6 INCHES FROM ALL UNBRACED DUCTS, PIPES, CONDUIT ETC.,
  - ATTACH ALL LIGHT FIXTURES AND AIR TERMINALS TO THE CEILING GRID RUNNERS WITH SCREWS OR APPROVED FASTENERS AS REQUIRED TO RESIST A HORIZONTAL FORCE EQUAL TO THE FIXTURES.
  - FLUSH OR RECESSED LIGHT FIXTURES AND AIR TERMINALS WEIGHING LESS THAN 56 POUNDS MAY BE SUPPORTED DIRECTLY ON THE RUNNERS OF A HEAVY DUTY GRID SYSTEM BUT, IN ADDITION, THEY MUST HAVE A MINIMUM OF 2-#12 GA. SLACK SAFETY WIRES ATTACHED AT DIAGONAL CORNERS AND ANCHORED TO THE STRUCTURE ABOVE.
  - CLASSIFICATION OF CEILING GRID: CLASSIFICATION OF CEILING GRID IS "HEAVY DUTY" CHICAGO METALLIC, OR DONN(USG) PER ASTM C635 MANUFACTURER'S CATALOG NUMBER - MAIN RUNNER HEAVY DUTY MAIN TEE OR EQUAL #200-01 OR DX26. MANUFACTURER'S CATALOG NUMBER - CROSS RUNNER CHICAGO METALLIC 1214-01 OR DONN DX 416 CROSS TEES. MANUFACTURER'S CATALOG NUMBER OF DETAIL FOR RUNNER SPLICE N/A. ACOUSTICAL PANELS SHALL BE 5/8" MINIMUM THICK, MINERAL FIBERBOARD OR VINYL-FACED FIBERGLASS LAY-IN PANELS SQUARE EDGE ASTM FLAME SPREAD CLASS T, 24" x 48" MODULAR SIZE, LIGHT REFLECTION 75% MINIMUM, NOISE REDUCTION COEFFICIENT OF 0.65 MINIMUM. MAXIMUM SMOKE DENSITY NOT TO EXCEED 450.

MANUFACTURER	MAIN TEE	H.D. 4' CROSS TEE	H.D. 2' CROSS TEE
DONN/USG	DX-26	DX-424	DX-216
ARMSTRONG	7301	7341	7323
CHICAGO MET.	200-01	1204-01	1226-01

NOTE: ALL GRID COMPONENTS SHALL BE BY SAME MANUFACTURER

MODEL NUMBER	DESCRIPTION	MAX. CFM	UNIT WEIGHT LBS.
WH421-A	3 1/2 TON HEAT PUMP	1400	530
WH482-A	4 TON HEAT PUMP	1550	560
WH602-A	5 TON HEAT PUMP	1700	560

**GENERAL NOTES**

- HEATING VENTILATING AND AIR CONDITIONING (HVAC)
- HEAT PUMP: SINGLE PACKAGE WALL MOUNTED AIR TO AIR ELECTRIC HEAT PUMP UNIT SHALL BE RATED IN ACCORDANCE WITH ARI STANDARD 240-77.
 

REFERENCE BRANDS: BARD WH421-A0000000  
BARD WH482-A0000000  
BARD WH602-A0000000

MAXIMUM AC SIZE FOR THIS BUILDING WILL BE A 5-TON UNIT

ALL UNITS SHALL BE 230/208 VOLT, 1 PHASE SYSTEM, UL TESTED & APPROVED OR COMPARABLE AND MEET CURRENT ENERGY STANDARDS.

A.) THE SYSTEM SHALL MAINTAIN AN AUTOMATICALLY CONTROLLED INDOOR CLASSROOM TEMPERATURE OF 78 DEGREES

F. WHEN THE OUTDOOR DRY BULB TEMPERATURE VARIES BETWEEN 100 DEGREES F. IN THE SUMMER

B.) THE SYSTEM MUST MAINTAIN THE ABOVE TEMPERATURE WHEN THE DAMPER IS ADJUSTED TO USE APPROXIMATELY ONE THIRD FRESH AIR.
  - DUCTWORK.
 

A.) CONSTRUCT ALL DUCTWORK OF GALVANIZED SHEET METAL IN ACCORDANCE WITH C.M.C., ASHRAE GUIDE EQUIPMENT VOLUME AND SMACNA LOW VELOCITY DUCT CONSTRUCTION MANUAL LATEST EDITIONS. ALL DUCTWORK SHALL BE INSULATED WITH 1" THICK FIBERGLASS DUCT WRAP WITH VAPOR BARRIER. PROVIDE 1" DUCT ATTENUATION AT ALL DUCTWORK WITHIN 2'-0" OF HVAC UNIT.

B.) NON-METALLIC DUCTWORK OPTION: IN ACCESSIBLE CONCEALED PORTIONS OF DUCT SYSTEM RIGID 1" FIBERGLASS OR INSULATED FLEX-DUCT WITH VAPOR BARRIER MAY BE SUBSTITUTED FOR SHEET METAL DUCTWORK. ALL DUCTWORK WITHIN 2'-0" OF THE HVAC UNIT AND ALL INTERFACE CONNECTIONS SHALL BE METAL. DUCTWORK AND REINFORCEMENT SHALL BE DESIGNED FOR 2" STATIC PRESSURE. REFERENCE BRANDS: OWENS-CORNING FIBERGLASS DUCTBOARD, 1" THICK, AND MICRO-AIRE, TYPE 475. NON-METALLIC DUCTWORK SHALL CONFORM TO NFPA 90-A AND SMACNA CLASS 1 RATING.
  - AIR DUCT INSULATION AND LININGS SHALL COMPLY WITH FLAME SPREAD LESS THAN OR EQUAL TO 25, SMOKE GENERATION LESS THAN OR EQUAL TO 50.
  - SUPPLY AIR DIFFUSERS SHALL BE 675 CFM MAX. 12" ROUND. 1" FIBERGLASS OR FLEXDUCT DUCTWORK SPECIFICALLY DESIGNED TO PROVIDE AIR THERMAL COOLING SYSTEMS. 24"x8"x1" MICRO-AIRE TYPE #475 OWENS-CORNING, KNAUF, CERTANTEED, OR EQUAL AND 90- B: UL #131 TEST, CLASS 1 RATING WITH "SMACNA".
  - REGISTERS AND DIFFUSERS: PROVIDE THREE (MIN) 4-WAY THROW AIR DIFFUSERS AS MANUFACTURED CARNES, TITUS, HART AND COOLEY, METALAIRE, SHOEMAKER, BARBER-COLEMAN OR KRUEGER COMMERCIAL GRADE GRILLS AND REGISTERS
  - AIR CONDITIONING CONTROLS. THERMOSTAT: PROVIDE ELECTRONIC PROGRAMMABLE THERMOSTAT. THERMOSTAT SHALL HAVE THE FOLLOWING FUNCTIONS.
    - 5 AND 2 WEEKDAY/WEEKEND PROGRAMMING WITH 4 SEPARATE TIME/TEMPERATURE SETTING FOR 24-HOUR PERIOD.
    - KEY BOARD LOCKOUT SWITCH.
    - PROGRAMMABLE DISPLAY.
    - 2-HOUR OVERRIDE MINIMUM.
    - STATUS INDICATED LED'S.
    - BATTERY BACK-UP.

PROVIDE LOCKING CLEAR THERMOSTAT COVER WITH THERMOSTAT COVER WITH ACCESS HOLE FOR PROGRAM OVERRIDE. WHITE RODERS #92-371. MOUNT @ +60" w/COVER (SEALED-SETTING ADJUSTMENTS CAN BE DONE BY SERVICE PERSONNEL ONLY.) +48" UNSEALED.
  - THERMAL INSULATION
    - ROOF INSULATION: R-19 UNFACED.
    - WALLS INSULATION: R-13 KRAFT FACED.
    - FLOORS INSULATION: CONCRETE FLOOR FLAME SPREAD AND SMOKE DEVELOPMENT SHALL CONFORM TO CALIFORNIA BUILDING CODE SEC. 719.
  - FACTORY-MADE AIR DUCTS. FACTORY-MADE AIR DUCTS SHALL BE APPROVED FOR THE USE INTENDED OR SHALL CONFORM TO THE REQUIREMENTS OF U.M.C. STANDARD NO. 6-1. EACH PORTION OF A FACTORY-MADE AIR DUCT SYSTEM SHALL BE IDENTIFIED BY THE MANUFACTURER WITH A LABEL OR OTHER SUITABLE IDENTIFICATION INDICATING COMPLIANCE WITH U.M.C. STANDARD NO. 6-1 AND ITS CLASS DESIGNATION. THESE DUCTS SHALL BE LISTED AND SHALL BE INSTALLED IN ACCORDANCE WITH THE TERMS OF THEIR LISTING AND THE REQUIREMENTS OF UMC STD. 6-1.

DUCT SUPPORT  
FLEX DUCT TO BE SUPPORTED WITH 1-1/2" WIDE X 26 GA. CALV. STRAP @ MAX 6'-0" O.C. ATTACH TO RAFTER W/2 #8 SMS @ EACH END.  
SUPPLY AIR PLENUM TO BE SUPPORTED WITH 1-1/2" WIDE X 26 GA. CALV. STRAPS MIN. 2 PER PLENUM.  
SUPPLY AIR BOX AND DIFFUSERS TO BE SUPPORTED WITH (2) 12 GA. HANGER WIRES TO BOX @ OPPOSITE CORNERS.  
SUPPLY AIR BOX AND DIFFUSERS TO BE BRACED WITH (2) 12 GA. SLACK WIRES TO BOX @ OPPOSITE CORNERS. ATTACH SUPPLY AIR DIFFUSERS TO CEILING GRID TO RESIST A LATERAL LOAD EQUAL TO THE WEIGHT OF THE DIFFUSER AND SUPPLY AIR BOX W/2 #8 SMS.

- FIREBLOCKING: SHALL BE PROVIDED IN THE FOLLOWING LOCATION
- IN CONCEALED SPACES OF STUD WALLS AND PARTITIONS, INCLUDING FURRED SPACES, AT THE CEILING AND FLOOR LEVELS AND AT 10-FOOT (3048mm) INTERVALS BOTH VERTICAL AND HORIZONTAL. SEE CBC SECTION 717.2

ZONE	WALL	ROOFS	FLOORS
1-14 & 16	R -13	R -19	R -13
15	R -13	R -30	R -13

NO	DATE	DESCRIPTION

DATE: 2/24/08  
SCALE: NOTED  
DRAWN BY: DM  
SERIAL NO.:

CUSTOMER:  
**12'X40' RELOCATABLE BUILDING  
CEILING & MECHANICAL NOTES**



APPROVALS:



IDENTIFICATION STAMP  
BY: OF THE STATE ARCHITECT  
03-11-2008  
AC: FLS: SS: [Signature]  
DATE: 2/10/08


IDENTIFICATION STAMP  
OFFICE OF THE STATE ARCHITECT  
OFFICE OF REGULATION SERVICES  
PC 02-108508  
AC: FLS: [Signature]  
DATE: 2/10/08

PROJECT NO.  
PC  
**M3**

THESE DRAWINGS AND SPECIFICATIONS ARE THE PROPERTY OF AMERICAN MODULAR SYSTEMS, INC. AND ARE NOT TO BE REPRODUCED, CHANGED OR COPIED IN ANY FORM OR MANNER, NOR ARE THEY TO BE ASSIGNED TO ANY THIRD PARTY WITHOUT THE WRITTEN AUTHORIZATION OF AMERICAN MODULAR SYSTEMS, INC.

**STANDARD ELECTRICAL SYMBOLS**

	EXIT LIGHT WHERE TWO OR MORE EXITS ARE REQUIRED
	INCANDESCENT WALL MOUNTED INTERIOR LIGHT FIXTURE
	DUPLEX WALL CONVENIENCE OUTLETS ● +18" TO CENTER LINE ABOVE F.F. AND 12'-0" MAX TYP U.O.N.
	FOURPLEX WALL OUTLET ● +18" TO CENTER LINE U.O.N.
	WEATHER PROOF GROUND FAULT CIRCUIT INTERRUPT OUTLET
	GROUND FAULT CIRCUIT INTERRUPT OUTLET
	SINGLE POLE LIGHT SWITCHES ● +48", HUBBELL PREMIUM, BRYANT HEAVY DUTY, OR LEVITON SPECIFICATIONS GRADE.
	ELECTRICAL CROSSOVER J-BOXES ABOVE T-BAR CEILING #1-4"X1", #22 4"X2"
	CLOCK/SPEAKER COMBO ● +90"
	SWITCH SUBSCRIPTS - ○=DEVICE CONTROLLED.
	JUNCTION BOX - SIZE AND TYPE AS REQUIRED.
	SPEAKER- OUTLET ONLY - 4" SQ. BOX W/ DEVICE RING AND COVER +84"
	DATA/COMMUNICATION OUTLET ONLY- 4" SQ. BOX W/ SINGLE DEVICE RING AND COVER +18" U.O.N. AND A 3/4" CONDUIT STUB CEILING SPACE.
	INTERCOM TELEPHONE- OUTLET ONLY- 4" SQ. BOX W/ SINGLE DEVICE RING AND COVER +48" U.O.N.
	MOTION SENSOR OUTLET STUB-UP -PROVIDE (1)4" SQ. BOX W/ SINGLE DEVICE RING AND COVER AND ONE 3/4" CONDUIT STUB TO ABOVE CEILING (DEVICES BY OTHERS)
	SECURITY/INTRUSION KEY PAD - OUTLET ONLY- 4" SQ. BOX W/ SINGLE DEVICE RING AND COVER ● +48" AND ONE 3/4" CONDUIT STUB ABOVE CEILING
	DOOR CONTACT - PROVIDE (1) EMPTY 1/2"Ø EMT THROUGH DOOR HEADER STUB ABOVE CEILING
	CATV OUTLET STUB-UP -PROVIDE (1)4" SQ. BOX W/ SINGLE DEVICE RING AND COVER AND(1) 3/4"Ø CONDUIT TO ABOVE CEILING (DEVICES BY OTHERS)
	FIRE ALARM PULL STATION - OUTLET ONLY, 4" SQ. BOX W/ SINGLE DEVICE RING AND COVER +48". (DEVICE N.I.C.)
	FIRE ALARM HORN - OUTLET ONLY - 4" SQ. SINGLE GANG J-BOX WITH BLANK WEATHERPROOF COVER ● +90" MIN (DEVICE N.I.C.)
	FIRE ALARM VISUAL ALARM- OUTLET ONLY - 4" SQ. BOX W/ SINGLE DEVICE RING AND COVER +80". A.F.F. BUT NO GREATER THAN +96". IF CEILING MOUNTED PER NFPA72 TABLE 6-4.4.1(b).
	MINI HORN BOX W/ SINGLE DEVICE RING AND COVER ● +80"A.F.F. BUT NO GREATER THAN +96". STUB TO ATTIC
	THERMOSTAT ● +60" SEALED, +48" A.F.F UNSEALED
	ULTRASONIC OCCUPANCY SENSOR
	ELECTRICAL PANEL

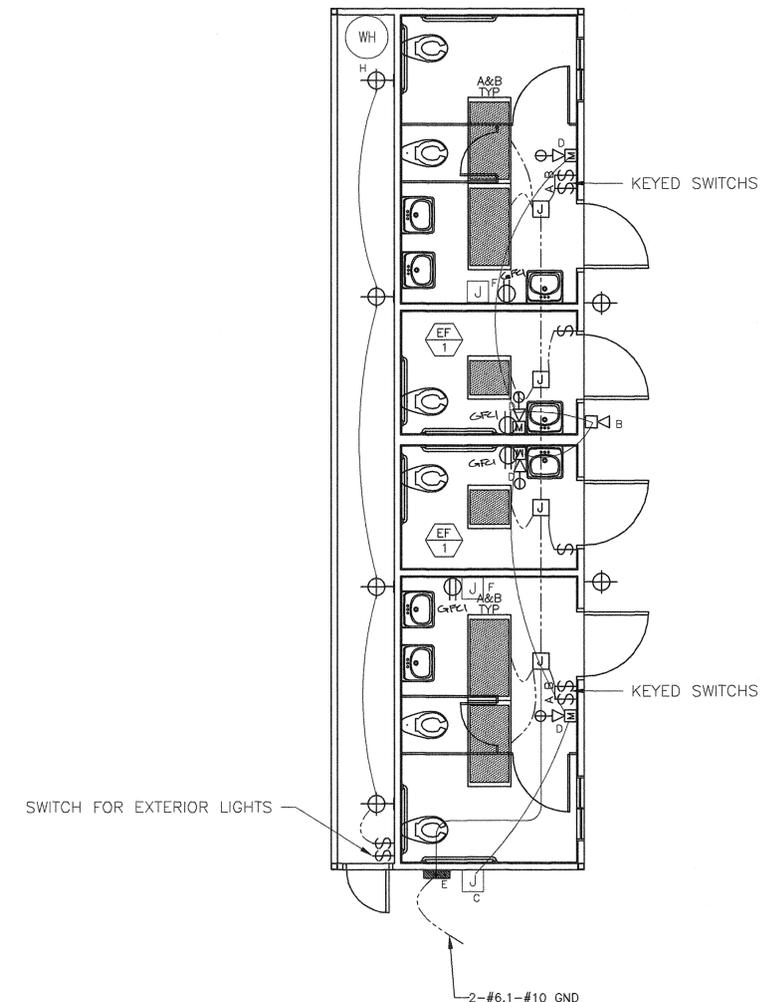

- B. EXTERIOR 4 SQ. J-BOX (FIRE ALARM HORN) INSTALL AT +90" FROM FINISHED FLOOR.
- C. J-BOX ONLY (FIRE ALARM TIE-IN) INSTALL 4" SQ. BOX, 2 GANG RING WITH 1" CONDUIT TO ABOVE CEILING. TIE TO 3/4" CONDUIT AS SHOWN ON PLAN FOR FIRE ALARM DEVICES.
- D. 4" SQ. J-BOX (FIRE ALARM HORN/STROBE).
- E. ELECTRICAL SERVICE TIE-IN LOCATION.
- F. 4" J-BOX MOUNTED AT +36" TO CENTER WITH 230 V. POWER FOR DISTRICT SUPPLIED HAND DRYERS.
- G. EXTERIOR ENERGY SAVING LIGHT FIXTURE, STANDARD LIGHT SWITCH LOCATED IN PLUMBING CHASE. IDENTIFY SWITCH AS SUCH.
- H. 6 GALLON 120V ELECTRIC WATER HEATER. MOUNT ON WALL AS HIGH AS POSSIBLE WITH dsa APPROVED PLATFORM AND SAFETY STRAP.

**3 TYPICAL ELECTRICAL PLAN**  
E1 1/4"=1'-0"

NOTE:  
AT ANY SPACE REQUIRING 2 OR MORE EXITS PROVIDE EXIT SIGNS (CBC 1011) AND EMERGENCY EXIT ILLUMINATION (CBC 1006)

NOTE:  
THE PROJECT ARCHITECT SHALL BE RESPONSIBLE FOR THE PLACEMENT OF HEAT, SMOKE DETECTORS AND PULL STATIONS WHEN THE SITE SPECIFIC PROJECT IS REQUIRED TO MEET THE PROVISIONS OF SB 575 & CBC 907.2.3

SYMBOL	DESCRIPTION	WATTS	MANUFACTURER
	2'X4' FLOURESCENT DROP IN FIXTURE, ACRYLIC PRISMATIC LENS. T-8 ELECTRONIC BALLASTS (3)32 WATT TUBES, WT. 27 LBS.	SP41 32 W	CRESCENT 24GP40HFA1158YF2 OR LITHONIA 2GT440A12120ESPWS1846LPESCW
	FLOURESCENT SURFACE MOUNTED EXTERIOR LIGHT WITH IMPACT RESISTANT ENCLOSURE. .125 THICK CLEAR PRISMATIC ONE PIECE LENS W/ NEOPRENE GASKET & POSIGRIP STAINLESS STEEL SCREWS. (PROVIDE EMERGENCY BATTERY BACK-UP WHERE TWO OR MORE EXITS OCCUR.)	(2) 7W TT 2700 K	ENERTRON 7026B-L OR EQUAL

- GENERAL NOTES -**
- F.A. : STUB-UP ALL FIRE ALARM JUNCTION BOXES TO ACCESSIBLE ATTIC SPACE WITH 1/2" MIN. GALV. THIN WALL TUBING (EMT). DO NOT CONNECT FIRE ALARM CONDUIT WITH ANY OTHER ELECTRICAL CONDUIT
  - IF OPTIONAL DOOR OCCURS A PULL STATION J-BOX AND EXIT SIGN ARE REQUIRED. PULL STATIONS ARE REQUIRED ● EVERY EXIT
  - STUB OUT LOCATIONS FOR ELECTRICAL PANEL, FIRE ALARM, AND DATA BOXES SHOWN ARE DIAGRAMITICAL ONLY EXACT LOCATIONS MAY VARY +/- SEVERAL FEET. PLEASE CONTACT AMERICAN MODULAR SYSTEMS FOR EXACT LOCATIONS. POINT OF CONNECTION WILL BE AT FACE OF BUILDING.
  - SEE TYPICAL CLASSROOM LAYOUT FOR LOCATIONS OF ALL DEVICES. FIXTURE MOUNTING SHALL COMPLY WITH CALIFORNIA SEISMIC REGULATIONS.
  - THE LIGHTS FOR EACH ROOM OVER 250' SQ FT SHALL BE CONTROLLED BY ULTRASONIC OCCUPANCY SENSOR, WATT STOPPER W-500A, W-1000A,OR W-2000A (OR EQUAL) BASED ON THE ROOM SIZE IN CONJUNCTION WITH BI-LEVEL SWITCHING.

BASED ON PC# 02-109808

**REVISIONS**

NO	DATE	DESCRIPTION


DATE: 01/14/10  
SCALE: NOTED  
DRAWN BY: RS  
SERIAL NO.:

CUSTOMER:  
**BAKERSFIELD SCHOOL DISTRICT  
MUNSEY ELEMENTARY SCHOOL**

**12'X40' RELOCATABLE BUILDING  
TYPICAL ELECTRICAL PLAN & NOTES**



APPROVALS:

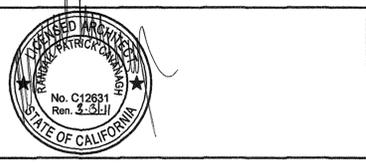

IDENTIFICATION STAMP  
DIV. OF THE STATE ARCHITECT  
OFFICE OF REGULATION SERVICES  
DATE: 2/10/10

PROJECT No.  
**E1**

THESE DRAWINGS AND SPECIFICATIONS ARE THE PROPERTY OF AMERICAN MODULAR SYSTEMS, INC. AND ARE NOT TO BE REPRODUCED, CHANGED OR COPIED IN ANY FORM OR MANNER, NOR ARE THEY TO BE ASSIGNED TO ANY THIRD PARTY WITHOUT THE WRITTEN AUTHORIZATION OF AMERICAN MODULAR SYSTEMS, INC.

- GENERAL NOTES -

**FIRE ALARM SYSTEM**

- THE FIRE ALARM SYSTEM SHALL CONFORM TO THE CALIFORNIA ELECTRICAL CODE, & CA. FIRE CODE.
- INSTALLATION OF THE FIRE ALARM SYSTEM SHALL NOT BE STARTED UNTIL DETAILED PLANS AND SPECIFICATIONS, INCLUDING CALIFORNIA STATE FIRE MARSHAL LISTINGS FOR EACH COMPONENT OF THE SYSTEM HAVE BEEN APPROVED BY DSA.
- UPON COMPLETION OF THE INSTALLATION OF THE FIRE ALARM SYSTEM, A SATISFACTORY TEST OF THE ENTIRE SYSTEM SHALL BE MADE IN THE PRESENCE OF THE ENFORCING AGENCY.
- JUNCTION BOXES- GALVANIZED SHEET METAL, SQUARE OR RECTANGULAR WITH BLANK COVERS. LOCATE ONE BOX AT REAR OF BUILDING NEAR MAIN ELECTRICAL PANEL AT +18" ABOVE FINISH FLOOR FOR FUTURE CONNECTION.
- COVERS- INSTALL GASKETED, METAL, WATERPROOF, FINISH COVERS AT EXTERIOR LOCATIONS. INSTALL FINISH COVERS AT INTERIOR LOCATIONS.
- THE AUTOMATIC ALARM SYSTEM SHALL BE INSTALL, TESTED, AND MAINTAINED IN ACCORDANCE WITH THE STATE FIRE MARSHAL REGULATIONS (CBC 907.2.3) AND THE 2002 EDITION OF NFPA 72.
- THE LOCATION OF AUTOMATIC DETECTORS, MANUAL STATIONS AND OTHER FIRE ALARM EQUIPMENT AND DEVICES, AS SHOWN ON PLAN, ARE FOR REFERENCE ONLY AND DO NOT CONSTITUTE SHOP DRAWINGS WHICH ARE REQUIRED FOR REVIEW AND APPROVAL.
- ALARM-INDICATING DEVICES OF A FIRE ALARM SYSTEM INTENDED TO ALERT ALL OCCUPANTS SHALL CAUSE A LEVEL OF AUDIBILITY OF NOT LESS THAN 15 dBA ABOVE THE AVERAGE AMBIENT NOISE LEVELS OR 5dBA ABOVE THE MAXIMUM SOUND LEVEL HAVING A DURATION OF 60 SECONDS WHICH-EVER IS GREATER, MEASURED 5' ABOVE THE FLOOR. AMBIENT NOISE LEVELS MEANS THE LEVEL WHICH CAN NORMALLY BE EXPECTED WHEN THE FACILITY, BUILDING, ROOM, OR AREA IS FUNCTIONING UNDER NORMAL OPERATING OR WORKING CONDITIONS (NFPA 72, SEC. 7.4.2)
- THE ALARM SYSTEM SHALL ACTIVATE A MEANS OF WARNING THE HEARING IMPAIRED. FLASHING VISUAL WARNINGS SHALL HAVE A FLASH RATE NOT EXCEEDING TWO FLASHES PER SECOND (2 HZ) NOR BE LESS THAN ONE FLASH EVERY SECOND (1 HZ). STROBE SIGNALING DEVICES FOR THE HEARING IMPAIRED SHALL BE STATE FIRE MARSHAL APPROVED AND LISTED (NFPA 72, SEC. 7.5)
- AUTOMATIC FIRE ALARM SYSTEM SHALL TRANSMIT THE ALARM, SUPERVISORY AND TROUBLE SIGNALS TO AN APPROVED SUPERVISING STATION AS REQUIRED BY NFPA 72 AS AMENDED BY STATE FIRE MARSHAL. THE SUPERVISING STATION SHALL BE LISTED AS EITHER UUFX OR UJJS BY UNDERWRITERS LABORATORY OR SHALL MEET THE REQUIREMENTS OF FACTORY MUTUAL RESEARCH APPROVAL STANDARD 3011. SUPERVISION OF SYSTEM AND LEASED TELEPHONE LINES SHALL BY ARRANGED BY OWNER.  
IF TESTING RESULTS DETERMINE FIRE ALARM AUDIBILITY DOES NOT MEET 10db OVER AMBIENT NOISE LEVELS, ADDITIONAL FIRE ALARM SIGNALING DEVICES MAY BE REQUIRED BY THE ENFORCING AGENCY PER [CBC].

**GENERAL NOTES**

- GROUNDING ELECTRODE CONDUCTOR SIZED PER CEC.
- PROVIDE BONDS TO BLDG. STEEL & PANEL (#8 CU)
- PANEL TO LISTED FOR USE AS SERVICE EQUIPMENT.

**FIXTURE NOTES:**


- ALL FLUORESCENT LIGHT FIXTURES SHALL HAVE ENERGY SAVING LAMPS AND BALLASTS.
- LUMINATES/BALLASTS SHALL BE CERTIFIED PER CALIFORNIA BUILDING CODE, TITLE 24.
- FLUORESCENT LIGHT FIXTURE TYPE "A" SHALL BE CONTROLLED TO PROVIDE TWO LEVELS OF LIGHTING. SWITCH (SA) SHALL CONTROL THE TWO OUTER LAMPS AND SWITCH (SB) SHALL CONTROL THE TWO INNER LAMPS.

**ELECTRICAL**

- ELECTRICAL SERVICE DROP AND CONNECTIONS SUPPLIED BY OTHERS.
- MANUFACTURER TO PROVIDE STUB-OUT FROM BACK OF ELECTRICAL PANEL THROUGH THE EXTERIOR WALL OR TO BELOW FLOOR FOR RECEIVING EITHER UNDERGROUND OR OVERHEAD SERVICE & FITTING FOR GROUNDING CABLE.
- ELECTRICAL PANEL BOARD SHALL BE RECESS MOUNTED INSIDE THE BUILDING. SIZED TO ACCOMMODATE ALL CONNECTED LOADS INCLUDING SPACES AS SHOWN. OVERCURRENT PROTECTIVE DEVICES IN THE PANEL BOARDS HAVE ADEQUATE SHORT CIRCUIT INTERRUPTING CAPACITY. ALL BUSES INCLUDING BUS SHALL BE COPPER OR ALUMINUM.
- 2X4 FLOURESCENT FIXTURES SHALL BE STEEL FRAME, LENS SHALL BE HINGED AND LOCKED IN PLACE BY TWO LOCKING DEVICES. THE LENS DIFFUSERS SHALL BE KHS, INC. #KSH-12, CAROLITE, INC. #C-12 OR PLASKOLITE, INC. #PL21A. MINIMUM LENS THICKNESS SHALL BE .125 INCH.
- FLOURESCENT BALLAST SHALL BE ENERGY SAVER WHILE MAINTAINING FULL LIGHT OUTPUT. CLASS "P" EQUIPPED WITH THERMAL PROTECTORS GUARANTEE AGAINST FAILURE FOR (2) YEARS AND BE REPLACED FROM INSIDE THE FIXTURE.
- CLOCK - 12" DIAL CLOCK ON CLOCK OUTLET.  
A) CLOCK SHALL BE GENERAL ELECTRIC MODEL 2912 129V 60 CYCLE  
B) CLOCK OUTLET SHALL BE BRYANT #2828 OR EQUAL WITH SEPERABLE HANGING CLIP & APP'D RECEIPT.  
THE H.V.A.C. UNIT FEEDER CIRCUIT - PANEL CIRCUIT BREAKER, FEEDER WIRE, UNIT DISCONNECT AND FUSES (WHERE USED) - IS TO BE COORDINATED WITH THE NAME PLATE DATA AT THE TIME OF MANUFACTURE. H.V.A.C. UNITS HAVING KVA RATINGS LARGER THAN THAT INDICATED ON THIS PANEL SCHEDULE WILL NOT BE ALLOWED TO BE INSTALLED ON THIS BUILDING. IF 60 DEGREES C. WIRE IS TO BE USED IN THIS INSTALLATION, CALCULATIONS DEMONSTRATING AMPACITY BE PROVIDED ON THE DRAWING.

VOLTS: 120/240 SINGLE PHASE		PANEL "A"		FEED: EXTERIOR LB							
MAIN: 60 AMP MAIN BKR.		LOCATION: INTERIOR		MOUNTING: FLUSH							
LOAD	WATTS		BRK.	C	A	B	C	BRK.	WATTS		LOAD
	A	B							A	B	
RECEPTS	1440		20	1	1		2	2	30	3216	WATER HEATER
EXIT LIGHT / EXTERIOR LIGHTS		300	20	1	3		4	30		3216	WATER HEATER
INTERIOR LIGHTS	1440		20	1	5		6				
F.A.C.P		*					7				
							8				
							9				
							10				
							11				
							12				
							13				
							14				
							15				
							16				
							17				
							18				
PHASE WATTAGE	2880	300						3216	3216	PHASE WATTAGE	
TOTAL WATTS "A" LEG =	6096							TOTAL WATTS A+B=	9612		
TOTAL WATTS =	9612							TOTAL WATTS "B" LEG =	3516		
FEEDERS: 3-#2 & 1-#8 CU. TO BE RUN BY THE DISTRICT EITHER UNDERGROUND OR OVERHEAD, SEE SITE ELEC. PLAN.		40 AMPS		120/240V		SINGLE PHASE		60 AMP BUS.			

NOTE:  
FIRE ALARM DEDICATED CIRCUIT SHALL BE IDENTIFIED WITH A RED MARKED DISCONNECT WITH LOCK-ON CAPABILITY NFPA 72 4.4.1.4.2.1

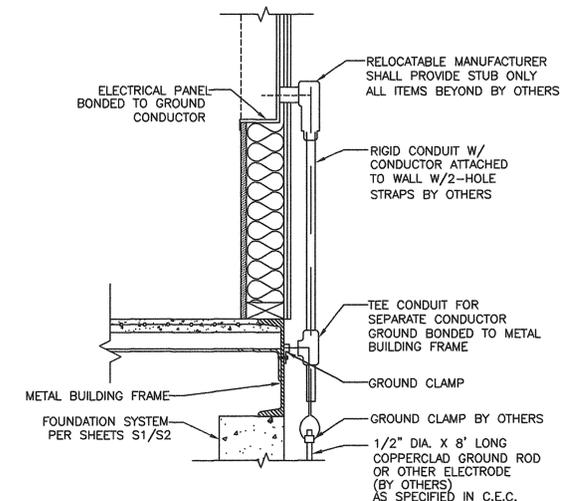

SIZE OF CONDUCTORS SHALL COMPLY W/CEC. BOND SEPARATE CONDUCTORS FROM GROUND ROD TO ELECTRICAL PANEL & METAL BUILDING FRAME (CEC). IN ADDITION TO THE DETAIL SHOWN ABOVE, BOND THE ELECTRICAL GROUND TO METAL WATER PIPE EMBEDDED AT LEAST 10' INTO THE SOIL IF AVAILABLE (CEC). ELECTRICAL BOND MODULES TOGETHER W/#8 CU @ MODLINE. BY MANUFACTURER. CHECK RESISTANCE TO GROUND. IF RESISTANCE EXCEEDS 25 OHMS, INSTALL ADDITIONAL GROUND RODS (CEC) AS REQUIRED. GROUNDING DETAIL PER DSA IR E-1. INSPECTOR TO WITNESS GROUNDING TEST.

1 GROUNDING DETAIL  
E2 1 1/2"=1'-0"

BASED ON PC# 02-109808

REVISIONS		
NO	DATE	DESCRIPTION

DATE: 01/14/10  
SCALE: NOTED  
DRAWN BY: RS  
SERIAL NO.:

CUSTOMER:  
BAKERSFIELD SCHOOL DISTRICT  
MUNSEY ELEMENTARY SCHOOL

12'X40' RELOCATABLE BUILDINGS  
ELECTRICAL NOTES & DETAILS




APPROVALS:



IDENTIFICATION STAMP  
DIV. OF THE STATE ARCHITECT  
OFFICE OF REGULATION SERVICES  
02-11285  
AC. # FLS. # SS #  
DATE: 2/10/10


PROJECT No.  
PC  
E2

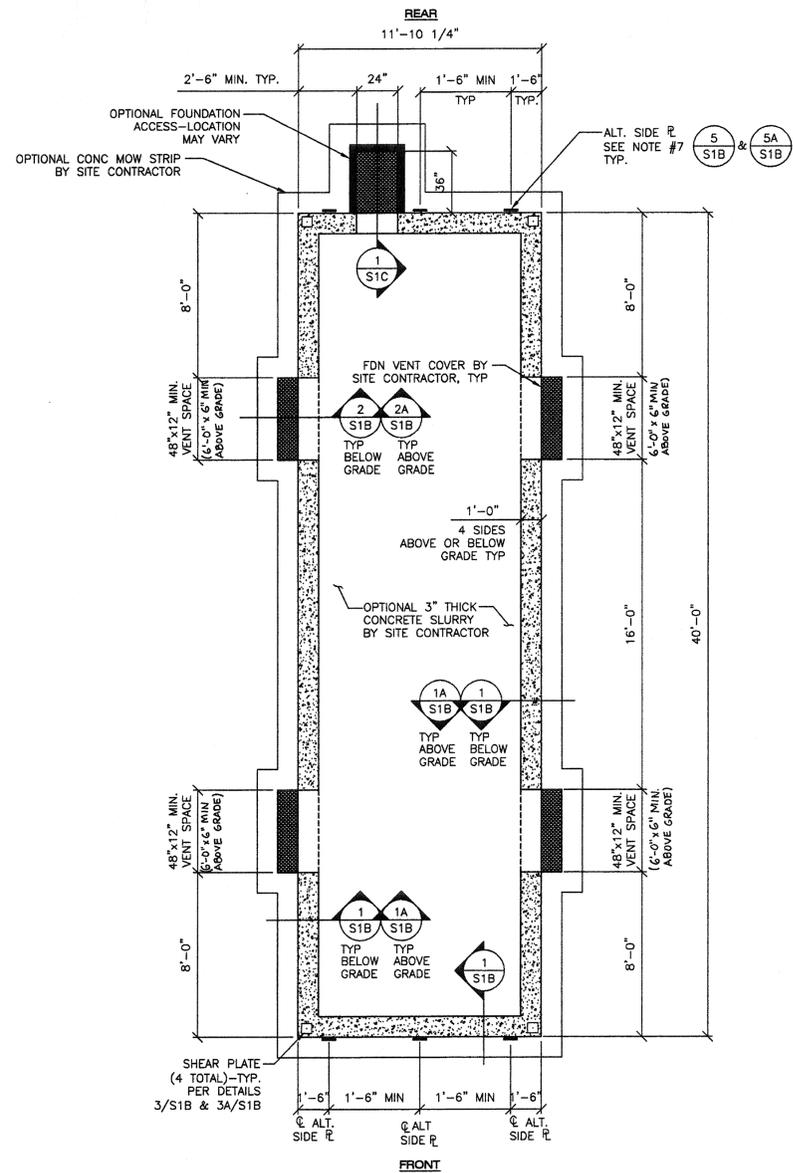

**A FOUNDATION PLAN (ABOVE/BELOW GRADE)**  
**S1A** 1/4"=1'-0"  
 (50 PSF FLOOR LIVE LOAD PLUS 15 PSF PARTITION LOAD)

**NOTES:**

- DO NOT INSTALL BUILDING IN AREAS OF WATER FLOW LINES.
- ULTIMATE 28-DAY CONCRETE COMPRESSIVE STRENGTH SHALL BE 2500 PSI MIN. PROPORTIONED PER TITLE 24, PART 2, SECTION 1905A.3 OR 1905A.4
- THE REINFORCING BARS MUST BE TESTED PER TITLE 24, PART 2, SECTION 1916A.2 IF CONCRETE WITH A COMPRESSIVE STRENGTH OF 3500 PSI IS SPECIFIED THEN THE TESTING OF THE REINFORCING BARS MAY BE WAIVED PER SECTION 1916A.4. THE CEMENT SHALL BE CERTIFIED PER SECTION 1916A.1
- REINFORCING STEEL 40,000 PSI MINIMUM, PER ASTM A615
- MINIMUM SOIL BEARING CAPACITY 1500 PSF.
- DESIGN SOIL BEARING CAPACITY 1500 PSF.
- ALTERNATE SIDE PLATES MUST COMPLETELY REPLACE TYPICAL SHEAR PLATES ALONG ANY ONE 40' WALL. COMBINATION OF TYPICAL SHEAR PLATES AND SIDE PLATES ALONG ANY ONE 40' WALL LINE IS NOT PERMITTED.
- MINIMUM BUILDING SEPARATION IS 6".

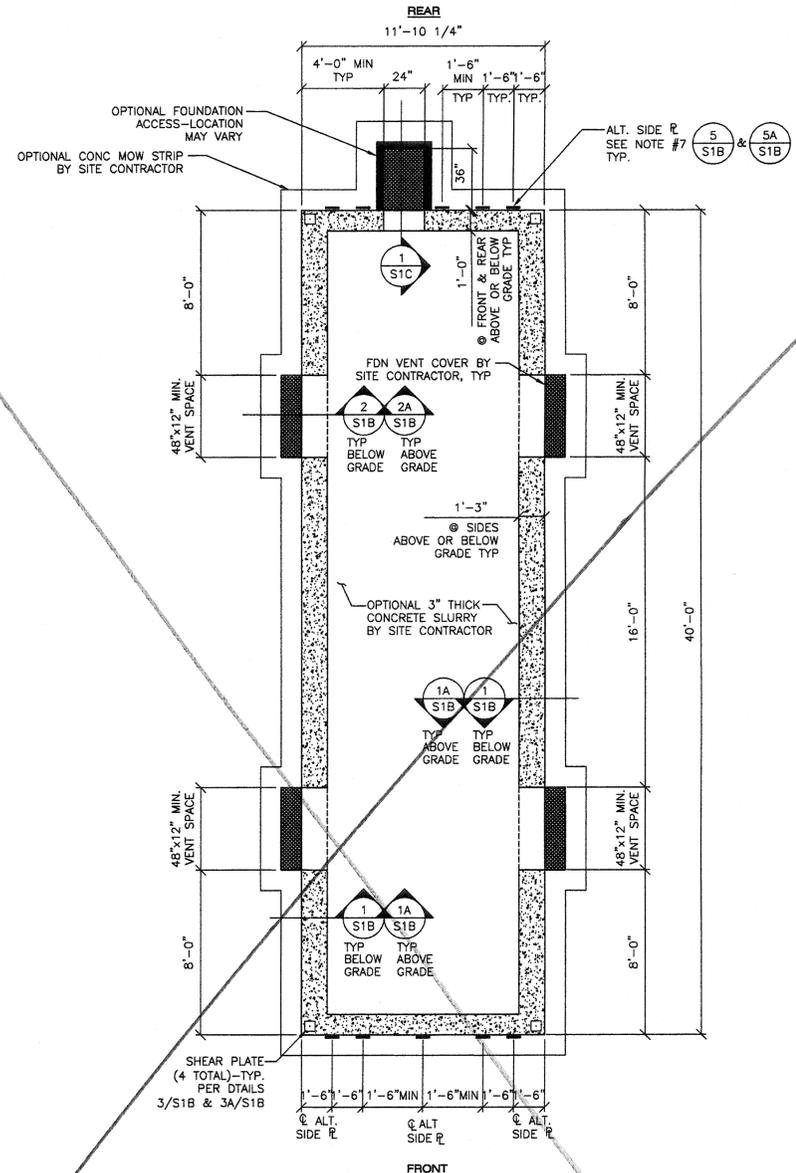

**B FOUNDATION PLAN (ABOVE/BELOW GRADE)**  
**S1A** 1/4"=1'-0"  
 (CONCRETE 125 PSF FLOOR LIVE LOAD)

**NOTES:**

- DO NOT INSTALL BUILDING IN AREAS OF WATER FLOW LINES.
- ULTIMATE 28-DAY CONCRETE COMPRESSIVE STRENGTH SHALL BE 2500 PSI MIN. PROPORTIONED PER TITLE 24, PART 2, SECTION 1905A.3 OR 1905A.4
- THE REINFORCING BARS MUST BE TESTED PER TITLE 24, PART 2, SECTION 1916A.2 IF CONCRETE WITH A COMPRESSIVE STRENGTH OF 3500 PSI IS SPECIFIED THEN THE TESTING OF THE REINFORCING BARS MAY BE WAIVED PER SECTION 1916A.4. THE CEMENT SHALL BE CERTIFIED PER SECTION 1916A.1
- REINFORCING STEEL 40,000 PSI MINIMUM, PER ASTM A615
- MINIMUM SOIL BEARING CAPACITY 1500 PSF.
- DESIGN SOIL BEARING CAPACITY 1500 PSF.
- ALTERNATE SIDE PLATES MUST COMPLETELY REPLACE TYPICAL SHEAR PLATES ALONG ANY ONE 40' WALL. COMBINATION OF TYPICAL SHEAR PLATES AND SIDE PLATES ALONG ANY ONE 40' WALL LINE IS NOT PERMITTED.
- MINIMUM BUILDING SEPARATION IS 6".

REVISIONS		
NO	DATE	DESCRIPTION

DATE: 02/21/08  
 SCALE: NOTED  
 DRAWN BY: RL  
 SERIAL NO.:

CUSTOMER:  
 12' x 40' RELOCATABLE BUILDINGS  
 CONCRETE FOUNDATION PLAN  
 50 PSF LIVE LOAD + 15 P.S.F. & 125 PSF














APPROVALS:  
 THESE DRAWINGS ARE PRELIMINARY AND NOT FOR CONSTRUCTION UNLESS STAMPED & SIGNED BY THE ENGINEER OF RECORD.  
 REGISTERED PROFESSIONAL ENGINEER  
 Kenneth A. Luttrell  
 No. 4418  
 Exp. 3/31/11  
 Structural Engineer  
 State of California

IDENTIFICATION STAMP  
 DIV. OF THE STATE ARCHITECT  
 OFFICE OF REGULATION SERVICES  
 C2-112985  
 AC FLS SS  
 DATE: 2/10/08

IDENTIFICATION STAMP  
 DIV. OF THE STATE ARCHITECT  
 OFFICE OF REGULATION SERVICES  
 PC 02-109808  
 AC FLS SS  
 DATE: 2/10/08

PROJECT No.  
**S1A**

THESE DRAWINGS AND SPECIFICATIONS ARE THE PROPERTY OF AMERICAN MODULAR SYSTEMS, INC. AND ARE NOT TO BE REPRODUCED, CHANGED OR COPIED IN ANY FORM OR MANNER, NOR ARE THEY TO BE ASSIGNED TO ANY THIRD PARTY WITHOUT THE WRITTEN AUTHORIZATION OF AMERICAN MODULAR SYSTEMS, INC.

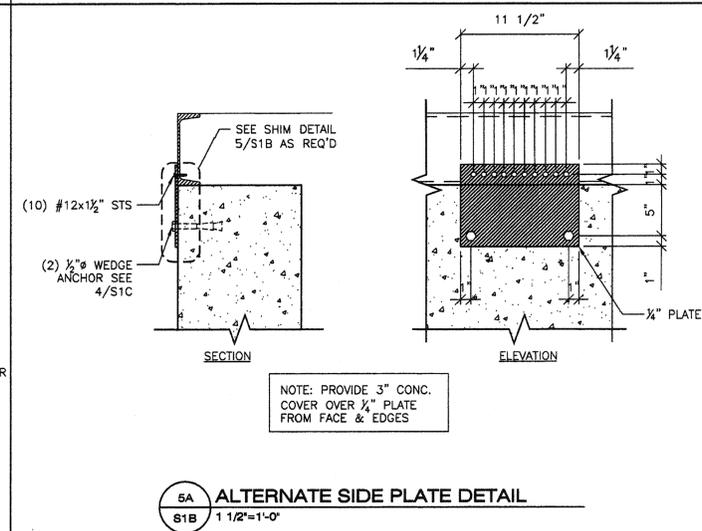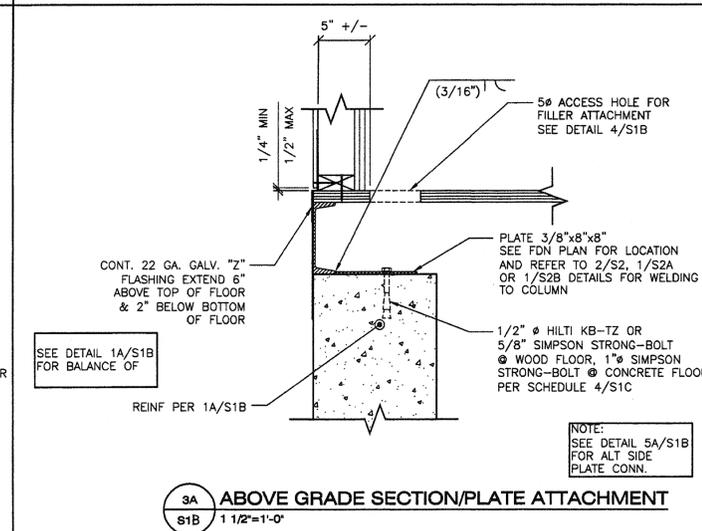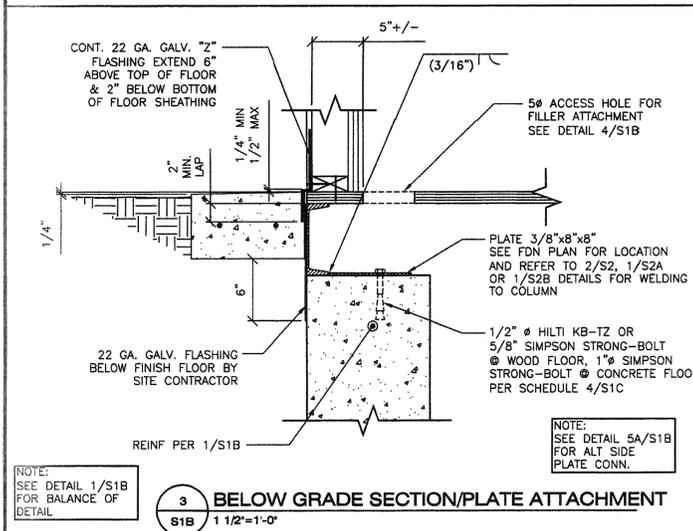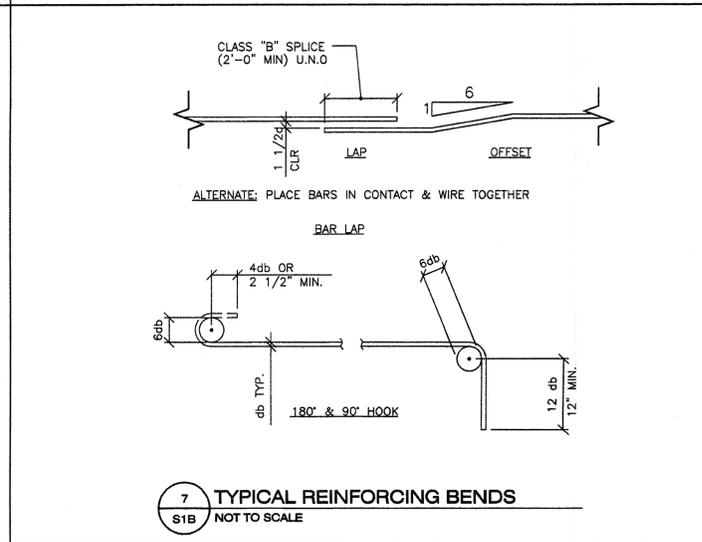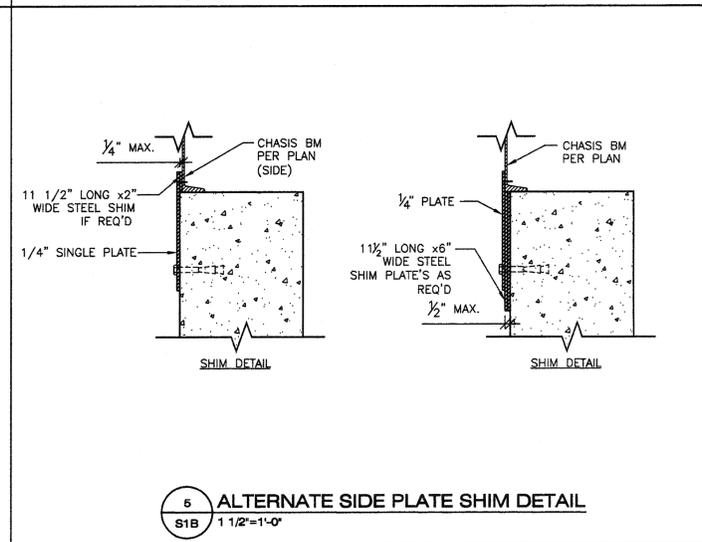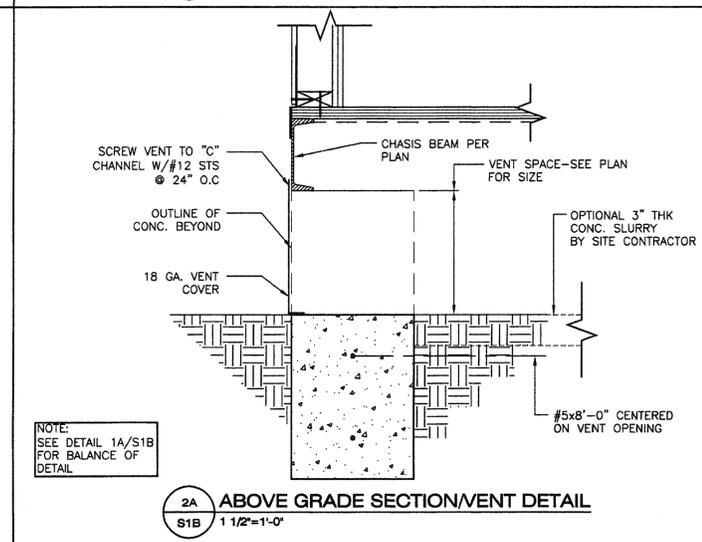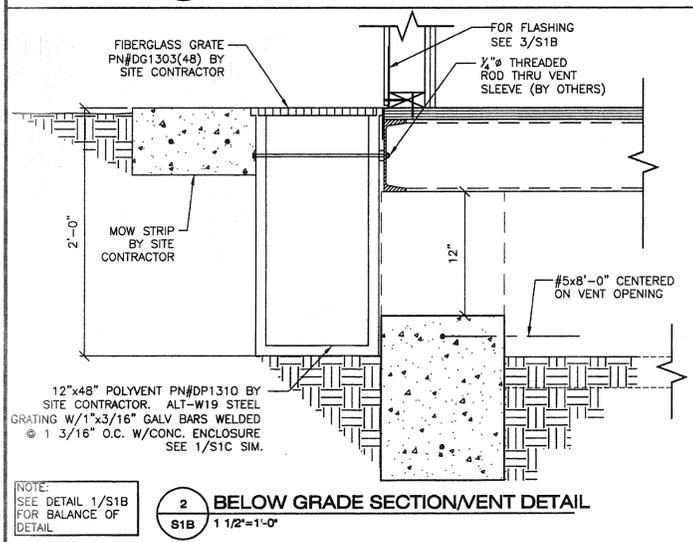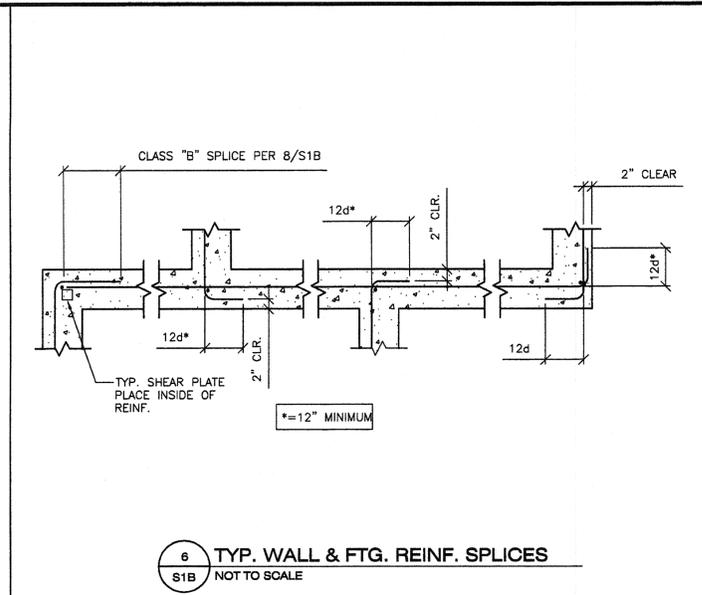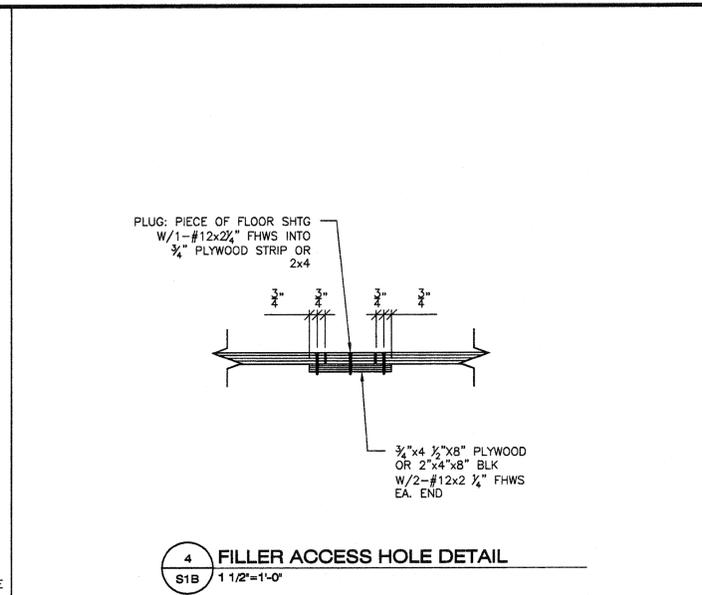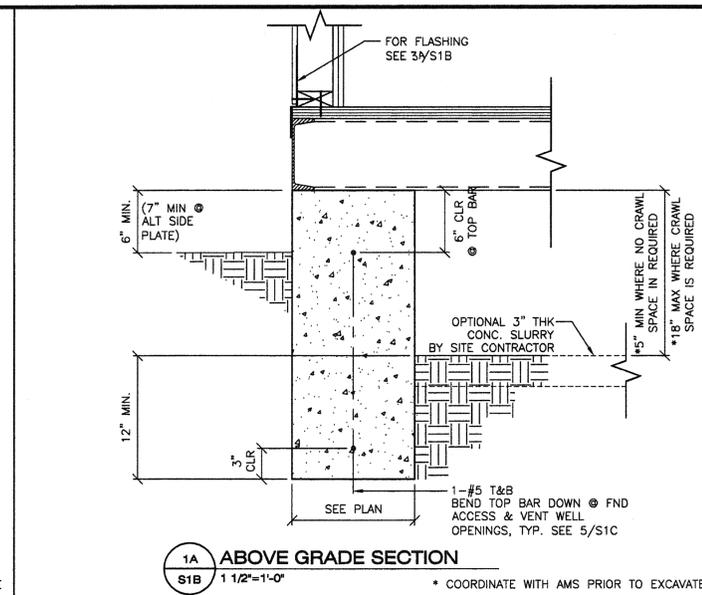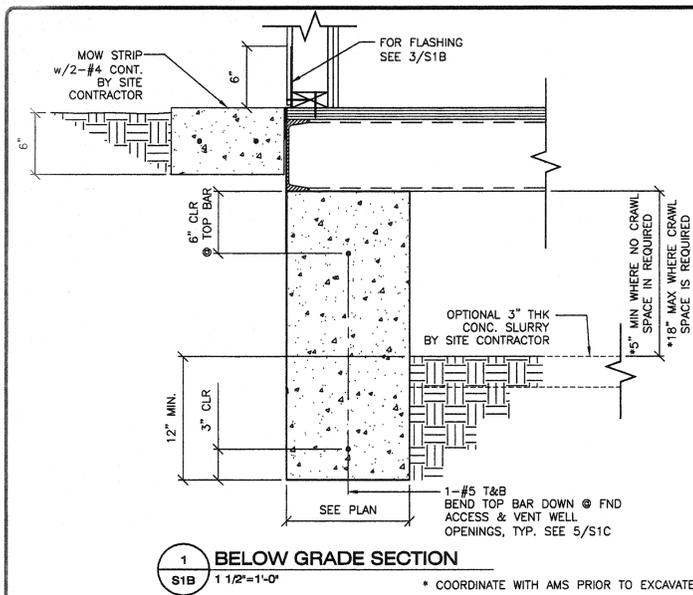

**REVISIONS**

NO	DATE	DESCRIPTION
1		
2		
3		
4		

DATE: 02/21/08  
SCALE: NOTED  
DRAWN BY: DM  
SERIAL NO.:

CUSTOMER:  
**12' x 40' RELOCATABLE BUILDINGS  
CONCRETE FOUNDATION DETAILS**




APPROVALS:  
THESE DRAWINGS ARE PRELIMINARY AND NOT FOR CONSTRUCTION UNLESS STAMPED & SIGNED BY THE ENGINEER OF RECORD.

IDENTIFICATION STAMP  
DIV. OF THE STATE ARCHITECT  
OFFICE OF REGULATION SERVICES  
69-112985  
AC: FLS SS: JLL  
DATE: 2/10/08


IDENTIFICATION STAMP  
DIV. OF THE STATE ARCHITECT  
OFFICE OF REGULATION SERVICES  
PC 02-109808  
AC: FLS SS: JLL  
DATE: 4/1/09

PROJECT No.  
**S1B**

THESE DRAWINGS AND SPECIFICATIONS ARE THE PROPERTY OF AMERICAN MODULAR SYSTEMS, INC. AND ARE NOT TO BE REPRODUCED, CHANGED OR COPIED IN ANY FORM OR MANNER, NOR ARE THEY TO BE ASSIGNED TO ANY THIRD PARTY WITHOUT THE WRITTEN AUTHORIZATION OF AMERICAN MODULAR SYSTEMS, INC.

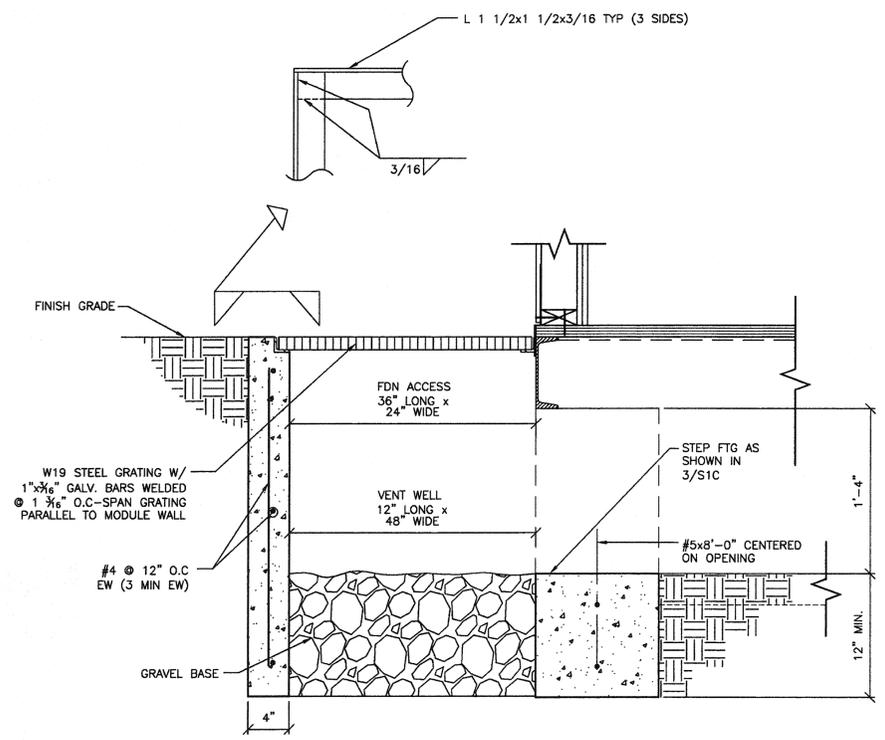

**1** OPTIONAL FOUNDATION ACCESS/VENT WELL  
S1C 1 1/2"=1'-0"

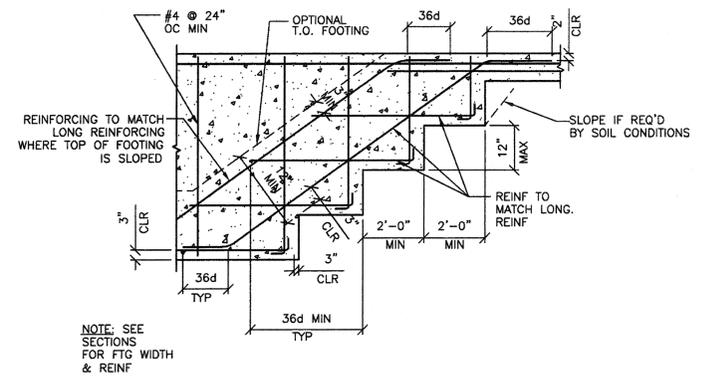


**3** TYPICAL STEPPED FOOTING  
S1C N.T.S.

ANCHOR TYPE	HILTI KWIK KB-TZ ICC ESR-1917			SIMPSON STRONG-BOLT ICC ESR-1771			
ANCHOR SIZE (IN)	1/2"Ø	5/8"Ø	3/4"Ø	1/2"Ø	5/8"Ø	3/4"Ø	1"Ø
MIN EMBED (IN)	4"	4 3/4"	5 3/4"	3 7/8"	5 1/8"	5 3/4"	5 1/4"
TENSION TEST LBS (SINGLE BOLT)	5121#	8040#	7917#	3826#	6732#	5454#	3550#
TENSION TEST LBS (DOUBLE BOLT)	5121#	6174#	5889#	3826#	5102#	4122#	N/A
INSTALLATION TORQUE (FT-LB)	40	60	110	50	85	180	230


- TENSION TEST - 2 x ALLOWABLE TENSION LOAD PER DSA IR 19-1.
- NORMAL WEIGHT CONCRETE WITH  $f'_c = 2500$  PSI TO COMPLY WITH 1916A.4 FOR MATERIAL TEST WAIVER.
- MINIMUM EDGE DISTANCE REQUIRED 6"

**4** ANCHOR BOLT SCHEDULE  
S1C N.T.S.

- NOTES:
- AS AN OPTION TO INDIVIDUAL PIPE SLEEVES THE FOOTING MAY BE BLOCKED OUT FOR MULTIPLE PIPES (8" HIGH x 18" WIDE MAX @ OPTION "A", 6" HIGH x 18" WIDE MAX @ OPTION "B"). PROVIDE 1" MIN CLEARANCE ALL AROUND BTWN PIPES/CONDUITS & BLOCKOUT/SLEEVES & FILL W/ CAULK.
  - CONCRETE SHALL BE WELL CONSOLIDATED AROUND & UNDER PIPES, CONDUITS, SLEEVES, BLOCKOUTS TO PREVENT CONCRETE VOIDS.
  - PROVIDE 2" CLEAR MIN BETWEEN BLOCKOUT/SLEEVES AND REINFORCEMENT.
  - WHERE TOP OF PIPES/CONDUITS ARE 12" OR MORE BELOW THE BOTTOM OF THE FOOTING, THICKENED FOOTING AROUND PIPES/CONDUITS IS NOT REQUIRED. BACKFILL & COMPACT TO 95% OVER PIPES/CONDUITS PRIOR TO PLACING FOOTING.

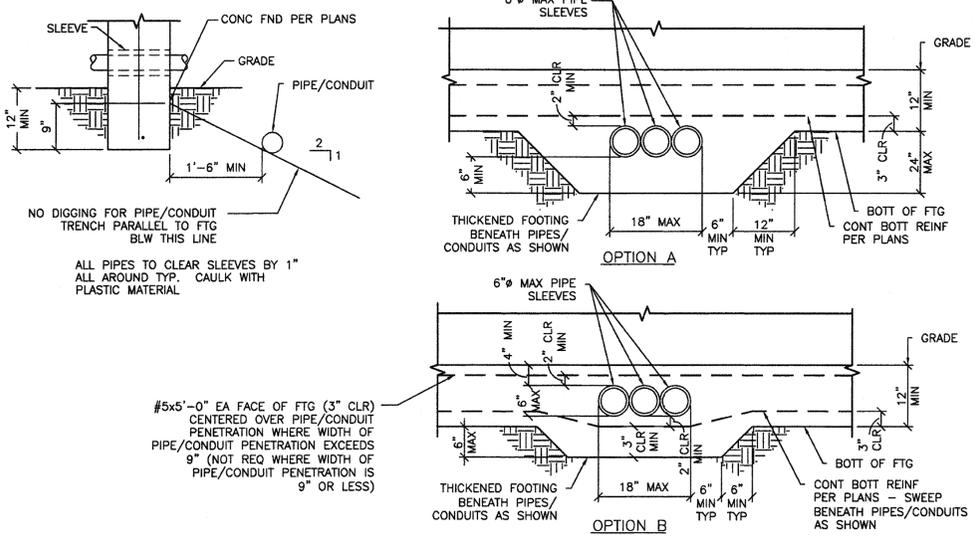

**2** PIPE SLEEVE DETAIL  
S1C 1 1/2"=1'-0"

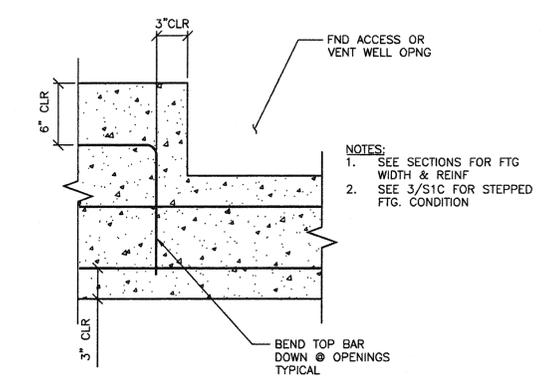

**5** VENT/ACCESS VENT OPENING DETAIL  
S1C 1 1/2"=1'-0"

REVISIONS		
NO	DATE	DESCRIPTION

DATE: 02/21/08  
SCALE: NOTED  
DRAWN BY: DM  
SERIAL NO.:

CUSTOMER:  
**12' x 40' RELOCATABLE BUILDINGS  
CONCRETE FOUNDATION DETAILS**





APPROVALS:  
THESE DRAWINGS ARE PRELIMINARY AND NOT FOR CONSTRUCTION UNLESS STAMPED & SIGNED BY THE ENGINEER OF RECORD.  
*Professional Engineer Seal*

IDENTIFICATION STAMP  
DIV. OF THE STATE ARCHITECT  
OFFICE OF REGULATION SERVICES  
03-112985  
AC X FLS SS M  
DATE 2/21/08


IDENTIFICATION STAMP  
DIV. OF THE STATE ARCHITECT  
OFFICE OF REGULATION SERVICES  
PC 02-109608  
AC FLS SS DP  
DATE 4/16/09

PROJECT No.  
**S1C**

THESE DRAWINGS AND SPECIFICATIONS ARE THE PROPERTY OF AMERICAN MODULAR SYSTEMS, INC. AND ARE NOT TO BE REPRODUCED, CHANGED OR COPIED IN ANY FORM OR MANNER, NOR ARE THEY TO BE ASSIGNED TO ANY THIRD PARTY WITHOUT THE WRITTEN AUTHORIZATION OF AMERICAN MODULAR SYSTEMS, INC.

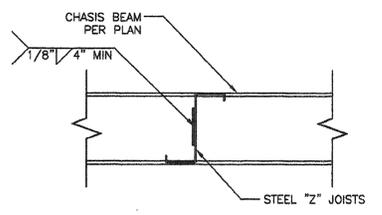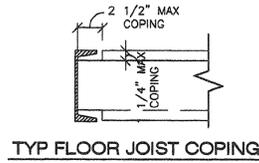

1 TYP. Z-JOIST ATTACHMENT TO BEAM  
S2 1 1/2"=1'-0"

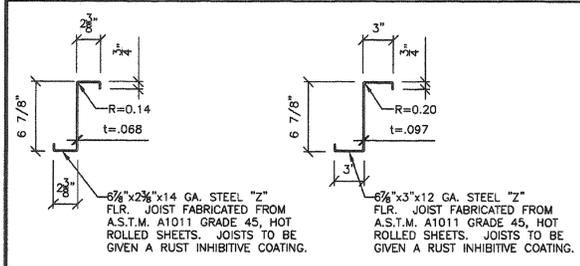


14 GA. JOIST      12 GA. JOIST


Z SECTION PROPERTIES  
A=0.89 IN.<sup>2</sup>  
Sx=1.85 IN.<sup>3</sup>  
Ix=6.37 IN.<sup>4</sup>

Z SECTION PROPERTIES  
A=1.38 IN.<sup>2</sup>  
Sx=2.97 IN.<sup>3</sup>  
Ix=10.20 IN.<sup>4</sup>

1A TYP. Z-JOISTS  
S2 1 1/2"=1'-0"

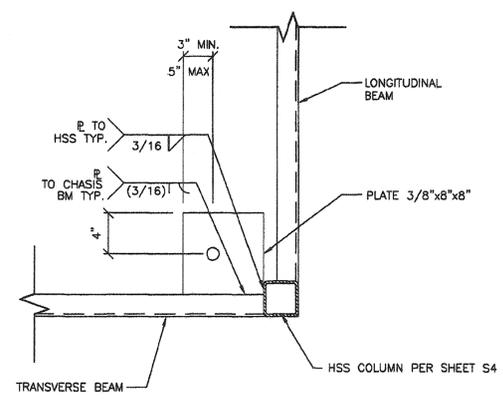

2 TYP. FL. BEAM CONNECTION  
S2 1 1/2"=1'-0"

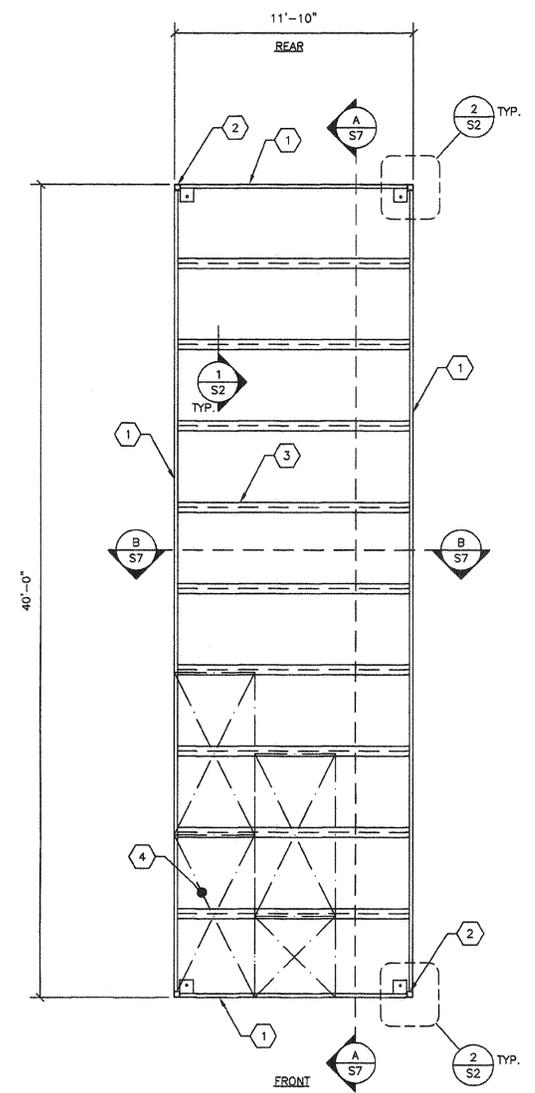

A TYPICAL FLOOR FRAMING PLAN  
S2 1/4"=1'-0" PLYWOOD FLOOR

- KEY NOTES -

- 1 C 7x8.8 FLOOR BEAM FOR 50 PSF + 15 PSF ALTERNATE C10x15.3 C 9x13.4 FOR 125 PSF
- 2 HSS COLUMN PER SHEET S4
- 3 FLOOR JOIST PER SCHEDULE (SEE 1A/S2)

LIVE LOAD PSF	SPACING	
	14 GA. JOIST	12 GA. JOIST
50 + 15	24" O.C.	48" O.C.
125		24" O.C.

- 4 1 1/8" T&G PLYWOOD FLOOR SH'T'G STURDI-I-FLOOR 48" O.C SPAN RATING EXP. 1 CONFORMING TO PS 1-95 OPTION: UNI-FLOOR BY PITTSBURGH TESTING LAB CONFORMING TO PS 1-95. STAGGER SHEETS 48" O.C AS SHOWN W/ FACE GRAIN NORMAL TO FLOOR JOISTS. FASTENING: BOUNDARY OF EA. MODULE: #12x2 1/4" WOOD TEK CHANNEL @ 6" O.C PANEL EDGES: ET&F 0.144"x2" MIN. POWER DRIVEN PINS @ 6" O.C FIELD: ET&F 0.144"x2" MIN. POWER DRIVEN PINS @ 10" O.C. NOTE: SEE ICC ER-4144 FOR ET&F BRAND PNEUMATIC PINS.

- GENERAL NOTES -

- 1. THE MATERIAL THICKNESS OF STRUCTURAL MEMBER, IN THEIR END-USE, SHALL MEET OR EXCEED THE MINIMUM BASE METAL THICKNESS SPECIFIED IN THE TABLE OR IN THE PLAN. THE MATERIAL GAGE DESIGNATION IN THE PLAN SHALL BE USED AS REFERENCE ONLY.

NO.	DATE	DESCRIPTION

DATE: 02/21/08  
SCALE: NOTED  
DRAWN BY: DM  
SERIAL NO.:

CUSTOMER:  
**12' x 40' RELOCATABLE BUILDINGS  
FLOOR FRAMING PLAN & DETAILS (PLYWOOD OPTION)**




APPROVALS:  
THESE DRAWINGS ARE PRELIMINARY AND NOT FOR CONSTRUCTION UNLESS STAMPED & SIGNED BY THE ENGINEER OF RECORD.  
*Kenneth A. Luttrell*  
REGISTERED PROFESSIONAL ENGINEER  
No. 4478  
EXP. 3-31-11  
Structural Engineer  
STATE OF CALIFORNIA


IDENTIFICATION STAMP  
DIV. OF THE STATE ARCHITECT  
OFFICE OF REGULATION SERVICES  
05-112985  
AC: FLS  
DATE: 2/10/08

IDENTIFICATION STAMP  
DIV. OF THE STATE ARCHITECT  
OFFICE OF REGULATION SERVICES  
PC 02-109806  
AC: FLS  
DATE: 2/10/08


PROJECT No.  
**S2**

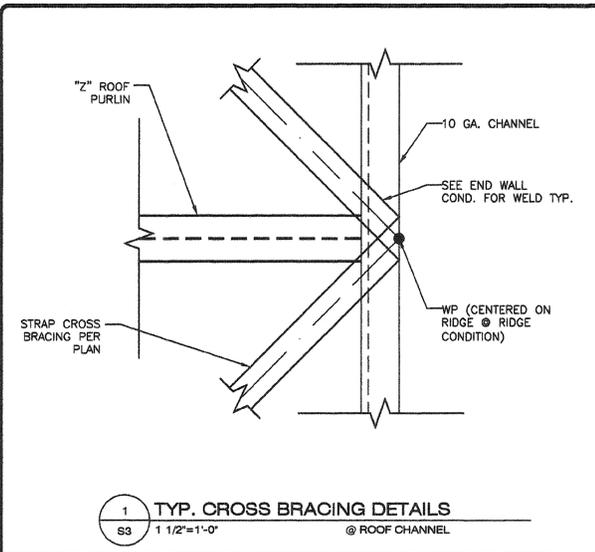


1 TYP. CROSS BRACING DETAILS  
S3 1 1/2"=1'-0" @ ROOF CHANNEL

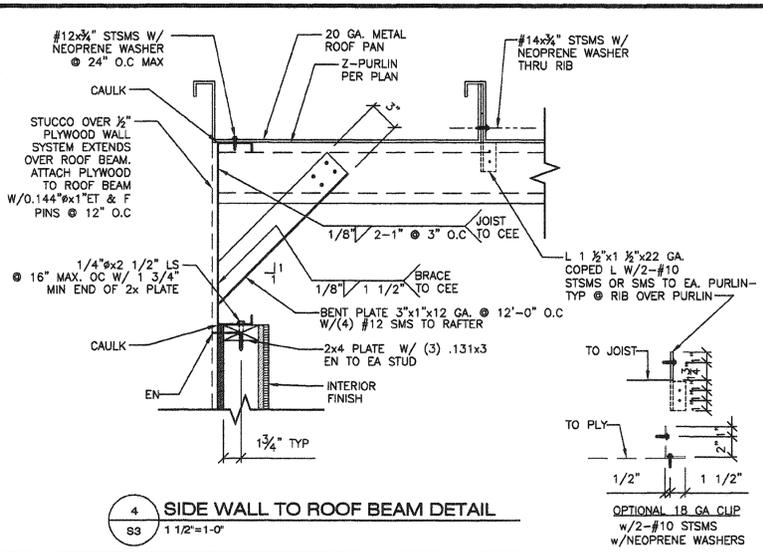


4 SIDE WALL TO ROOF BEAM DETAIL  
S3 1 1/2"=1'-0"

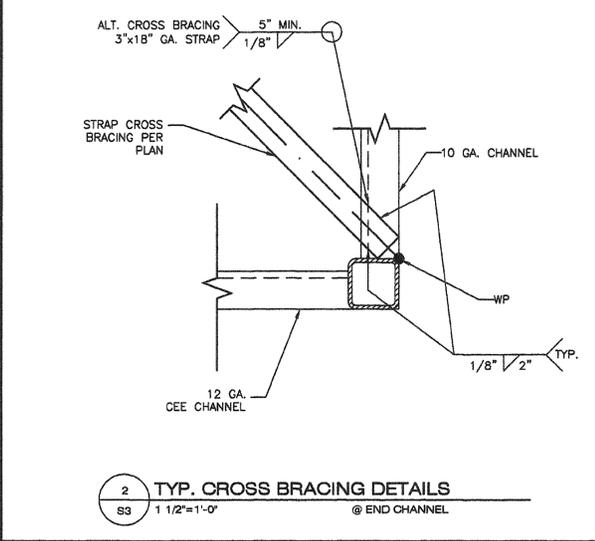


2 TYP. CROSS BRACING DETAILS  
S3 1 1/2"=1'-0" @ END CHANNEL

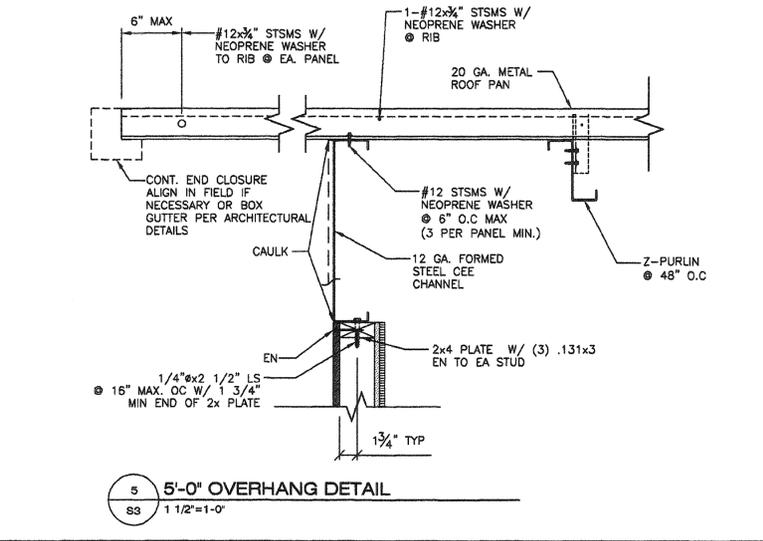


5 5'-0" OVERHANG DETAIL  
S3 1 1/2"=1'-0"

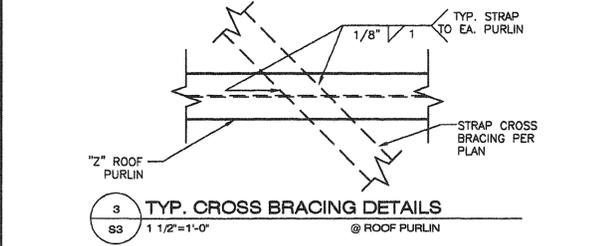


3 TYP. CROSS BRACING DETAILS  
S3 1 1/2"=1'-0" @ ROOF PURLIN

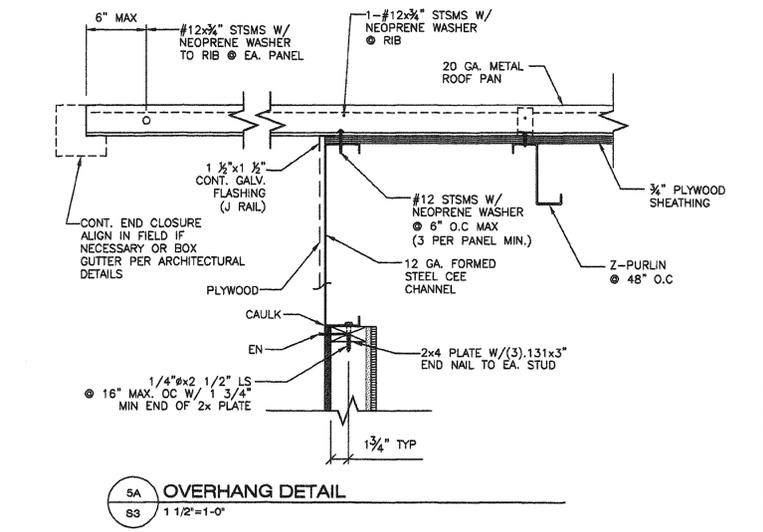

5A OVERHANG DETAIL  
S3 1 1/2"=1'-0"

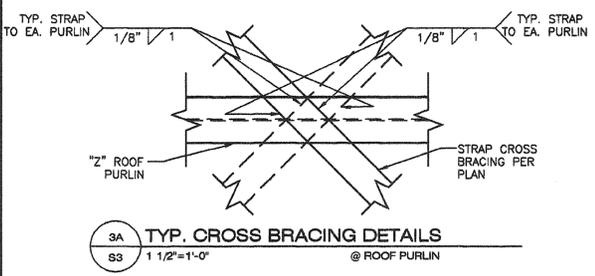

3A TYP. CROSS BRACING DETAILS  
S3 1 1/2"=1'-0" @ ROOF PURLIN

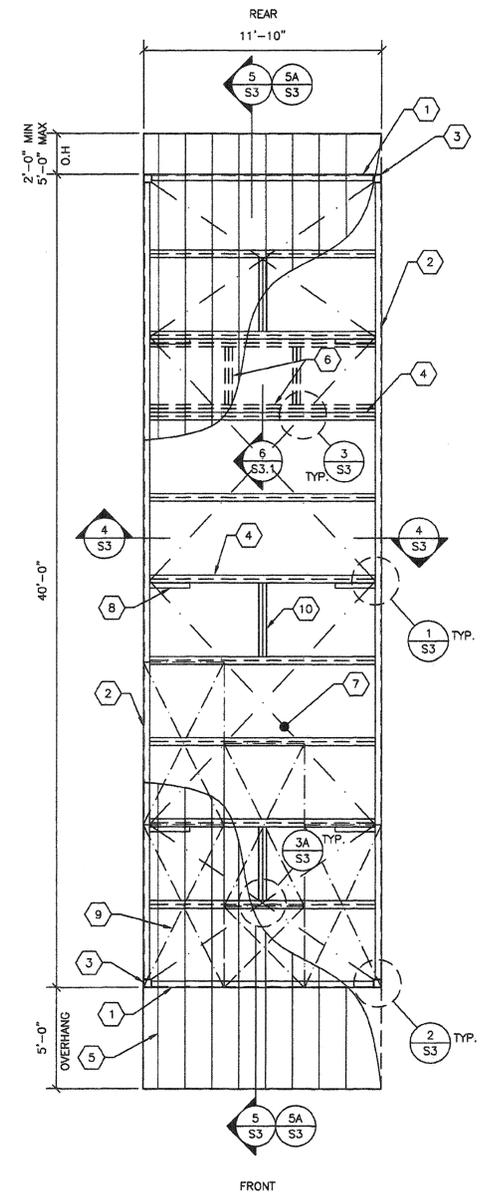

A TYPICAL ROOF FRAMING LAYOUT  
S3 1/4"=1'-0" (MONODUAL PITCH-OPEN SOFFIT)

- KEY NOTES -**
- 12 GA. TRANSVERSE BEAM PER 10/S3.1
  - LONGITUDINAL ROOF CHANNEL TYP. PER 9/S3.1
  - HSS COLUMN PER SHEET S4
  - 2\"/>

**FASTENING SCHEDULE**

NAILING	0.144 PINS SPACING		# 10 SMS SPACING	
	TYPICAL	WITHIN 3' OF BUILDING CORNERS	TYPICAL	WITHIN 3' OF BUILDING CORNERS
BOUNDARY	6" O.C.	6" O.C.	6" O.C.	6" O.C.
EDGE	6" O.C.	6" O.C.	6" O.C.	6" O.C.
FIELD	12" O.C.	6" O.C.	12" O.C.	12" O.C.

ET & F 0.144 PINS PER ICC ESR #4144

- GENERAL NOTES -**
1. THE MATERIAL THICKNESS OF STRUCTURAL MEMBER, IN THEIR END-USE, SHALL MEET OR EXCEED THE MINIMUM BASE METAL THICKNESS SPECIFIED IN THE TABLE OR IN THE PLAN. THE MATERIAL GAGE DESIGNATION IN THE PLAN SHALL BE USED AS REFERENCE ONLY.
  2. SEE SHEET S5 FOR TYP. SIDE WALL FRAMING.
  3. SEE SHEET S5 FOR TYP. END WALL FRAMING.
  4. ALL FASTENERS THRU METAL ROOF PANEL SHALL BE INSTALLED W/NEOPRENE WASHERS.

**REVISIONS**

NO.	DATE	DESCRIPTION

DATE: 02/25/08  
SCALE: NOTED  
DRAWN BY: DM  
SERIAL NO.:

CUSTOMER:  
12' x 40' RELOCATABLE BUILDINGS  
ROOF FRAMING PLAN & DETAILS (OPEN SOFFIT OPTION)




APPROVALS:  
THESE DRAWINGS ARE PRELIMINARY AND NOT FOR CONSTRUCTION UNLESS STAMPED & SIGNED BY THE ENGINEER OF RECORD.  
Kenneth A. Luttrell  
No. 1418  
Exp. 3-31-11  
Structural Engineer  
STATE OF CALIFORNIA


IDENTIFICATION STAMP  
DIV. OF THE STATE ARCHITECT  
OFFICE OF REGULATION SERVICES  
05-112985  
PC 02-109808  
AC: FLB  
DATE: 2/10/08

PROJECT No.  
S3

THESE DRAWINGS AND SPECIFICATIONS ARE THE PROPERTY OF AMERICAN MODULAR SYSTEMS, INC. AND ARE NOT TO BE REPRODUCED, CHANGED OR COPIED IN ANY FORM OR MANNER, NOR ARE THEY TO BE ASSIGNED TO ANY THIRD PARTY WITHOUT THE WRITTEN AUTHORIZATION OF AMERICAN MODULAR SYSTEMS, INC.

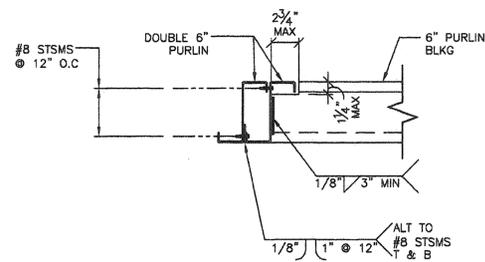

6 BLOCKING DETAIL  
S3.1 1 1/2"=1'-0"

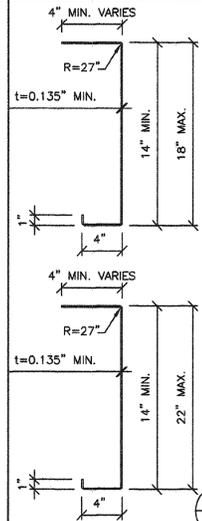


	14"	18"
A	3.14 IN <sup>2</sup>	3.71 IN <sup>2</sup>
S <sub>x</sub> MIN.	12.07 IN <sup>3</sup>	17.32 IN <sup>3</sup>
I <sub>x</sub> MIN.	86.94 IN <sup>4</sup>	159.80 IN <sup>4</sup>

BEAM FABRICATED FROM ASTM A1011  
GR50 W/RUST INHIBITIVE COATING.


	14"	22"
A	3.14 IN <sup>2</sup>	4.28 IN <sup>2</sup>
S <sub>x</sub> MIN.	12.07 IN <sup>3</sup>	23.33 IN <sup>3</sup>
I <sub>x</sub> MIN.	86.94 IN <sup>4</sup>	262.35 IN <sup>4</sup>

BEAM FABRICATED FROM ASTM A1011  
GR50 W/RUST INHIBITIVE COATING.

9 LONGITUDINAL ROOF BEAM  
S3.1 1 1/2"=1'-0"

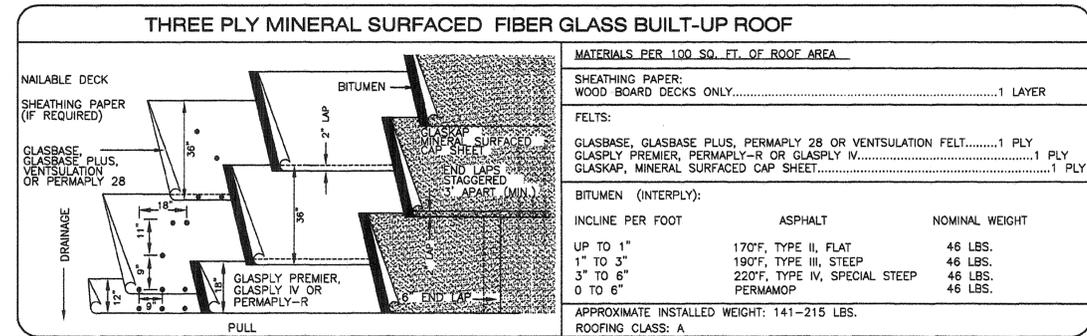


12 THREE PLY MINERAL BUILT-UP ROOF  
S3.1 1 1/2"=1'-0"

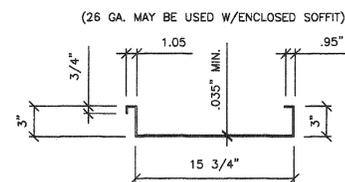

$S_x(t) = 0.418 \text{ IN}^3$   
 $S_x(b) = 1.412 \text{ IN}^3$   
 $I_x = 0.968 \text{ IN}^4$

PAN FABRICATED FROM ASTM A1011 GRADE 36,  
HOT ROLLED SHEETS. PAN TO BE GIVEN A  
RUST INHIBITIVE COATING.


7 20 GA. ROOF PAN  
S3.1 1 1/2"=1'-0"

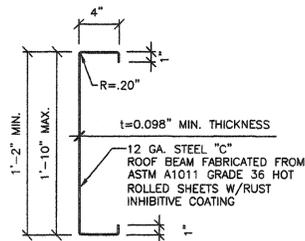

TYPICAL SECTION


C SECTION PROPERTIES  
D=1'-2"  
A=2.36 IN<sup>2</sup>  
S<sub>x</sub>=9.57 IN<sup>3</sup>  
I<sub>x</sub>=67.02 IN<sup>4</sup>

10 12 GA. ROOF CHANNEL  
S3.1 1 1/2"=1'-0"

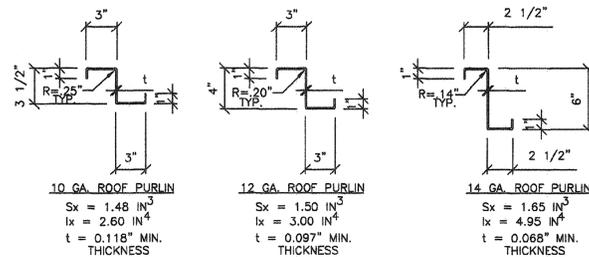

JOIST FABRICATED FROM ASTM A1011  
GRADE 36. HOT ROLLED SHEETS. JOISTS  
TO BE GIVEN A RUST INHIBITIVE COATING.

8 Z PURLINS DETAILS AND PROPERTIES  
S3.1 1 1/2"=1'-0"

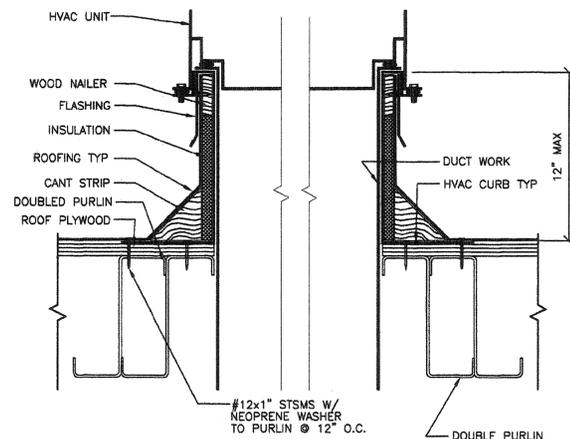

11 HVAC CURB DETAIL ANCHORAGE  
S3.1 3"=1'-0"

- GENERAL NOTES -  
1. THE MATERIAL THICKNESS OF STRUCTURAL MEMBER, IN THEIR END-USE, SHALL MEET OR EXCEED THE MINIMUM BASE METAL THICKNESS SPECIFIED IN THE TABLE OR IN THE PLAN. THE MATERIAL GAGE DESIGNATION IN THE PLAN SHALL BE USED AS REFERENCE ONLY.

NO	DATE	DESCRIPTION

DATE: 02/26/08  
SCALE: NOTED  
DRAWN BY: DM  
SERIAL NO.:

CUSTOMER:  
12' x 40' RELOCATABLE BUILDINGS  
ROOF FRAMING DETAILS










APPROVALS:  
KENNETH A. LUTHELMAN  
No. 1418  
EXP. 3-31-11  
Structural Engineer  
STATE OF CALIFORNIA

IDENTIFICATION STAMP  
DIV. OF THE STATE ARCHITECT  
OFFICE OF REGULATION SERVICES  
03-112985  
AC FLS SS YJA  
DATE 2/20/10

IDENTIFICATION STAMP  
DIV. OF THE STATE ARCHITECT  
OFFICE OF REGULATION SERVICES  
PC 02-108808  
AC FLS SS YJA  
DATE 4/1/07

PROJECT No.  
S3.1

THESE DRAWINGS AND SPECIFICATIONS ARE THE PROPERTY OF AMERICAN MODULAR SYSTEMS, INC. AND ARE NOT TO BE REPRODUCED, CHANGED OR COPIED IN ANY FORM OR MANNER, NOR ARE THEY TO BE ASSIGNED TO ANY THIRD PARTY WITHOUT THE WRITTEN AUTHORIZATION OF AMERICAN MODULAR SYSTEMS, INC.

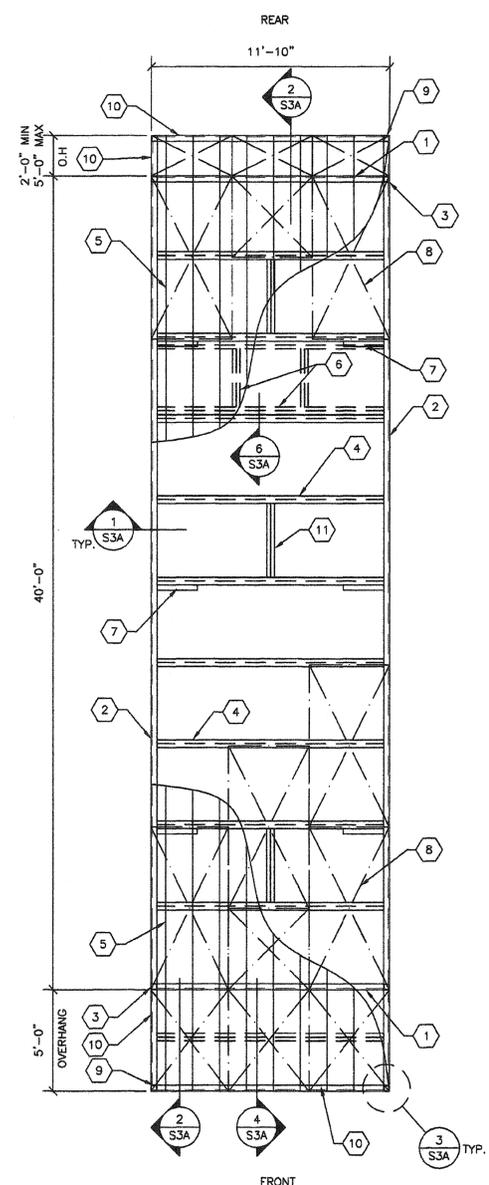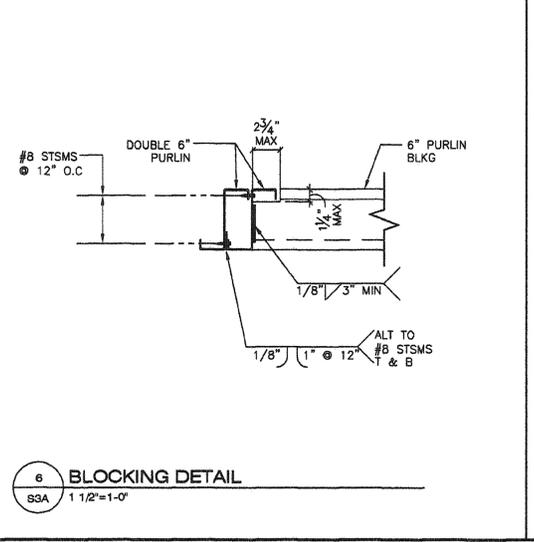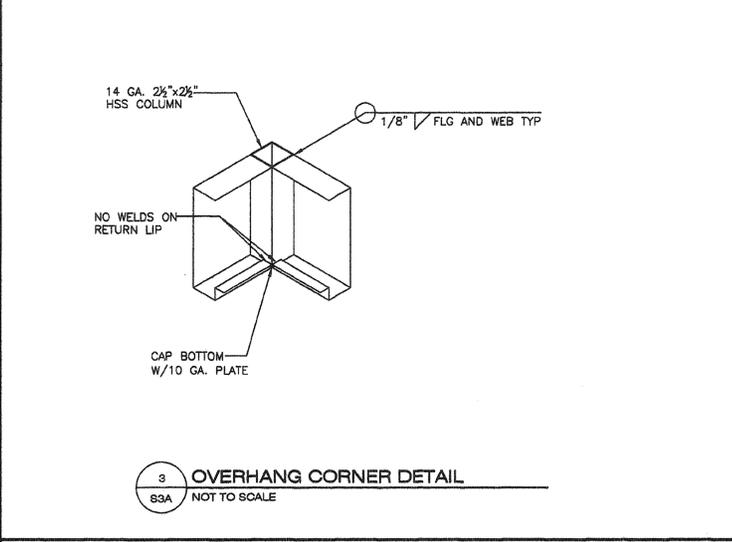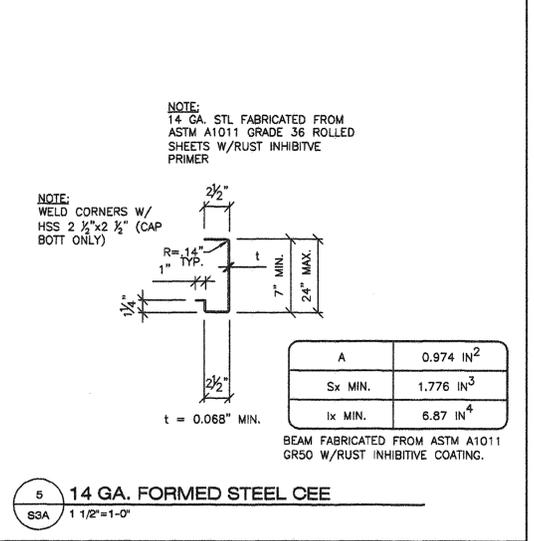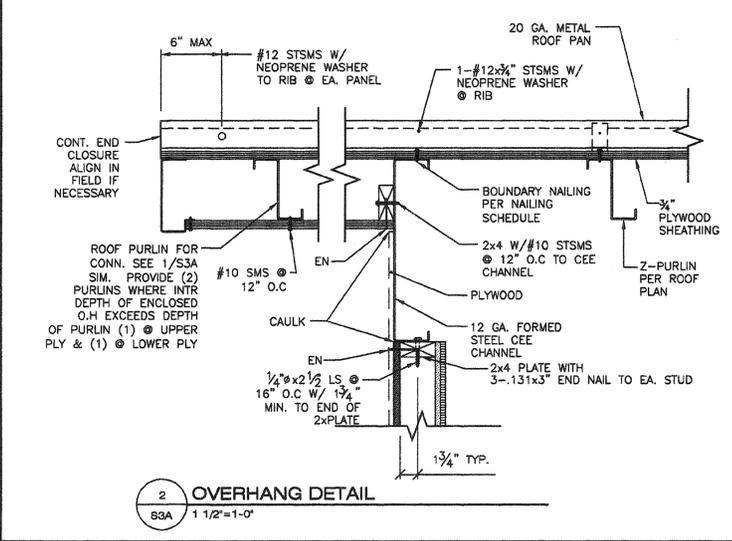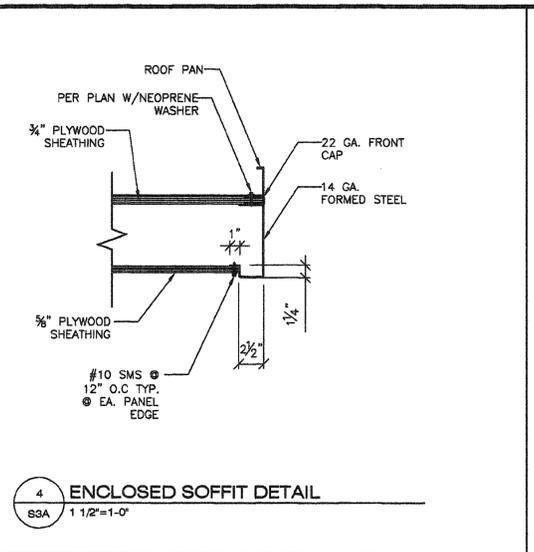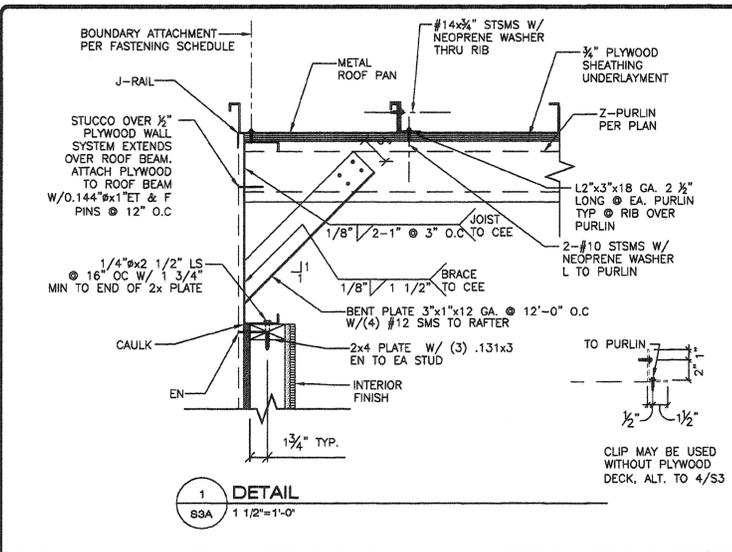

- KEY NOTES -**
- 12 GA. TRANSVERSE BEAM PER 10/S3.1
  - LONGITUDINAL ROOF CHANNEL TYP. PER 9/S3.1
  - HSS PER SHEET S4
  - 2' FORMED ROOF PURLINS PER 8/S3.1 @ 48" O.C. MAX
  - 20 GA. ROOF PAN (ALT. 26 GA. ROOF PAN OVER PLYWOOD)
  - PROVIDE DOUBLE 6" PURLINS W/6" PURLIN BLKG PER 6/S3A @ OPTIONAL 600# HVAC. (10'-0" MAX FROM END OF BLDG TO CENTER OF UNIT)
  - 3"x12 GA. BENT PLATE TO 10 GA. BEAM @ 12'-0" OC MAX PER 1/S3A. PROVIDE PURLIN BLOCKING @ EACH BRACE PER (1) BELOW. (IF CROSS BRACING IS USED THEN REFER TO PLAN 1/S3 FOR BENT PLATE LOCATIONS, AND PROVIDE CROSS BRACING AT OVERHANGS)
  - 3/4" APA RATED L-P OSB SHEATHING OR 3/4" PLYWOOD (ALL SHEATHING SHALL BE EITHER T&G OR EDGE CLIP). COMPLY WITH DSA PA-062, CD EXPOSURE-1 48/24 SPAN INDEX, FACE GRAIN NORMAL TO ROOF PURLINS. ROOF SHING MAY BE REPLACED BY STRAP CROSS BRACING (REFER TO SHEET S3 FOR DETAILS, AND PROVIDE CROSS BRACING AT OVERHANGS). ALL BOUNDARY, EDGE & FIELD ATTACHMENTS SHALL BE 1" MIN. FROM EDGE OF PLYWOOD & EDGE OF STEEL SUPPORTING MEMBER. REFER TO SCHEDULE BELOW FOR FASTENING.
  - HSS COLUMN 14 GA. 2 1/2"x2 1/2" TYP. SEE 3/S3A
  - 14 GA. FORMED STEEL CEE SEE 5/S3A
  - PURLIN BLOCKING WELD TO ROOF PURLIN PER DETAIL 6/S3A. BLOCKING IS ONLY REQUIRED AT PURLINS WITH DIAGONAL BRACING PER (7) ABOVE

**FASTENING SCHEDULE**

NAILING	0.144 PINS SPACING		# 10 SMS SPACING	
	TYPICAL	WITHIN 3' OF BUILDING CORNERS	TYPICAL	WITHIN 3' OF BUILDING CORNERS
BOUNDARY	6" O.C.	6" O.C.	6" O.C.	6" O.C.
EDGE	6" O.C.	6" O.C.	6" O.C.	6" O.C.
FIELD	12" O.C.	6" O.C.	12" O.C.	12" O.C.

ET & F 0.144 PINS PER ICC ESR #4144

- GENERAL NOTES -**
- THE MATERIAL THICKNESS OF STRUCTURAL MEMBER, IN THEIR END-USE, SHALL MEET OR EXCEED THE MINIMUM BASE METAL THICKNESS SPECIFIED IN THE TABLE OR IN THE PLAN. THE MATERIAL GAGE DESIGNATION IN THE PLAN SHALL BE USED AS REFERENCE ONLY.
  - SEE SHEET S5 FOR TYP. SIDE WALL FRAMING.
  - SEE SHEET S5 FOR TYP. END WALL FRAMING.
  - ALL FASTENERS THRU METAL ROOF PANEL SHALL BE INSTALLED W/NEOPRENE WASHERS.

**REVISIONS**

NO.	DATE	DESCRIPTION

DATE: 02/25/08  
 SCALE: NOTED  
 DRAWN BY: DM  
 SERIAL NO.:

CUSTOMER:  
 12' x 40' RELOCATABLE BUILDINGS  
 ROOF FRAMING PLAN & DETAILS (ENCLOSED SOFFIT OPTION)

**AMS**  
 American Modular Systems Inc.  
 787 Spreckels Ave. Manteca, CA 95336  
 (209)825-1921 Fax (209)825-7018  
 americanmodular.com


APPROVALS:  
 THESE DRAWINGS ARE PRELIMINARY AND NOT FOR CONSTRUCTION UNLESS STAMPED & SIGNED BY THE ENGINEER OF RECORD.

IDENTIFICATION STAMP  
 DIV. OF THE STATE ARCHITECT  
 05-112985  
 AC, FLS, S3A  
 DATE: 2/10/08


IDENTIFICATION STAMP  
 DIV. OF THE STATE ARCHITECT  
 OFFICE OF REGULATION SERVICES  
 PC 02-109808  
 AC, FLS, S3A  
 DATE: 2/17/08

PROJECT No.  
**S3A**

THESE DRAWINGS AND SPECIFICATIONS ARE THE PROPERTY OF AMERICAN MODULAR SYSTEMS, INC. AND ARE NOT TO BE REPRODUCED, CHANGED OR COPIED IN ANY FORM OR MANNER, NOR ARE THEY TO BE ASSIGNED TO ANY THIRD PARTY WITHOUT THE WRITTEN AUTHORIZATION OF AMERICAN MODULAR SYSTEMS, INC.

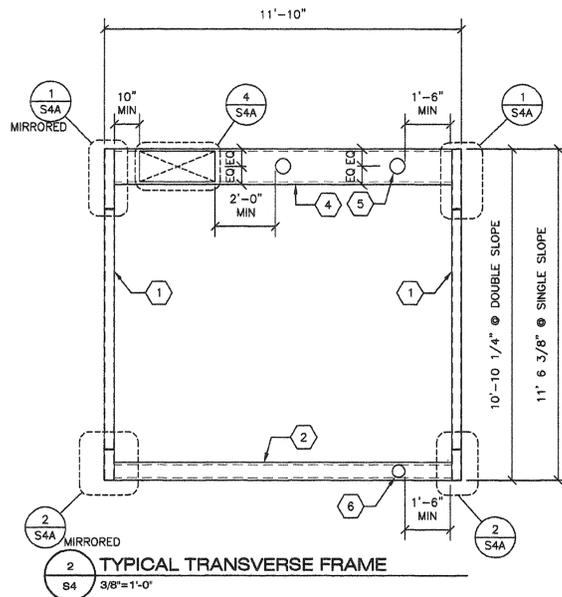

2 TYPICAL TRANSVERSE FRAME  
S4 3/8"=1'-0"

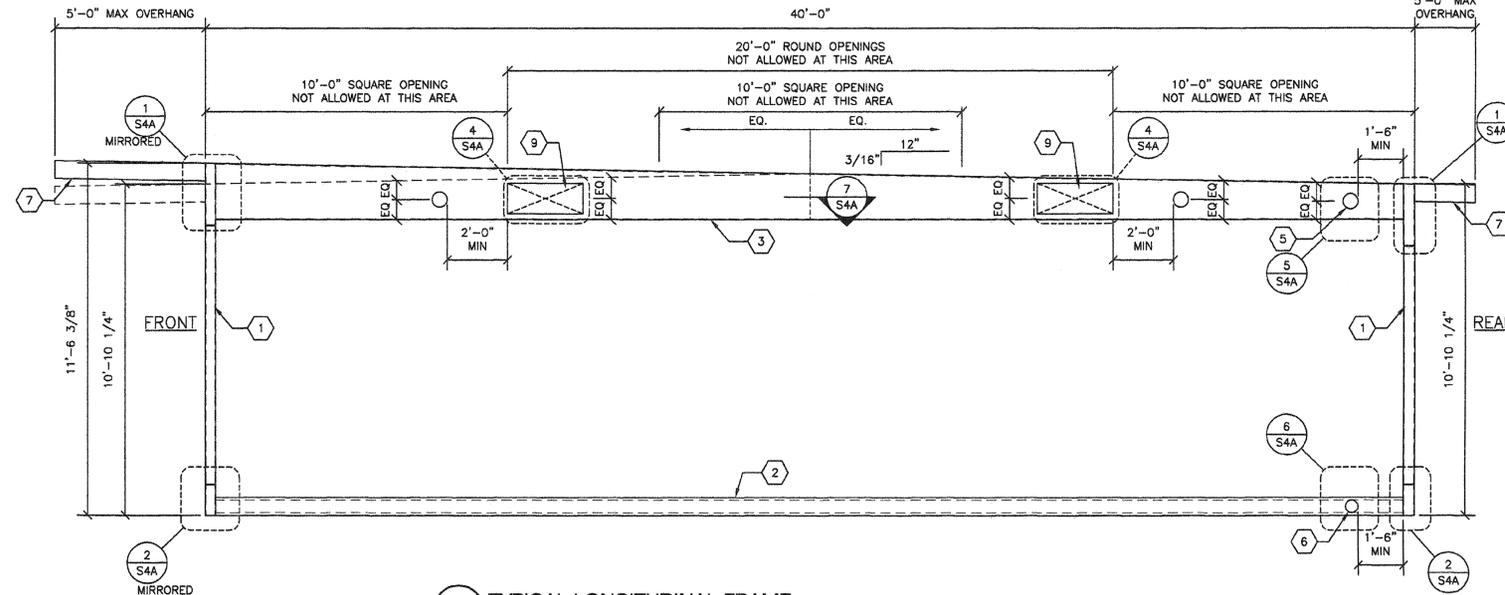


1 TYPICAL LONGITUDINAL FRAME  
S4 3/8"=1'-0"


- KEY NOTES -**
- 1 4x4x5/16 HSS COLUMN
  - 2 FLOOR BEAM PER SCHEDULE
  - 3 10 GA. LONGITUDINAL ROOF CHANNEL  
14"-18"-14" @ DOUBLE SLOPE  
14"-22" @ SINGLE SLOPE
  - 4 12 GA. TRANSVERSE ROOF CHANNEL  
14" MIN 22" MAX
  - 5 6" # MAX OPENING IN WEB OF ROOF BEAM  
WITHOUT WEB REINFORCEMENT  
MINIMUM SPACING OF HOLES @ 48" O.C.  
HOLES MAY OCCUR @ ANY LOCATION ALONG  
LENGTH OF ROOF BEAM EXCEPT AS NOTED  
OTHERWISE ON FRAMING ELEVATION  
NOTE: IF HOLE IS 3" OR LESS THEY MAY BE  
SPACED AT 24" O.C. MINIMUM
  - 6 4" # MAX OPENING IN WEB OF FLOOR BEAM  
WITHOUT WEB REINFORCEMENT  
MINIMUM SPACING OF HOLES @ 48" O.C.  
HOLES MAY OCCUR @ ANY LOCATION ALONG  
LENGTH OF FLOOR BEAM WITH DIRECT  
FOUNDATION SUPPORT BELOW. OPENINGS  
ARE NOT ALLOWED WHERE BEAMS ARE  
SPANNING BETWEEN FOUNDATIONS OR ACROSS  
VENT OPENINGS.  
NOTE: IF HOLE IS 2" OR LESS THEY MAY BE  
SPACED AT 24" MINIMUM
  - 7 14 GA. OUTRIGGER CHANNEL AT OPTIONAL  
ENCLOSED OVERHANG  
REFER TO DETAIL 1/S4A
  - 8 2x6 H.F. #2 OR BETTER STUDS @ 16" O.C.
  - 9 12"x 30" MAX OPENING ALLOWED ONLY  
AT EXTERIOR BEAMS WITH A WALL DIRECTLY  
BELOW. IF WALL BELOW IT IS REMOVED THEN  
A COLUMN MUST BE ADDED AT MID SPAN.  
REFER TO DETAIL 4/S4A FOR OPENING  
REINFORCEMENT

**- FLOOR BEAM SCHEDULE -**

SUBFLOOR TYPE	FLOOR BEAM SIZE	ALTERNATES
VIROC OR PLYWOOD	C7x9.8	C9x13.4, C10x15.3
CONCRETE	C9x13.4	C10x15.3

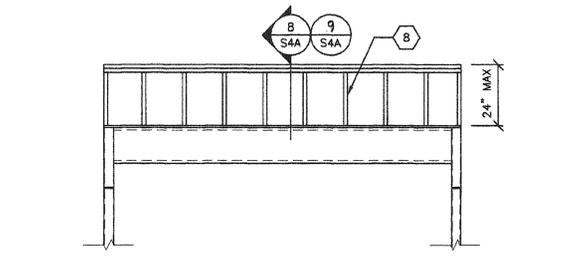

4 PARAPET WALL OPTION @ TRANSVERSE FRAME  
S4 3/8"=1'-0"

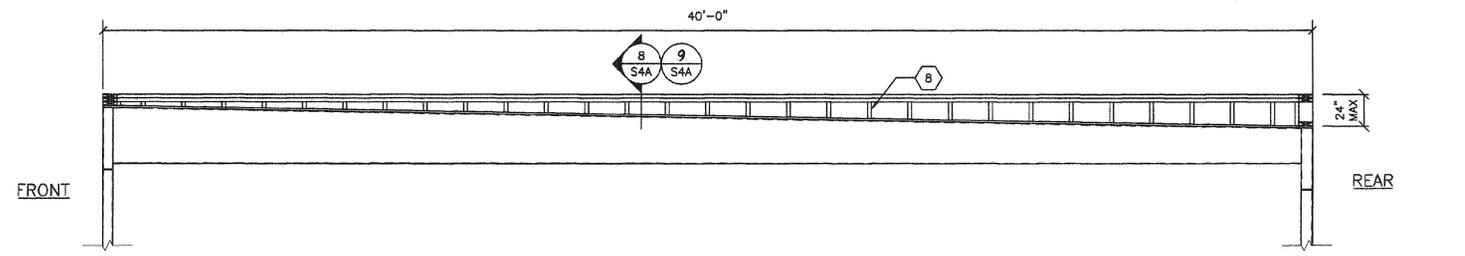

3 PARAPET WALL OPTION @ LONGITUDINAL FRAME  
S4 3/8"=1'-0"

**REVISIONS**

NO	DATE	DESCRIPTION

DATE: 02/25/08  
SCALE: NOTED  
DRAWN BY: DM  
SERIAL NO.:

CUSTOMER:  
  
12' x 40' RELOCATABLE BUILDINGS  
TYPICAL FRAME ELEVATIONS















APPROVALS:  
THESE DRAWINGS ARE PRELIMINARY AND NOT FOR CONSTRUCTION UNLESS STAMPED & SIGNED BY THE ENGINEER OF RECORD.  
Kenneth A. Luttrell  
No. 1419  
EXP. 3-31-11  
Structural Engineer  
STATE OF CALIFORNIA

IDENTIFICATION STAMP  
DIV. OF THE STATE ARCHITECT  
OFFICE OF REGULATION SERVICES  
PC 02-109808  
03-112985  
AC FLS  
DATE 2/11/09

IDENTIFICATION STAMP  
DIV. OF THE STATE ARCHITECT  
OFFICE OF REGULATION SERVICES  
PC 02-109808  
AC FLS  
DATE 2/11/09

PROJECT No.  
  
S4

THESE DRAWINGS AND SPECIFICATIONS ARE THE PROPERTY OF AMERICAN MODULAR SYSTEMS, INC. AND ARE NOT TO BE REPRODUCED, CHANGED OR COPIED IN ANY FORM OR MANNER, NOR ARE THEY TO BE ASSIGNED TO ANY THIRD PARTY WITHOUT THE WRITTEN APPROBATION OF AMERICAN MODULAR SYSTEMS, INC.

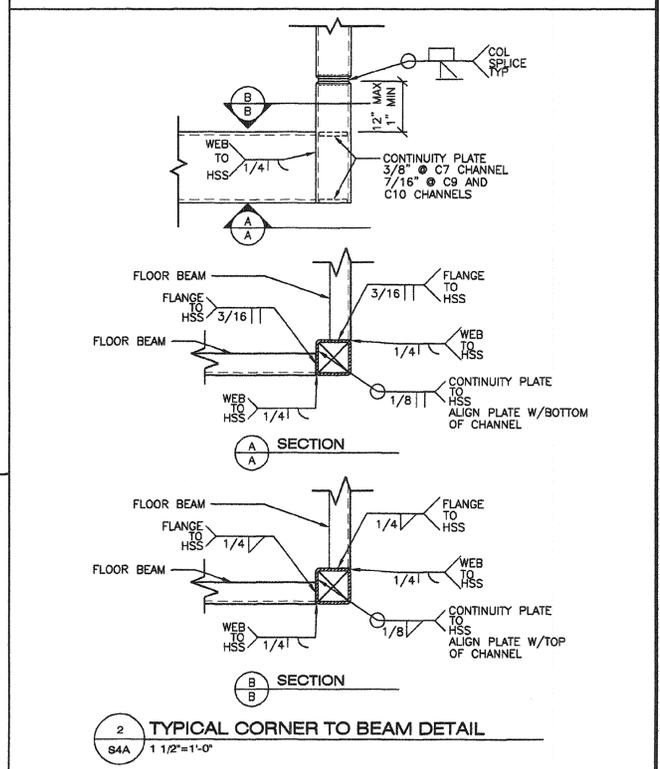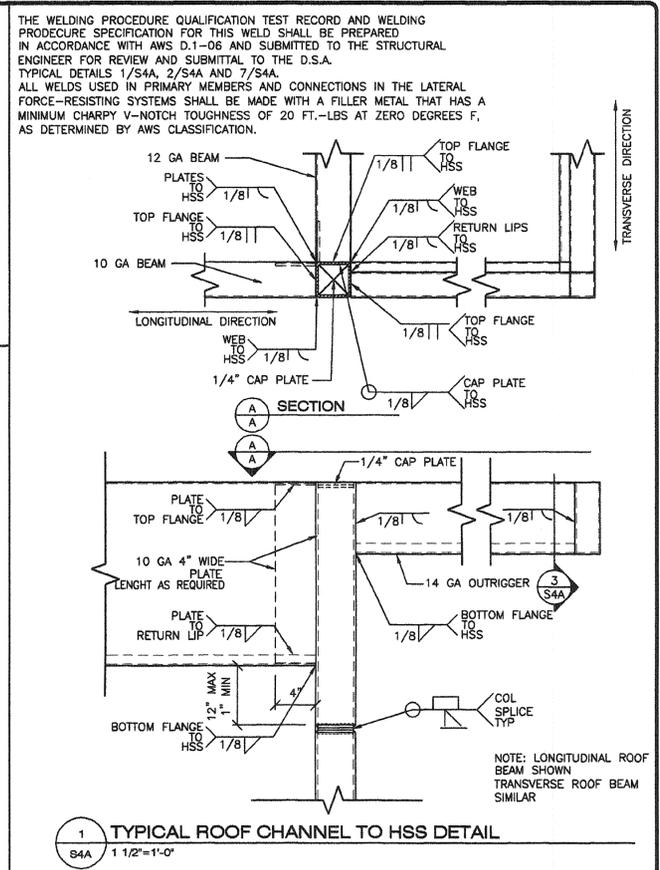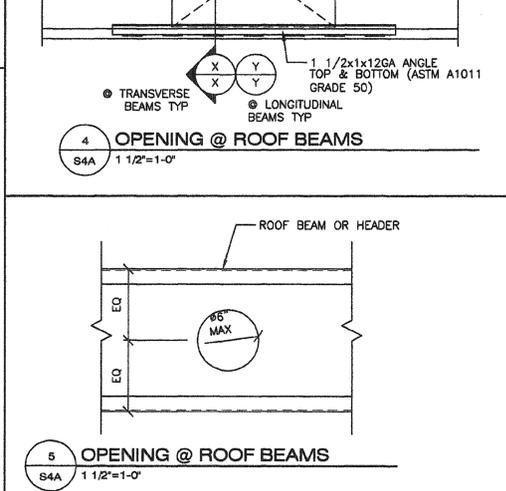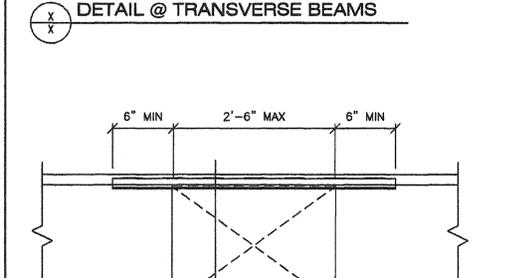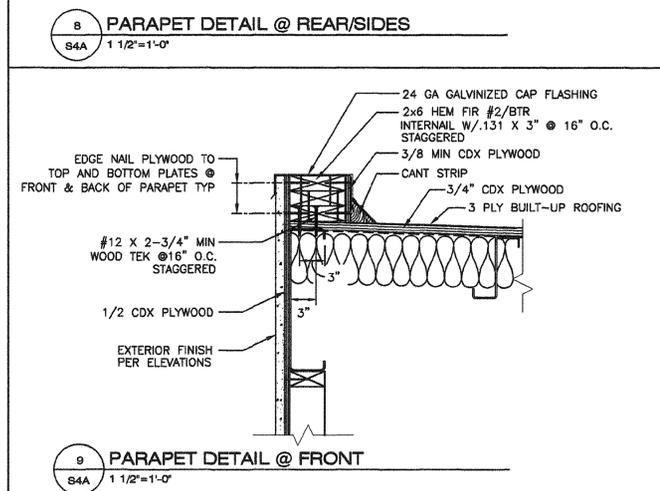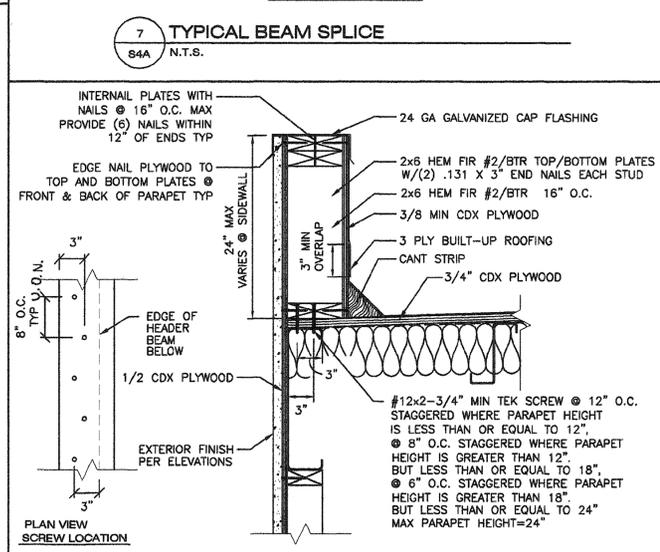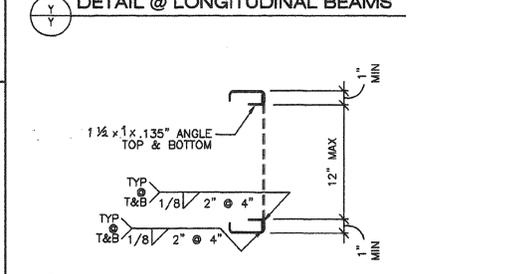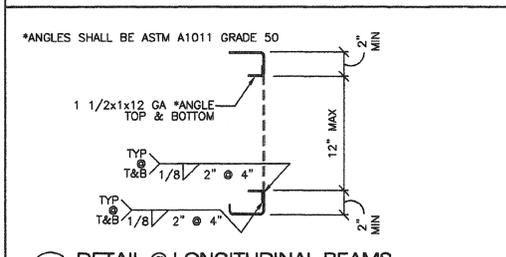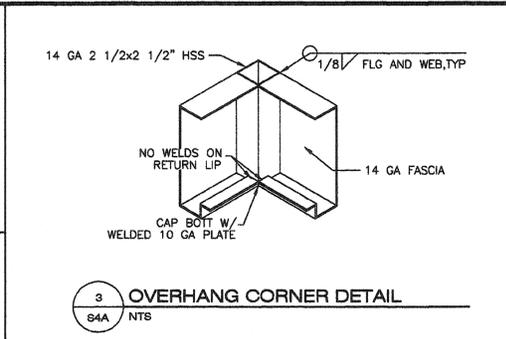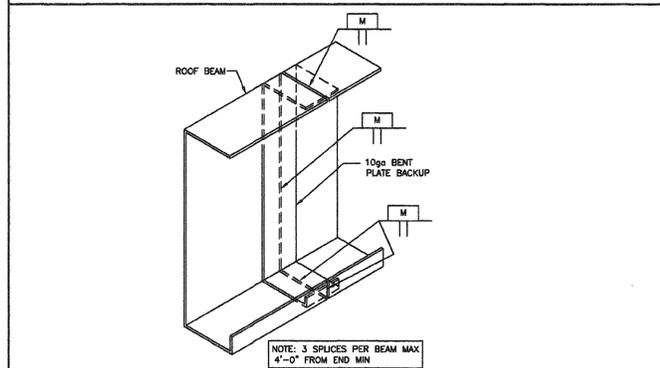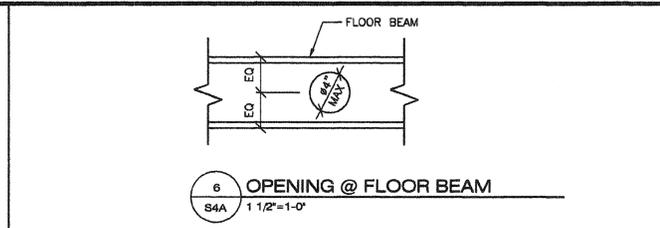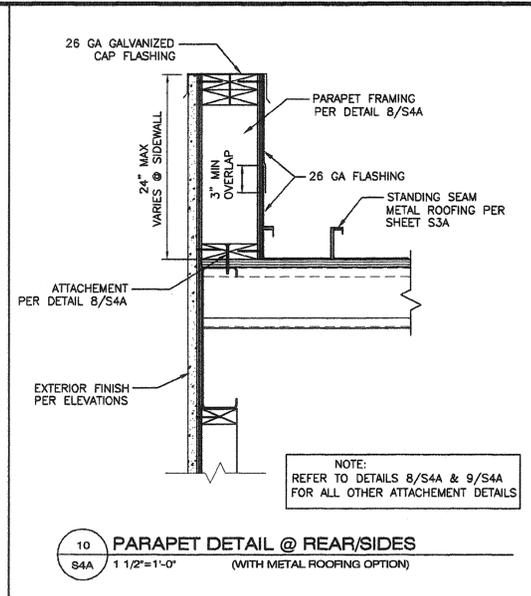

REVISIONS		
NO	DATE	DESCRIPTION

DATE: 02/25/08  
 SCALE: NOTED  
 DRAWN BY: DM  
 SERIAL NO.:

CUSTOMER:  
 12' x 40' RELOCATABLE BUILDINGS  
 FRAME CONNECTION DETAILS




APPROVALS:  
 THESE DRAWINGS ARE PRELIMINARY AND NOT FOR CONSTRUCTION UNLESS STAMPED & SIGNED BY THE ENGINEER OF RECORD.  
 PROFESSIONAL ENGINEER  
 Kenneth A. Luttrell  
 No. 1418  
 Exp. 3-31-11  
 Structural Engineer  
 DATE: 2/10/08


IDENTIFICATION STAMP  
 DIV. OF THE STATE ARCHITECT  
 03-112985  
 AC: FLS: SS: [initials]  
 DATE: 2/10/08

IDENTIFICATION STAMP  
 DIV. OF THE STATE ARCHITECT  
 OFFICE OF REGULATION SERVICES  
 PC 02-108608  
 AC: FLS: SS: [initials]  
 DATE: 2/10/08  
 PROJECT No. S4A


THESE DRAWINGS AND SPECIFICATIONS ARE THE PROPERTY OF AMERICAN MODULAR SYSTEMS, INC. AND ARE NOT TO BE REPRODUCED, CHANGED OR COPIED IN ANY FORM OR MANNER, NOR ARE THEY TO BE ASSIGNED TO ANY THIRD PARTY WITHOUT THE WRITTEN AUTHORIZATION OF AMERICAN MODULAR SYSTEMS, INC.

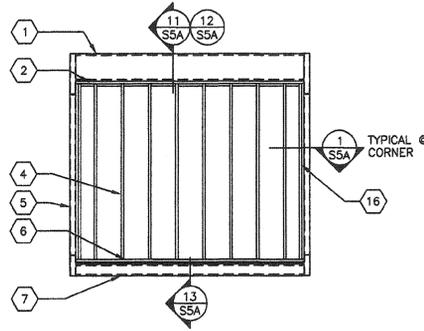


1 TYP END WALL FRAMING W/NO OPENINGS  
S5 1/4"=1'-0"

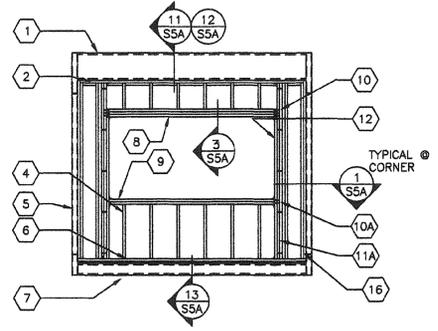


4 TYP END WALL FRAMING W/WINDOW  
S5 1/4"=1'-0"

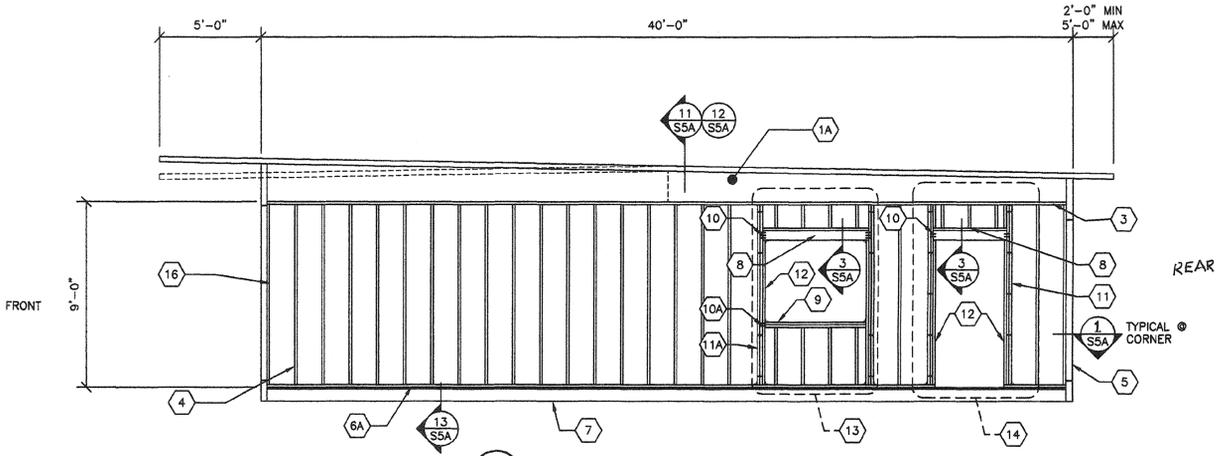

6 TYP SIDE WALL FRAMING  
S5 1/4"=1'-0" (MONODUAL PITCH)

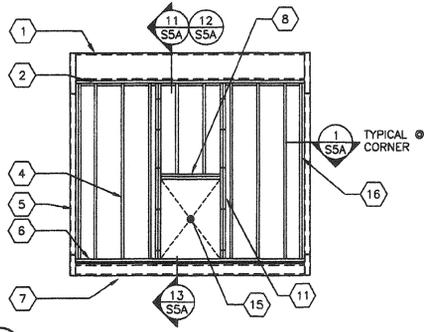


2 TYP END WALL FRAMING W/INDOOR HVAC UNIT  
S5 1/4"=1'-0" OPTIONAL

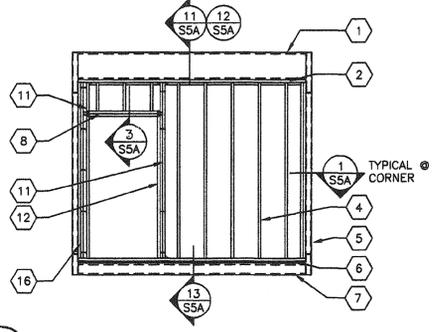

5 TYP END WALL FRAMING W/DOOR  
S5 1/4"=1'-0"

- KEY NOTES -**
- 1 ROOF HEADER
  - 1A ROOF BEAM
  - 2 2x4 PLATE NO SPLICE
  - 3 2x4 PLATE
  - 4 2x4 STUDS SPACED PER SCHEDULE TYP. W/ (3) .131x3" NAILS @ EA END
  - 5 HSS COLUMN
  - 6 2x4 BOTTOM PLATE NO SPLICES
  - 6A 2x4 BOTTOM PLATE
  - 7 PERIMETER FLOOR BEAM
  - 8 (2) 2x6 W/ 2x4 FLAT HEADER ALT. (3) FLAT 2x4 HEM FIR. PER DETAIL 3/SSA
  - 9 (2) 2x4 HEM FIR #2 WINDOW SILL PLATE (3) 2x4 HEM FIR #2 OR (2) 2x4 DOUG FIR #2 @ 8" WIDE WINDOW SILL PLATE WITH STUCCO FINISH ONLY
  - 10 (5).131x3" END NAILS THROUGH KING STUD TYP
  - 10A (3) .131x3" END NAILS THROUGH KING STUD. TYP.
  - 11 (2) 2x4 KING STUDS W/ (2) A34 T&B TO PLATE (INTERNAL W/0.131 NAILS @ 14" OC TYP MAX.)
  - 11A (3) 2x4 KING STUDS W/ (2) A34 T&B TO PLATE (INTERNAL W/0.131 NAILS @ 14" OC TYP MAX.)
  - 12 2x4 TRIMMER
  - 13 OPTIONAL WINDOW OPENING MAX 8'-0" WIDE (REFER TO 4/S5 FOR DETAILS AND FLOOR PLANS FOR LOCATIONS)
  - 14 OPTIONAL DOOR OPENING (REFER TO 5/S5 FOR DETAILS AND FLOOR PLANS FOR LOCATIONS)
  - 15 HVAC OPENINGS @ INDOOR UNIT
  - 16 2x NAILER

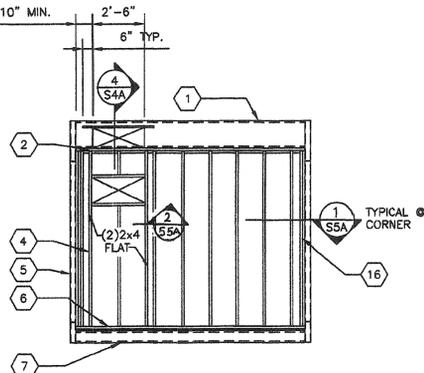

3 TYP END WALL FRAMING W/WALL HUNG HVAC UNIT  
S5 1/4"=1'-0" OPTIONAL

**EXTERIOR WALL FINISH/WALL STUD SCHEDULE**

FINISH TYPE	FOUNDATION TYPE	WALL FINISH COMMENTS	STUD TYPE	STUD SPACING TYPICAL	STUD SPACING @ CORNERS
5/8" PLYWOOD SHEATHING 303 CONFORMING TO PS1-95. VERTICAL GROOVES @ 8" OC	WOOD OR CONCRETE	JOINT DETAIL SEE 9/SSA NAILING PER BLDG SECTIONS	HEM FIR #2	@ 16" OC	@ 16" OC
5/8" HARDIBOARD WITH SYNTHETIC STUCCO	WOOD OR CONCRETE	PER SHEETS A5, A5A, A6 & A6A	DOUG FIR #2	@ 16" OC	@ 16" OC
5/8" HARDI-LAP SIDING	WOOD OR CONCRETE	PER SHEETS A5, A5A, A6 & A6A	HEM FIR #2	@ 16" OC	@ 16" OC
5/8" PLYWOOD SHEATHING CONFORMING TO PS1-95, APA RATED, 5 PLY 32/16, EXPOSURE 1 WITH 5/8" STUCCO	CONCRETE ONLY	NAILING PER BLDG SECTIONS	DOUG FIR #2	@ 16" OC	@ 12" OC
			HEM FIR #2	@ 16" OC	@ 16" OC

- ALL NAILS IN EXTERIOR APPLICATIONS TO BE GALVANIZED.
- WALL CORNERS ARE DEFINED AS A DISTANCE OF 8 FEET IN BOTH DIRECTIONS FROM EACH CORNER OF BUILDINGS WITH 2160 SQ. FT. OR GREATER AND A DISTANCE OF 3 FEET IN BOTH DIRECTIONS FROM EACH CORNER OF BUILDINGS WITH LESS THAN 2160 SQ. FT.
- TYPICAL PLYWOOD NAILING WHERE OCCURS .131x2 1/4" GALV @ 6" O.C E.N. & 12" O.C. F.N.

**REVISIONS**

NO	DATE	DESCRIPTION

DATE: 02/25/08  
SCALE: NOTED  
DRAWN BY: DM  
SERIAL NO.:

CUSTOMER:  
**12' x 40' RELOCATABLE BUILDINGS  
WALL FRAMING ELEVATIONS**




APPROVALS:  
THESE DRAWINGS ARE PRELIMINARY AND NOT FOR CONSTRUCTION UNLESS STAMPED & SIGNED BY THE ENGINEER OF RECORD.  
*Kenneth A. Lubert*  
REGISTERED PROFESSIONAL ENGINEER  
No. 4416  
EXP. 3-31-11  
Structural Engineer  
STATE OF CALIFORNIA

IDENTIFICATION STAMP  
DIV. OF THE STATE ARCHITECT  
03-112985  
AC: FLS: SSA: M  
DATE: 2/10/08


IDENTIFICATION STAMP  
DIV. OF THE STATE ARCHITECT  
OFFICE OF REGULATION SERVICES  
PC 02-109808  
AC: FLS: SSA: M  
DATE: 2/10/08

PROJECT No.  
**S5**


THESE DRAWINGS AND SPECIFICATIONS ARE THE PROPERTY OF AMERICAN MODULAR SYSTEMS, INC. AND ARE NOT TO BE REPRODUCED, CHANGED OR COPIED IN ANY FORM OR MANNER, NOR ARE THEY TO BE ASSIGNED TO ANY THIRD PARTY WITHOUT THE WRITTEN AUTHORIZATION OF AMERICAN MODULAR SYSTEMS, INC.

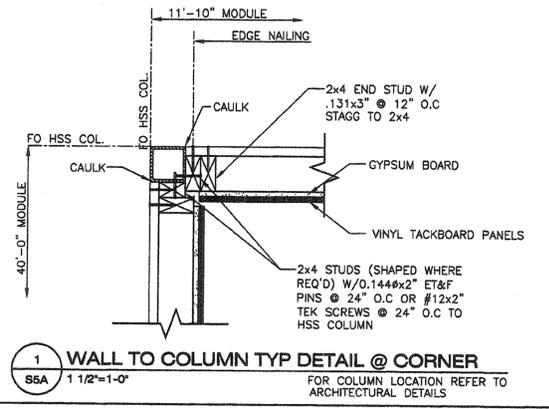


**1 WALL TO COLUMN TYP DETAIL @ CORNER**  
 S5A 1 1/2"=1'-0"  
 FOR COLUMN LOCATION REFER TO ARCHITECTURAL DETAILS

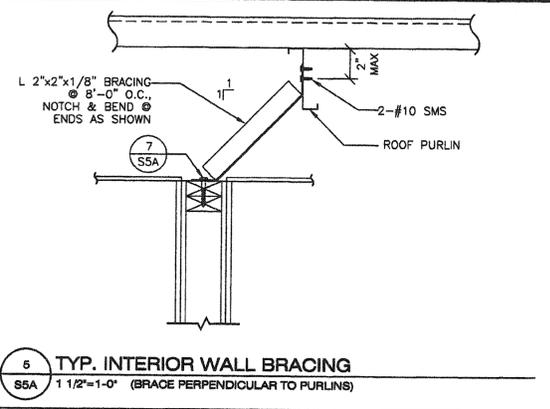


**5 TYP. INTERIOR WALL BRACING**  
 S5A 1 1/2"=1'-0" (BRACE PERPENDICULAR TO PURLINS)

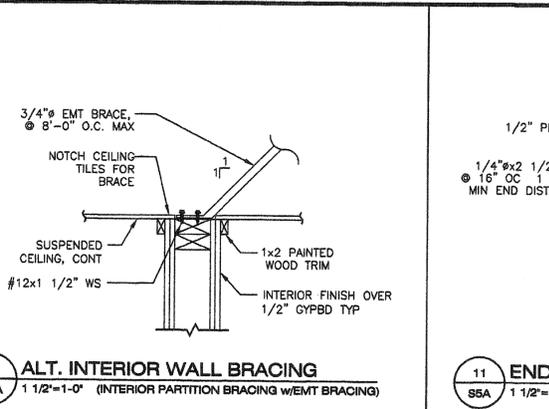


**8 ALT. INTERIOR WALL BRACING**  
 S5A 1 1/2"=1'-0" (INTERIOR PARTITION BRACING W/EMT BRACING)

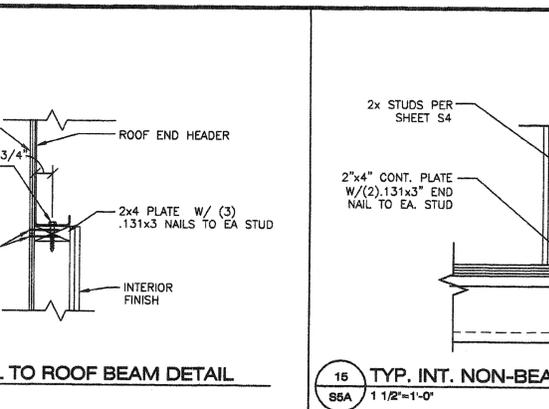


**11 END WALL TO ROOF BEAM DETAIL**  
 S5A 1 1/2"=1'-0"

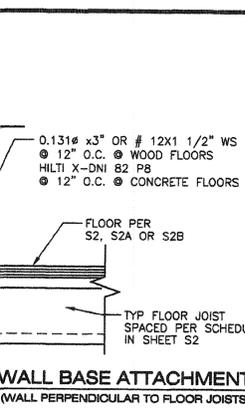


**16 TYP. INT. NON-BEARING WALL BASE ATTACHMENT**  
 S5A 1 1/2"=1'-0" (WALL PERPENDICULAR TO FLOOR JOISTS)

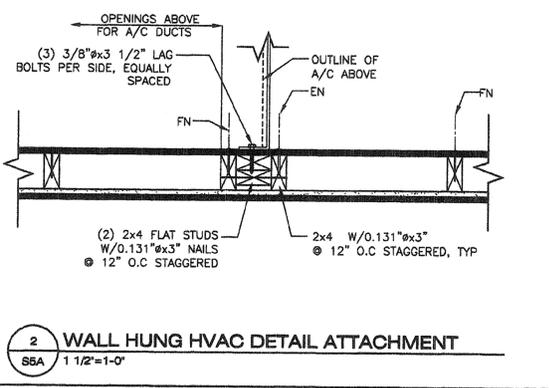


**2 WALL HUNG HVAC DETAIL ATTACHMENT**  
 S5A 1 1/2"=1'-0"

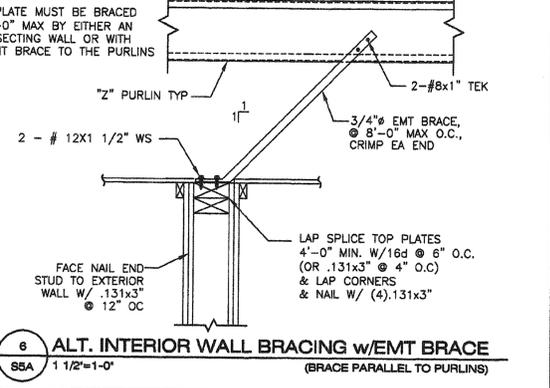


**6 ALT. INTERIOR WALL BRACING w/EMT BRACE**  
 S5A 1 1/2"=1'-0" (BRACE PARALLEL TO PURLINS)

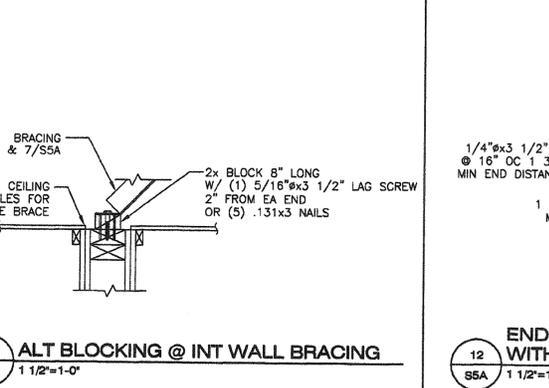


**8A ALT BLOCKING @ INT WALL BRACING**  
 S5A 1 1/2"=1'-0"

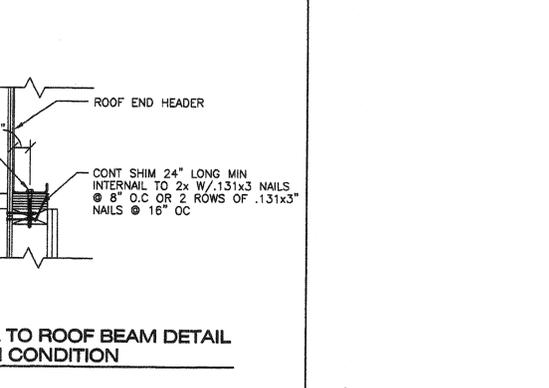


**12 END WALL TO ROOF BEAM DETAIL WITH SHIM CONDITION**  
 S5A 1 1/2"=1'-0"

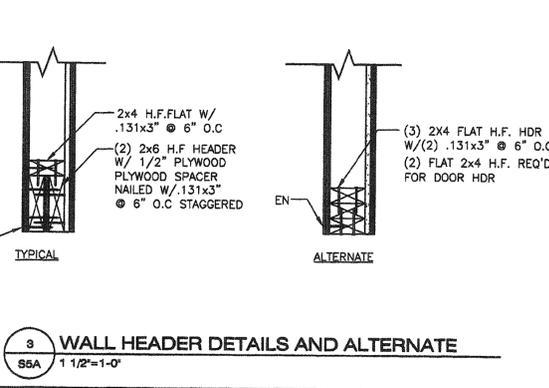


**3 WALL HEADER DETAILS AND ALTERNATE**  
 S5A 1 1/2"=1'-0"

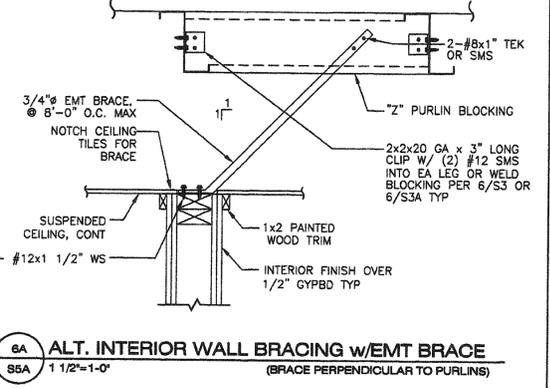


**6A ALT. INTERIOR WALL BRACING w/EMT BRACE**  
 S5A 1 1/2"=1'-0" (BRACE PERPENDICULAR TO PURLINS)

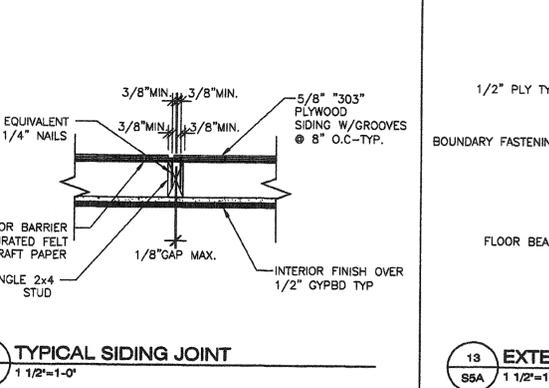


**9 TYPICAL SIDING JOINT**  
 S5A 1 1/2"=1'-0"

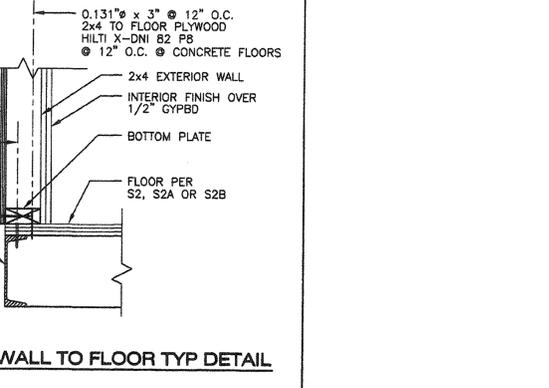


**13 EXTERIOR WALL TO FLOOR TYP DETAIL**  
 S5A 1 1/2"=1'-0"

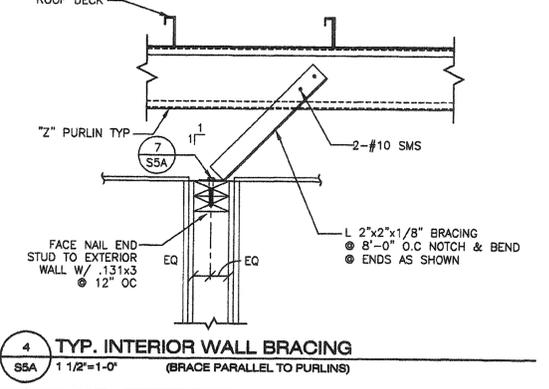


**4 TYP. INTERIOR WALL BRACING**  
 S5A 1 1/2"=1'-0" (BRACE PARALLEL TO PURLINS)

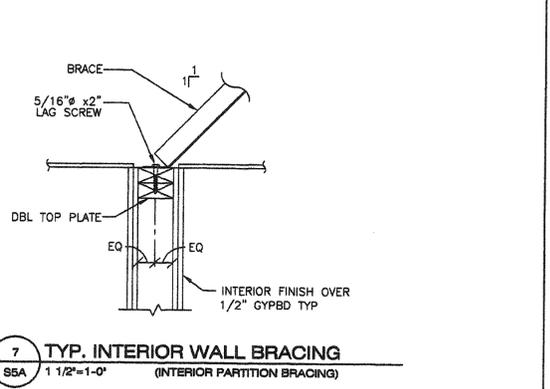

**7 TYP. INTERIOR WALL BRACING**  
 S5A 1 1/2"=1'-0" (INTERIOR PARTITION BRACING)

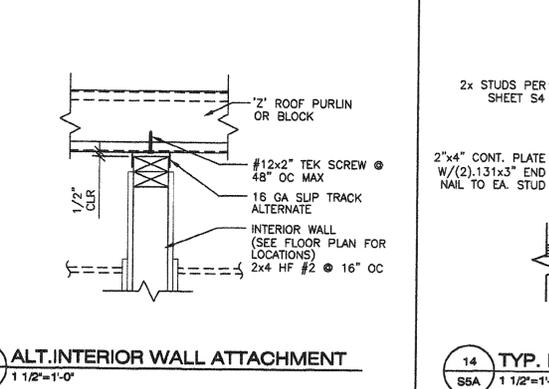

**10 ALT. INTERIOR WALL ATTACHMENT**  
 S5A 1 1/2"=1'-0"

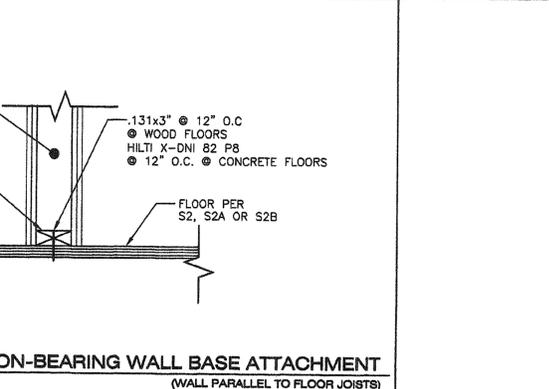

**14 TYP. INT. NON-BEARING WALL BASE ATTACHMENT**  
 S5A 1 1/2"=1'-0" (WALL PARALLEL TO FLOOR JOISTS)

REVISIONS		
NO	DATE	DESCRIPTION

DATE: 02/25/08  
 SCALE: NOTED  
 DRAWN BY: DM  
 SERIAL NO.:


CUSTOMER:  
 12 x 40' RELOCATABLE BUILDINGS  
 WALL FRAMING DETAILS

APPROVALS:  
 THESE DRAWINGS ARE PRELIMINARY AND NOT FOR CONSTRUCTION UNLESS STAMPED & SIGNED BY THE ENGINEER OF RECORD.  
 Registered Professional Engineer  
 Kenneth A. Luttrell  
 No. 1418  
 Exp. 3-31-11  
 Structural Engineer  
 State of California


IDENTIFICATION STAMP  
 DIV. OF THE STATE ARCHITECT  
 OFFICE OF REGULATION SERVICES  
 03-112085  
 AC: FLS S5A  
 DATE: 2/10/08

IDENTIFICATION STAMP  
 DIV. OF THE STATE ARCHITECT  
 OFFICE OF REGULATION SERVICES  
 PC 02-109808  
 AC: FLS S5A  
 DATE: 4/1/08  
 PROJECT No.  
**S5A**

THESE CHANGES AND SPECIFICATIONS ARE THE PROPERTY OF AMERICAN MODULAR SYSTEMS, INC. AND ARE NOT TO BE REPRODUCED, CHANGED OR COPIED IN ANY FORM OR MANNER, NOR ARE THEY TO BE ASSIGNED TO ANY THIRD PARTY WITHOUT THE WRITTEN AUTHORIZATION OF AMERICAN MODULAR SYSTEMS, INC.

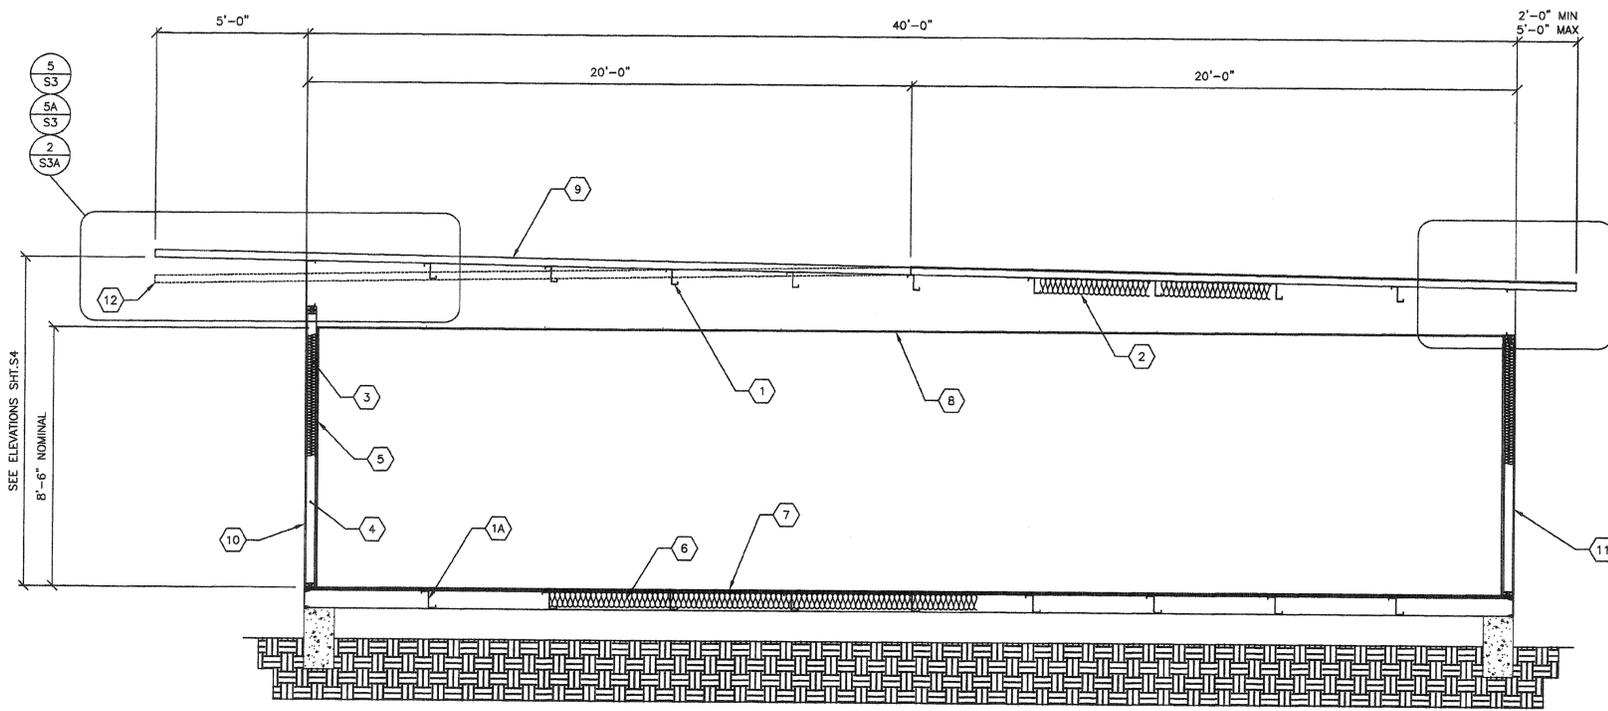

**A TYP. LONGITUDINAL SECTION**  
S7 3/8"=1'-0" (MONO/DUAL PITCH)

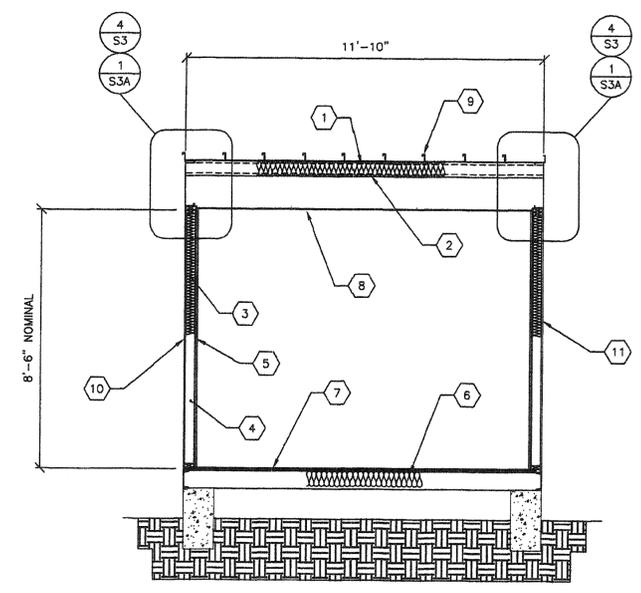

**B TYP. TRANSVERSE SECTION**  
S7 3/8"=1'-0" (MONO/DUAL PITCH)

- KEY NOTES -
- 1 "Z" PURLINS @ 48" O.C
  - 1A) STEEL "Z" FLOOR JOISTS
  - 2 INSULATION w/22 GA WIRE
  - 3 INSULATION w/KRAFT PAPER
  - 4 2x STUDS PER ELEV, S5
  - 5 VINYL FABRIC OVER TACKABLE BACKING PANELS
  - 6 INSULATION w/KRAFT PAPER AND CHICKEN WIRE
  - 7 1/2" PLYWOOD FLOOR SHEATHING FOR ALT SEE SHEET S2, S2A OR S2B
  - 8 SUSPENDED T-BAR CEILING
  - 9 METAL ROOF PANELS SEE ROOF FRAMING PLAN
  - 10 TYPICAL PLYWOOD NAILING .131x2 1/2" GALV @ 6" O.C PANEL EDGES (ALL EDGES BLOCKED).131x2 1/2" GALV @ 12" O.C FIELD
  - 11 EXTERIOR WALL FINISH PER EXTERIOR ELEVATIONS
  - 12 ALTERNATE DUAL PITCH

REVISIONS		
NO	DATE	DESCRIPTION

DATE: 02/25/08  
SCALE: NOTED  
DRAWN BY: DM  
SERIAL NO.:

CUSTOMER:  
**12' x 40' RELOCATABLE BUILDINGS  
BUILDING SECTIONS**

APPROVALS:  
THESE DRAWINGS ARE PRELIMINARY AND NOT FOR CONSTRUCTION UNLESS STAMPED & SIGNED BY THE ENGINEER OF RECORD.  
*[Signature]*  
REGISTERED PROFESSIONAL ENGINEER  
Kenneth A. Luttrell  
No. 1418  
EXP. 3-31-11  
Structural Engineer  
STATE OF CALIFORNIA

IDENTIFICATION STAMP  
DIV. OF THE STATE ARCHITECT  
42-112985  
AC: [Signature] FL: [Signature] SS: [Signature]  
DATE: 2/10/10

IDENTIFICATION STAMP  
DIV. OF THE STATE ARCHITECT  
OFFICE OF REGULATION SERVICES  
PC 02-109808  
AC: [Signature] FL: [Signature] SS: [Signature]  
DATE: 4/1/09

PROJECT No.  
**S7**

THESE DRAWINGS AND SPECIFICATIONS ARE THE PROPERTY OF AMERICAN MODULAR SYSTEMS, INC. AND ARE NOT TO BE REPRODUCED, CHANGED OR COPIED IN ANY FORM OR MANNER, NOR ARE THEY TO BE ASSIGNED TO ANY THIRD PARTY WITHOUT THE WRITTEN AUTHORIZATION OF AMERICAN MODULAR SYSTEMS, INC.