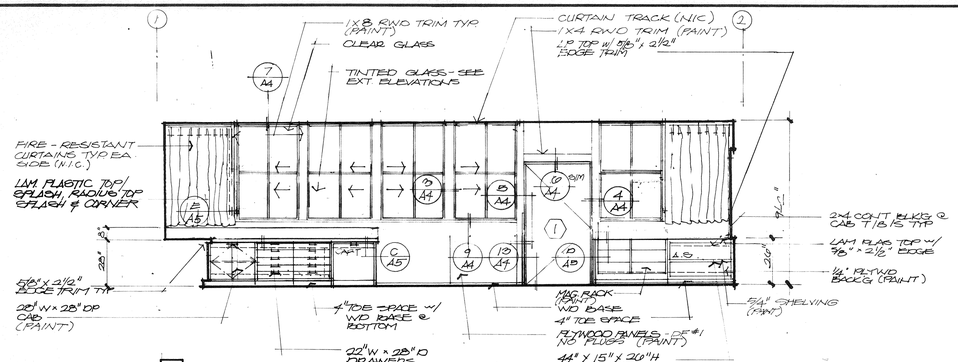

1 FRONT

1/4"

NOTE: 1) SEE SHEET A.1 FOR CABINET ANCHORAGE

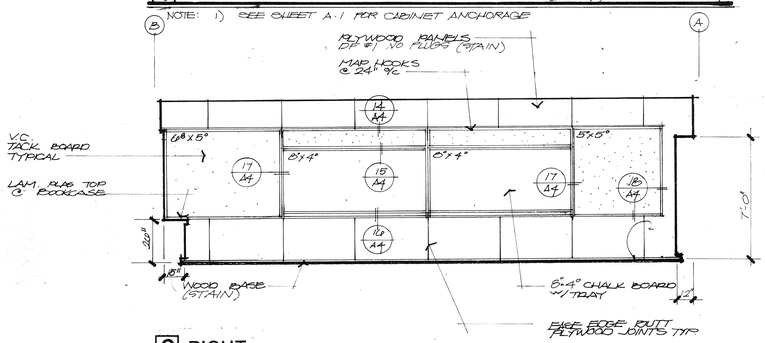

2 RIGHT

1/4"

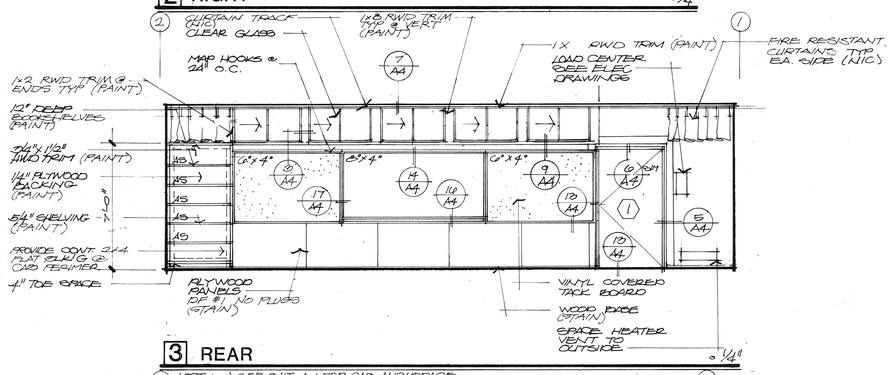

3 REAR

1/4"

NOTE: 1) SEE SHT. A.1 FOR CAB. ANCHORAGE

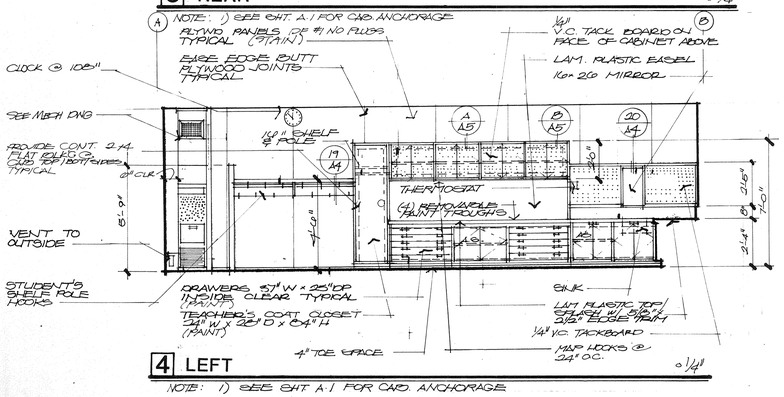

4 LEFT

1/4"

NOTE: 1) SEE SHT A.1 FOR CAB. ANCHORAGE

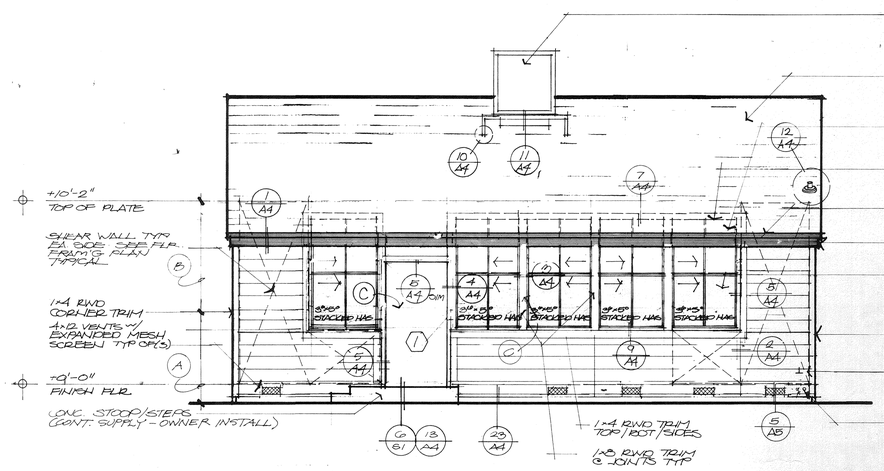

FRONT ELEVATION

1/4"

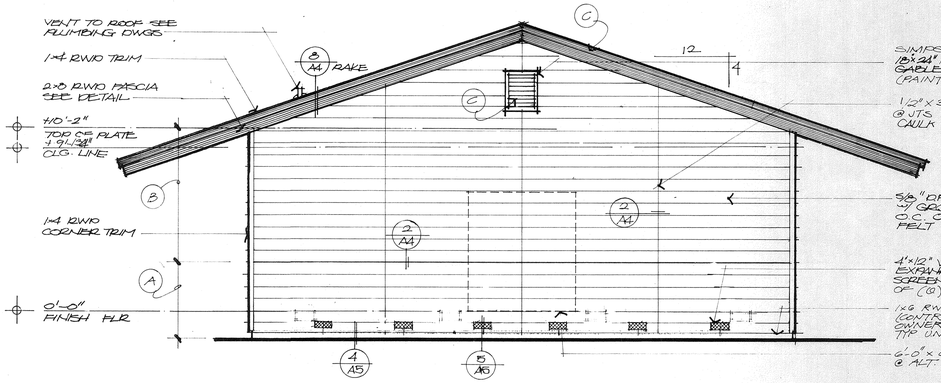

LEFT /RIGHT ELEVATION

1/4"

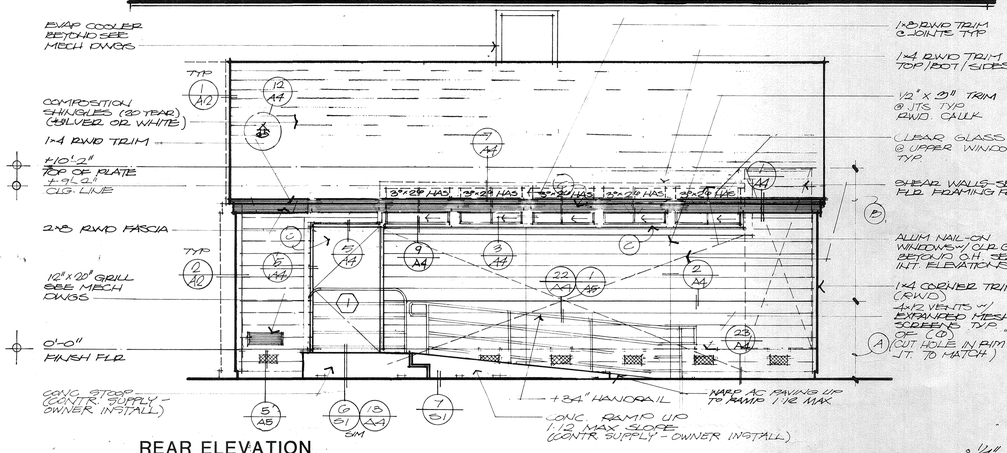

REAR ELEVATION

1/4"

COLOR SCHEDULE (PIONEER PAINT COLORS)

A	EXTERIOR	MARINE ENAMEL	#1036
B	EXTERIOR	MARINE ENAMEL	#432
C	EXTERIOR	MARINE ENAMEL	SANDLEWOOD

THE ABOVE DRAWINGS AND SPECIFICATIONS AND IDEAS, DESIGNS AND ARRANGEMENTS REPRESENTED THEREBY, ARE AND SHALL REMAIN THE PROPERTY OF THE ARCHITECT AND NO PART THEREOF SHALL BE COPIED, DISCLOSED TO OTHERS OR USED IN CONNECTION WITH ANY WORK OR PROJECT OTHER THAN THE SPECIFIC PROJECT FOR WHICH THEY HAVE BEEN PREPARED AND DEVELOPED WITHOUT THE WRITTEN CONSENT OF THE ARCHITECT. VISUAL CONTACT WITH these DRAWINGS OR SPECIFICATIONS SHALL CONSTITUTE CONCLUSIVE EVIDENCE OF ACCEPTANCE OF THESE RESTRICTIONS.
WRITTEN DIMENSIONS ON THESE DRAWINGS SHALL HAVE PRECEDENCE OVER SCALED DIMENSION. CONTRACTORS SHALL VERIFY AND BE RESPONSIBLE FOR ALL DIMENSIONS AND CONDITIONS ON THE JOB AND THIS OFFICE MUST BE NOTIFIED OF ANY VARIATIONS FROM THE DIMENSIONS AND CONDITIONS SHOWN BY THESE DRAWINGS. SHOP DETAILS MUST BE SUBMITTED TO THIS OFFICE FOR APPROVAL BEFORE PROCEEDING WITH FABRICATION.

DATE:	PRINTS ISSUED FOR:	MARK	DATE	REVISIONS
5.10.85	BOARD APPROVAL	1	5.10.85	DEL CONTINUOUS - PT EXT
6.20.85	DSA	2		
6.23.85	BIDDING	3		
		4		
		5		

DRAWN MIKE
DATE 5.10.85
JOB NO. 85-242.1
CHECK'D MMS

CAA
CHRIS A. ADDINGTON C-9093

EXTERIOR / INTERIOR ELEVATIONS

NEW PORTABLE CLASSROOM
FOR BAKERSFIELD CITY SCHOOL DISTRICT.
BAKERSFIELD - KERN COUNTY - CALIFORNIA

A3
OF 9 SHEETS

CHRIS A. ADDINGTON & ASSOCIATES
A.I.A. ARCHITECTS • 3434 TRUXTUN AVE. SUITE #240 • BAKERSFIELD • CALIF. 93301 / 805-327-1699

OZALID