CLASS LEASING, LLC.

1221 Harley Knox Blvd. Perris, CA 92571-7408
(951) 943-1908 Fax (951) 943-5768

3.01 **CARPENTRY:**

1. Scope of Work: Contractor shall provide all labor, materials and services to install carpentry.

2. Workmanship:
   a) FRAMING: securely nailed, bridged and blocked to form rigid structure. Work cut, fitted and assembled level, plumb and true to line. Trim in as long lengths as possible with all standing trim in one piece. Trim sealed at all edges.

   b) NAILING: in accordance with the title 24 CCR-Table 2304.9.1. Nails shall be corrosion resistant box nails.

   c) Machine applied nailing shall have prior demonstration and approval by DSA Field Inspector and the Architect. The approval is subject to continuous satisfactory performance. Plywood shall have a minimum thickness of 3/8". If nail heads penetrate the outer ply more than would be normal for a hand hammer or if minimum allowable edge distances are not maintained, the performance will be deemed unsatisfactory.

   d) TRIM: sealed at all edges. Sealant painted to match trim or siding.

4.01 **MATERIAL SPECIFICATIONS:**

1. Structural framing shall be Hem Fir- Larch graded in accordance with the standard grading rules of the Western Wood Products Association or standard grading rules No. 16 of the West Coast Lumber Inspection Bureau, latest editions. Grades shall be as follows unless noted otherwise on the drawings. (Hem Fir South is not allowed.) Each piece shall be grade marked and no piece may fall below grades indicated. All framing except as noted Hem Fir No. 2

2. Plywood shall be as shown on these drawings with exterior glue in accordance with U.S. Product Standard PS 1-07. All panels shall be marked with an APA grade mark with an Identification Index as shown on drawings. Use 4'x8' panels-minimum, except at boundaries and at framing changes where minimum panel dimension shall be 24" at roofs and floors and 12" at walls.

3. Bolts for timber connections shall conform to ANSI/ASME Standard B18.2.1-2012 & 2012 edition of NDS (the National Design Specification for Wood Construction by the National Forest Products Association). Bolts shall be installed in accordance with the requirement of 2012 NDS.
   Bolt holes shall be 1/32 to 1/16 inch larger than bold diameter. Bolts shall be full body steel bolts with minimum yield strength of 45,000 PSI. Re-tighten bolts before closing in work.

4. Lag screws shall be steel and conform to ANSI/ASME Standard B18.2.1 and 2012 NDS. Holes for lag screw shanks shall be bored the same depth and diameter as the shank. The remaining depth of penetration of the screw shall be bored to 70% of the shank diameter. One quarter inch (1/4") diameter lag screws need not have pre-drilled holes if it can be shown that wood members are not damaged during installation. Provide full diameter body lag screws with bending yield strengths per Table 11J in NDS

5. Provide malleable iron washers or equivalent cut plate washers (not less than a standard cut washer) under nuts and bolt or lag screw heads which bear on wood.

6. Wood screws shall conform to ANSI/ASME Standard B18.6.1 and the requirements of the 2012 NDS. Galvanized or other corrosion resistant coating where exposed to weather or used in foundations.
   Screws shall be steel with cut threads and bending yield strengths per Table 11L in NDS.

7. Wood members shall be cut or notched only as shown on structural drawings.

8. When required nailing tends to split wood members, nail holes shall be pre-bored to 3/4 of the nail diameter.

9. Structural nailing shall be with BOX NAILS per all requirements of 2012 NDS. Nailing not specifically indicated shall comply with CCR Title 24, Part 2, Table 2304.9.1. All nails shall be galvanized or other corrosion resistant coating where exposed to weather, in foundations and as noted on plans, per the requirements of CCR Title 24, Part 2, with minimum bending yields per table 11N in NDS. (See nail equivalence below.)

10. Nail equivalence:
    (provide minimum nail lengths as required for specified penetration, TYPICAL: U.N.O.)

    6d equals .113" DIA. - provide 1.38" minimum point penetration
    8d equals .131" DIA. - provide 1.5" minimum point penetration

11. Pressure preservative treatment shall be per Section 2303.1.8, CCR Title 24, Part 2. Provide quality mark on all treated foundation members that comply with CBC 2303.1.8.1. All foundation members shall be marked as "For ground contact" or "For above ground use" as appropriate. Pressure treated material shall comply with AWPA Steindard U1 as required by CBC 2303.1.8. Treat all cut ends of pressure treated members with an approved preservative. (Willard WIB Copper Green 2% or an approved equivalent). Where noted, members below the sub floor that are not a part of the foundation shall be pressure treated.

12. Only material in contact with ground needs to be pressure treated, all other foundation lumber can be DF or HF#2 or equal.

13. If machine nailing is utilized for this project, contractor shall comply with all requirements of CCR Title 24, Part 2. Machine nailing is subject to approval by the Structural Engineer or Architect and the Division of the State Architect.

14. Fasteners for pressure-preservative treated and fire-retardant treated wood shall comply with Section 2304.9 of CBC.

15. Nails and spikes used in wet or exterior locations shall comply with Section 2304.9.1.1 of CBC.

16. Shim material shall be plywood CD EXP 1 or equal (not pressure treated).

17. Used lumber in good condition is acceptable for use in foundation system.

18. Tie plates shall conform to A-1011 Grade 33.

5.01 **SITE INSTALLATION REQUIREMENTS FOR DSA CLASSROOM BUILDINGS:**

In the case of equipment located in the State of California, the LESSEE (School District) is responsible for the site being cleared (free of grass, trees, shrubs, etc) and graded to within 4 1/2" of level grade for each building. If the site exceeds the 4 1/2" level grade requirement additional costs may be charged to lessee.

Under no circumstances should the site be greater that 9" from level grade or have less than a 1000 PSF MINIMUM SOIL BEARING PRESSURE.

Prior to delivery, the lessee shall mark the four corners of the building on the site, including door location. Should special handling be required to either place, install or relocate the classroom on the lessee's site due to site obstruction such as fencing, landscaping, other classrooms, etc., additional costs will be charge to the lessee.

6.01 **TEST AND INSTALLATION:**

1. Provide Electrical Grounding Test per DSA IR E-1.

2. Field Welding for welded tie plate option. (If used, requires Test and Inspection.)

   The example form DSA 103's shown on this sheet are for illustration purposes only.
   A form DSA 103 is to be completed for each application that this PC is being incorporated into and all example form DSA-103's are to be crossed out on this drawing.

3. No other tests and inspections are required.

SPECIFICATIONS
RELOCATABLE CLASSROOMS

1.01 **GENERAL REQUIREMENTS:**

1. The requirements of the general conditions of the agreement and these General Requirements apply to the several trade sections with the same force as though fully repeated in each section.

2. Name brands are indicated to establish a standard of quality. Items of equal or better quality may be substituted for the listed brand named products.

1.02 **SCOPE OF WORK:**

1. The work consists of installing on-site, modular Relocatable buildings as defined herein, shown and detailed on the drawings.

2. All requirements of CCR (California Code of Regulation) Title 19 and 24 relating to inspections and verified reports shall be complied with and shall include:

   a) General responsible charge of Field Administration by the Architect of Record.

   b) Inspection during the course of construction by an Inspector approved by DSA (Division of the State Architect) and the District Architect. The Inspector shall be responsible for and approved to inspect the general construction, welding, mechanical and electrical work. Cost of these inspections shall be borne by the School District.

   c) On site inspection of the building installation, electrical and utility of the building installation or connection by an Inspector approved by the DSA and retained by the School District.

   d) Other special tests or inspections as may be required by DSA.
   Cost of these inspections/tests shall be borne by the School District.

1.03 **WORK NOT INCLUDED:**

1. All on-site or off-site utilities and the connection of them to the building unless indicated on the drawings.

2. All leveling, grading or other site preparation (except concrete or wood leveling strips, where Required) unless otherwise indicated on the drawings.

3. Fire alarm system, program bell, clock, public address system, intercom system, TV system, computer data or any other low voltage system, unless otherwise indicated on the drawings or the lease agreement.

1.04 **ACCESSIBILITY OF SITE:**
The School District shall provide access to the site for the installation of the building. Removal of trees, shrubs, fencing, sprinklers, etc. necessary for move-in and removal of the buildings shall be the responsibility of the School District.

2.01 **SITE ASSEMBLY:**

1. Scope of Work: Contractor shall provide all labor, materials and services to prepare the building elements, transport them from the plant to the site and to complete the assembly at the site.

   The condition of the site, such as drainage and soil bearing capacity, shall be the responsibility of the School District and the District Architect.

2. Assembly of Elements:
   a) In a location on the site as determined by the District Architect. The contractor shall place the foundation as detailed on the drawings.

   b) The elements shall be brought to the site on wheel assembly and transferred to the prepared site. Great care shall be taken to avoid damage to the elements by racking or bumping.

   c) Connection of the elements together shall be done according to instructions on the drawings. Flashing, trim and other loose items shall be installed per plans and details of the original building manufacturer's drawings.

DSA
DEPARTMENT OF GENERAL SERVICES

DSA-103 ver 100913
Statement of Structural Tests & Special Inspections - 2013 CBC

INCREMENT #: | DSA File No.: | Application No.: | Date Submitted: | Revised: | Revised:

Subcat Name: SAMPLER FOR WELD PLATE OPTION ONLY | Status:

IMPORTANT!! This form is only a summary list of structural tests and special inspections required for the project. The special tests and inspections must be performed as detailed on the DSA approved documents. The project inspector is responsible for provide a complete list of all items of construction, including but not limited to, special inspections and tests on this form, such as structural wood framing, high-lead wood diaphragms, cold-formed steel framing, anchorage of non-structural components, etc., per Title 24, Part 2, Chapter 17A. NOTE: This form is also available for projects submitted for review under the 2007 and 2010 CBC.

INSTRUCTIONS: Click a plus sign (+) before any category or subcategory to reveal additional tests and special inspections. An "X" before a listed test or inspection indicates it is a mandatory requirement. A selected box indicates a test or special inspection that may be required, depending on the scope of the construction and other issues. A shaded box can be clicked indicating your selection of that test. Such A shaded (+) sin a category or subcategory heading indicates that it can be collapsed. However, any selections you may have made will be cleared. Click on the "COMPILE" button to show only the tests finally selected. For more information on use of this form, see DSA-103-INSTR.

Note: References are to the 2013 edition of the California Building Code (CBC) unless otherwise noted.

Mandatory	Selected	TEST or SPECIAL INSPECTION	Frequency	Continuous	Periodic	CODE REFERENCE AND NOTES
		+ SOILS				
		+ CONCRETE				Table 1705A.3
		+ MASONRY				TMS 402-11/ACI 530-11/ASCE 5-11 Table 1.19.3
		- STEEL				Table 1705A.2.1
		- 17. STRUCTURAL STEEL AND COLD-FORMED STEEL USED FOR STRUCTURAL PURPOSES				
		Material Verification:				
	X	a. Verify that all materials are appropriately marked and that: • All continuous indicate material properties that comply with requirements. • Material sizes, types and grades comply with requirements.	Periodic		P	* By special inspector when performed off-site; by project inspector for steel shipped directly to project site without welding or fabrication.
	X	b. Test certified material.	Test		Lab	2009A.1 (2006 1^A, ASTM A370)
		Inspections:				
	X	c. Verify member locations, bracing and all details constructed in the field.	Continuous		PI	
	X	e. Verify stiffener locations, connection site locations and all connection details fabricated in the shop.	Periodic		SI	
		- 18. WELDING:				DSA IR 17-9, AWS D1.1 and AWS D1.3 (AWS D1.3 for cold formed steel).
		Verification of Materials, Equipment, Welders, etc:				
	X	a. Verify weld filler material identification markings per AWS designation listed on the DSA approved documents and the WPS.	Periodic		SI	
	X	b. Verify weld filler material manufacturer's certificate of conformance.	Periodic		SI	
	X	c. Verify WPS, welder qualifications and equipment.	Periodic		SI	DSA IR 17-6.
		- 19.2 FIELD WELDING:				
	X	a. Inspect single-pass fillet welds ≤ 5/16"	Periodic		SI	Per AISC 360 (and AISC 341 as applicable), DSA IR 17-5.
		+ WOOD				
		+ OTHER				

1. Field Welding Inspection: Special Inspection Verified Report - Form DSA-202

KEY to Columns	
1 Type -	2 Performed By -
Continuous – Indicates that a continuous special inspection is required	SE – Indicates that the special inspection is to be performed by a registered geotechnical engineer or his or her authorized representative
Periodic – Indicates that a periodic special inspection is required	Lab – Indicates that the test or inspection is to be performed by a testing laboratory accepted in the DSA Laboratory Evaluation and Acceptance (LEA) Program, then review 4.305, 2013 CCR Title 24, Part 1.
Test – Indicates that a test is required	PI – Indicates that the special inspection is to be performed by the project inspector
	SI – Indicates that the special inspection is to be performed by a special inspector

APPLICABLE BUILDING CODES
ALL NEW WORK SHALL COMPLY AND CONFORM TO THE REQUIREMENTS OF THE 2013 CBC

2013 CALIFORNIA CODE OF REGULATIONS (CCR) As of January 01, 2014*
-2013 CALIFORNIA BUILDING STANDARDS ADMINISTRATIVE CODE PART 1, TITLE 2
(2012 INTERNATIONAL BUILDING CODE VOLUMES 1-2 WITH 2013 CALIFORNIA AMENDMENTS)

-2013 CALIFORNIA ELECTRICAL CODE (CEC) PART 3, TITLE 24, CCR
(2011 NATIONAL ELECTRICAL CODE WITH 2013 CALIFORNIA AMENDMENTS)

-2013 CALIFORNIA MECHANICAL CODE (CMC) PART 4, TITLE 24, CCR
(2012 UNIFORM MECHANICAL CODE WITH 2013 CALIFORNIA AMENDMENTS)

-2013 CALIFORNIA PLUMBING CODE (CPC) PART 5, TITLE 24, CCR
(2012 UNIFORM PLUMBING CODE WITH 2013 CALIFORNIA AMENDMENTS)

-2013 CALIFORNIA ENERGY CODE (CEC) PART 6, TITLE 24, CCR*

-2013 CALIFORNIA FIRE CODE PART 9, TITLE 24, CCR
(2012 INTERNATIONAL FIRE CODE WITH 2013 CALIFORNIA AMENDMENTS)

-2013 CALIFORNIA REFERENCED STANDARDS CODE PART 12, TITLE 24, CCR

TITLE 19 CCR-PUBLIC SAFETY, STATE FIRE MARSHALL REGULATIONS.

DESIGN DATA:

FLOOR LIVE LOAD = 50 PSF, 50 + 20 PSF PARTITIONS, 100 PSF
ROOF LIVE LOAD = 20 PSF REDUCIBLE FOR TRIBUTARY AREA
WIND SPEED =(120 MPH (V) (3 SECOND GUST), K zz = 1.0
SNOW LOAD: PROJECT IS NOT LOCATED IN A SNOW REGION.
BUILDING CODES = 2012 IBC AND CBC 2013

SEISMIC DESIGN DATA: MOMENT FRAME PC'S
Basic Seismic Force-Resisting System = STEEL MOMENT FRAME
ANALYSIS PROCEDURE USED = EQUIVALENT LATERAL FORCE
Seismic Design Category = E (per CBC Section 1613A.5.6)
Design Base Shear : 24x40 BUILDING = 9460 # (Roof, Floor, Walls & Partitions)
36x40 BUILDING = 14190 # (Roof, Floor, Walls & Partitions)
48x40 BUILDING = 18920 # (Roof, Floor, Walls & Partitions)

t = 1.0 Cs= 0.411 R: = 3.5 SITE CLASS = D
Ss = 2.7 mapped value / 0.8 Ss = 2.16 (For Design)
Sds = 1.44 (Site Specific Documentation Justifying SDS Shall Be Submitted To DSA Prior
S1 = 1.3 per CBC Figure 1613A.5(2) S1r = 1.3 To Approval)
RISK CATEGORY = II

SEISMIC DESIGN DATA: SHEAR WALL PC'S
Basic Seismic Force-Resisting System = WOOD FRAME SHEAR WALLS
ANALYSIS PROCEDURE USED = EQUIVALENT LATERAL FORCE
Seismic Design Category = E (per CBC Section 1613A.5.6)
Design Base Shear: 24x40 BUILDING = 9460 # (Roof, Floor, Walls & Partitions)
36x40 BUILDING = 14190 # (Roof, Floor, Walls & Partitions)
48x40 BUILDING = 18920 # (Roof, Floor, Walls & Partitions)

t = 1.0 Cs= 0.222 R: = 6.5 SITE CLASS = D p = 1.3
Ss = 2.7 mapped value / 0.8 Ss = 2.16 (For Design)
Sds = 1.44 (Site Specific Documentation Justifying SDS Shall Be Submitted To DSA Prior
S1 = 1.3 per CBC Figure 1613A.5(2) S1r = 1.3 To Approval)
RISK CATEGORY = II

FLOOD DESIGN DATA: Project is not located in a flood zone.

LIMITATIONS FOUNDATION PC ONLY:

FOUNDATION ONLY PC IS DESIGNED TO SUPPORT THE SUPERSTRUCTURE FOR THE RELOCATABLE BUILDINGS AS LISTED ON THIS DRAWING.

THE DESIGN CALCULATIONS ARE BASED ON THE FOLLOWING:

1. DSA APPROVED STOCKPILE BUILDINGS

2. ROOF OVERHANGS OF 5'-0" MAXIMUM

3. SINGLE SLOPE OR DUAL SLOPE BUILDINGS
   WALL HEIGHT: 9'-0" MAXIMUM ON DUAL SLOPE BUILDING.
   WALL HEIGHT: 10'-4" MAXIMUM ON SINGLE SLOPE BUILDING.
   (HEIGHT DETERMINED FROM FINISH FLOOR IN BUILDING TO BOTTOM OF STEEL ROOF STRUCTURE: BEAMS OR ROOF HEADERS)
   WALL HEIGHT: 9'-10" MAXIMUM ON SHEAR WALL-DUAL SLOPE BUILDING

4. WALL DEAD LOAD OF 10 PSF (NO STUCCO)

5. FLOOR DEAD LOAD OF 8 PSF

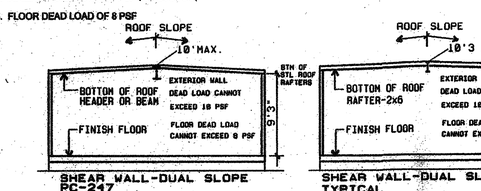

SHEAR WALL-DUAL SLOPE
PC-247

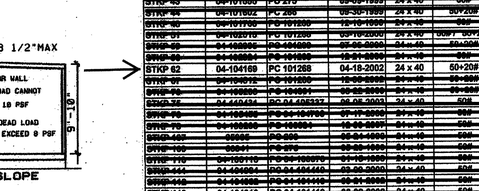

SHEAR WALL-DUAL SLOPE
TYPICAL

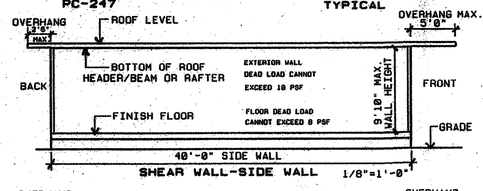

SHEAR WALL-SIDE WALL 1/8"=1'-0"

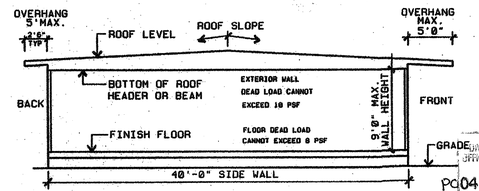

DUAL SLOPE ROOF 1/8"=1'-0"

REVISED 1/29/15

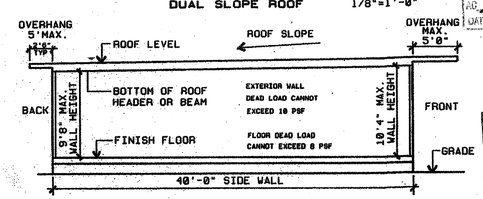

MONO SLOPE ROOF 1/8"=1'-0"

TYPICAL ELEVATIONS ARE SHOWN TO CLARIFY FOUNDATION PC ONLY LIMITATIONS DOCUMENTATION SHALL BE PROVIDED BY ENGINEER OF GENERAL RESPONSIBLE CHARGE TO BE REVIEWED AND APPROVED BY THE DSA STRUCTURAL PLAN REVIEWER.

SCOPE OF WORK: DSA FOUNDATION PLANS FOR EXISTING STOCKPILE BUILDINGS FOR CLASS LEASING, LLC.

SHEET INDEX: STOCKPILE BUILDING FOUNDATION– 2013 CODE UPDATE

F1.0	COVER SHEET, BUILDING DATA, STOCKPILE APPROVAL INDEX	
F2.0	24x40 50 PSF	FOUNDATION PLAN AND DETAILS, ADJACENT BUILDING PAD
~~F2.1~~	~~24x40 50+20 PSF~~	~~FOUNDATION PLAN AND DETAILS, ADJACENT BUILDING PAD~~
~~F3.0~~	~~36x40 50 PSF~~	~~FOUNDATION PLAN AND DETAILS, ADJACENT BUILDING PAD~~
~~F3.1~~	~~36x40 50+20 PSF~~	~~FOUNDATION PLAN AND DETAILS, ADJACENT BUILDING PAD~~
~~F3.2~~	~~36x40 100 PSF~~	~~FOUNDATION PLAN AND DETAILS, ADJACENT BUILDING PAD~~
~~F4.0~~	~~48x40 50 PSF~~	~~FOUNDATION PLAN AND DETAILS, ADJACENT BUILDING PAD~~
~~F4.1~~	~~48x40 50+20 PSF~~	~~FOUNDATION PLAN AND DETAILS, ADJACENT BUILDING PAD~~
~~F4.2~~	~~48x40 100 PSF~~	~~FOUNDATION PLAN AND DETAILS, ADJACENT BUILDING PAD~~

SHEET INDEX:
BELOW GRADE CONCRETE FOUNDATION DESIGNED FOR MODTECH BUILDINGS ONLY

C1.0	COVER SHEET, BUILDING DATA, STOCKPILE APPROVAL INDEX	
C2.0	24 x 40 - 50 PSF	CONCRETE FOUNDATION PLAN & DETAILS, ADJACENT BUILDING PAD
C2.1	24 x 40 - 50+20 PSF	CONCRETE FOUNDATION PLAN & DETAILS, ADJACENT BUILDING PAD
C3.0	36 x 40 - 50 PSF	CONCRETE FOUNDATION PLAN & DETAILS, ADJACENT BUILDING PAD
C3.1	36 x 40 - 50+20 PSF	CONCRETE FOUNDATION PLAN & DETAILS, ADJACENT BUILDING PAD
C3.2	36 x 40 - 100 PSF	CONCRETE FOUNDATION PLAN & DETAILS, ADJACENT BUILDING PAD
C4.0	48 x 40 - 50 PSF	CONCRETE FOUNDATION PLAN & DETAILS, ADJACENT BUILDING PAD
C4.1	48 x 40 - 50+20 PSF	CONCRETE FOUNDATION PLAN & DETAILS, ADJACENT BUILDING PAD
C4.2	48 x 40 - 100 PSF	CONCRETE FOUNDATION PLAN & DETAILS, ADJACENT BUILDING PAD

ADJACENT BUILDINGS: ONLY THOSE BUILDINGS MANUFACTURED BY THE SAME COMPANY MAY BE PLACED ADJACENT TO EACH OTHER

CLASS LEASING-APPROVED STOCKPILE A NUMBERS FOR THIS FOUNDATION PC

BUILDING DATA - 24 x 40 SHEAR WALL

STKP #	DSA #	PC-BASE	DATE	SIZE	FLOOR LOAD	BLDG MFG
STKP 1029	52643	SHR	10-21-1988	24 x 40	50+20#	MODTECH
STKP 02	52512	48132-SHR	11-08-1989	24 x 40	50#	MODTECH
STKP 01	52513	48144-SHR	11-06-1989	24 x 40	50#	MODTECH
STKP 03	52514	SHR	11-06-1989	24 x 40	50#	MODTECH
STKP 05	52515	45400-SHR	12-01-1989	24 x 40	50#	AURORA
STKP 04	52516	SHR PC 32-WR	12-07-1989	24 x 40	50#	MODTECH
STKP 22	58113	PC 80	10-08-1990	24 x 40	50#	MODTECH
STKP 24	58680	PC 56	06-14-1994	24 x 40	50#	MODTECH
STKP 13	61067	PC 247	06-29-1994	24 x 40	50#	MODTECH
STKP 17	67970	PC 247	11-10-1997	24 x 40	50#	MODTECH

BUILDING DATA - 24 x 40 RIGID FRAME

STKP #	DSA #	PC-BASE	DATE	SIZE	FLOOR LOAD	BLDG MFG
STKP 07	52516	SHR	05-15-1990	24 x 40	50+20#	MODTECH
STKP 06	52516	PC 20	05-15-1990	24 x 40	50#	MODTECH
STKP 08	52516	PC 20	05-15-1990	24 x 40	50#	MODTECH
STKP 10	53525	PC 20	05-15-1990	24 x 40	50#	MODTECH
STKP 09	53525	PC 20	05-15-1990	24 x 40	50#	MODTECH
STKP 12	53521	PC 256	06/11/1990	24 x 40	50#	MODTECH
STKP 27	56166	PC 256	07-31-1990	24 x 40	50#	MODTECH
STKP 31	56610	PC 256	11-12-1990	24 x 40	50+20#	MODTECH
STKP 33	57024	PC 256	06-14-1991	24 x 40	50#	MODTECH
STKP 35	57024	PC 256	06-14-1991	24 x 40	50+20#	MODTECH
STKP 30	04-100505	PC 270	06/10/1992	24 x 40	50+20#	MODTECH
STKP 39	04-100505	PC 270	06/10/1992	24 x 40	50+20#	MODTECH
STKP 38	04-100505	PC 256	03-13-1992	24 x 40	50+20#	MODTECH
STKP 40	04-100505	PC 256	03-31-1992	24 x 40	50+20#	MODTECH
STKP 42	04-100505	PC 256	03-31-1992	24 x 40	50+20#	MODTECH
STKP 43	04-101000	PC 270	03-31-1992	24 x 40	50+20#	MODTECH
STKP 44	04-101002	PC 256	05-30-1992	24 x 40	50+20#	MODTECH
STKP 47	04-101010	PC 256	05-30-1992	24 x 40	50+20#	MODTECH
STKP 48	04-101010	PC 101260	05-30-1992	24 x 40	50+20#	MODTECH
STKP 50	04-100505	PC 101260	05-05-2000	24 x 40	50#	MODTECH
STKP 62	04-104169	PC 101268	04-18-2002	24 x 40	50+20#	MODTECH

BUILDING DATA - 36 x 40 RIGID FRAME

STKP #	DSA #	PC-BASE	DATE	SIZE	FLOOR LOAD	BLDG MFG
